


# Marigold, Stage 7

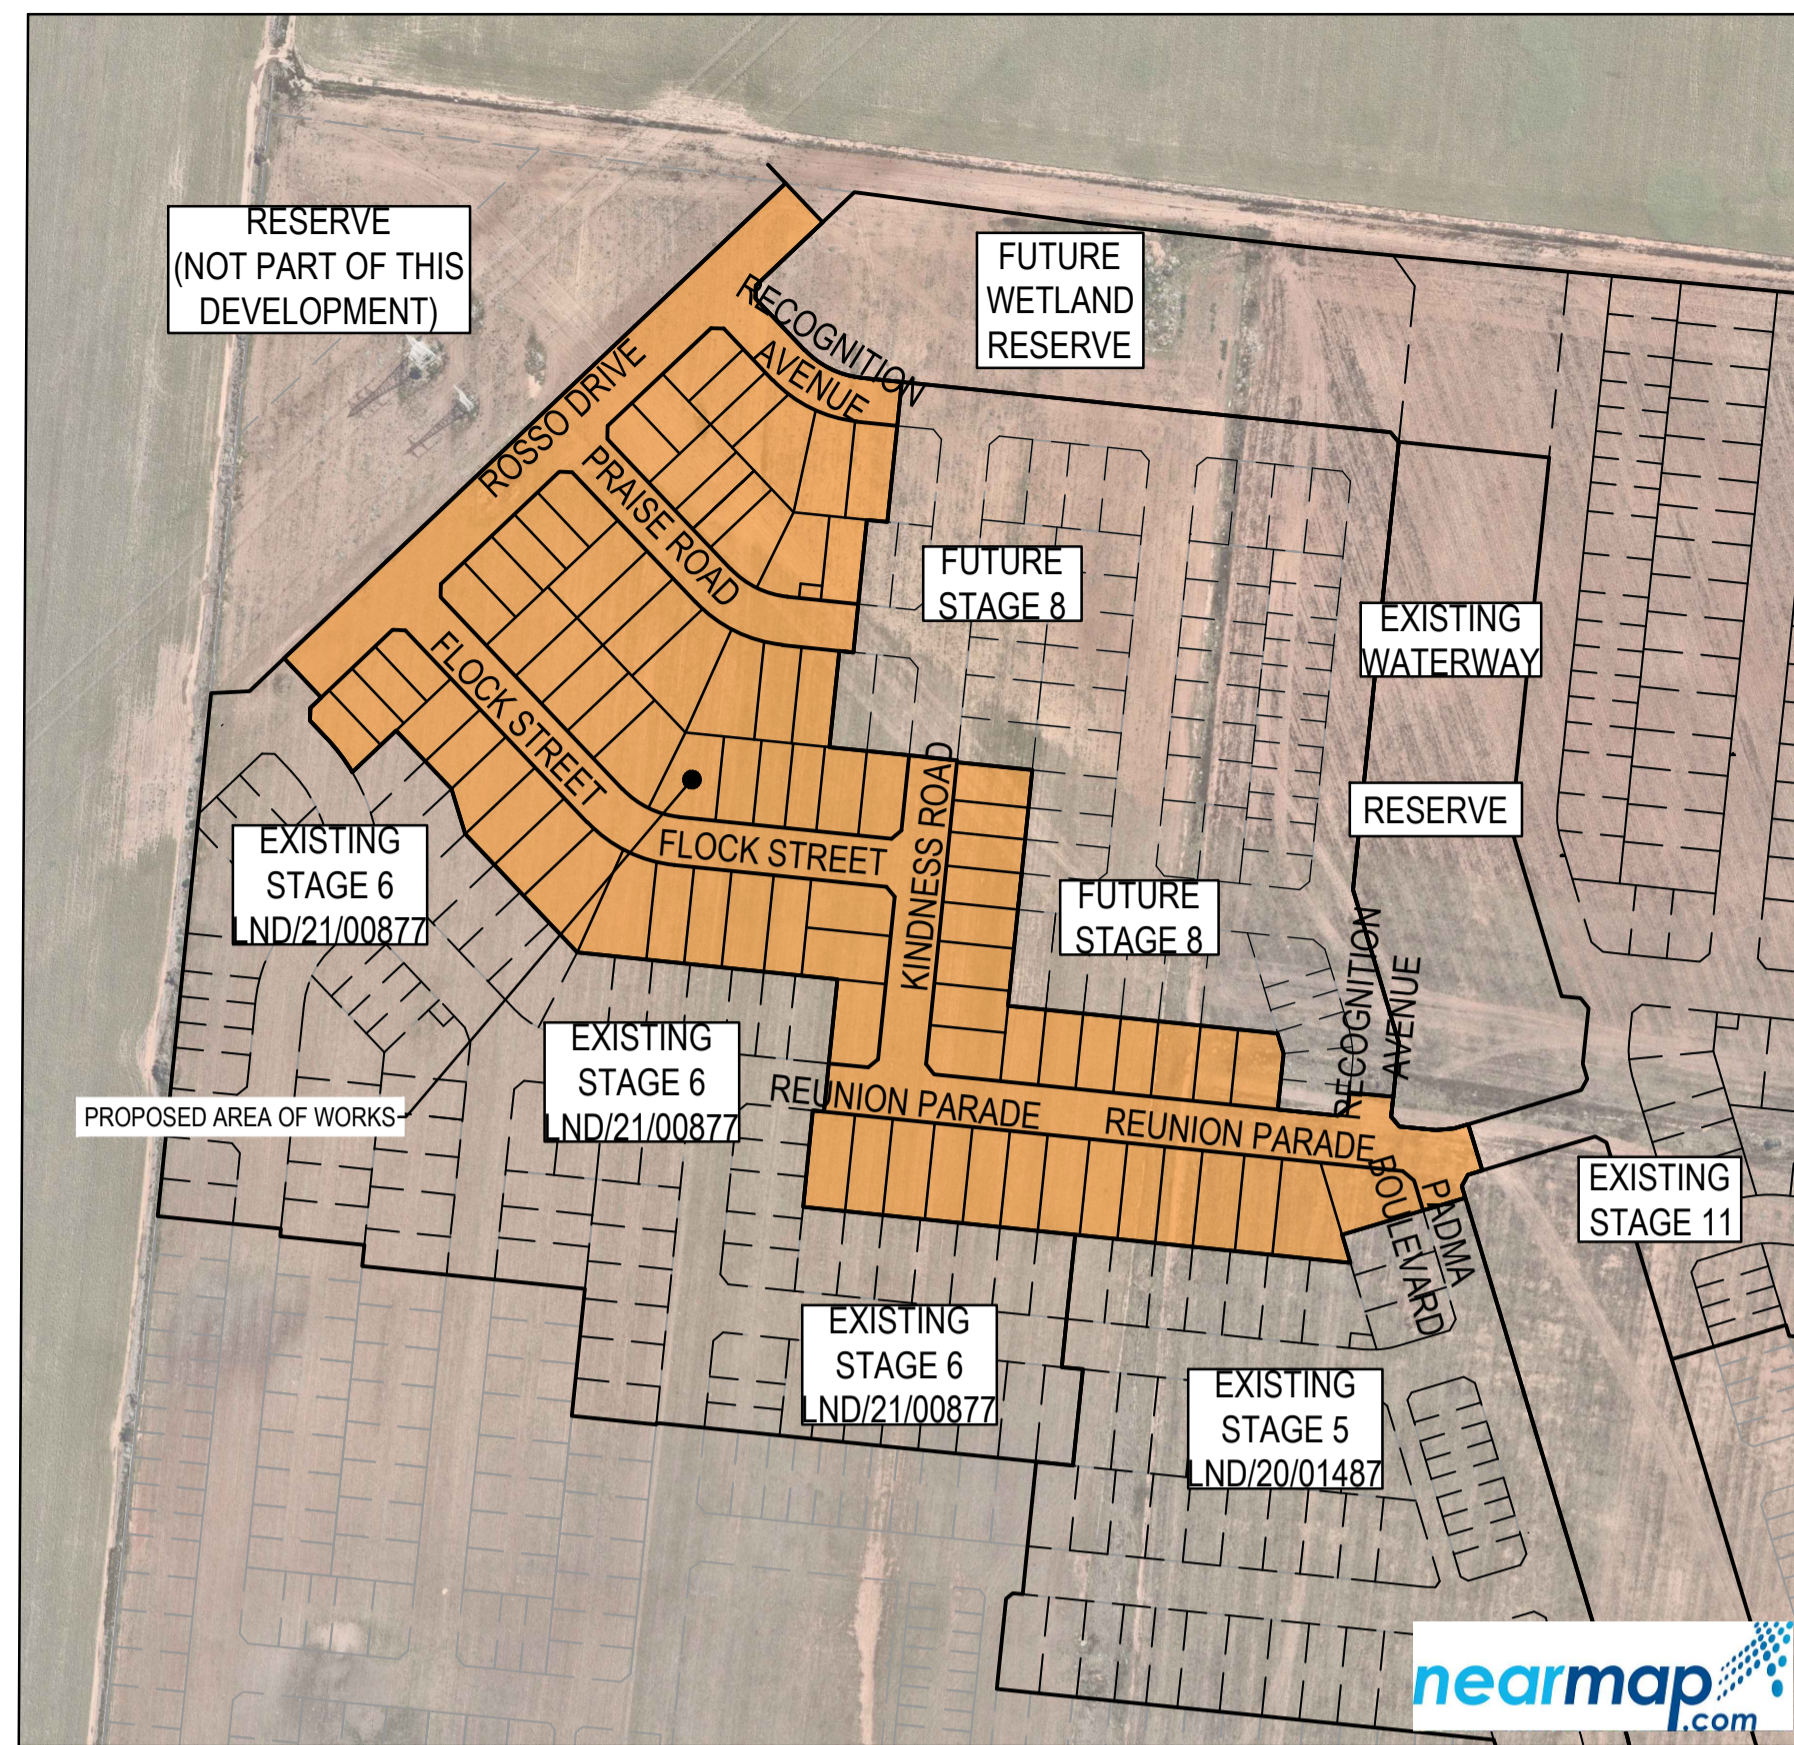


## Drawing Index


2360E-007-101	Cover Plan & General Notes
2360E-007-111	Layout Plan - 1
2360E-007-112	Layout Plan - 2
2360E-007-171	Signage & Linemarking Plan - 1
2360E-007-172	Signage & Linemarking Plan - 2
2360E-007-181	Intersection Detail Plan - 1
2360E-007-182	Intersection Detail Plan - 2
2360E-007-183	Intersection Detail Plan - 3
2360E-007-184	Intersection Detail Plan - 4
2360E-007-201	Longitudinal Sections - 1
2360E-007-202	Longitudinal Sections - 2
2360E-007-203	Longitudinal Sections - 3
2360E-007-251	Cross Sections: Flock Street Ch 11.80 - Ch 197.85
2360E-007-252	Cross Sections: Kindness Road Ch 11.80 - Ch 112.15
2360E-007-253	Cross Sections: Praise Road & Rosso Drive Ch 29.65 - Ch 141.46
2360E-007-254	Cross Sections: Rosso Drive Ch 712.29 - Ch 940.69
2360E-007-255	Cross Sections: Reunion Road Ch 48.38 - Ch 252.16
2360E-007-256	Cross Sections: Reunion Road Ch 258.93 - Ch 267.88 Recognition Ave. Ch 11.80 - Ch 16.15
2360E-007-257	Cross Sections: Recognition Avenue Recognition Ave. Ch 387.50 - Ch 452.37
2360E-007-258	Cross Sections: Padma Boulevard Ch 493.365 - 500.00
2360E-007-301	Drainage Longitudinal Sections - 1
2360E-007-302	Drainage Longitudinal Sections - 2
2360E-007-303	Drainage Longitudinal Sections - 3
2360E-007-351	Pit Schedule
2360E-007-411	Pavement Details - 1
2360E-007-412	Pavement Details - 2
2360E-007-421	General Details
2360E-007-500	Safety In Design

## GENERAL NOTES (WYNDHAM CITY COUNCIL)


- THE WORKS SHALL BE CONSTRUCTED IN ACCORDANCE WITH THE CURRENT EDM ADDENDUM STANDARD DRAWINGS AND SPECIFICATIONS. WORKS TO BE CARRIED OUT TO THE SATISFACTION OF COUNCIL'S SUPERVISING OFFICER.
- THE CONTRACTOR IS RESPONSIBLE FOR SAFETY OF WORK ON SITE IN ACCORDANCE WITH APPROPRIATE LEGISLATION. THE CONTRACTOR SHALL ERECT AND MAINTAIN ALL SHORING, PLANKING AND STRUTTING, DEWATERING DEVICES, BARRICADES, SIGNS, LIGHTS, ETC. NECESSARY TO KEEP WORKS IN A SAFE AND STABLE CONDITION, AND TO PROTECT THE PUBLIC FROM HAZARDS ASSOCIATED WITH THE WORKS.
- THE CONTRACTOR SHALL:
  - COMPLY WITH THE SAFETY REQUIREMENTS OF THE MINES ACT, GENERAL REGULATIONS AND STATUTORY RULES, AND THE MINES (TRENCHES) REGULATION 1982.
  - NOTIFY THE OCCUPATIONAL HEALTH AND SAFETY AUTHORITY OF THEIR INTENTION TO COMMENCE TRENCHING OPERATIONS WHERE TRENCHES ARE 1.5 METRES OR DEEPER.
  - ENSURE THAT THE MINE MANAGER OR THEIR DEPUTY AS REQUIRED BY THE REGULATIONS IS IN ATTENDANCE WHEN TRENCHING OPERATIONS ARE IN PROGRESS.
- THE CONTRACTOR IS TO NOTIFY COUNCIL AND ALL SERVICE AUTHORITIES SEVEN (7) DAYS PRIOR TO COMMENCEMENT OF CONSTRUCTION.
- THE LOCATION OF EXISTING SERVICES SHOULD BE DETERMINED BY THE CONTRACTOR PRIOR TO COMMENCING ANY EXCAVATION BY CONTACTING ALL RELEVANT SERVICE AUTHORITIES. ANY EXISTING SERVICES SHOWN ON THE DRAWINGS ARE OFFERED AS A GUIDE ONLY AND ARE NOT GUARANTEED AS CORRECT.
- TREES MARKED ON THE APPROVED PLANS FOR REMOVAL MUST BE REMOVED FROM THE SITE PRIOR TO THE COMMENCEMENT OF WORKS. NO EXCAVATION SHALL BE CARRIED OUT WITHIN 5.0m OF ANY EXISTING TREE UNTIL APPROVAL HAS BEEN GIVEN BY COUNCIL'S SUPERVISING OFFICER.
- ALL ROAD CHAINAGES ARE MEASURED ALONG THE ROAD CENTRELINE EXCEPT KERB RETURNS AND COURTHOUSES, WHERE LIP OF KERB CHAINAGES ARE SPECIFIED. ALL DIMENSIONS AND RADII ARE GIVEN TO THE LIP OF KERB. DO NOT SCALE OFF THESE DRAWINGS. WRITTEN DIMENSIONS ONLY SHALL BE USED.
- CONDUIT LOCATIONS ARE SUBJECT TO AMENDMENT AND CONDUITS SHALL NOT BE LAID UNTIL WRITTEN APPROVAL IS GIVEN BY THE SUPERINTENDENT. BOTH KERBS ARE TO BE MARKED WITH THE LETTERS E.G.H.T&W ABOVE CONDUIT LOCATIONS AS SPECIFIED. RESPECTIVE PLACES TO BE INDICATED ABOVE RELEVANT CONDUITS AS PER STANDARD DRAWING EDM 303. CONDUITS TO BE LAYERED MINIMUM OF 5m FROM BOUNDARIES WHERE POSSIBLE AND TO THE SATISFACTION OF THE SUPERINTENDENT IN ACCORDANCE WITH COUNCIL STANDARD DRAWINGS.
- SUBSOIL DRAINS SHALL BE INSTALLED BEHIND OR BELOW ALL KERB AND CHANNEL AS PER STANDARD DRAWINGS EDM 202 (EXPANSIVE SUBGRADE).
- ALL LINEMARKING, SIGNING AND TRAFFIC CONTROL DEVICES TO BE IN ACCORDANCE WITH VICROADS REQUIREMENTS WITH LATERAL WORKS AND ARROWS BEING COLD APPLIED PLASTIC TROWELLED INTO PLACE (MATERIAL DEGAOUR OR PLASTELINE) AND LONGITUDINAL LINES BEING EXTRUDED THERMOPLASTIC MATERIAL (VICROADS SPECIFICATION SEE SECTION 710&722).
- ALL LEVELS ARE TO AUSTRALIAN HEIGHT DATUM.
- THE CONTRACTOR WHEN ENGAGED IN BLASTING OPERATION, SHALL NOT BLAST WITHIN 4.5m OF AN EXISTING LINE OF WATER, GAS OR SEWER PIPES OR WITHIN 15m OF ANY COMPLETED PART OF THE WORKS WITHOUT THE CONSENT OF THE ENGINEER.
- ALL EXCAVATED OR FILLED AREAS OUTSIDE THE ROAD RESERVE SHALL BE SURFACED WITH A 100mm MINIMUM TO 200mm MAXIMUM LAYER OF TOPSOIL AS SPECIFIED. ALL FILLING ON ALLOTMENTS TO BE COMPACTED TO 95% STANDARD COMPACTION IN 150mm LAYERS AND AS PER THE SPECIFICATION. WHERE THERE IS FILL IN EXCESS OF 300mm IN DEPTH, THE CONTRACTOR IS TO CARRY OUT SOIL TESTS TO THE REQUIREMENTS OF APPENDIX B AS SPECIFIED IN THE AUSTRALIAN STANDARD AS 3798 TO SHOW THAT LEVEL 1 COMPACTION STANDARDS HAVE BEEN ACHIEVED. TEST RESULTS AND LOCATION OF TESTS FOR EACH ALLOTMENT SHALL BE APPROVED BY THE CONTRACTOR AND FORWARDED TO COUNCIL.
- FILL MATERIAL USED UNDER PAVEMENTS AND FOOTPATHS MUST BE AN APPROVED MATERIAL TO THE STANDARD OF WYNDHAM CITY COUNCIL. ALL SUCH MATERIAL IS TO BE COMPACTED AS PER THE REQUIREMENTS OF THE SPECIFICATION APPROVED WITH THESE DRAWINGS PRIOR TO FORMWORK BEING PLACED. COMPACTION TESTS TO BE COMPLETED AND PROVIDED TO SUPERINTENDENT.
- FILL & CUT BATTERS ARE NOT TO EXCEED 1 IN 6 SLOPE, UNLESS SHOWN OTHERWISE.
- ALL ALLOTMENTS SHALL BE SMOOTHED, GRADED AND SHAPED TO AN EVEN SURFACE WITH A MINIMUM FALL OF 1 IN 150 TO THE DRAINAGE OUTLET SHOWN.
- ALL DRAINAGE PIPES ARE CLASS 2 RCP PIPES, RUBBER RING JOINTED UNLESS OTHERWISE SPECIFIED.
- DRAINAGE PITS SHALL BE CAST MONOLITHICALLY.
- BACKFILLING OF TRENCHES WHERE DRAINAGE AND SEWERAGE ARE IN CLOSE PROXIMITY ARE TO BE BACKFILLED AS PER WYNDHAM CITY COUNCIL STANDARD DRAWING SD6-10.
- ALL SERVICING TRENCHES UNDER ROADS, FOOTPATHS, DRIVEWAYS, PARKING BAYS ETC. ARE TO BE BACKFILLED WITH CLASS 2 F.C.R.
- ALL HOUSE DRAIN CONNECTIONS ARE TO BE LOCATED NO CLOSER THAN 6.00m FROM THE SIDE BOUNDARY U.O.
- INVERT OF PROPERTY INLETS TO BE 500mm MINIMUM BELOW FINISHED SURFACE UNLESS NOTED OTHERWISE.
- VEHICLE CROSSINGS TO BE CONSTRUCTED IN ACCORDANCE WITH STANDARD DRAWINGS EDM 501 TO 503. DRIVEWAYS TO BE LOCATED MIN 0.75m FROM BUILDING LINE UNLESS SPECIFIED OTHERWISE AND CLEAR OF DRAINAGE PITS. SEWER MAINTENANCE HOLES AND EXISTING TREES. DOUBLE DRIVEWAY WIDTH TO BE 7.0m AT FRONT OF PATH/BUILDING LINE.
- ADDITIONAL AND OVER-EXCAVATION SHALL BE BACKFILLED IN ACCORDANCE WITH THE PROVISIONS OF THE SPECIFICATION.
- FOOTPATH CROSSFALL TO BE 1:50
- ALL FOOTPATHS AND SHARED PEDESTRIAN/BICYCLE PATHS ARE TO BE CONSTRUCTED AS PER CITY OF WYNDHAM SPECIFICATIONS AND MPA STANDARD DRAWINGS EDM 401 TO 403.
- ALL EXOTIC (NON NATIVE) TREES AND SHRUBS, INCLUDING DEAD TREES, NOT SHOWN ON THE DRAWINGS BUT LOCATED WITHIN THE WORKS ARE TO BE REMOVED AND DISPOSED OFFSITE.
- INSTALL BLUE RAISED REFLECTIVE PAVEMENT MARKER (BRPM) ON ROAD CENTRELINE AND "GROUND BALL" MARKER POST TO INDICATE LOCATION OF FIREPLUG.
- THE CONTRACTOR IS TO ENSURE THAT THEIR CONSTRUCTION PROCEDURES AND STANDARDS CONTROL THE VOLUME AND LOCATION FOR COLLECTION OF SEDIMENT RUNOFF ACCORDING TO CURRENT EPA - ENVIRONMENTAL GUIDELINES FOR MAJOR CONSTRUCTION SITES.
- UPON COMPLETION OF CONSTRUCTION THE WHOLE SITE SHALL BE CLEANED UP, GRADED AND ALL RUBBISH REMOVED. THE SITE IS TO BE LEFT IN A CLEAN AND TIDY CONDITION TO THE SATISFACTION OF THE SUPERINTENDENT.
- EXISTING PAVEMENT OR DRAINAGE WORKS DAMAGED DURING CONSTRUCTION OR THE MAINTENANCE PERIOD TO BE REINSTATED TO THE SATISFACTION OF THE COUNCIL ENGINEER.
- THE LOWER SUB-BASE MATERIAL SHALL BE N.C.R. FOR PAVEMENT MAKE UPS AS PER THE STANDARD DRAWINGS OF WYNDHAM CITY COUNCIL.

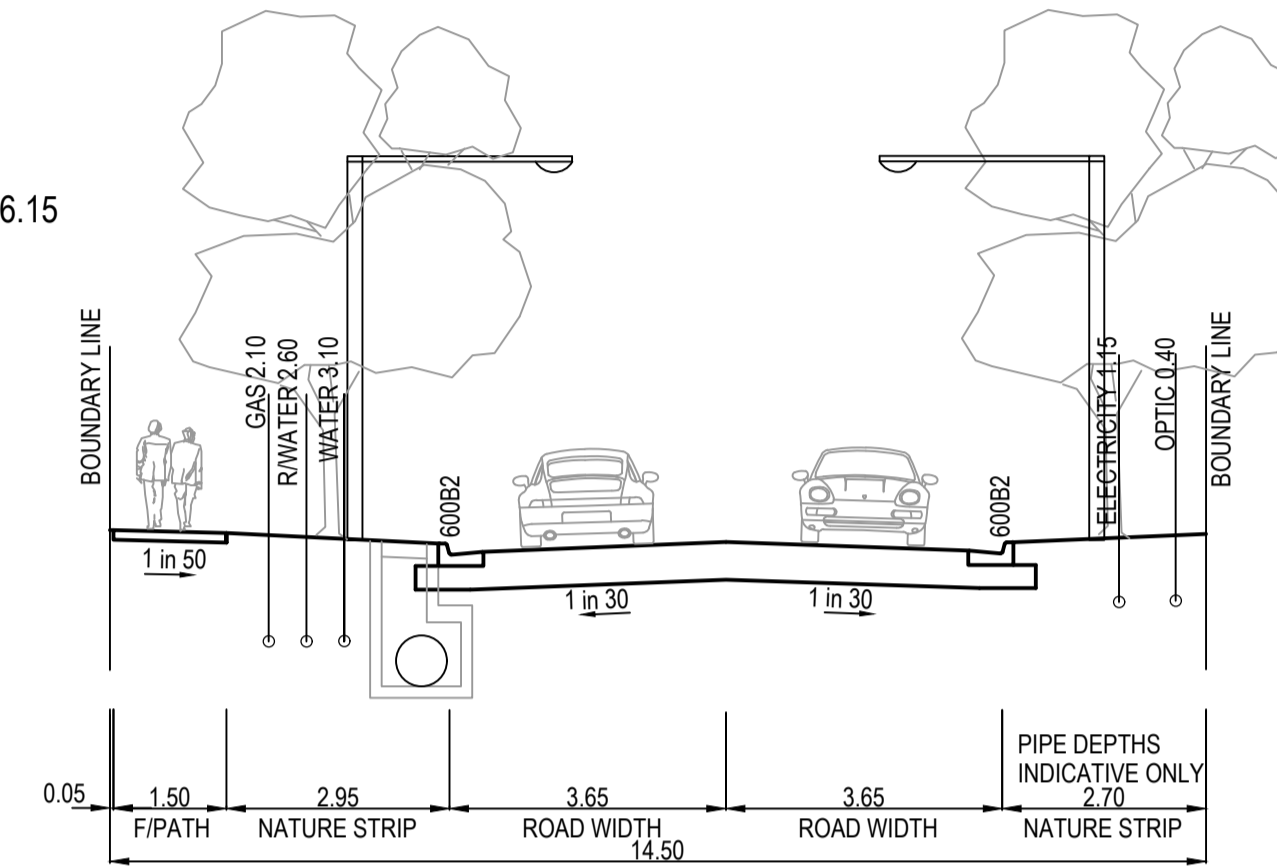


14.5m ROAD RESERVE  
PADMA BOULEVARD

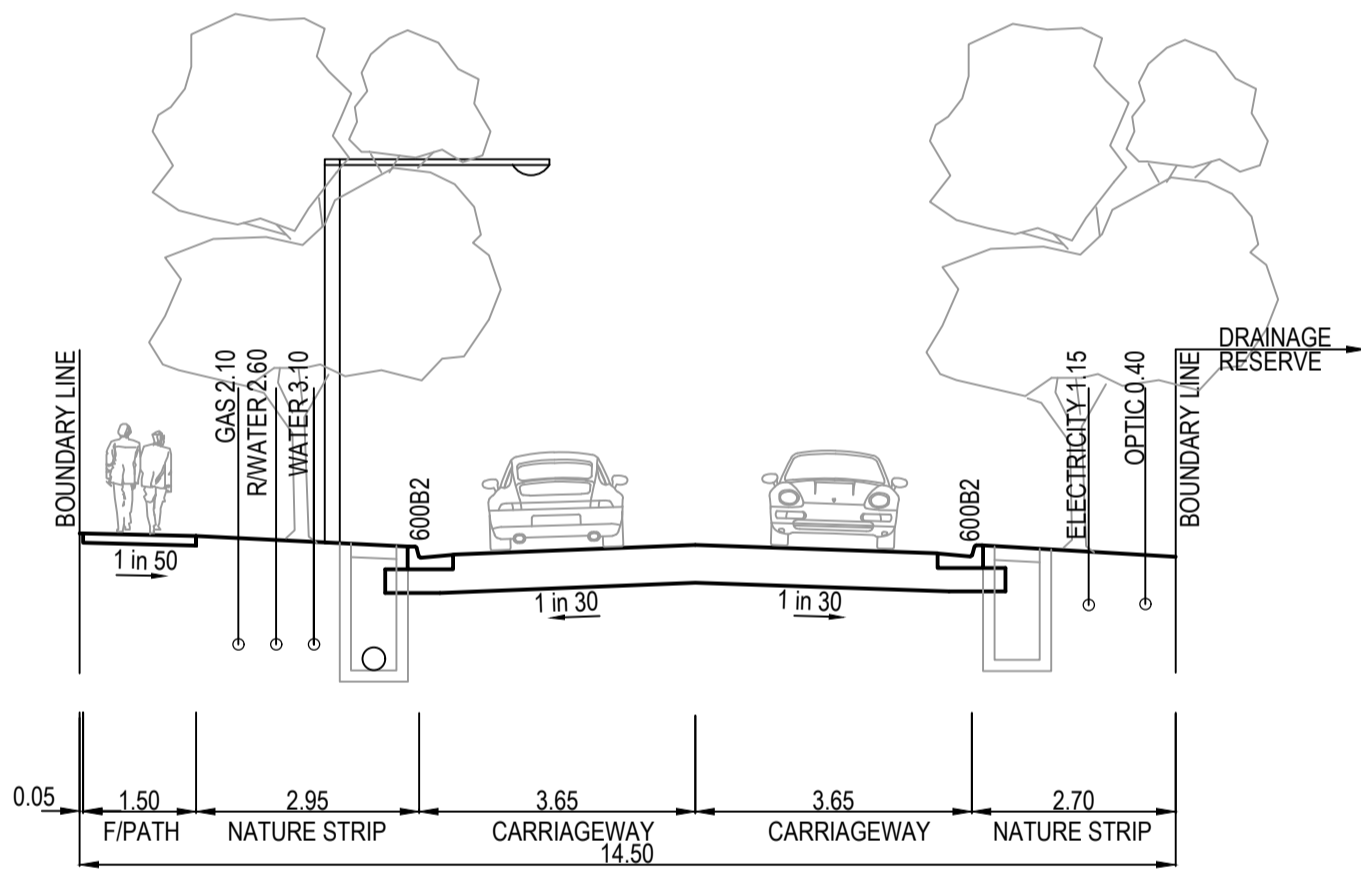


14.5m ROAD RESERVE  
RECOGNITION AVENUE

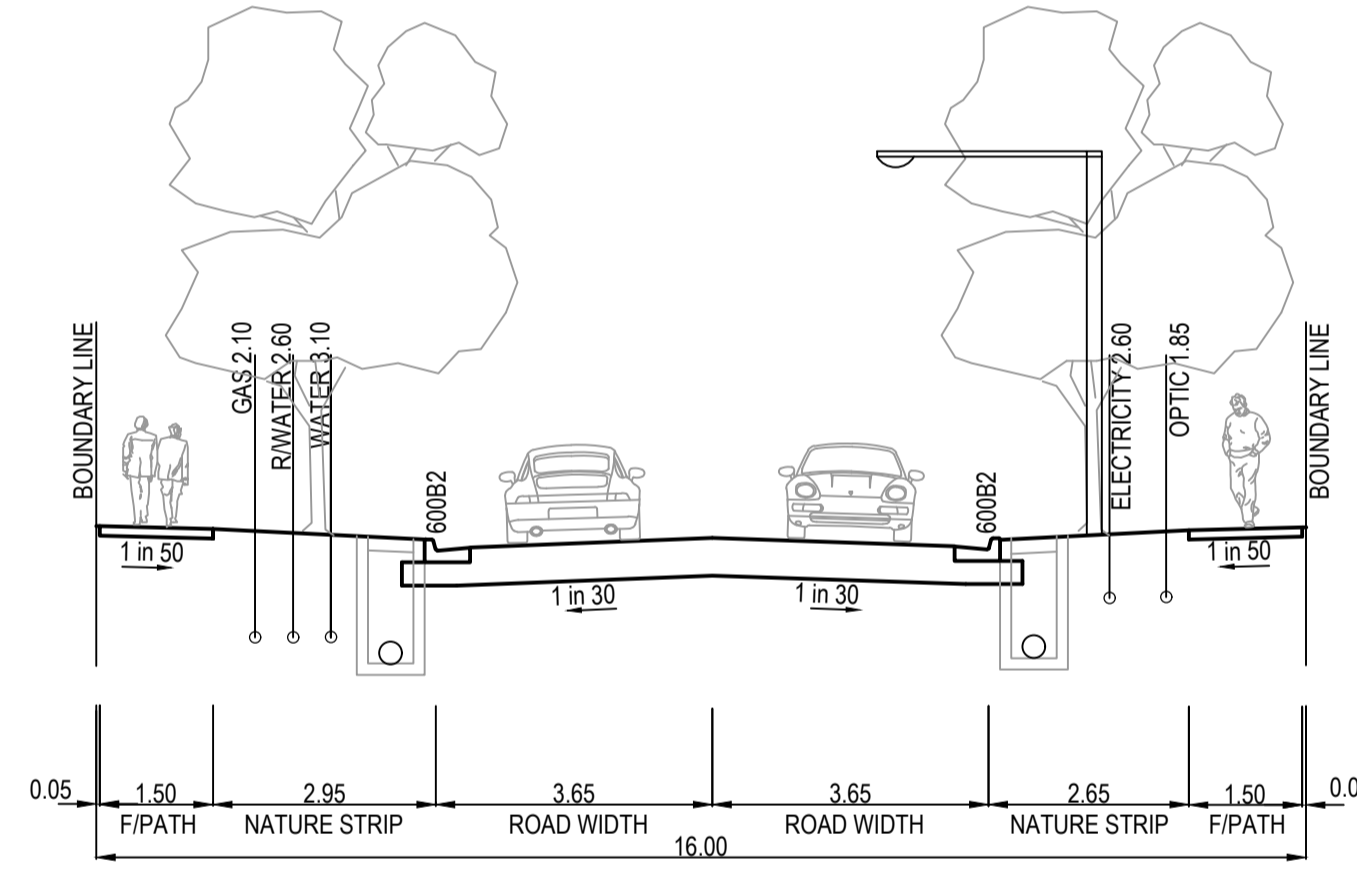


16m ROAD RESERVE  
FLOCK STREET & PRAISE ROAD

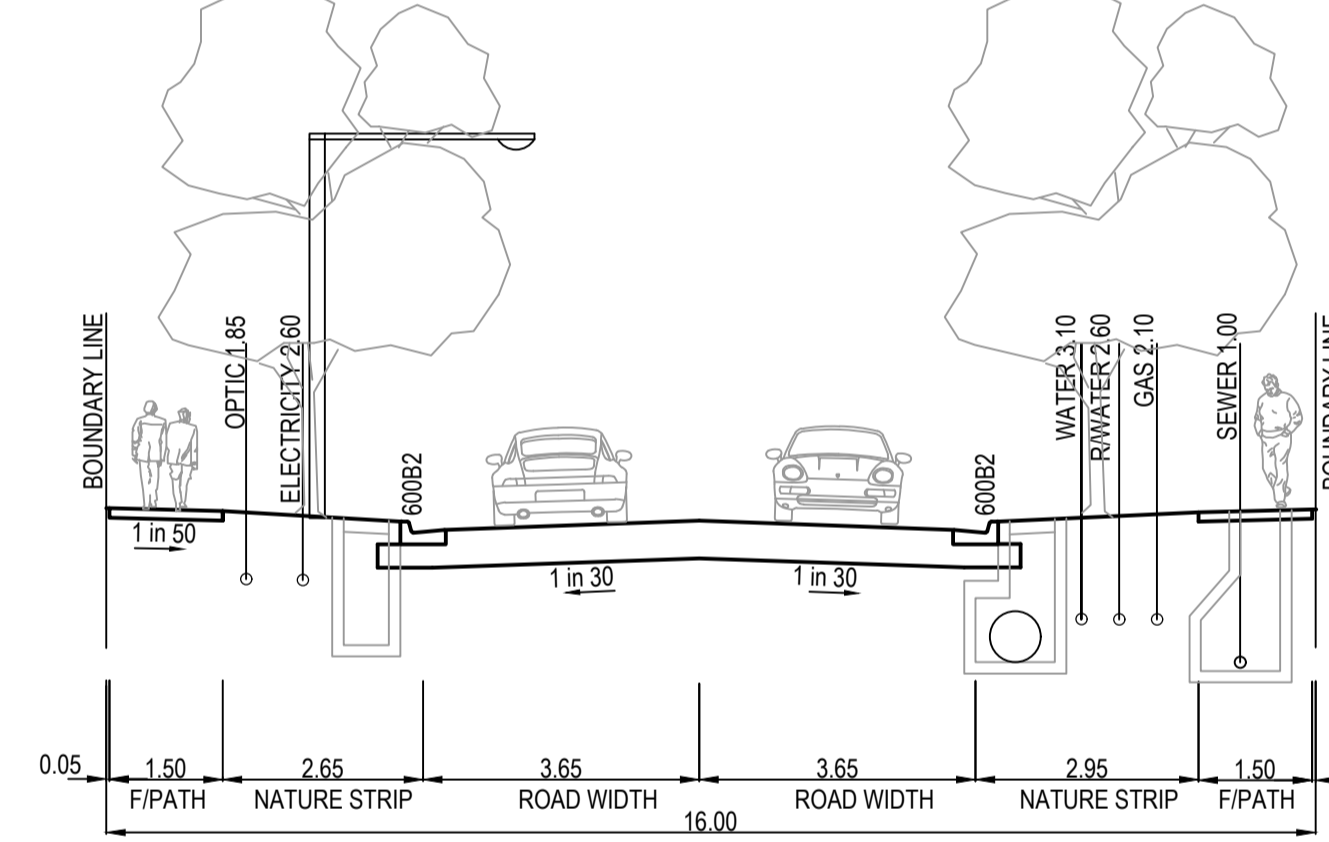

16m ROAD RESERVE  
REUNION PARADE

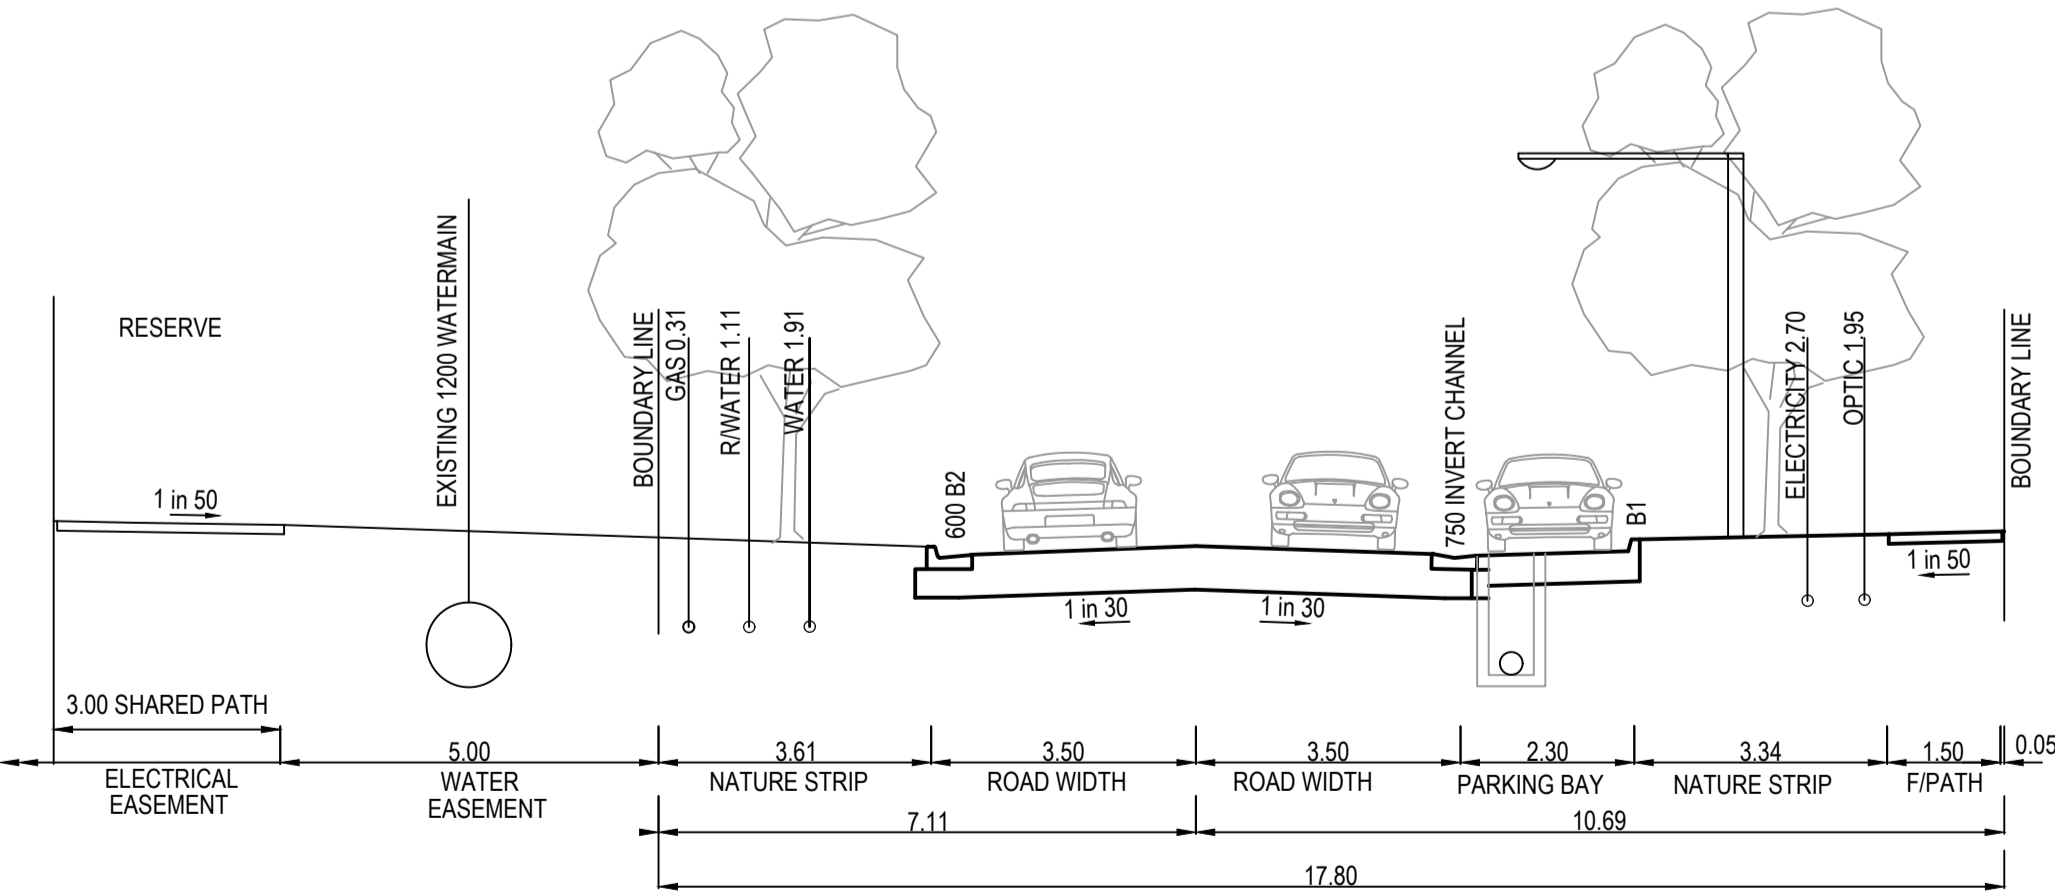

17.8m ROAD RESERVE  
ROSSO DRIVE

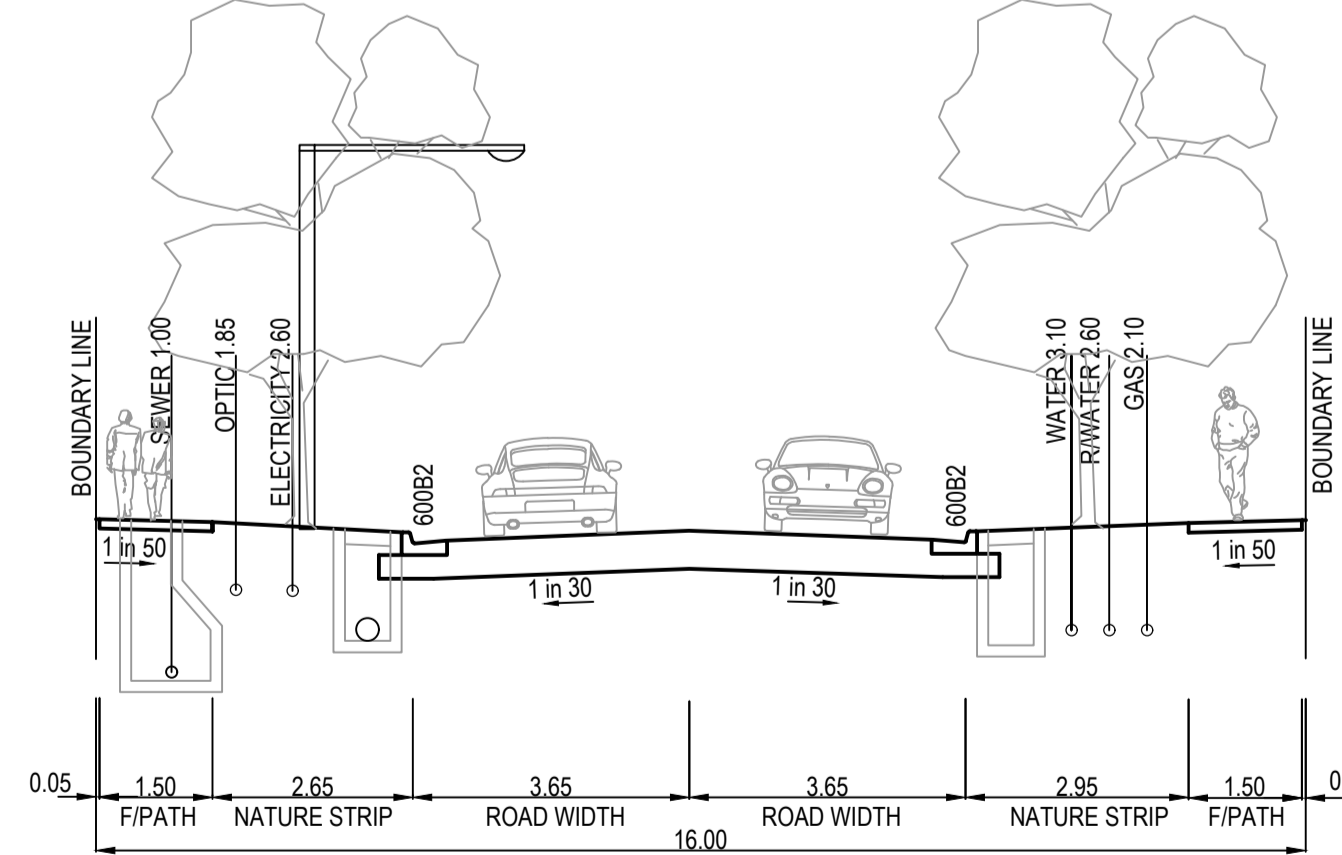

16m ROAD RESERVE  
KINDNESS ROAD

## GAS - STANDARD NOTES

- GAS MAINS, FITTINGS AND MARKER TAPE ARE TO BE SUPPLIED BY THE GAS AUTHORITY.
- EXCAVATION, SUPPLY AND PLACEMENT OF REQUIRED BACKFILL TO BE UNDERTAKEN BY OTHERS.
- NOTIFICATION MUST BE GIVEN TO THE GAS AUTHORITY TWO WEEKS PRIOR TO THE COMMENCEMENT OF EXCAVATION WORKS.

## REINFORCED CONCRETE PIPE

- ALL STORMWATER DRAINAGE PIPES SHALL NOT BE SUBJECTED TO CONSTRUCTION TRAFFIC LOADING DURING CONSTRUCTION UNLESS THE PIPE STRENGTH CHARACTERISTICS HAVE BEEN COMPUTED AND APPROVED BY THE CONTRACTORS ENGINEER. COMPUTATIONS ARE TO ACCORD WITH AS.3725-2007. LOADS ON BURIED PIPES.
- CONCRETE PIPES DAMAGED DUE TO CONSTRUCTION LOADS SHALL BE REPLACED & RELAID AT THE CONTRACTOR'S COST.

## WARNING

**SAFETY MEASURES REQUIRED**  
Please note there are risks attached to the construction of this project, and any ongoing maintenance of structures. Consider the safety of all. For potential risks, consequences and controls refer to Safety In Design Risk Register SID P4.EG.2360E-06-500  
**ASSESS THE RISK - STAY SAFE**

## WARNING

**BEWARE OF UNDERGROUND SERVICES**  
The locations of underground services are approximate only and their exact position should be proven on site. No guarantee is given that all existing services are shown. Locate all underground services before commencement of works  
**DIAL 1100 BEFORE YOU DIG**  
www.1100.com.au



## AS CONSTRUCTED PLANS

The purpose of these as-constructed plans is to update the design drawings to show significant changes which occurred during construction. Note that the levels shown on these plans are design levels, and have not been verified by survey. All information shown on these plans should be verified on site. SMEC Australia Pty Ltd accept no responsibility for loss or damages resulting from the inappropriate usage of these plans.

Quality Management ISO 9001  
OHS Management AS/NZS 4801  
Environmental Management ISO 14001

PLAN OF SUB. NO.  
PS90082T  
PERMIT REF. NO.  
WYP10365/17.01

**AS CONSTRUCTED**

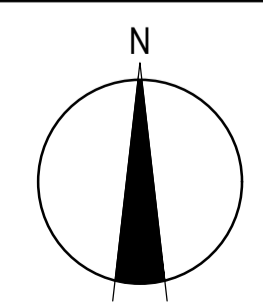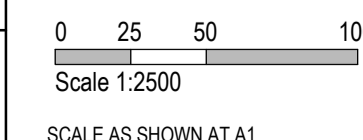

**SMEC**  
Member of the Surlana Jurong Group  
ABN 47 065 475 149  
Collins Square, Tower 4, Level 20, 727 Collins St  
Melbourne, VIC 3008  
Ph 03 9514 1500


**GROWLAND**

Marigold - Stage 7  
Wyndham City Council  
Road and Drainage  
Cover Plan & General Notes

MELWAYS REF 359 F9	PROJECT / DRAWING No. 2360E-007-101	SHEET No. 01 of 28	REVISION 1
-----------------------	--	-----------------------	---------------

ROAD NAME	ROAD RESERVE WIDTH (m)	ROAD WIDTH (m)				KERB TYPE		VERGE WIDTH (m)	
		LIP TO LIP	INV TO INV	BACK TO BACK	NTH/WEST	STH/EAST	NTH/WEST	STH/EAST	
					B1	600 B2	3.46	4.89	
ROSSO DRIVE	17.80	8.95	9.45	9.75	600 B2	3.46	4.89		
RECOGNITION AVENUE	14.50	6.40	7.30	7.60	600 B2	2.70	4.50		
PRAYSE ROAD	16.00	6.40	7.30	7.60	600 B2	4.20	4.50		
FLOCK STREET	16.00	6.40	7.30	7.60	600 B2	4.20	4.50		
KINDNESS ROAD	16.00	6.40	7.30	7.60	600 B2	4.20	4.50		
REUNION ROAD	16.00	6.40	7.30	7.60	600 B2	4.20	4.50		
PADMA BOULEVARD	14.50	6.40	7.30	7.60	600B2	4.50	2.70		

ROAD NAME	SERVICES OFFSET TABLE				
	GAS	WATER	RECYCLED WATER	ELECTRICITY	OPTIC FIBRE
	OFFSET (m)	OFFSET (m)	OFFSET (m)	OFFSET (m)	OFFSET (m)
ROSSO DRIVE	0.31 W	1.91 W	1.11 W	2.70 E	1.95 E
RECOGNITION AVENUE	2.10 S&W	3.10 S&W	2.60 S&W	1.15 N&E	0.40 N&E
PRAYSE ROAD	2.10 S	3.10 S	2.60 S	2.60 N	1.85 N
FLOCK STREET	2.10 S	3.10 S	2.60 S	2.60 N	1.85 N
KINDNESS ROAD	2.10 E	3.10 E	2.60 E	2.60 W	1.85 W
REUNION ROAD	2.10 N	3.10 N	2.60 N	2.60 S	1.85 S
PADMA BOULEVARD	2.10 W	3.12 W	2.57 W	1.15 E	0.40 E

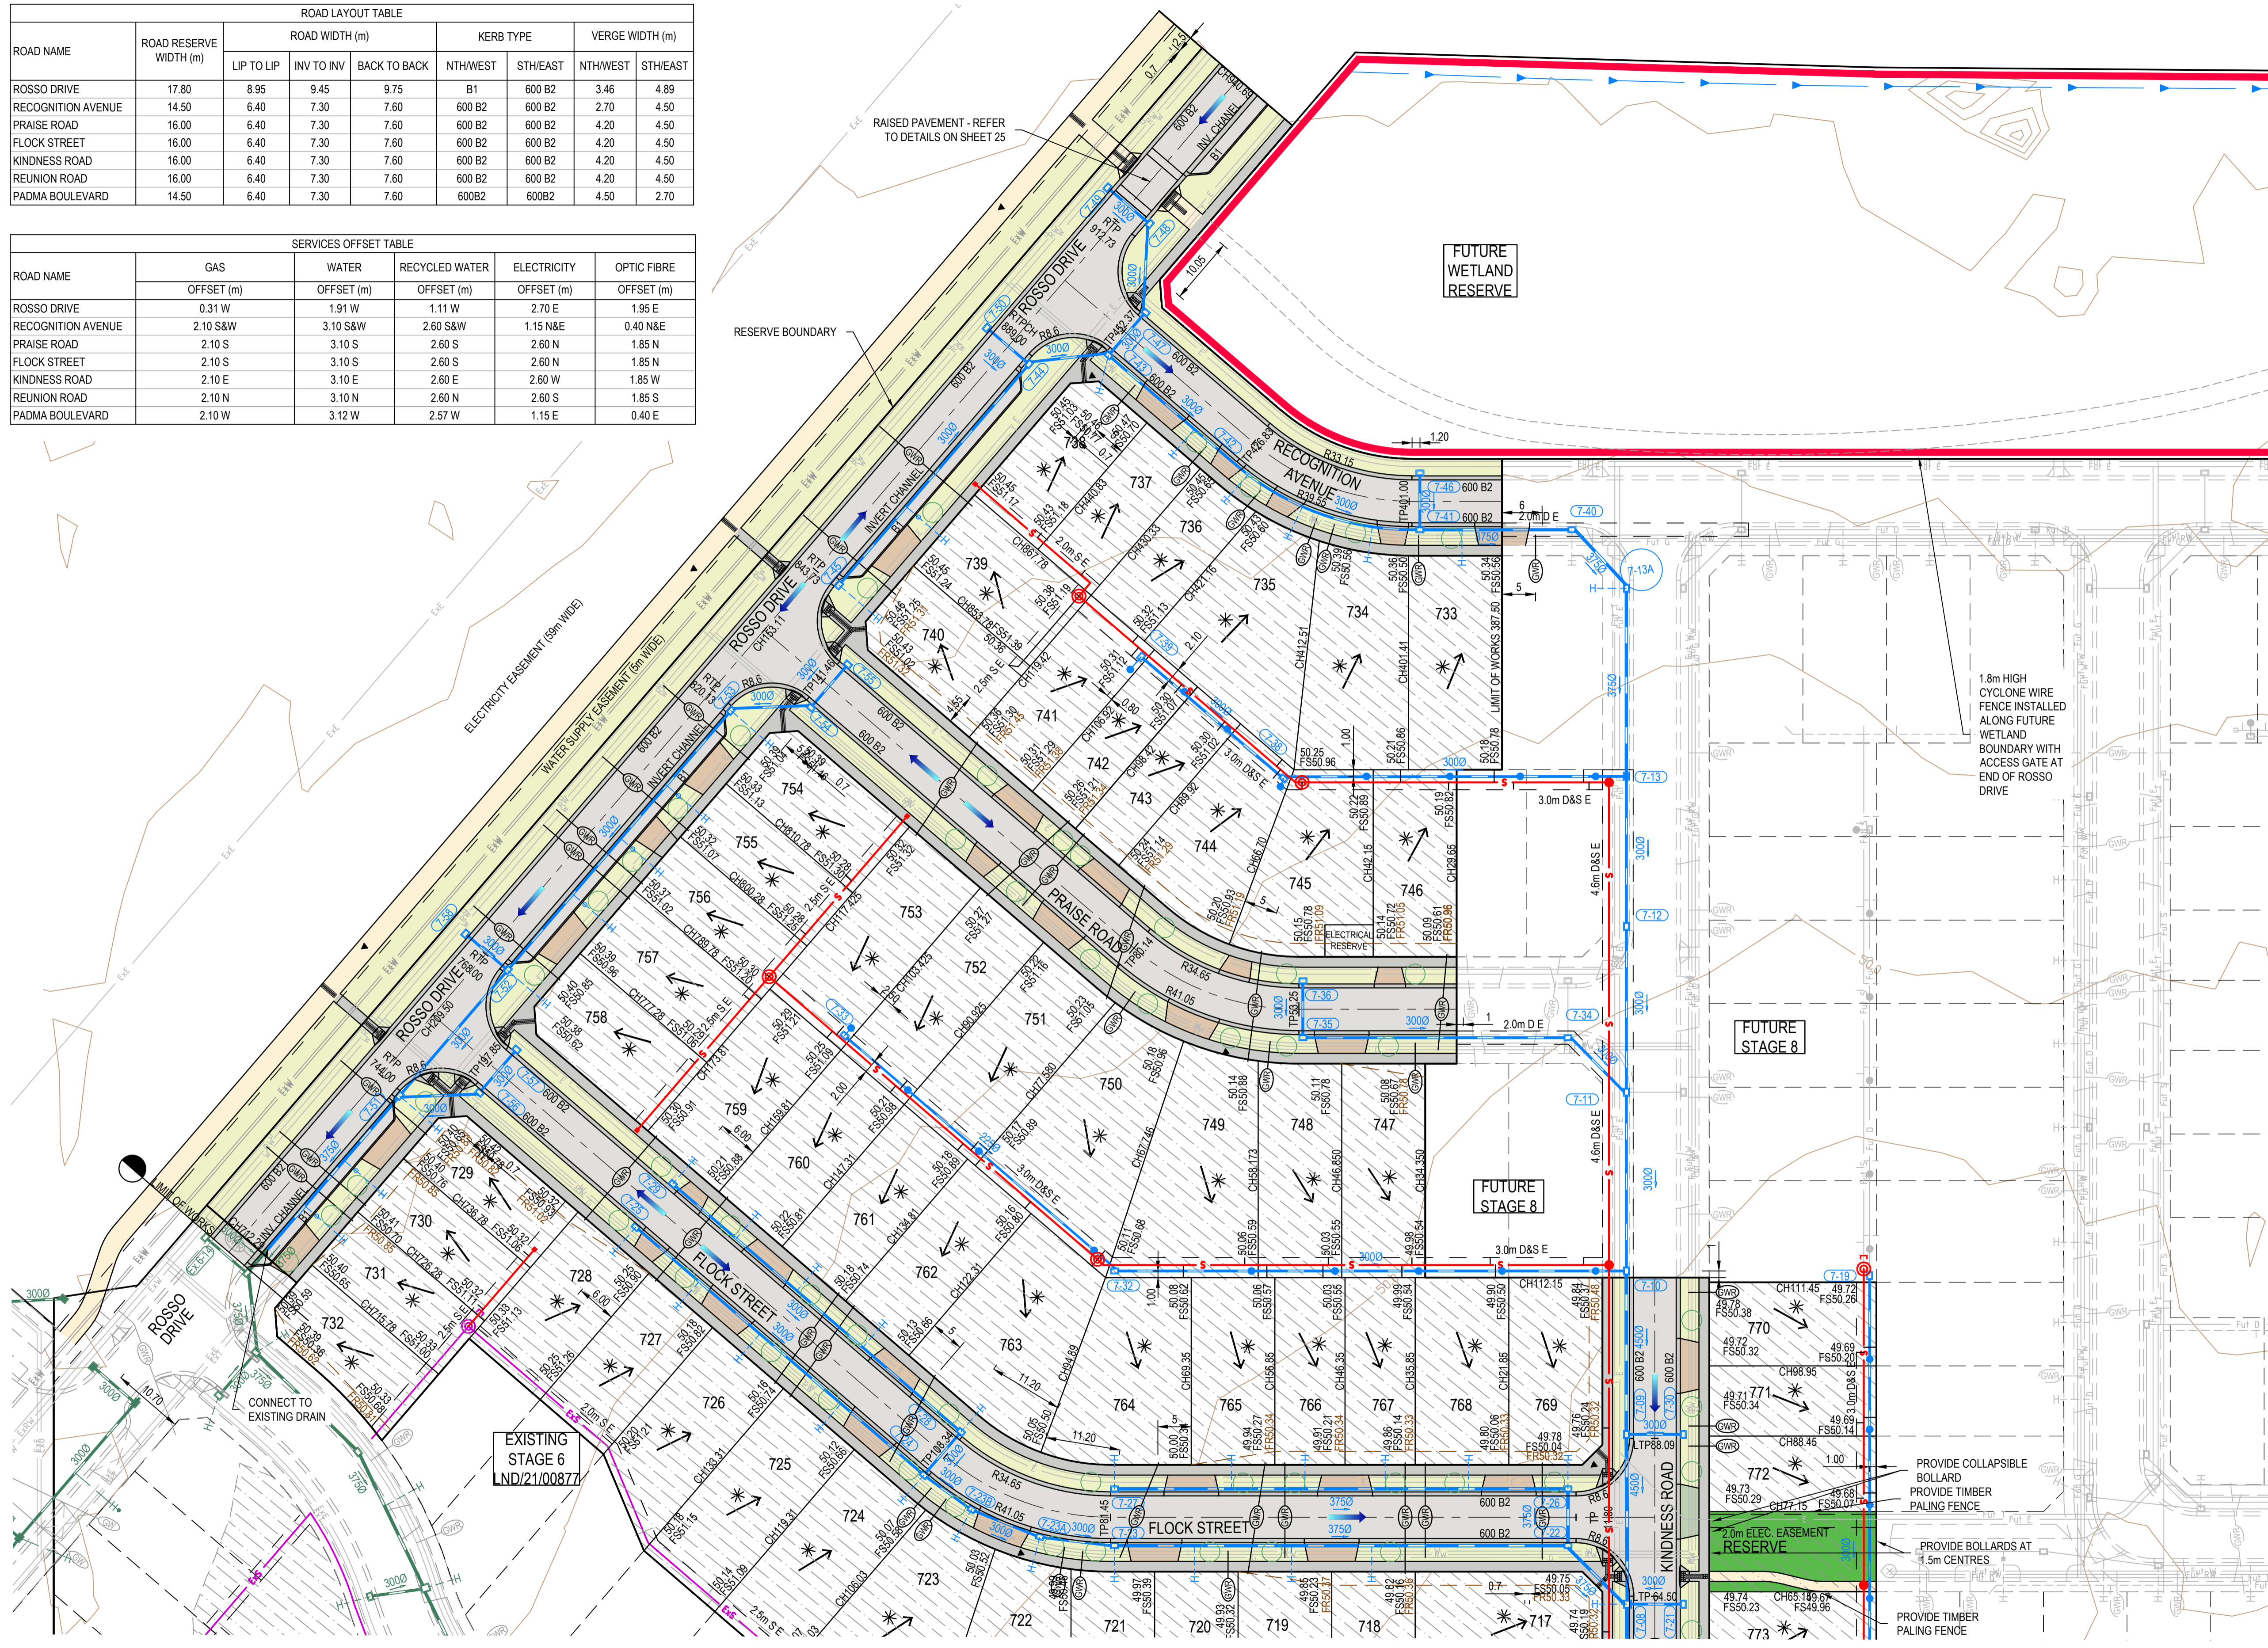

LEGEND - LAYOUT PLAN	
ALL PROPOSED, FUTURE & EXISTING SERVICE LOCATIONS ARE SHOWN INDICATIVELY	
	STORMWATER DRAIN, PIT & PROPERTY INLET
	SWALE DRAIN
	SEWER & MAINTENANCE STRUCTURES
	HOUSE DRAIN
	ELECTRICITY (U.GROUND)
	ELECTRICITY (O.HEAD)
	GAS
	TELSTRA
	OPTIC FIBRE
	WATER
	RECYCLED WATER
	AG. DRAIN
	SERVICE CONDUITS
	TACTILE PAVERS
	EXISTING STORMWATER DRAIN
	EXISTING MAIN DRAIN
	EXISTING SWALE DRAIN
	EXISTING SEWER & MAINTENANCE STRUCTURES
	EXISTING HOUSE DRAIN
	EXISTING ELECTRICITY (UNDER GROUND)
	EXISTING ELECTRICITY OVERHEAD
	EXISTING GAS
	EXISTING TELSTRA
	EXISTING OPTIC FIBRE
	EXISTING WATER
	EXISTING RECYCLED WATER
	EXISTING AG. DRAIN
	EXISTING SERVICE CONDUITS
	EXISTING TACTILE PAVERS
	FUTURE STORMWATER DRAIN
	FUTURE SWALE DRAIN
	FUTURE SEWER & MAINTENANCE STRUCTURES
	FUTURE HOUSE DRAIN
	FUTURE ELECTRICITY (UNDER GROUND)
	FUTURE ELECTRICITY OVERHEAD
	FUTURE GAS
	FUTURE TELSTRA
	FUTURE OPTIC FIBRE
	FUTURE WATER
	FUTURE RECYCLED WATER
	FUTURE AG. DRAIN
	FUTURE SERVICE CONDUITS
	FUTURE TACTILE PAVERS
	ZERO LOT LINES
	141.34 EXISTING SURFACE LEVEL
	FS140.35 EXISTING BUILDING LINE LEVEL
	FR157.40 EXISTING RIDGE LINE LEVEL
	CH270.00 CHAINAGE
	STRUCTURAL FILL > 200mm DEEP
	EXISTING STRUCTURAL FILL > 200mm DEEP
	CUT > 200mm DEEP
	DIRECTION OF FALL
	OVERLAND FLOW
	GRADED IN DIRECTION OF FALL TO LEVEL INDICATED
	EDGE STRIP, SUBSOIL DRAIN, "NO ROAD" SIGN & BARRIER
	EXISTING TREE TO BE RETAINED
	EXISTING TREE TO BE REMOVED
	PERMANENT SURVEY MARK
	TEMPORARY BENCH MARK
	PROPOSED DRIVEWAY & FOOTPATH
	PROPOSED SHARED FOOTPATH
	EXISTING ROAD PAVING
	3m DIAMETER TREE ZONE
	CYCLONE WIRE FENCE

**WARNING**  
**BEWARE OF UNDERGROUND SERVICES**  
 The locations of underground services are approximate only and their exact position should be proven on site.  
 No guarantee is given that all existing services are shown.  
 Locate all underground services before commencement of works  
**DIAL 1100 BEFORE YOU DIG**  
[www.1100.com.au](http://www.1100.com.au)

REFER SHEET 2360E-007-112 FOR CONTINUATION

**AS CONSTRUCTED PLANS**  
 The purpose of these as-constructed plans is to update the design drawings to show significant changes which occurred during construction. Note that the levels shown on these plans are design levels, and have not been verified by survey. All information shown on these plans should be verified on site. SMEC Australia Pty Ltd accept no responsibility for loss or damages resulting from the inappropriate usage of these plans.

Quality Management ISO 9001  
 OHS Management AS/NZS 4801  
 Environmental Management ISO 14001

PLAN OF SUB. NO. PS900882T  
 PERMIT REF. NO. WYP10365/17.01

**AS CONSTRUCTED**

Scale 1:500  
 SCALE AS SHOWN AT 1


**SMEC**  
 Member of the Surlana Jurong Group  
 ABN 47 065 475 149  
 Collins Square, Tower 4, Level 20, 727 Collins St  
 Melbourne, VIC 3008  
 Ph 03 9514 1500

**GROWLAND**

Marigold - Stage 7  
 Wyndham City Council  
 Road and Drainage  
 Layout Plan - 1

MELWAYS REF 359 F9  
 PROJECT / DRAWING No 2360E-007-111  
 SHEET No 02 of 28  
 REVISION 3

REFER SHEET 2360E-007-111 FOR CONTINUATION

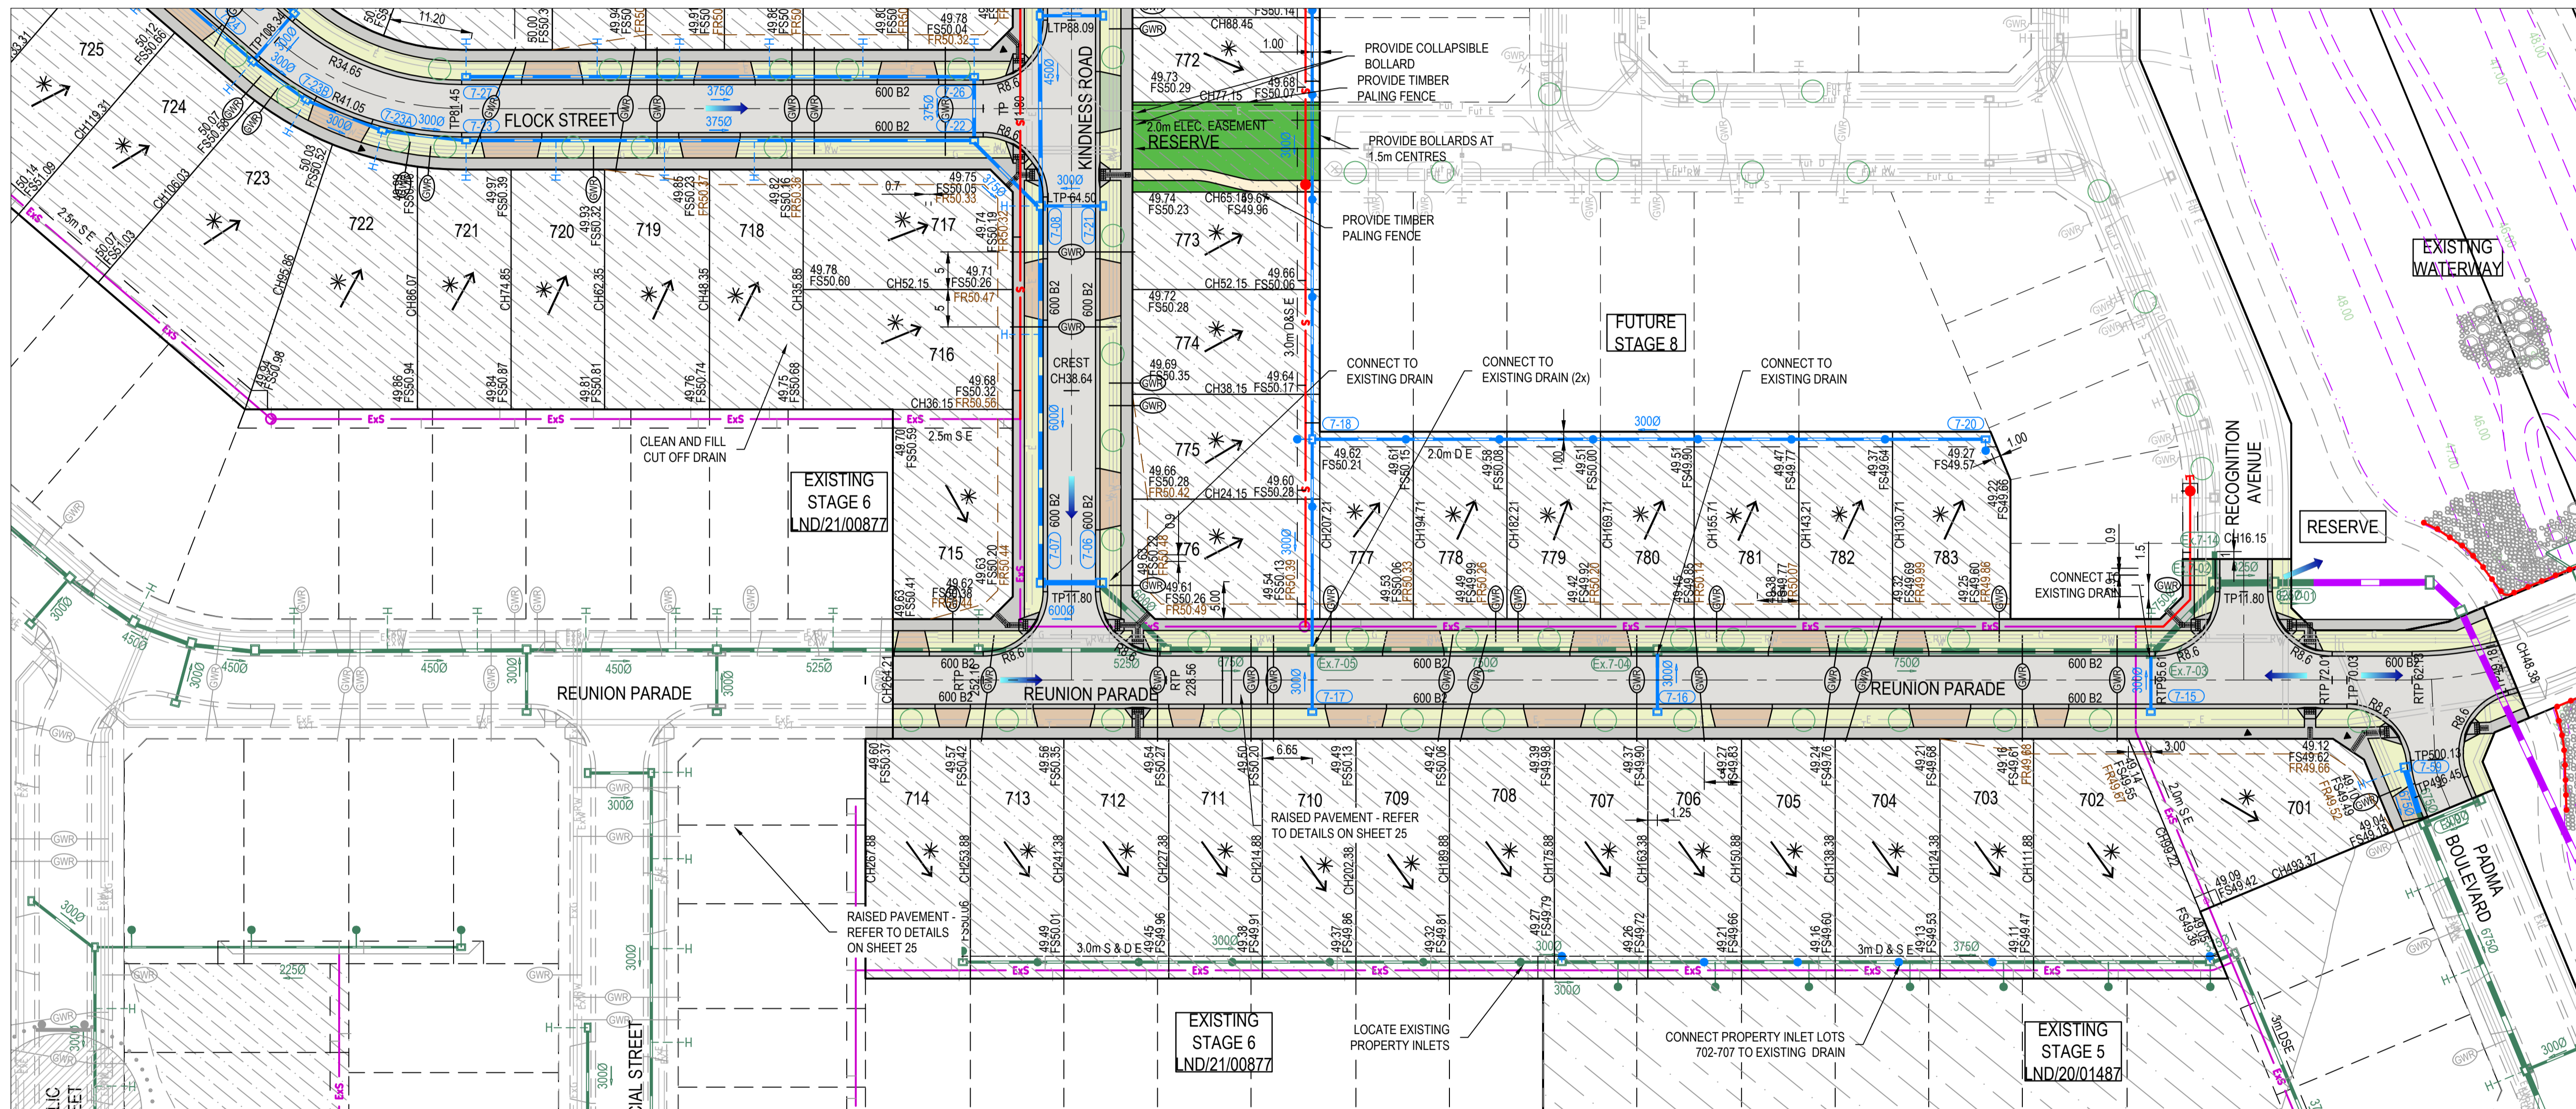

LEGEND - LAYOUT PLAN	
ALL PROPOSED, FUTURE & EXISTING SERVICE LOCATIONS ARE SHOWN INDICATIVELY	
	STORMWATER DRAIN, PIT & PROPERTY INLET
	SWALE DRAIN
	SEWER & MAINTENANCE STRUCTURES
	HOUSE DRAIN
	ELECTRICITY (U/GROUND)
	ELECTRICITY (O/HEAD)
	GAS
	TELSTRA
	OPTIC FIBRE
	WATER
	RECYCLE WATER
	AG. DRAIN
	SERVICE CONDUITS
	TACTILE PAVERS
	EXISTING STORMWATER DRAIN
	EXISTING MAIN DRAIN
	EXISTING SWALE DRAIN
	EXISTING SEWER & MAINTENANCE STRUCTURES
	EXISTING HOUSE DRAIN
	EXISTING ELECTRICITY (UNDER GROUND)
	EXISTING ELECTRICITY OVERHEAD
	EXISTING GAS
	EXISTING TELSTRA
	EXISTING OPTIC FIBRE
	EXISTING WATER
	EXISTING RECYCLED WATER
	EXISTING AG. DRAIN
	EXISTING SERVICE CONDUITS
	EXISTING TACTILE PAVERS
	FUTURE STORMWATER DRAIN
	FUTURE SWALE DRAIN
	FUTURE SEWER & MAINTENANCE STRUCTURES
	FUTURE HOUSE DRAIN
	FUTURE ELECTRICITY (UNDER GROUND)
	FUTURE ELECTRICITY OVERHEAD
	FUTURE GAS
	FUTURE TELSTRA
	FUTURE OPTIC FIBRE
	FUTURE WATER
	FUTURE RECYCLED WATER
	FUTURE AG. DRAIN
	FUTURE SERVICE CONDUITS
	FUTURE TACTILE PAVERS
	ZERO LOT LINES
	141.34 EXISTING SURFACE LEVEL
	FS140.35 FINISHED BUILDING LINE LEVEL
	FR157.40 FINISHED RIDGE LINE LEVEL
	CH270.00 CHAINAGE
	STRUCTURAL FILL > 200mm DEEP
	EXISTING STRUCTURAL FILL > 200mm DEEP
	CUT > 200mm DEEP
	DIRECTION OF FALL
	OVERLAND FLOW
	GRADED IN DIRECTION OF FALL TO LEVEL INDICATED
	EDGE STRIP, SUBSOIL DRAIN, "NO ROAD" SIGN & BARRIER
	EXISTING TREE TO BE RETAINED
	EXISTING TREE TO BE REMOVED
	PERMANENT SURVEY MARK
	TEMPORARY BENCH MARK
	PROPOSED DRIVEWAY & FOOTPATH
	PROPOSED SHARED FOOTPATH
	EXISTING ROAD PAVING
	3m DIAMETER TREE ZONE


**WARNING**  
**BEWARE OF UNDERGROUND SERVICES**  
 The locations of underground services are approximate only and their exact position should be proven on site.  
 No guarantee is given that all existing services are shown.  
 Locate all underground services before commencement of works  
**DIAL 1100 BEFORE YOU DIG**  
[www.1100.com.au](http://www.1100.com.au)

**AS CONSTRUCTED PLANS**

The purpose of these as-constructed plans is to update the design drawings to show significant changes which occurred during construction. Note that the levels shown on these plans are design levels, and have not been verified by survey. All information shown on these plans should be verified on site. SMEC Australia Pty Ltd accept no responsibility for loss or damages resulting from the inappropriate usage of these plans.

PLAN OF SUB. NO. PS900882T  
 PERMIT REF. NO. WYP10365/17.01  
**AS CONSTRUCTED**

Scale 1:500  
 SCALE AS SHOWN AT A1

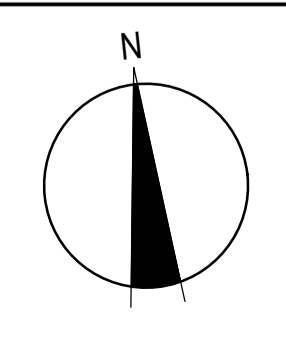


Member of the Surlana Jurong Group  
 ABN 47 065 475 149  
 Collins Square, Tower 4, Level 20, 727 Collins St  
 Melbourne, VIC 3008  
 Ph 03 9514 1500

Marigold - Stage 7  
 Wyndham City Council  
 Road and Drainage  
 Layout Plan - 2

MELWAYS REF 359 F9	PROJECT / DRAWING No 2360E-007-112	SHEET No 03 of 28	REVISION 2
-----------------------	---------------------------------------	----------------------	---------------

**WARNING**  
**BEWARE OF UNDERGROUND SERVICES**  
 The locations of underground services are approximate only and their exact position should be proven on site. No guarantee is given that all existing services are shown. Locate all underground services before commencement of works  
**DIAL 1100 BEFORE YOU DIG**  
 www.1100.com.au

**NOTES**  
 1. 90° BENDS TO HAVE CENTRELINE MARKING WITH RPPMS AT MAX 6m SPACING.  
 2. RPPMS TO BE IN ACCORDANCE WITH VICROADS TRAFFIC ENGINEERING MANUAL MANUAL VOL 2.  
 3. ALL LINEMARKING & SIGNAGE TO BE IN ACCORDANCE WITH AUSTRALIAN STANDARD AS1742.

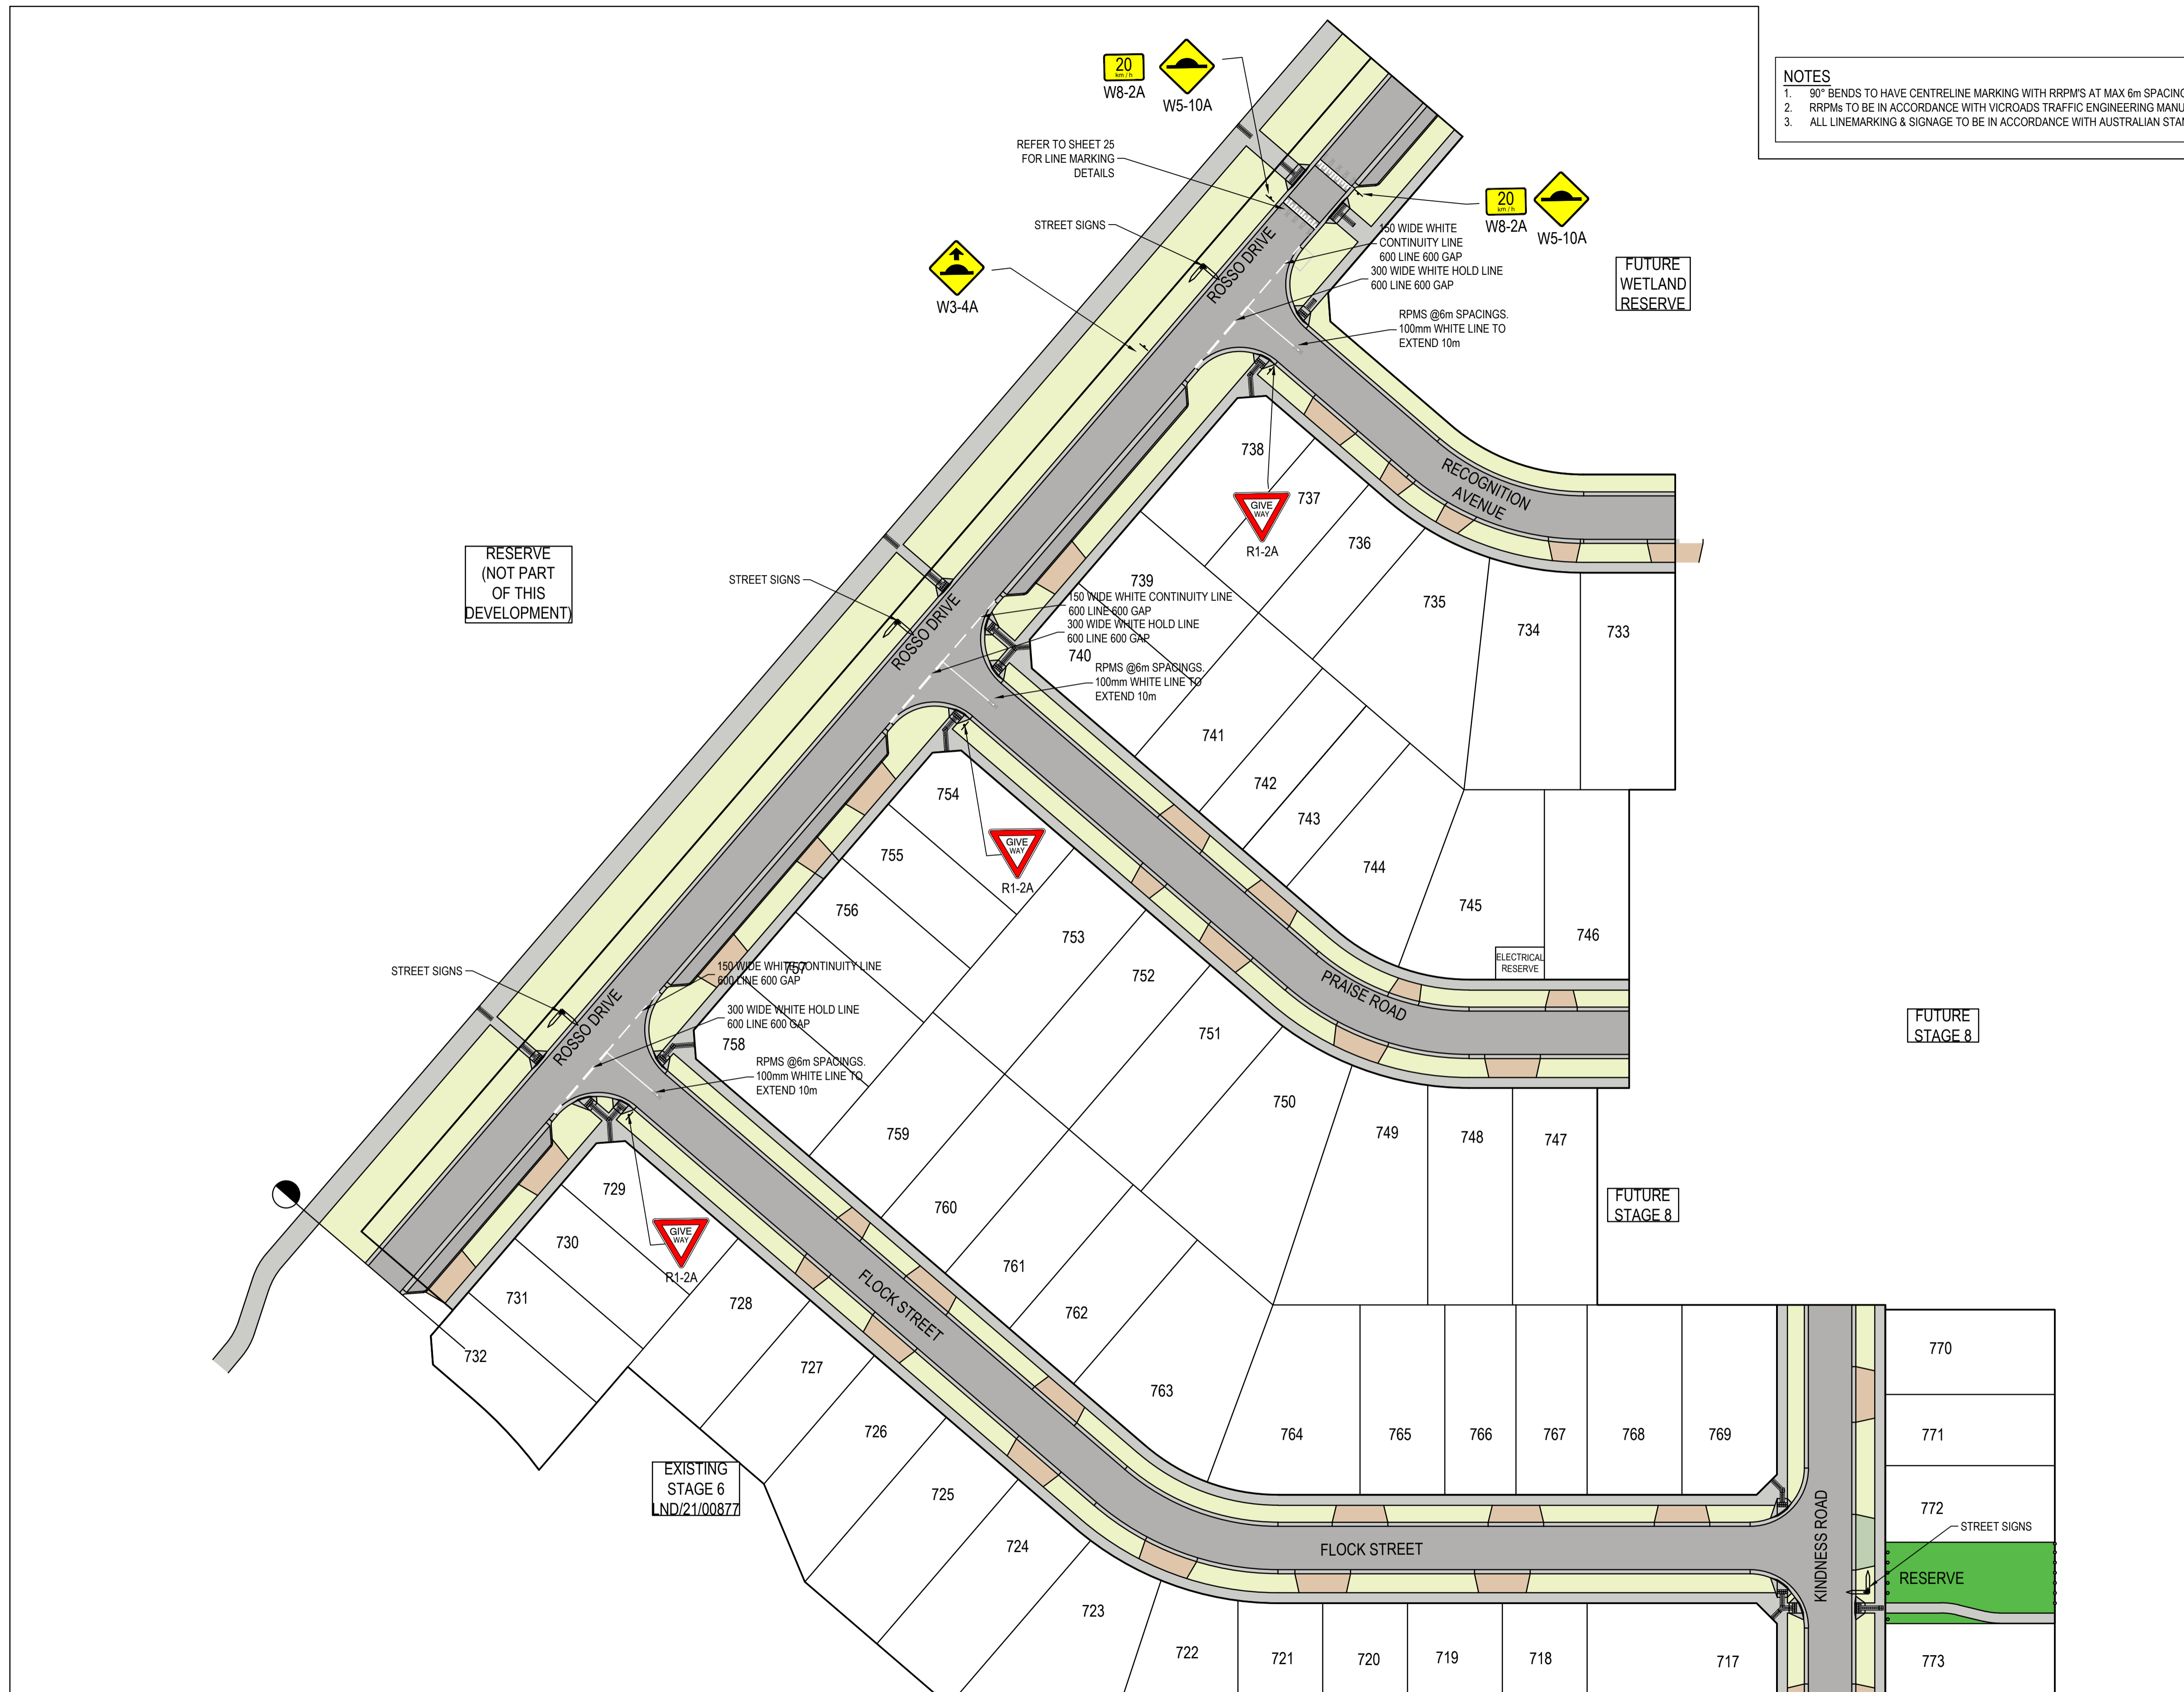



**AS CONSTRUCTED PLANS**

The purpose of these as-constructed plans is to update the design drawings to show significant changes which occurred during construction. Note that the levels shown on these plans are design levels, and have not been verified by survey. All information shown on these plans should be verified on site. SMEC Australia Pty Ltd accept no responsibility for loss or damages resulting from the inappropriate usage of these plans.



PLAN OF SUB. NO.  
 PS900882T  
 PERMIT REF. NO.  
 WYP10365/17.01

**AS CONSTRUCTED**

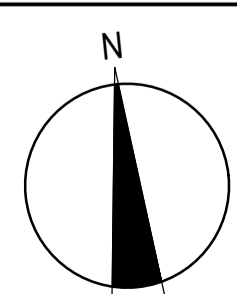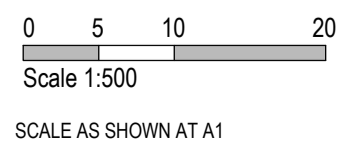


Marigold - Stage 7  
 Wyndham City Council  
 Road and Drainage  
 Signage & Linemarking Plan - 1

MELWAYS REF 359 F9	PROJECT / DRAWING No. 2360E-007-171	SHEET No. 04 of 28	REVISION 1
-----------------------	--	-----------------------	---------------

**WARNING**  
**BEWARE OF UNDERGROUND SERVICES**  
 The locations of underground services are approximate only and their exact position should be proven on site. No guarantee is given that all existing services are shown. Locate all underground services before commencement of works.  
**DIAL 1100 BEFORE YOU DIG**  
 www.1100.com.au

**NOTES**  
 1. 90° BENDS TO HAVE CENTRELINE MARKING WITH RRPMS AT MAX 6m SPACING.  
 2. RRPMS TO BE IN ACCORDANCE WITH VICROADS TRAFFIC ENGINEERING MANUAL VOL 2.  
 3. ALL LINEMARKING & SIGNAGE TO BE IN ACCORDANCE WITH AUSTRALIAN STANDARD AS1742.


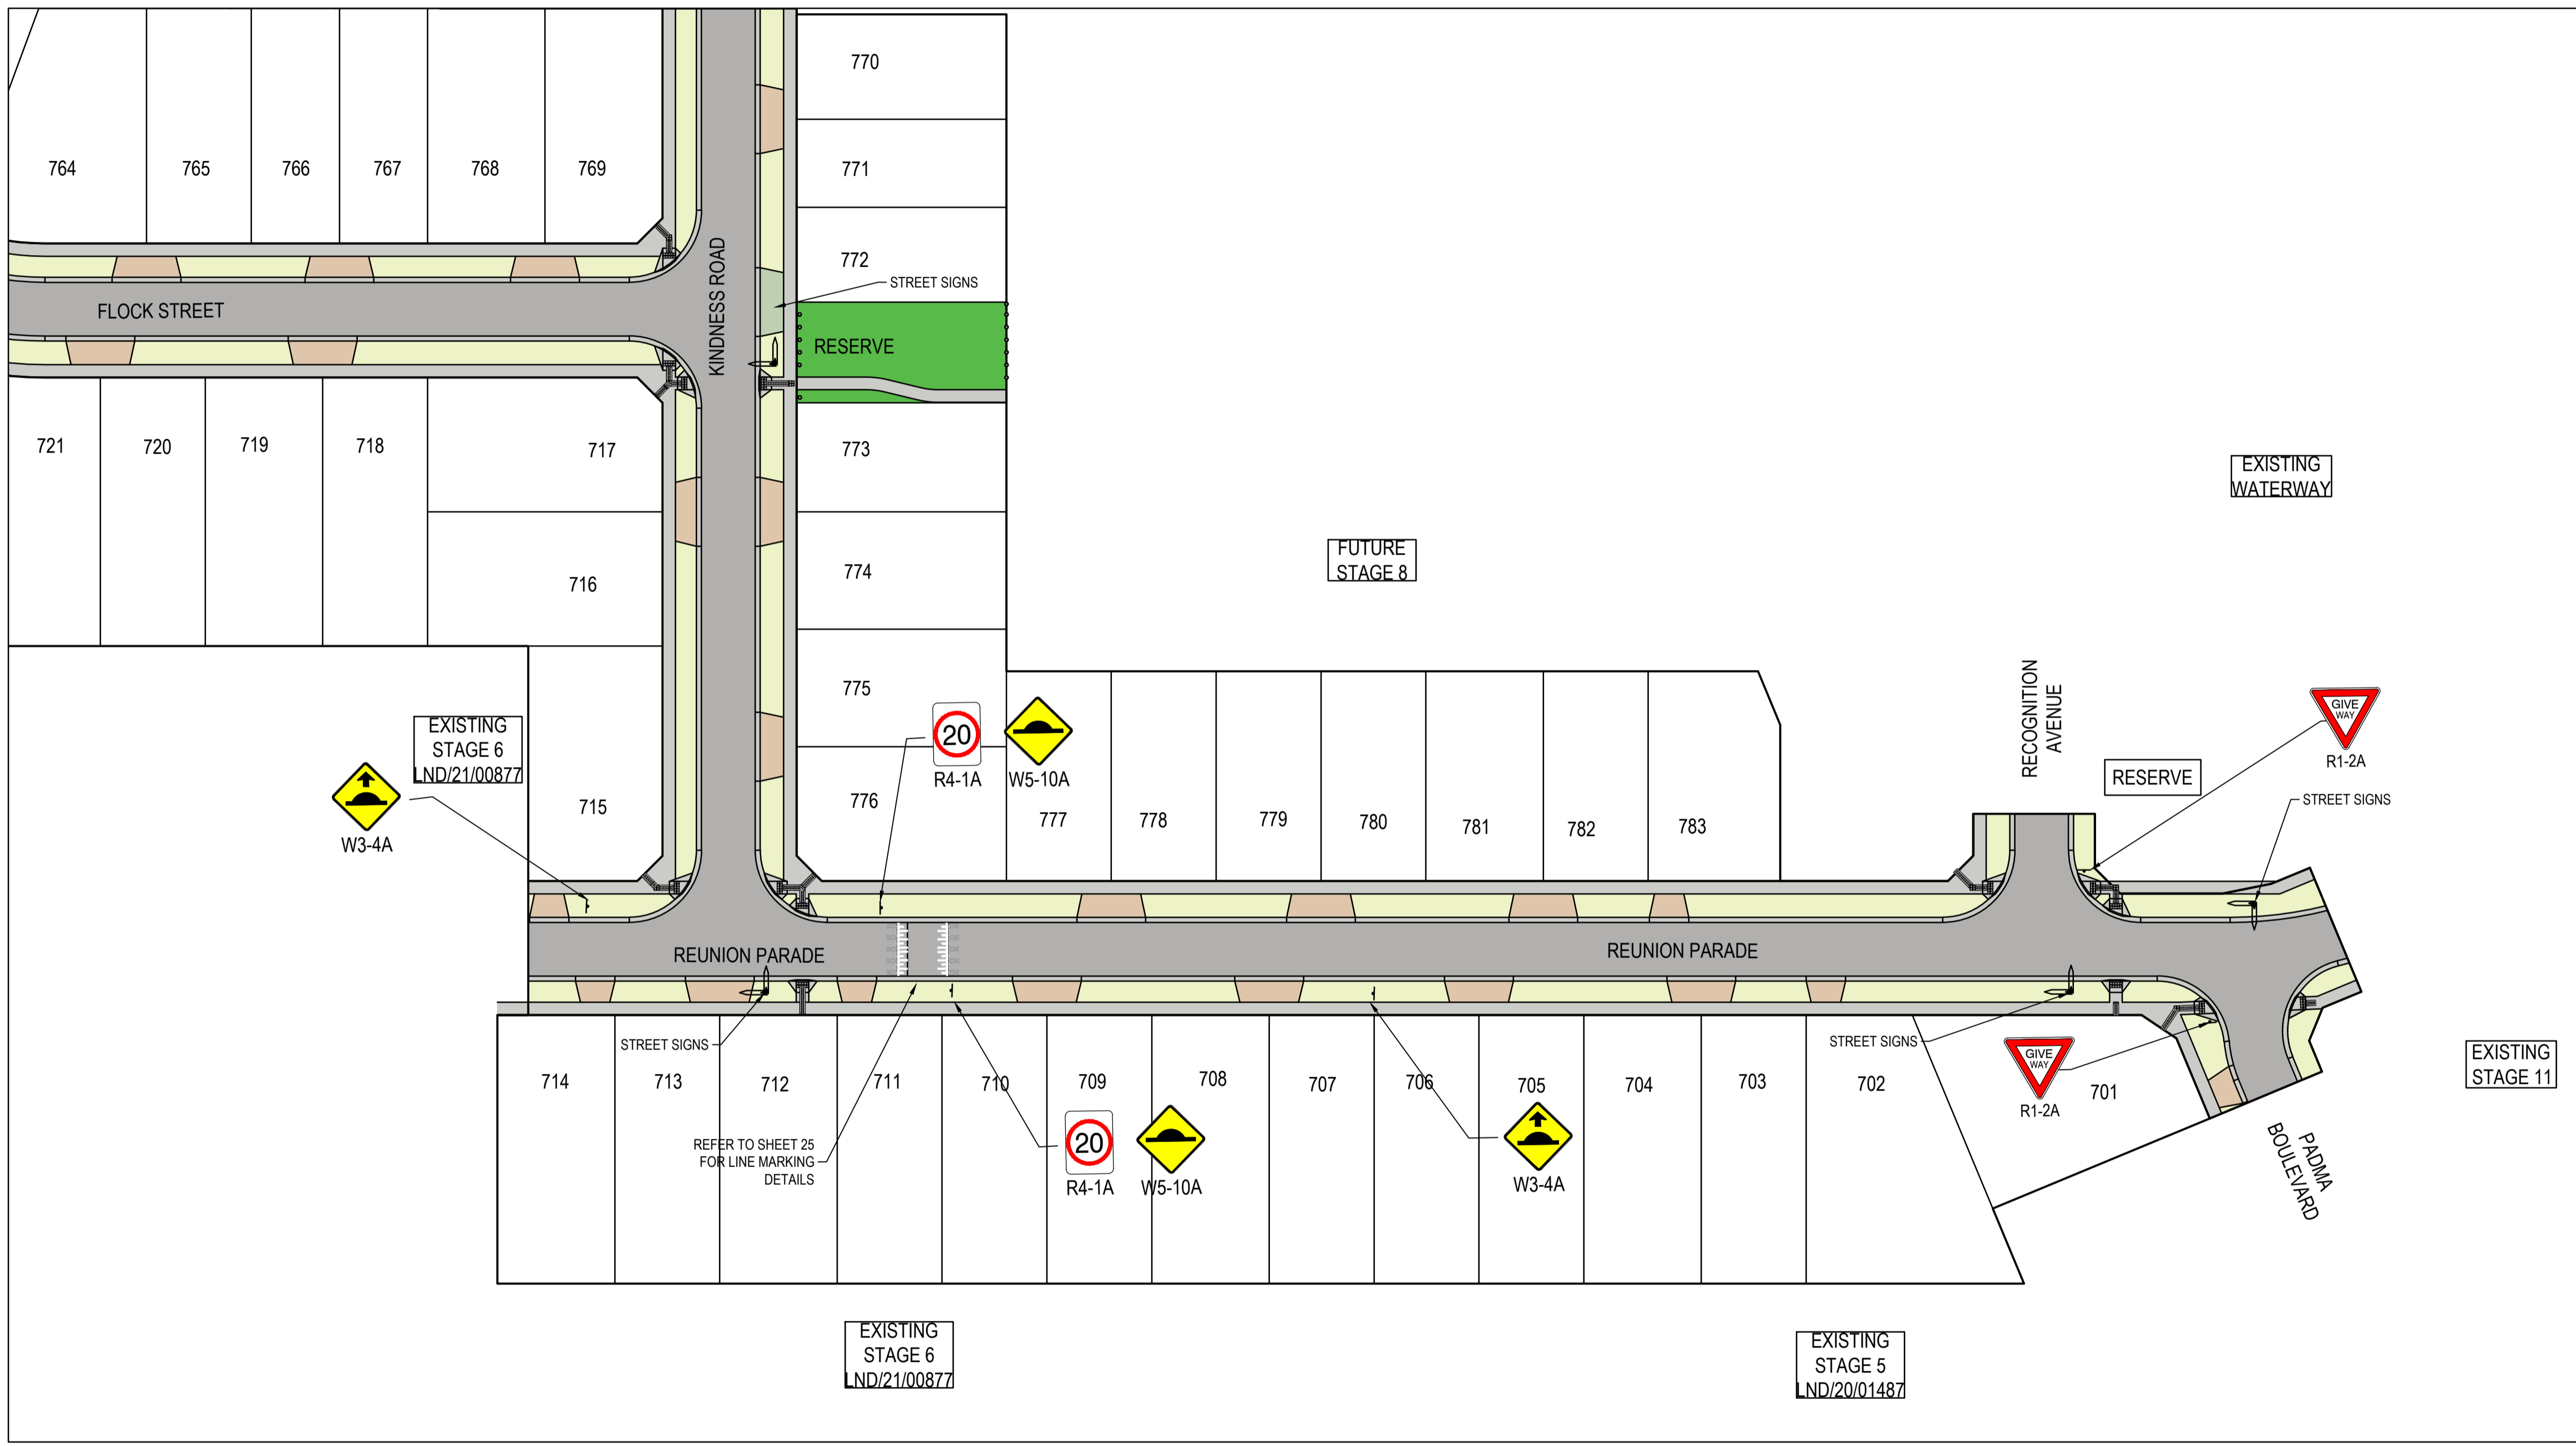


**AS CONSTRUCTED PLANS**  
 The purpose of these as-constructed plans is to update the design drawings to show significant changes which occurred during construction. Note that the levels shown on these plans are design levels, and have not been verified by survey. All information shown on these plans should be verified on site. SMEC Australia Pty Ltd accept no responsibility for loss or damages resulting from the inappropriate usage of these plans.

Quality Management ISO 9001  
 OHS Management AS/NZS 4801  
 Environmental Management ISO 14001  
 Global-Mark.com.au®

PLAN OF SUB. NO. PS900882T  
 PERMIT REF. NO. WYP10365/17.01

**AS CONSTRUCTED**


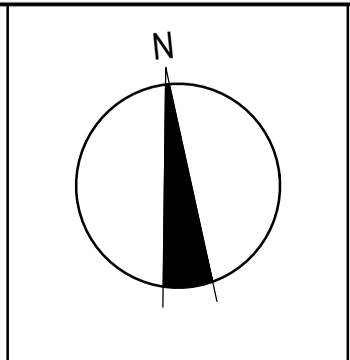
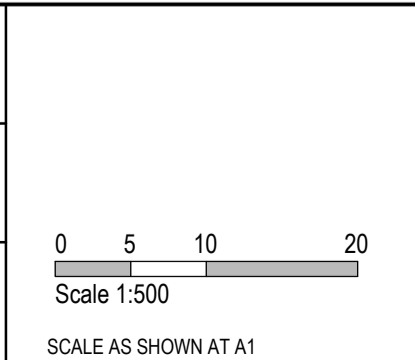


**SMEC**  
 Member of the Surlana Jurong Group  
 ABN 47 065 475 149  
 Collins Square, Tower 4, Level 20, 727 Collins St  
 Melbourne, VIC 3008  
 Ph 03 9514 1500

**GROWLAND**




Marigold - Stage 7  
 Wyndham City Council  
 Road and Drainage  
 Signage & Linemarking Plan - 2

MELWAYS REF 359 F9	PROJECT / DRAWING No. 2360E-007-172	SHEET No. 05 of 28	REVISION 1
-----------------------	--	-----------------------	---------------

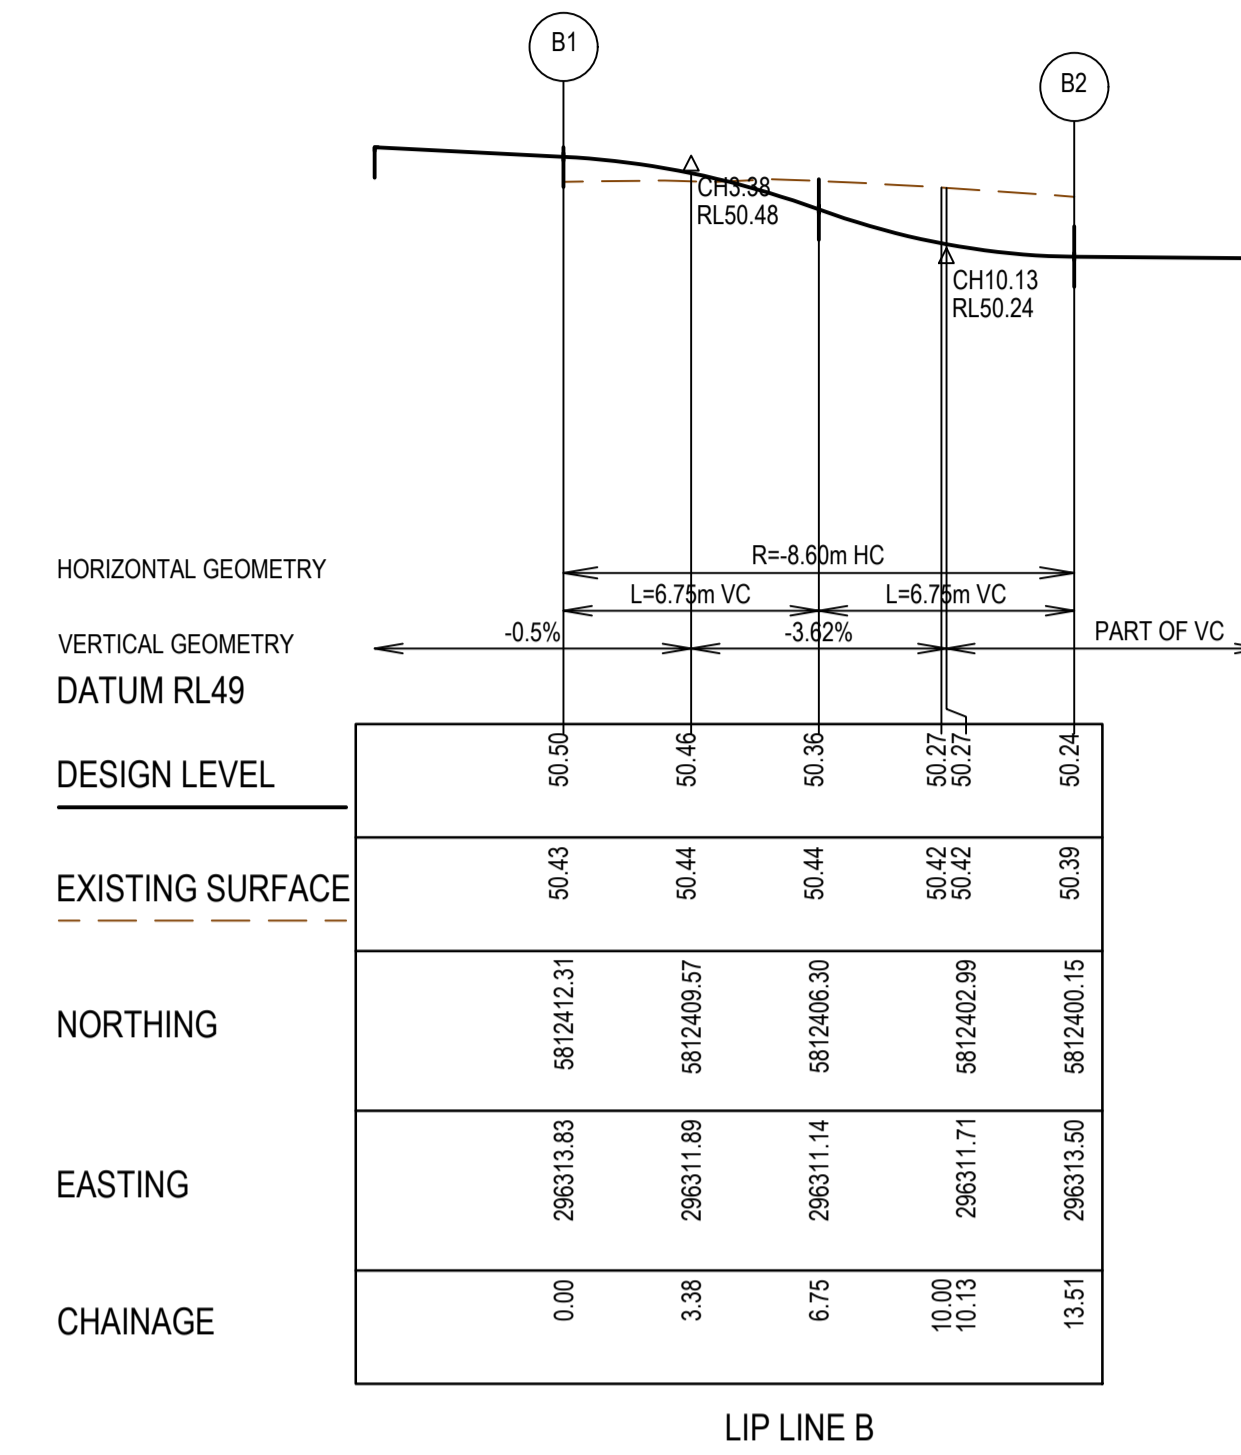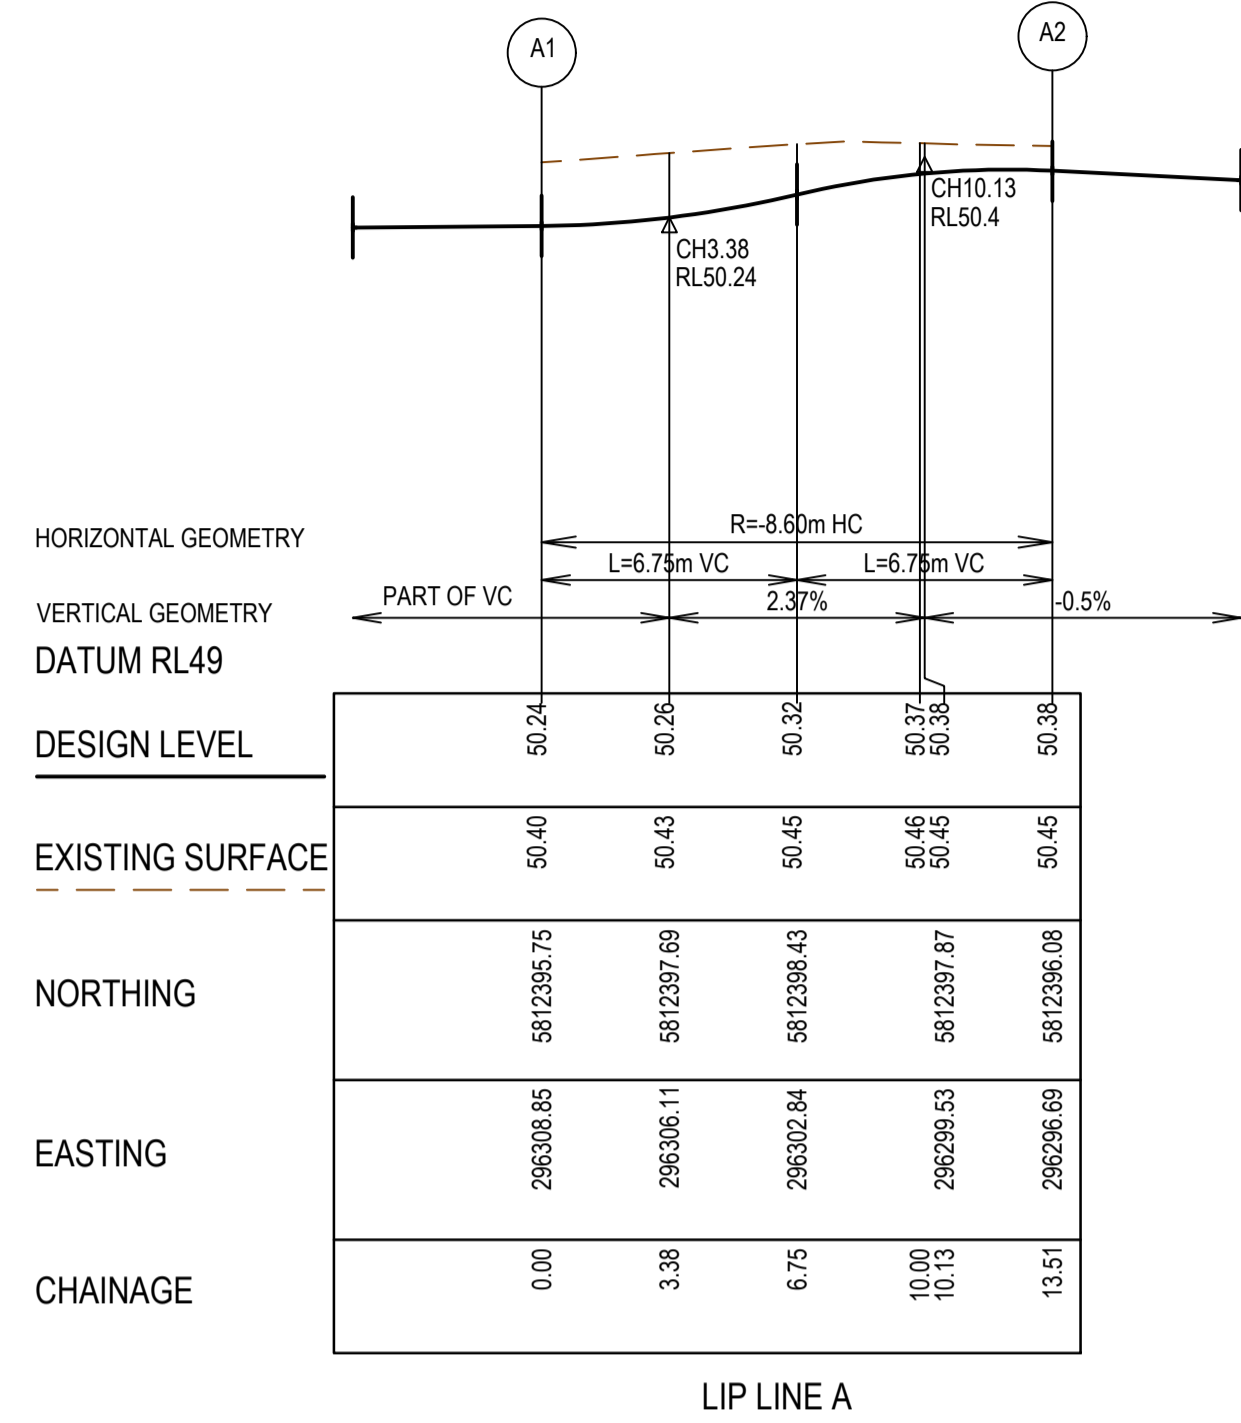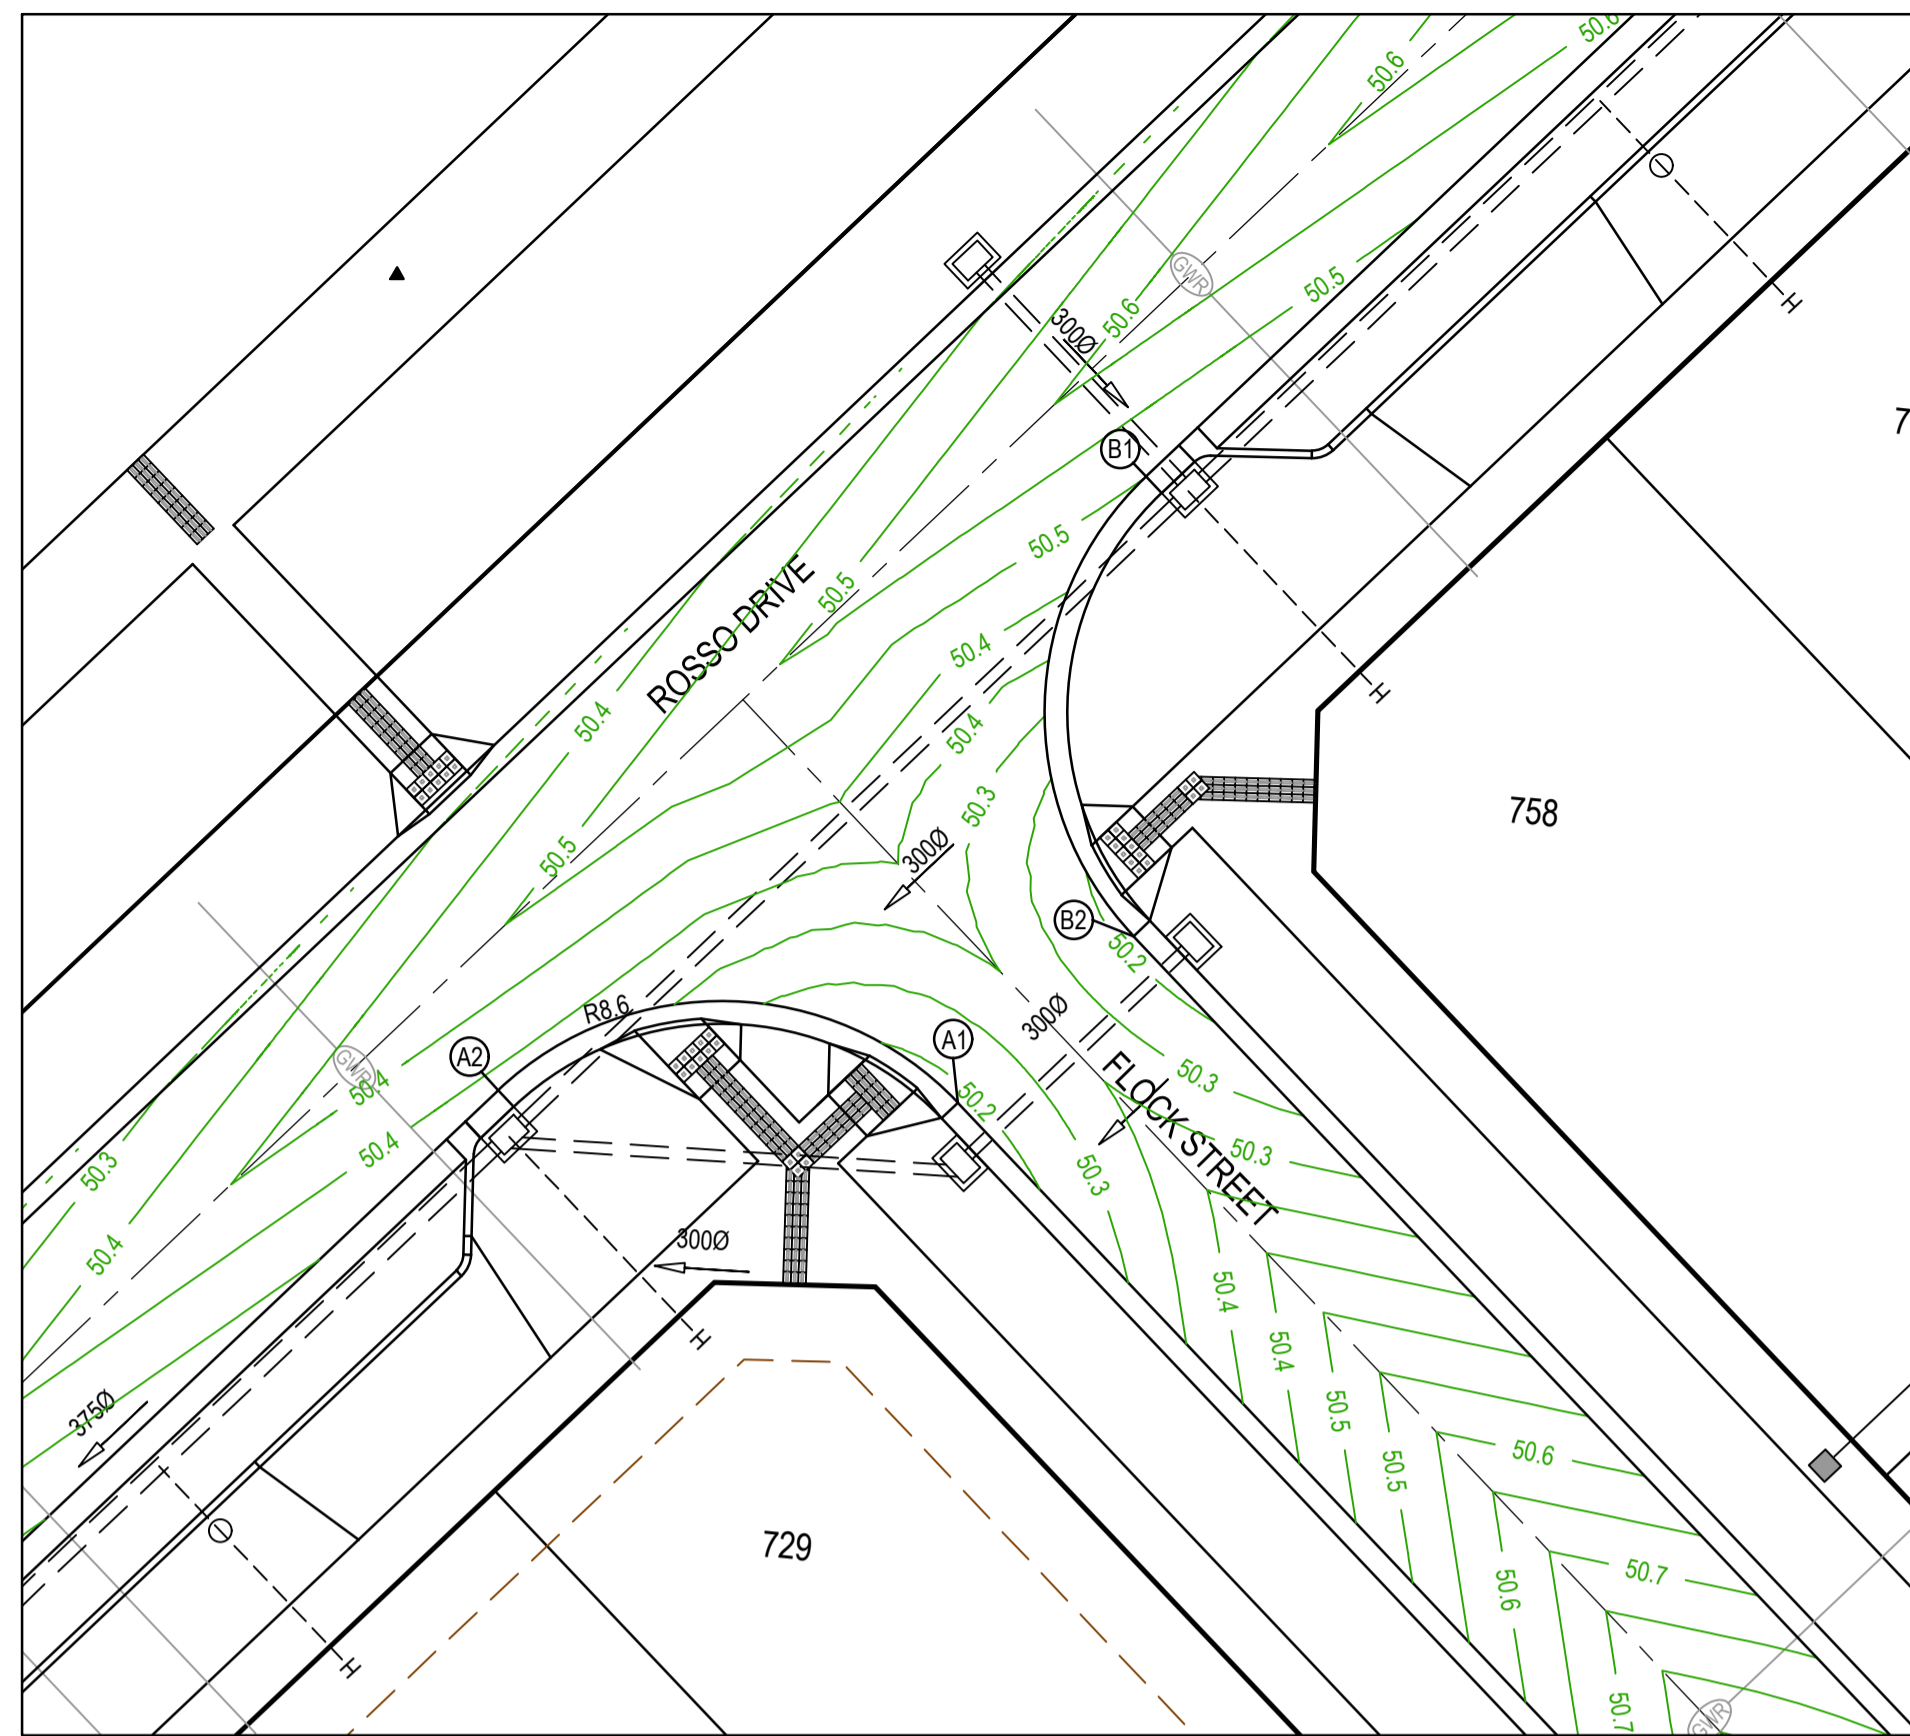

**LEGEND - INTERSECTION DETAIL PLAN**  
ALL PROPOSED, FUTURE & EXISTING SERVICE LOCATIONS ARE SHOWN INDICATIVELY

	STORMWATER DRAIN, PIT & PROPERTY INLET
	MAIN DRAIN
	SEWER & MAINTENANCE STRUCTURES
	HOUSE DRAIN
	SERVICE CONDUITS
	TACTILE PAVERS
	EXISTING STORMWATER DRAIN
	EXISTING MAIN DRAIN
	EXISTING SEWER & MAINTENANCE STRUCTURES
	EXISTING SERVICE CONDUITS
	EXISTING TACTILE PAVERS
	FUTURE STORMWATER DRAIN
	FUTURE MAIN DRAIN
	FUTURE SEWER & MAINTENANCE STRUCTURES
	FUTURE HOUSE DRAIN
	FUTURE SERVICE CONDUITS
	FUTURE TACTILE PAVERS
	EXISTING RETAINING WALL
	RETAINING WALL
	FUTURE RETAINING WALL
	EDGE STRIP, SUBSOIL DRAIN, 'NO ROAD' SIGN & BARRIER
	PERMANENT SURVEY MARK
	TEMPORARY BENCH MARK
	PROPOSED DRIVEWAY & FOOTPATH

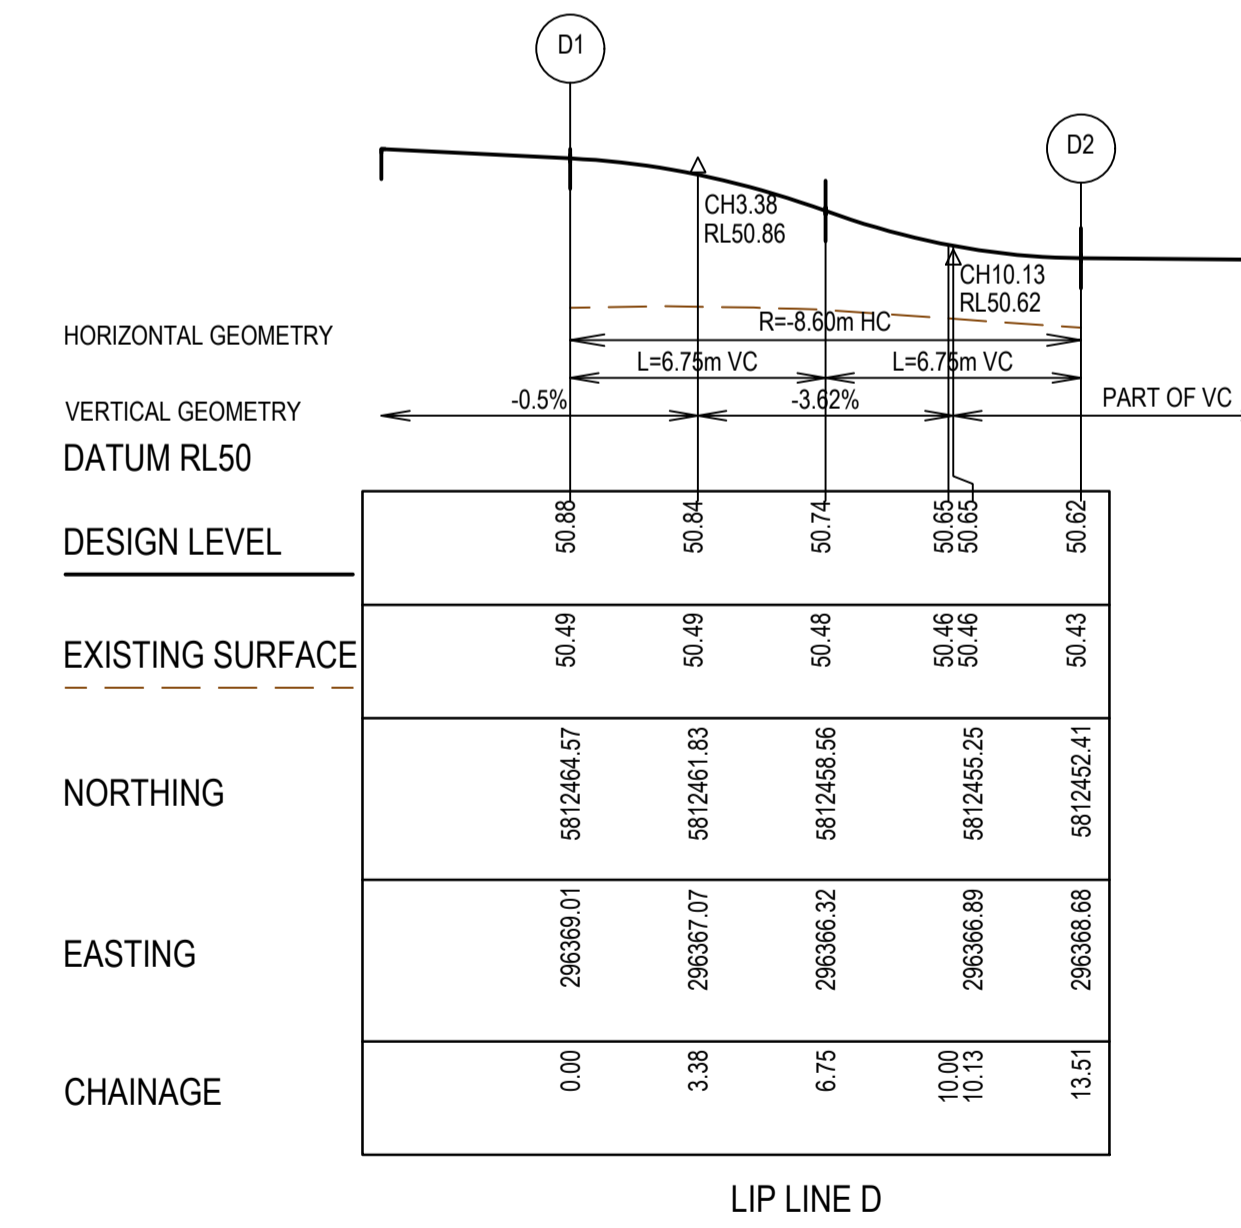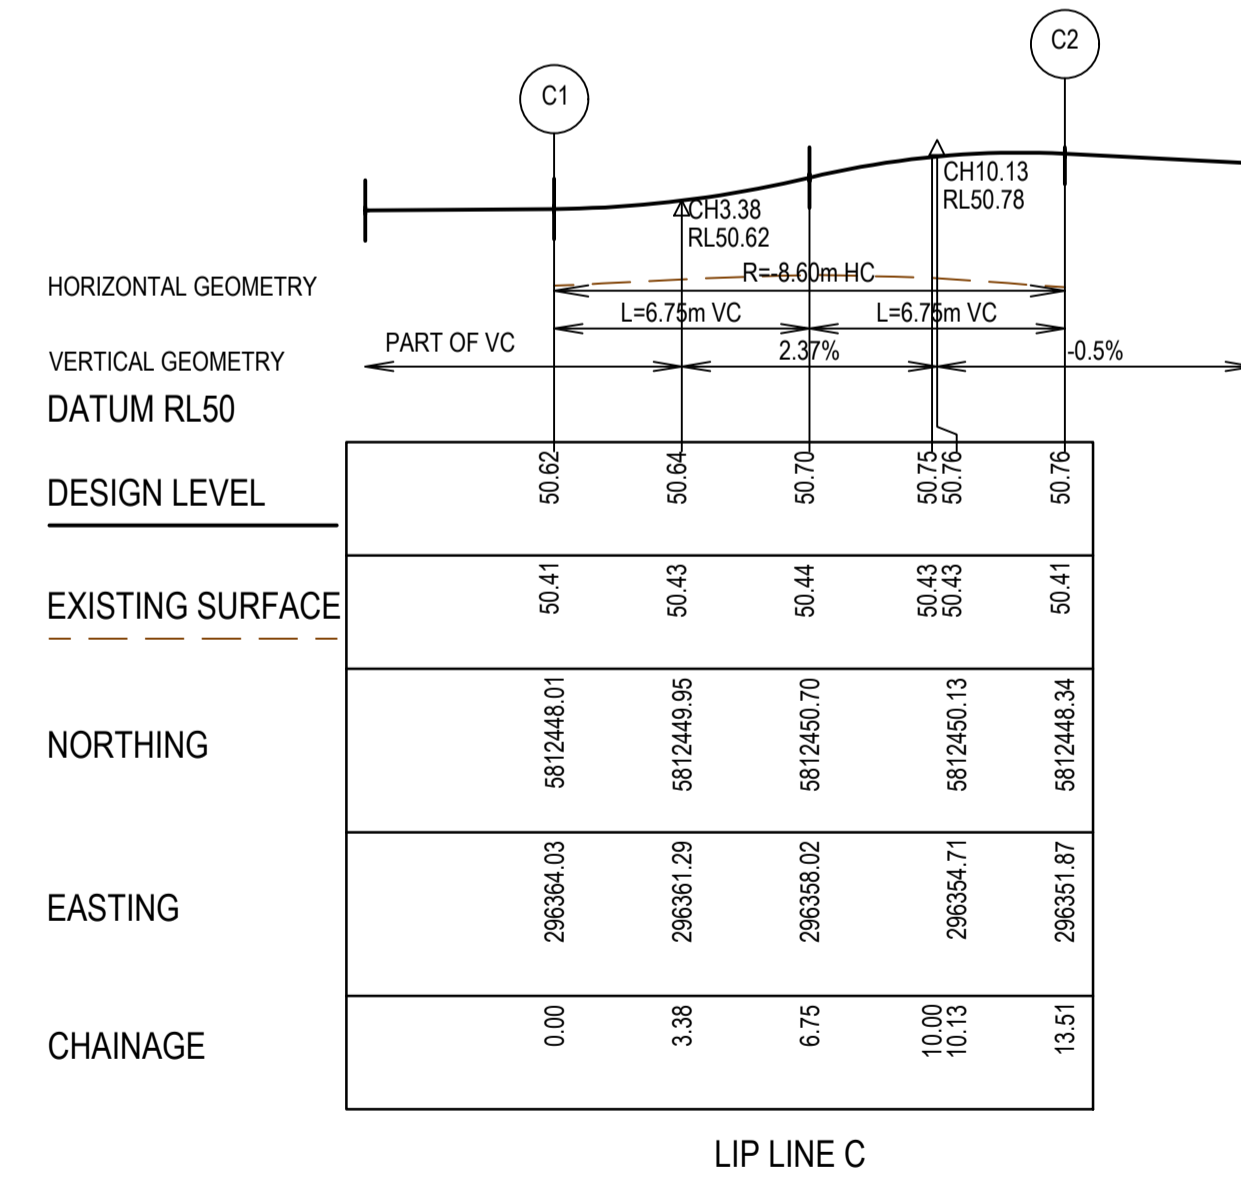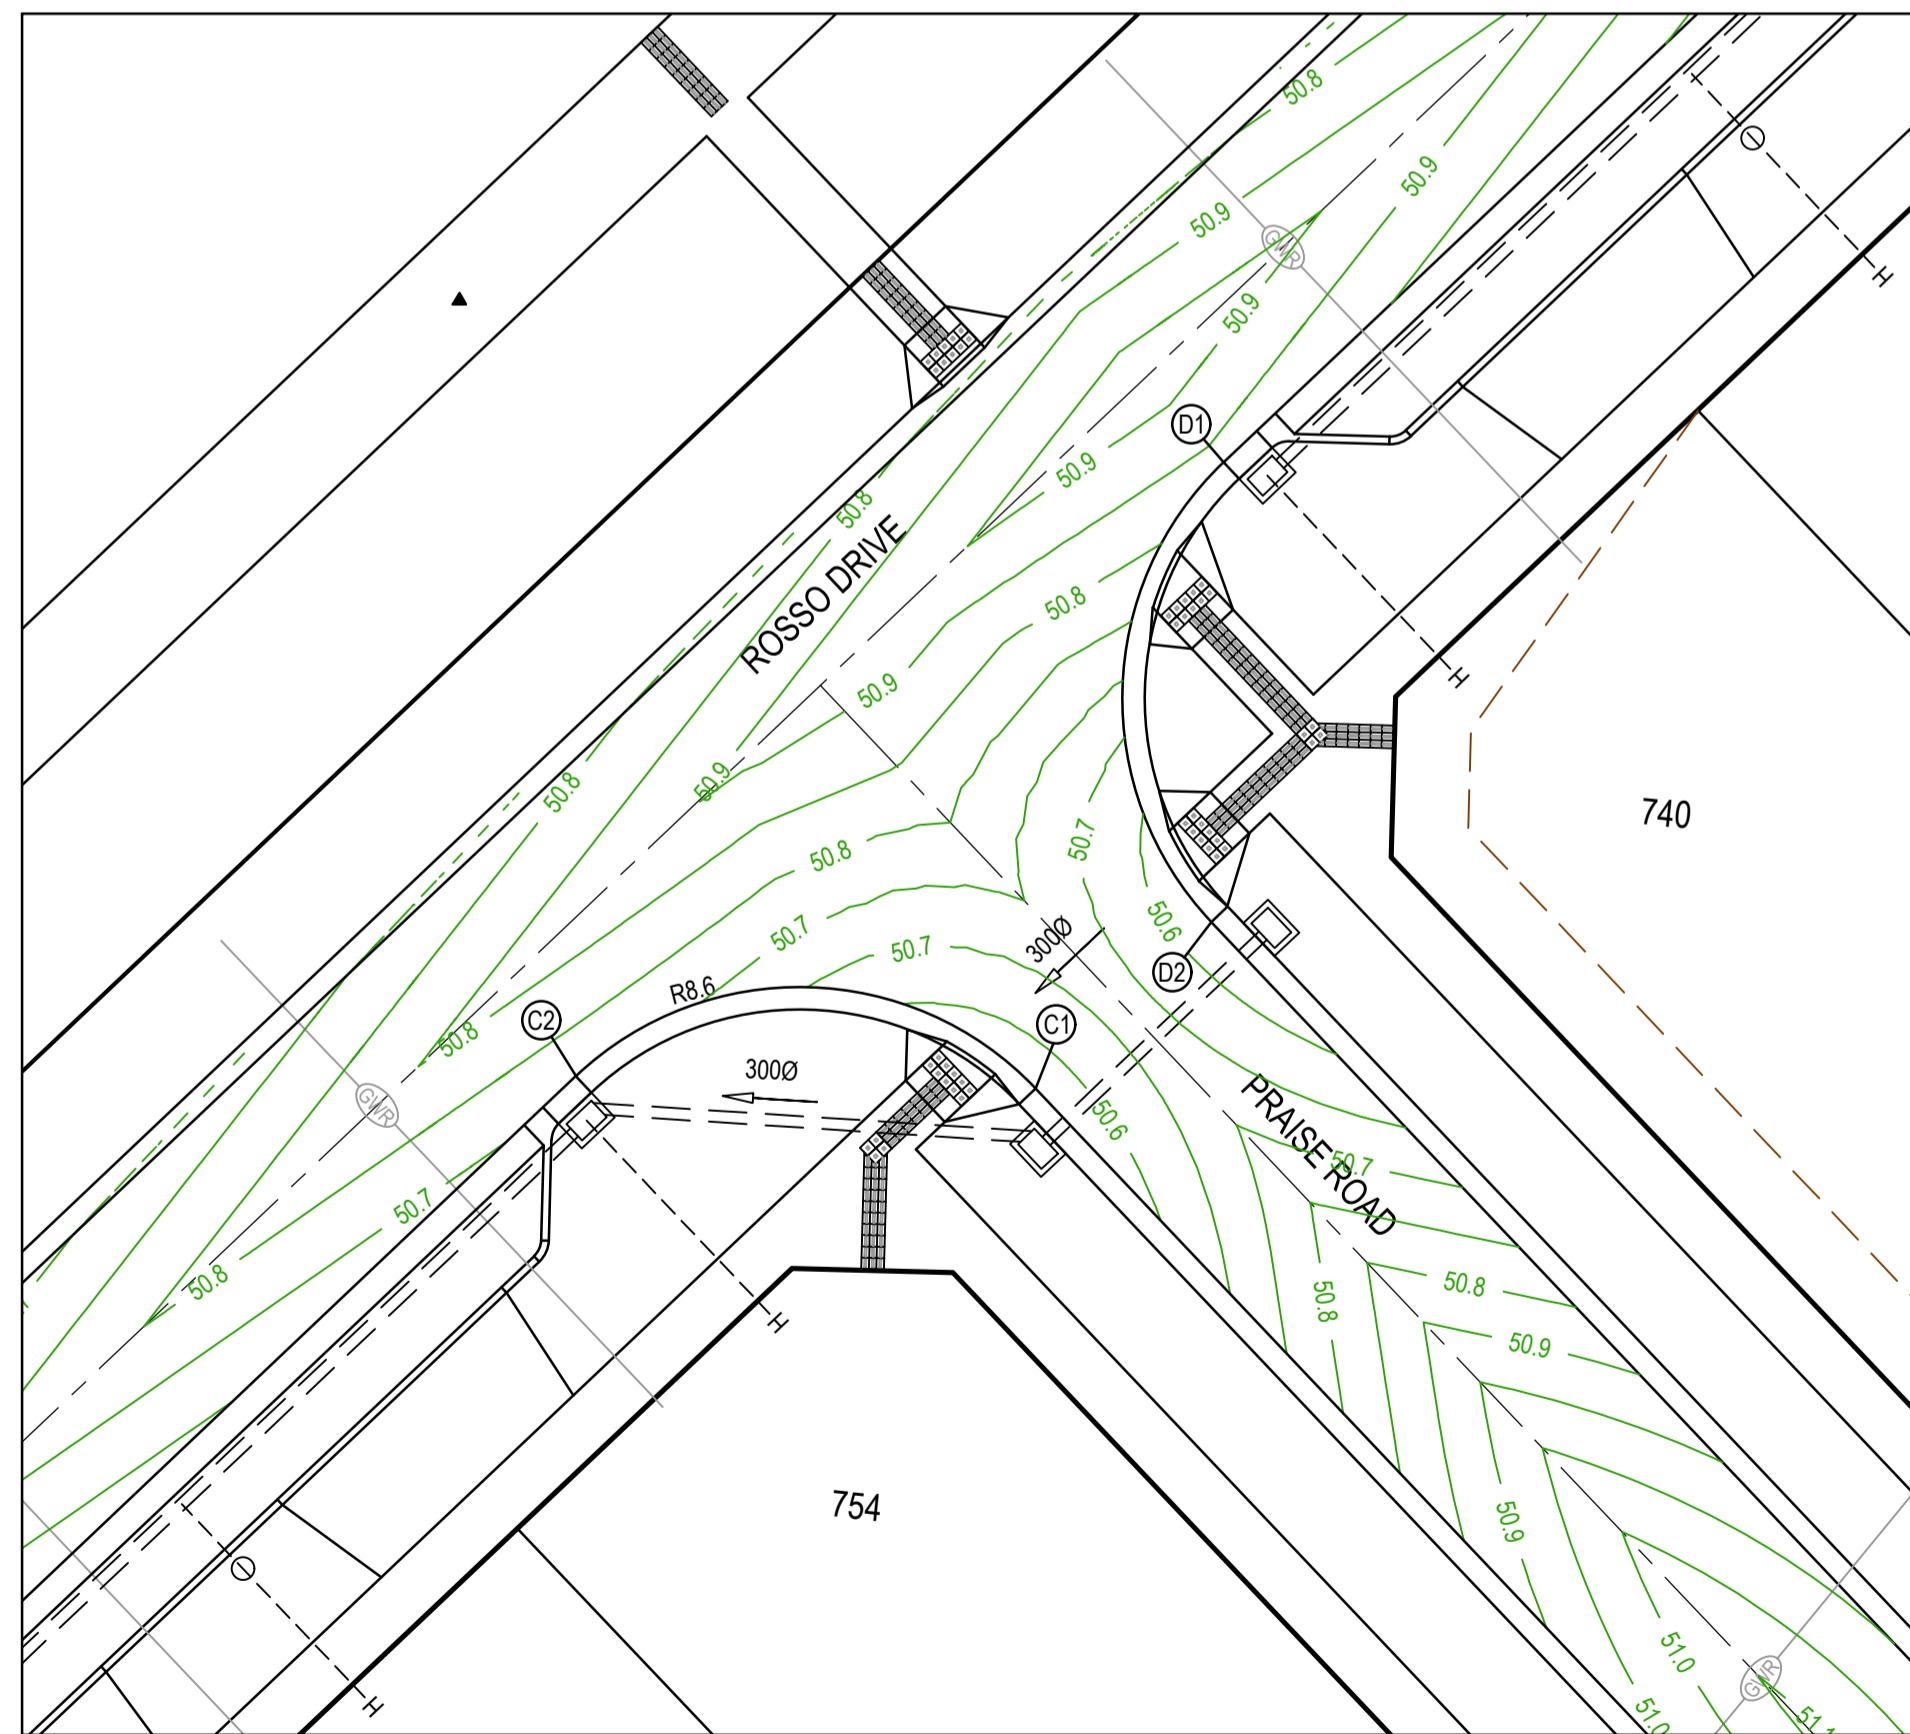

- NOTES**
1. ALL VEHICLE CROSSINGS AND PRAM CROSSINGS TO BE MINIMUM OF 0.75m FROM PITS.
  2. ALL PRAM CROSSINGS TO BE MINIMUM OF 2.0m FROM VEHICLE CROSSINGS.
  3. VEHICLE EXCLUSION MEASURES BETWEEN ROAD AND RESERVE TO FORM PART OF THE LANDSCAPE WORKS.
  4. INDUSTRIAL DRIVEWAYS TO COUNCIL RESERVES TO BE PROVIDED AS PART OF LANDSCAPE WORKS.
  5. SHARE PATH THROUGH CREEK CORRIDOR TO FORM PART OF LANDSCAPE WORKS.

**AS CONSTRUCTED PLANS**


The purpose of these as-constructed plans is to update the design drawings to show significant changes which occurred during construction. Note that the levels shown on these plans are design levels, and have not been verified by survey. All information shown on these plans should be verified on site. SMEC Australia Pty Ltd accept no responsibility for loss or damages resulting from the inappropriate usage of these plans.

Quality Management ISO 9001  
 OHS Management AS/NZS 4801  
 Environmental Management ISO 14001  
 Global-Mark.com.au®

PLAN OF SUB. NO.  
PS900882T

PERMIT REF. NO.  
WYP10365/17.01

**AS CONSTRUCTED**

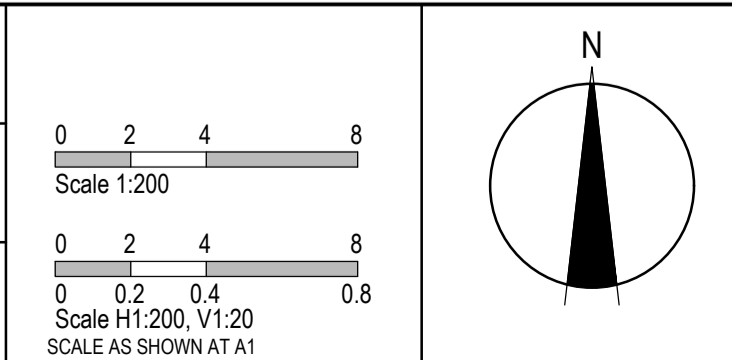

**SMEC**

Member of the Surlana Jurong Group




ABN 47 065 475 149

Collins Square, Tower 4, Level 20, 727 Collins St  
 Melbourne, VIC 3008  
 Ph 03 9514 1500

**GROWLAND**




Marigold - Stage 7  
 Wyndham City Council  
 Road and Drainage  
 Intersection Detail Plan - 1

MELWAYS REF: 359 F9  
 PROJECT / DRAWING No: 2360E-007-181  
 SHEET No: 06 of 28  
 REVISION: 1

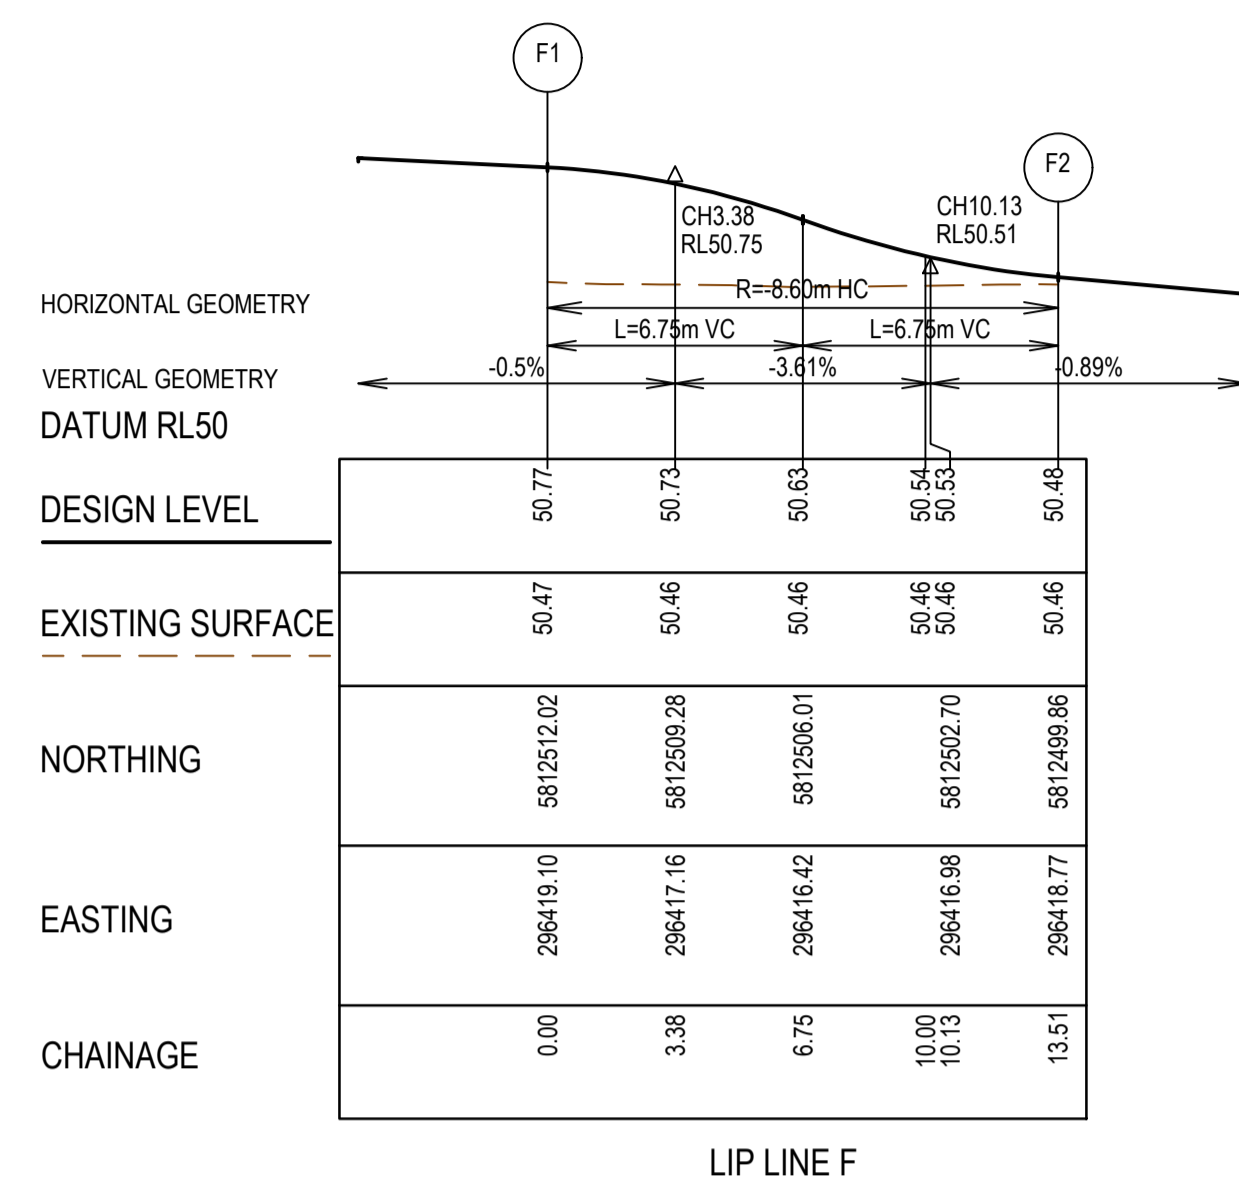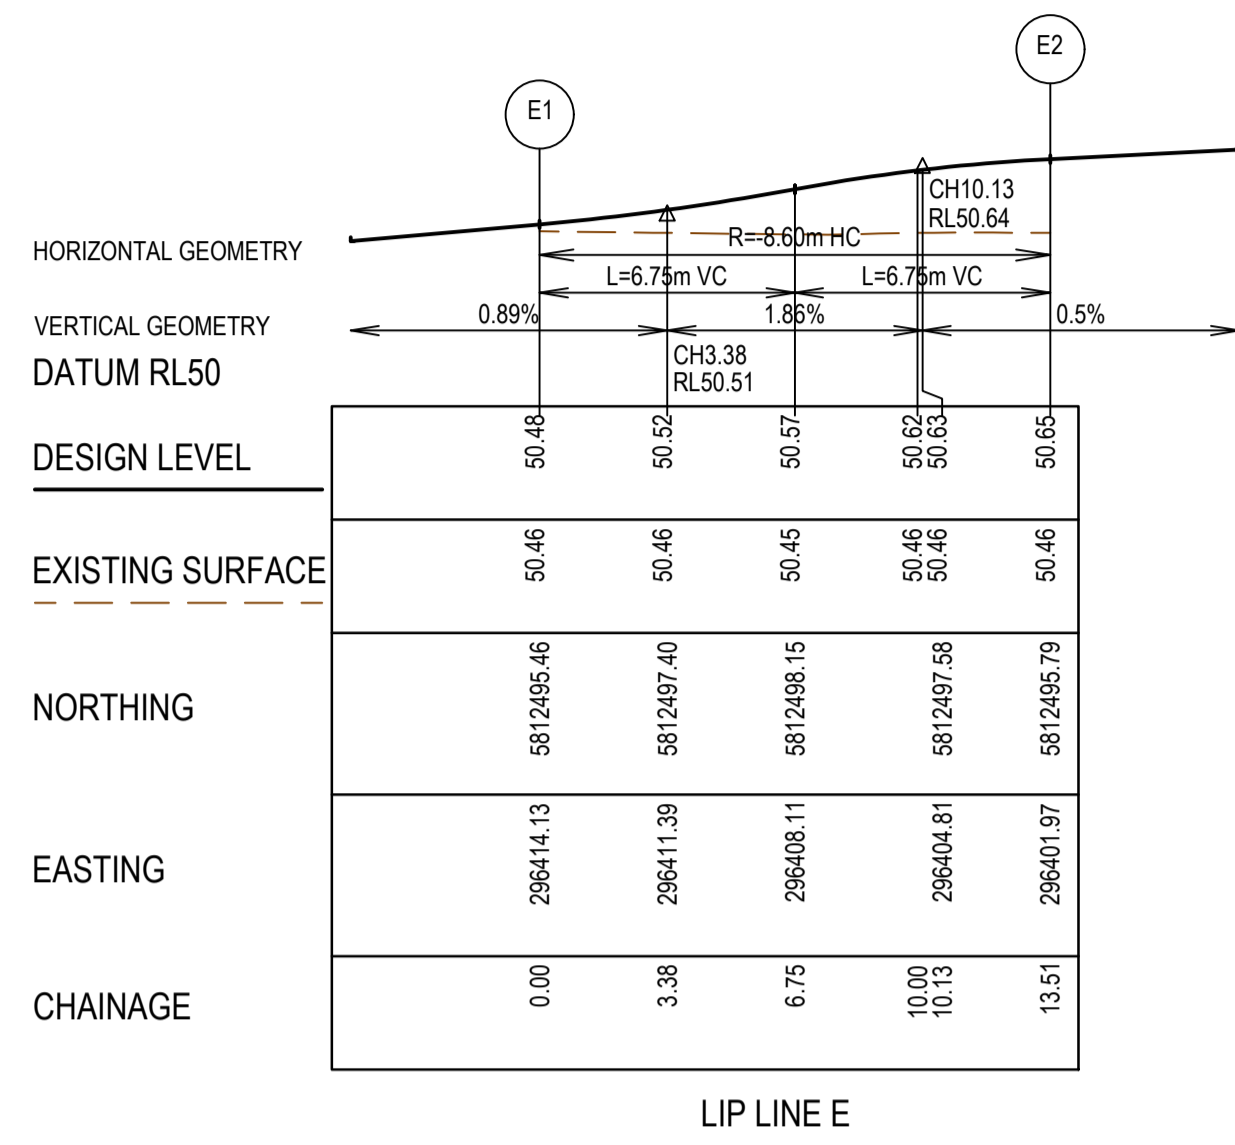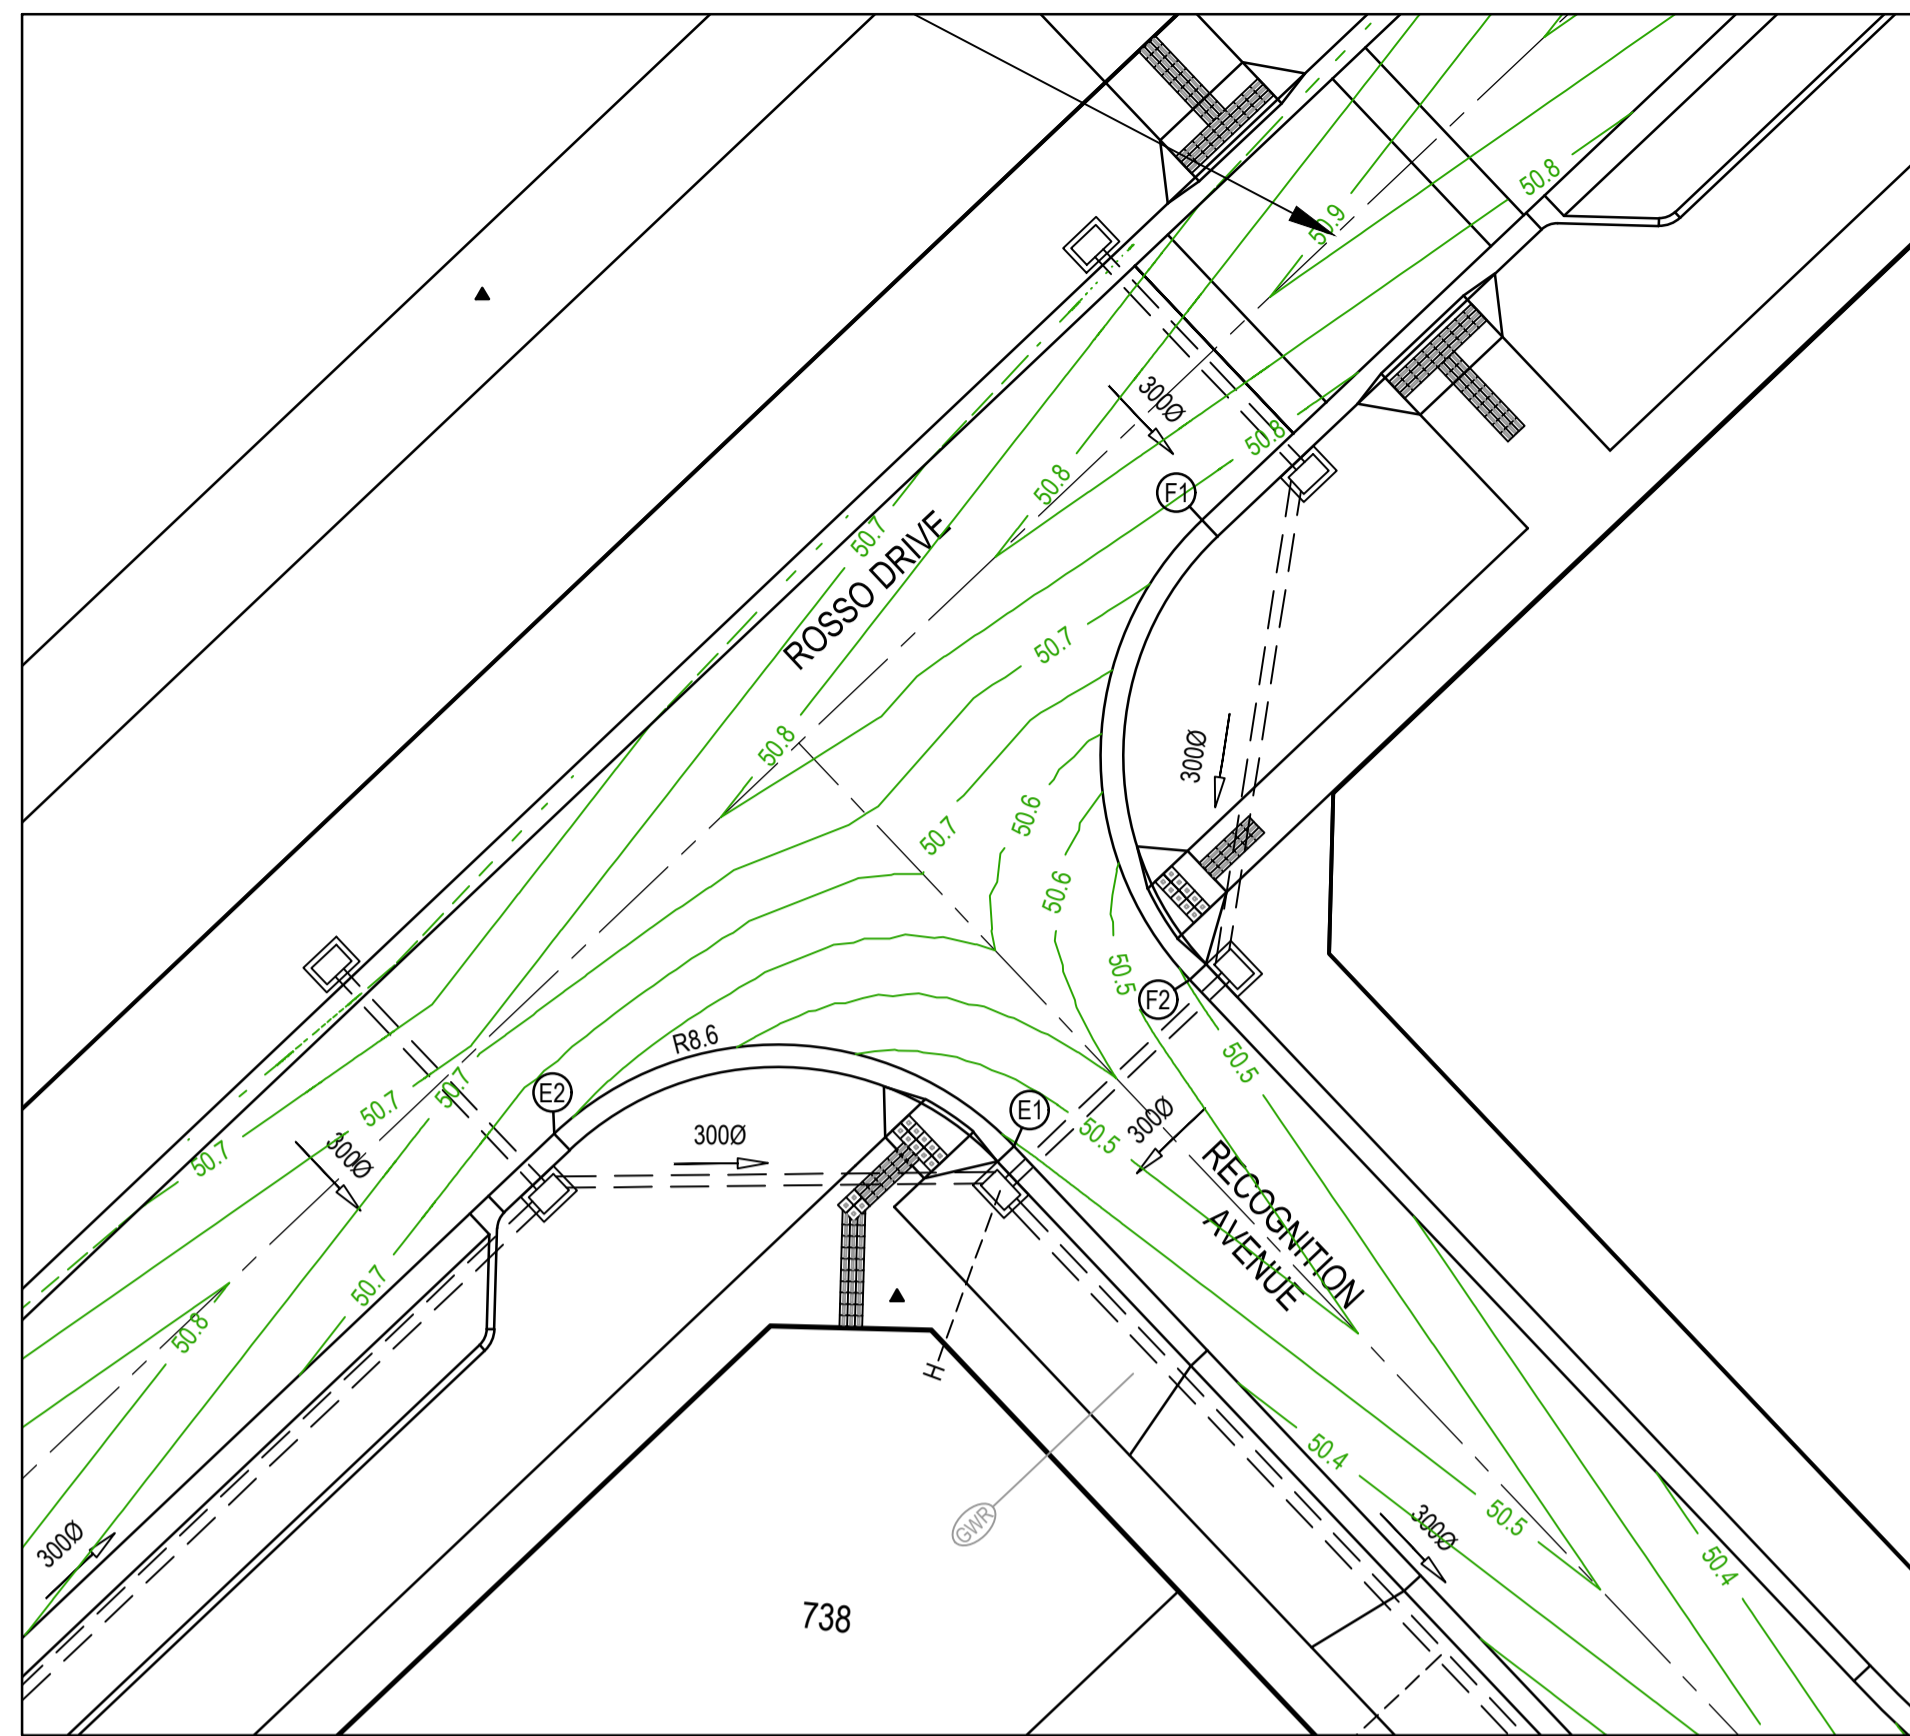

**LEGEND - INTERSECTION DETAIL PLAN**  
 ALL PROPOSED, FUTURE & EXISTING SERVICE LOCATIONS ARE SHOWN INDICATIVELY

	STORMWATER DRAIN, PIT & PROPERTY INLET
	MAIN DRAIN
	SEWER & MAINTENANCE STRUCTURES
	HOUSE DRAIN
	SERVICE CONDUITS
	TACTILE PAVERS
	EXISTING STORMWATER DRAIN
	EXISTING MAIN DRAIN
	EXISTING SEWER & MAINTENANCE STRUCTURES
	EXISTING SERVICE CONDUITS
	EXISTING TACTILE PAVERS
	FUTURE STORMWATER DRAIN
	FUTURE MAIN DRAIN
	FUTURE SEWER & MAINTENANCE STRUCTURES
	FUTURE HOUSE DRAIN
	FUTURE SERVICE CONDUITS
	FUTURE TACTILE PAVERS
	EXISTING RETAINING WALL
	RETAINING WALL
	FUTURE RETAINING WALL
	EDGE STRIP, SUBSOIL DRAIN, "NO ROAD" SIGN & BARRIER
	PERMANENT SURVEY MARK
	TEMPORARY BENCH MARK
	PROPOSED DRIVEWAY & FOOTPATH

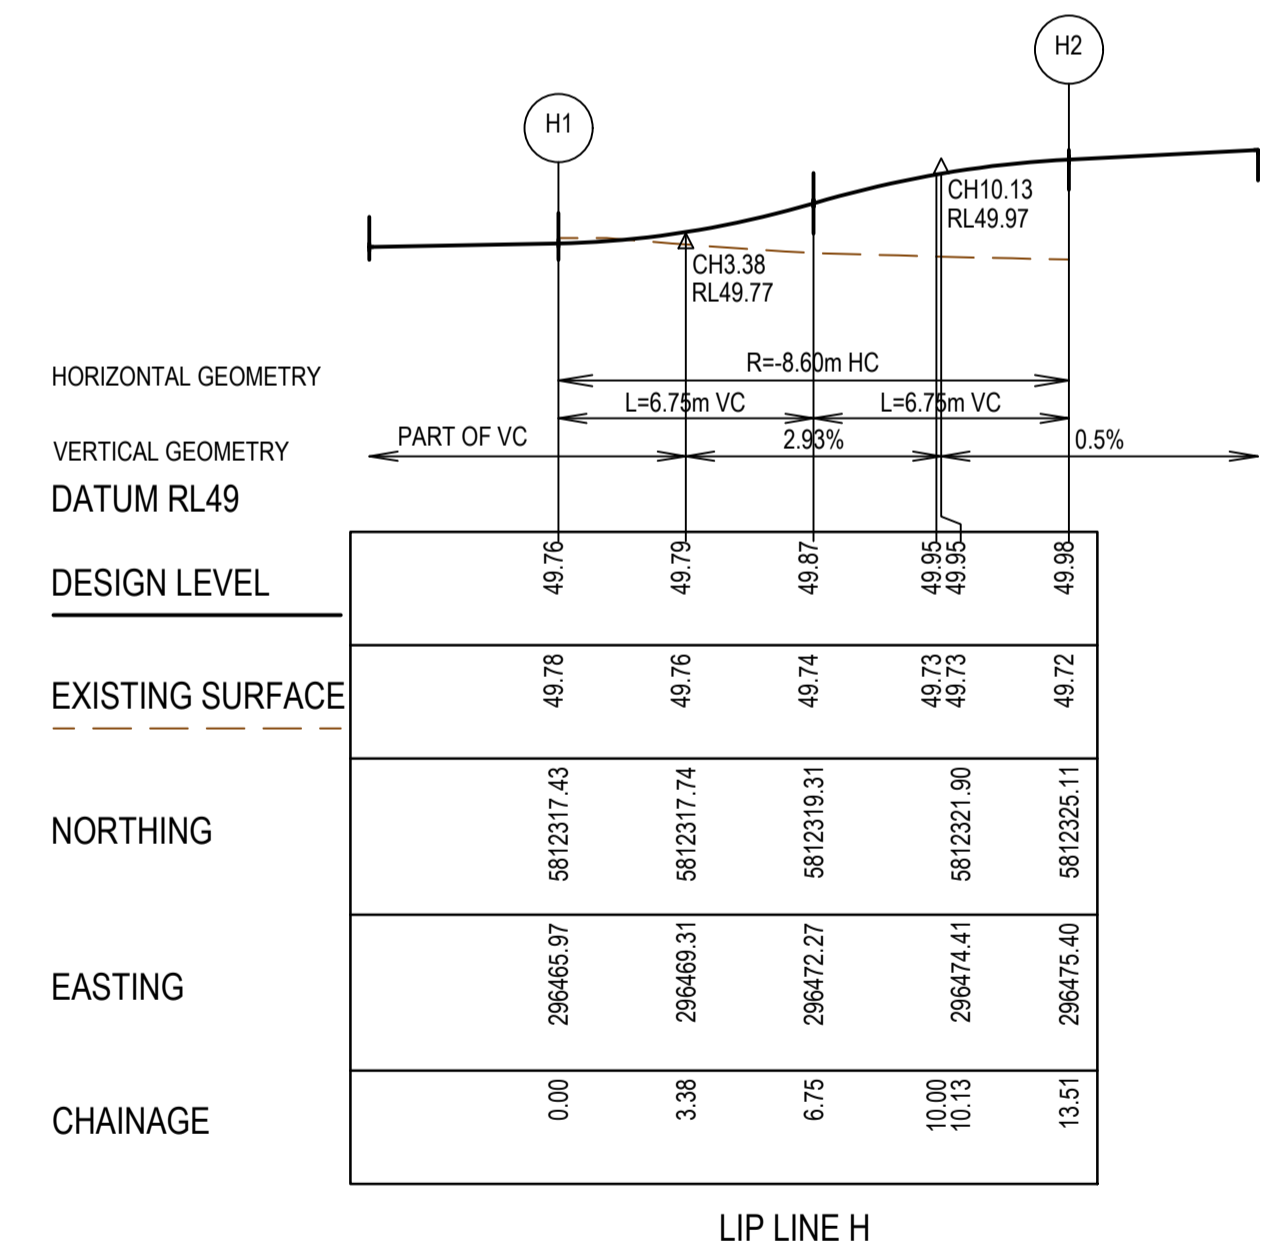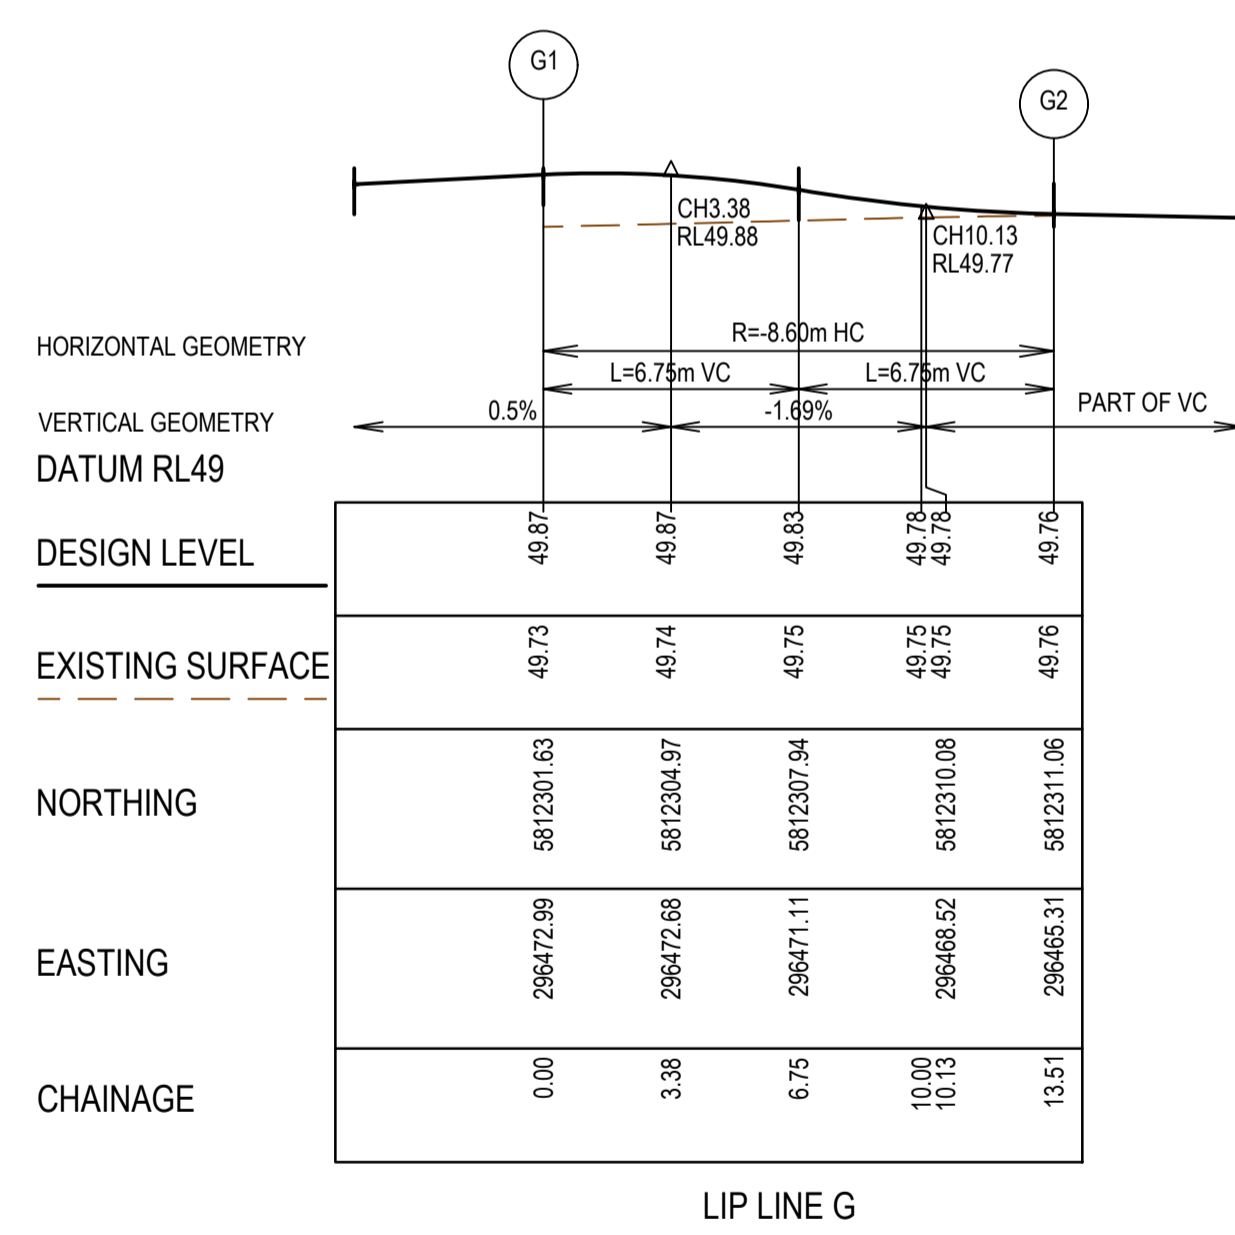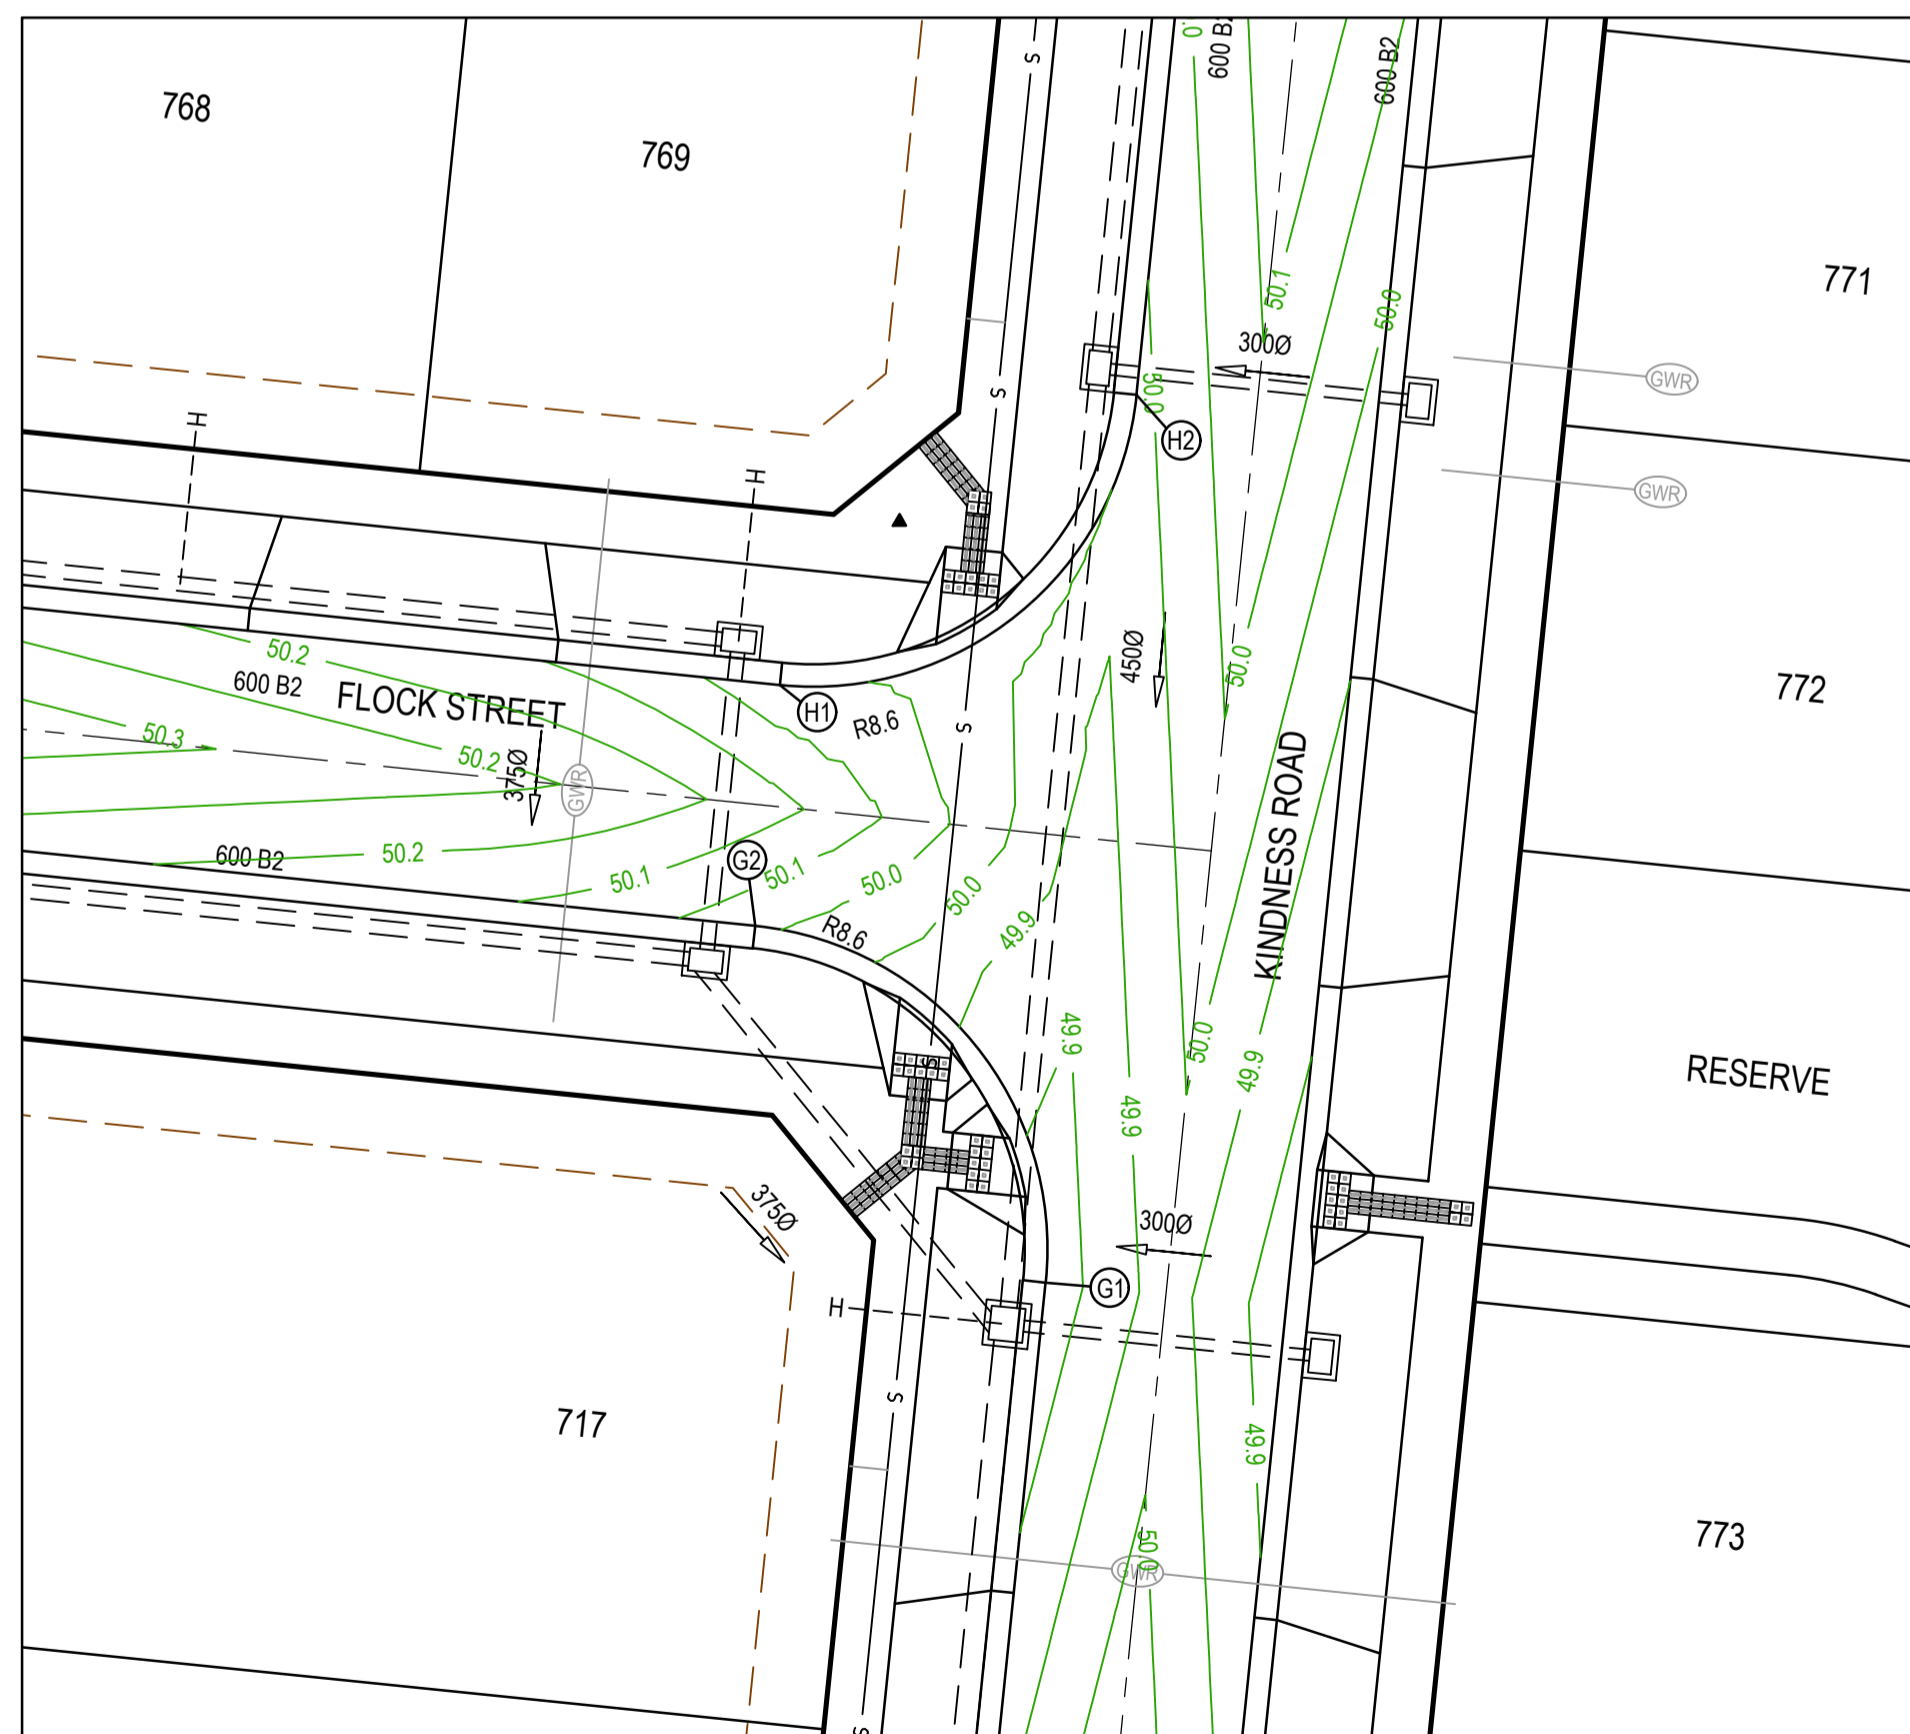


- NOTES**
- ALL VEHICLE CROSSINGS AND PRAM CROSSINGS TO BE MINIMUM OF 0.75m FROM PITS.
  - ALL PRAM CROSSINGS TO BE MINIMUM OF 2.0m FROM VEHICLE CROSSINGS.
  - VEHICLE EXCLUSION MEASURES BETWEEN ROAD RESERVE AND RESERVE TO FORM PART OF THE LANDSCAPE WORKS.
  - INDUSTRIAL DRIVEWAYS TO COUNCIL RESERVES TO BE PROVIDED AS PART OF LANDSCAPE WORKS.
  - SHARE PATH THROUGH CREEK CORRIDOR TO FORM PART OF LANDSCAPE WORKS.

**AS CONSTRUCTED PLANS**  
 The purpose of these as-constructed plans is to update the design drawings to show significant changes which occurred during construction. Note that the levels shown on these plans are design levels, and have not been verified by survey. All information shown on these plans should be verified on site. SMEC Australia Pty Ltd accept no responsibility for loss or damages resulting from the inappropriate usage of these plans.

Quality Management ISO 9001  
 OHS Management AS/NZS 4801  
 Environmental Management ISO 14001  
 Global-Mark.com.au®

PLAN OF SUB. NO.  
 PS900882T  
 PERMIT REF. NO.  
 WYP10365/17.01

**AS CONSTRUCTED**



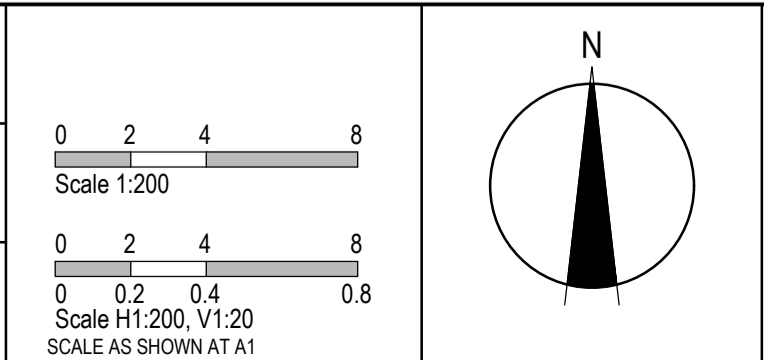


**SMEC**  
 Member of the Surlana Jurong Group  
 ABN 47 065 475 149  
 Collins Square, Tower 4, Level 20, 727 Collins St  
 Melbourne, VIC 3008  
 Ph 03 9514 1900

**GROWLAND**

Marigold - Stage 7  
 Wyndham City Council  
 Road and Drainage  
 Intersection Detail Plan - 2

MELWAYS REF: 359 F9  
 PROJECT / DRAWING No: 2360E-007-182  
 SHEET No: 07 of 28  
 REVISION: 1

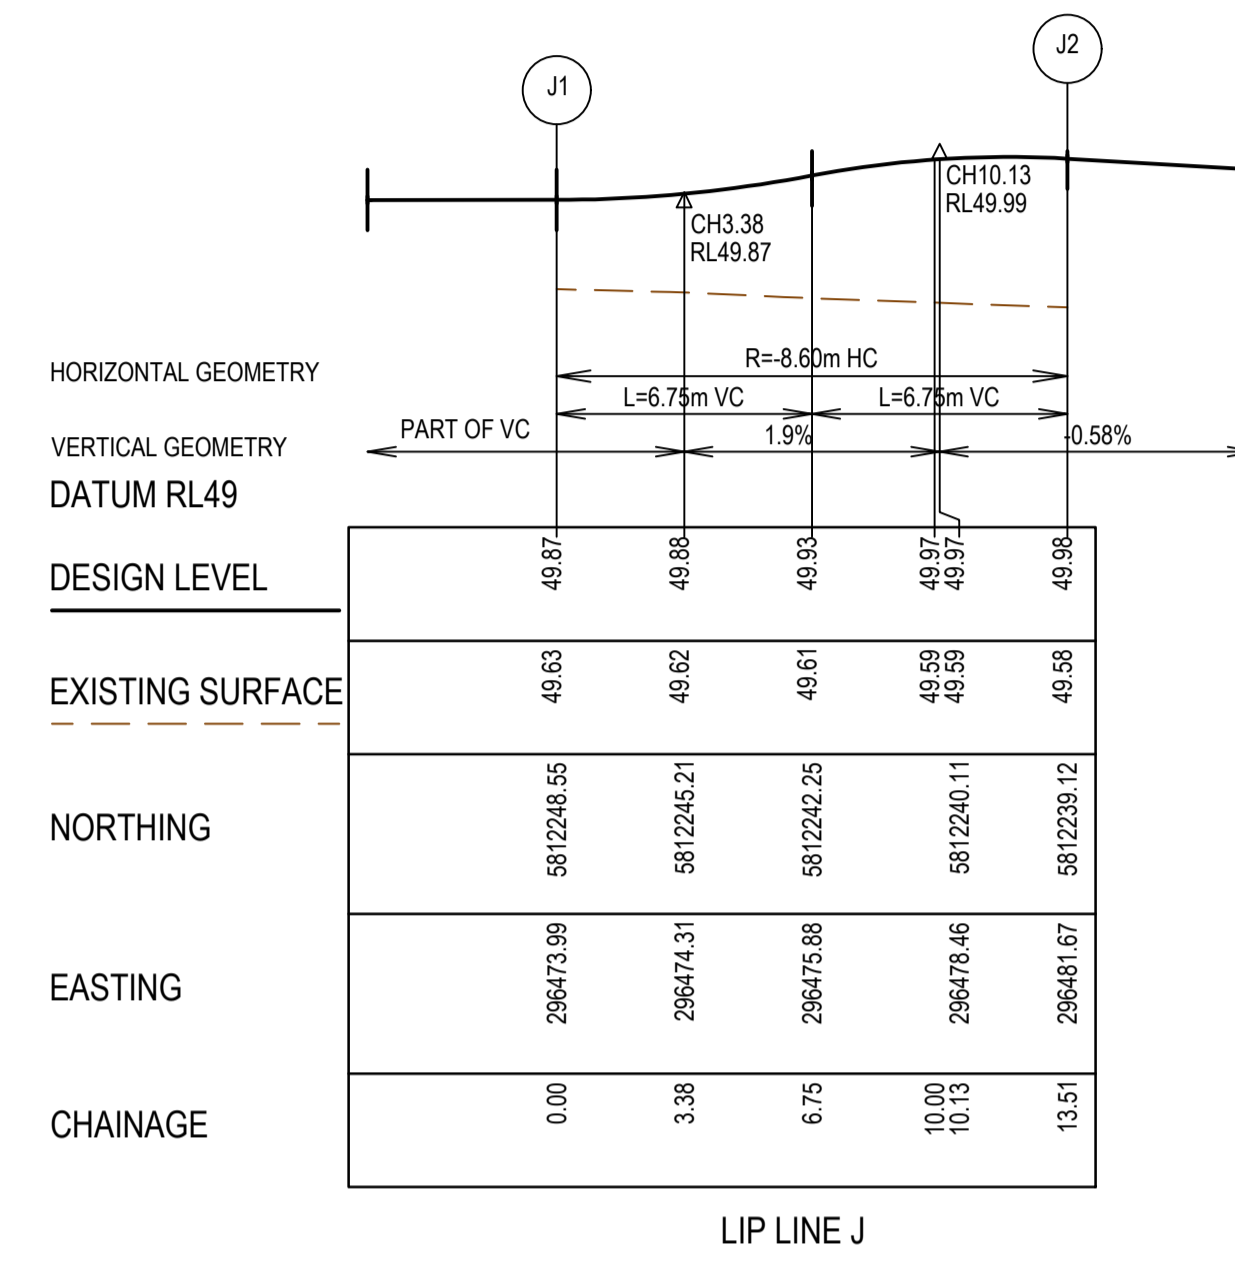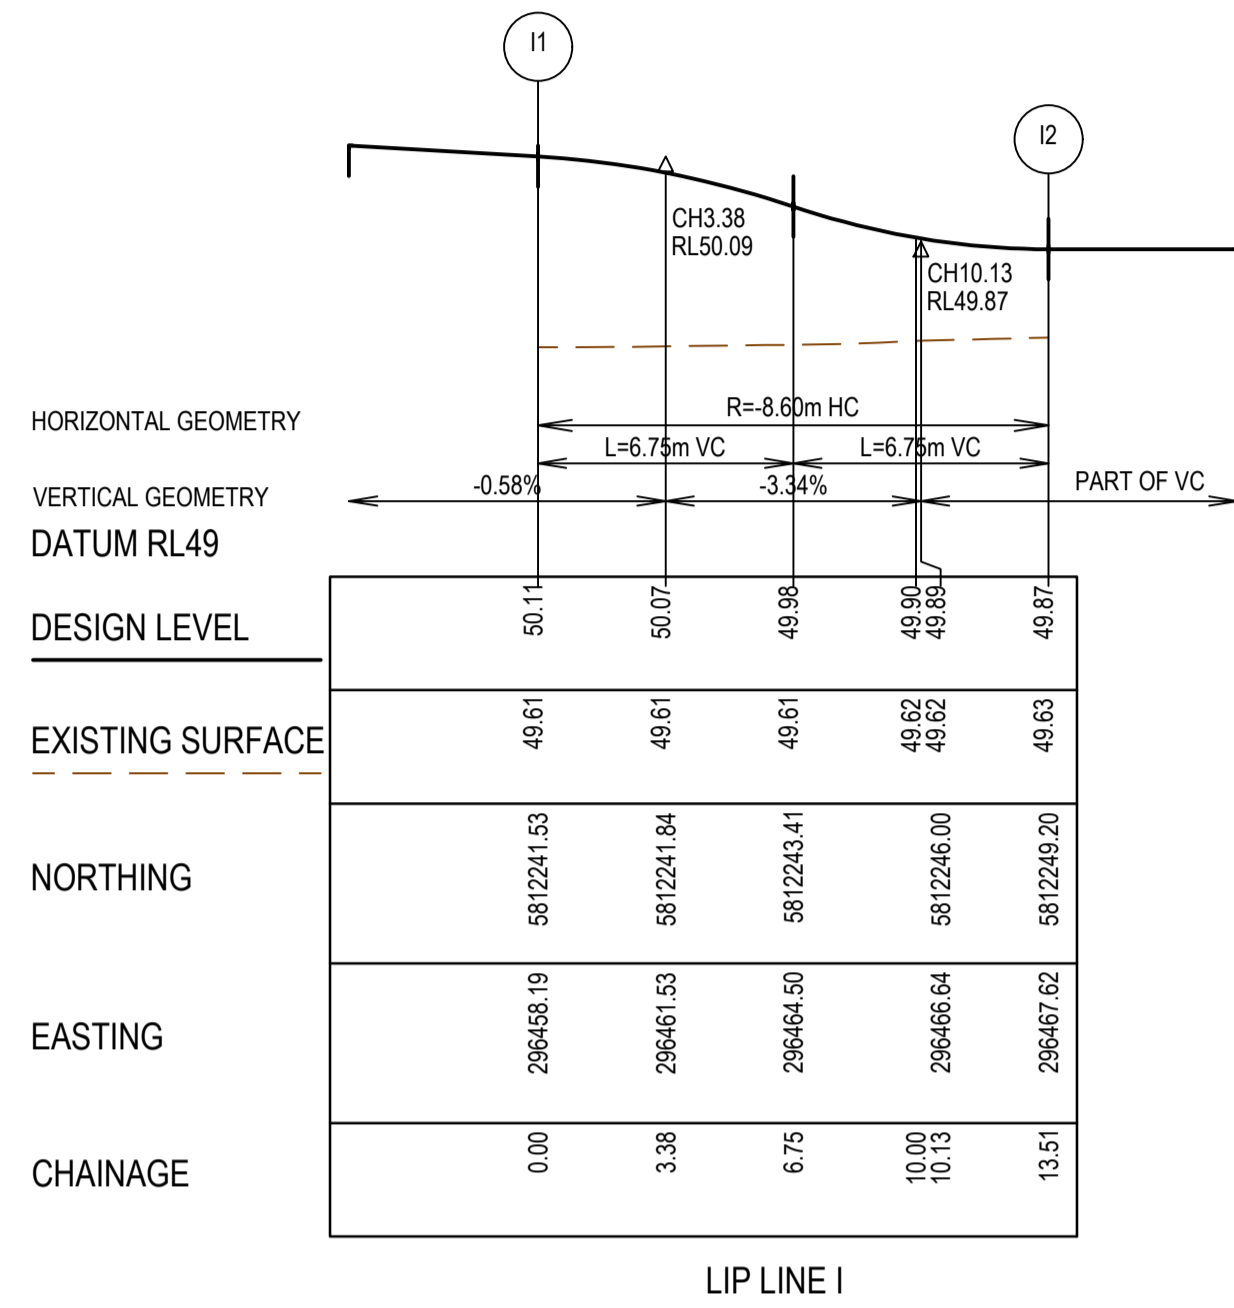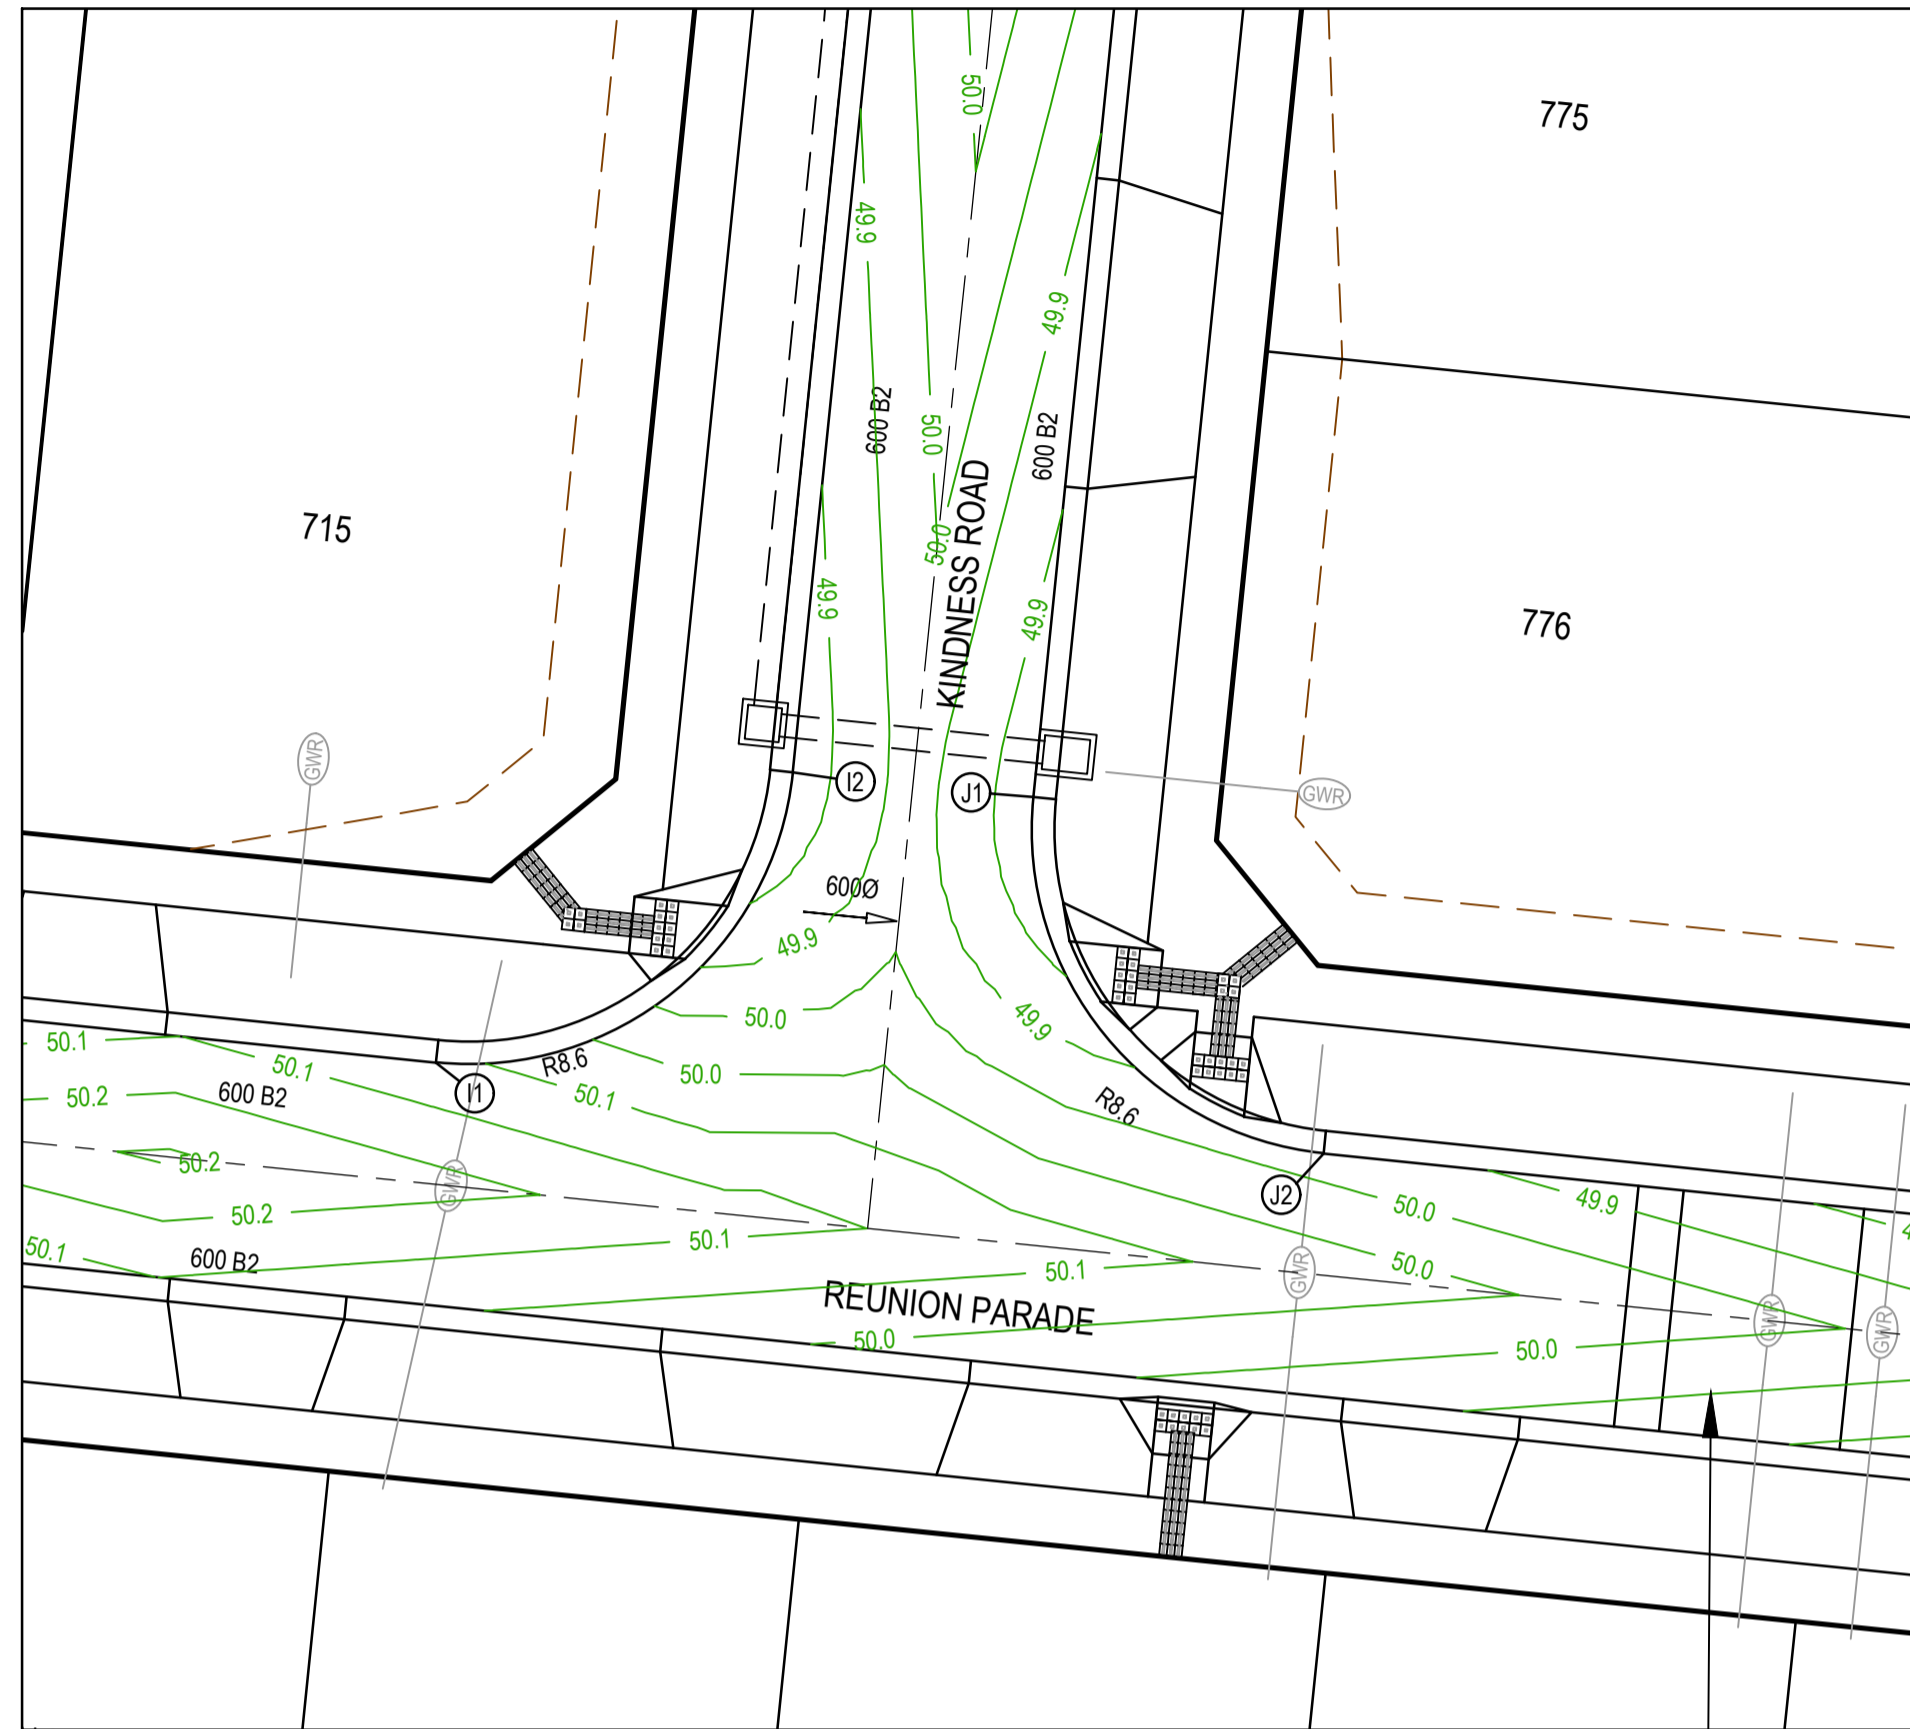

**LEGEND - INTERSECTION DETAIL PLAN**  
ALL PROPOSED, FUTURE & EXISTING SERVICE LOCATIONS ARE SHOWN INDICATIVELY

	STORMWATER DRAIN, PIT & PROPERTY INLET
	MAIN DRAIN
	SEWER & MAINTENANCE STRUCTURES
	HOUSE DRAIN
	SERVICE CONDUITS
	TACTILE PAVERS
	EXISTING STORMWATER DRAIN
	EXISTING MAIN DRAIN
	EXISTING SEWER & MAINTENANCE STRUCTURES
	EXISTING SERVICE CONDUITS
	EXISTING TACTILE PAVERS
	FUTURE STORMWATER DRAIN
	FUTURE MAIN DRAIN
	FUTURE SEWER & MAINTENANCE STRUCTURES
	FUTURE HOUSE DRAIN
	FUTURE SERVICE CONDUITS
	FUTURE TACTILE PAVERS
	EXISTING RETAINING WALL
	RETAINING WALL
	FUTURE RETAINING WALL
	EDGE STRIP, SUBSOIL DRAIN, 'NO ROAD' SIGN & BARRIER
	PERMANENT SURVEY MARK
	TEMPORARY BENCH MARK
	PROPOSED DRIVEWAY & FOOTPATH

- NOTES**
1. ALL VEHICLE CROSSINGS AND PRAM CROSSINGS TO BE MINIMUM OF 0.75m FROM PITTS.
  2. ALL PRAM CROSSINGS TO BE MINIMUM OF 2.0m FROM VEHICLE CROSSINGS.
  3. VEHICLE EXCLUSION MEASURES BETWEEN ROAD RESERVE AND RESERVE TO FORM PART OF THE LANDSCAPE WORKS.
  4. INDUSTRIAL DRIVEWAYS TO COUNCIL RESERVES TO BE PROVIDED AS PART OF LANDSCAPE WORKS.
  5. SHARE PATH THROUGH CREEK CORRIDOR TO FORM PART OF LANDSCAPE WORKS.

**AS CONSTRUCTED PLANS**

The purpose of these as-constructed plans is to update the design drawings to show significant changes which occurred during construction. Note that the levels shown on these plans are design levels, and have not been verified by survey. All information shown on these plans should be verified on site. SMEC Australia Pty Ltd accept no responsibility for loss or damages resulting from the inappropriate usage of these plans.

Quality Management ISO 9001  
Global-Mark.com.au®



OH&S Management AS/NZS 4801  
Global-Mark.com.au®

Environmental Management ISO 14001  
Global-Mark.com.au®

PLAN OF SUB. NO.  
PS900882T

PERMIT REF. NO.  
WYP10365/17.01

**AS CONSTRUCTED**

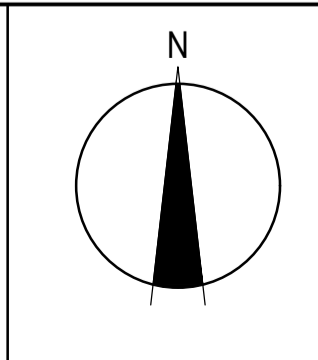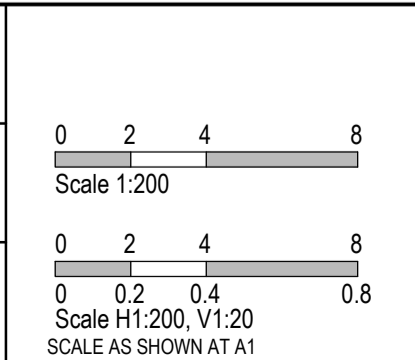

**SMEC**

Member of the Surlana Jurong Group

ABN 47 065 475 149

Collins Square, Tower 4, Level 20, 727 Collins St  
Melbourne, VIC 3008  
Ph 03 9514 1500


**GROWLAND**

Marigold - Stage 7  
Wyndham City Council  
Road and Drainage  
Intersection Detail Plan - 3

MELWAYS REF: 359 F9  
PROJECT / DRAWING No: 2360E-007-183






SHEET No: 08 of 28  
REVISION: 1



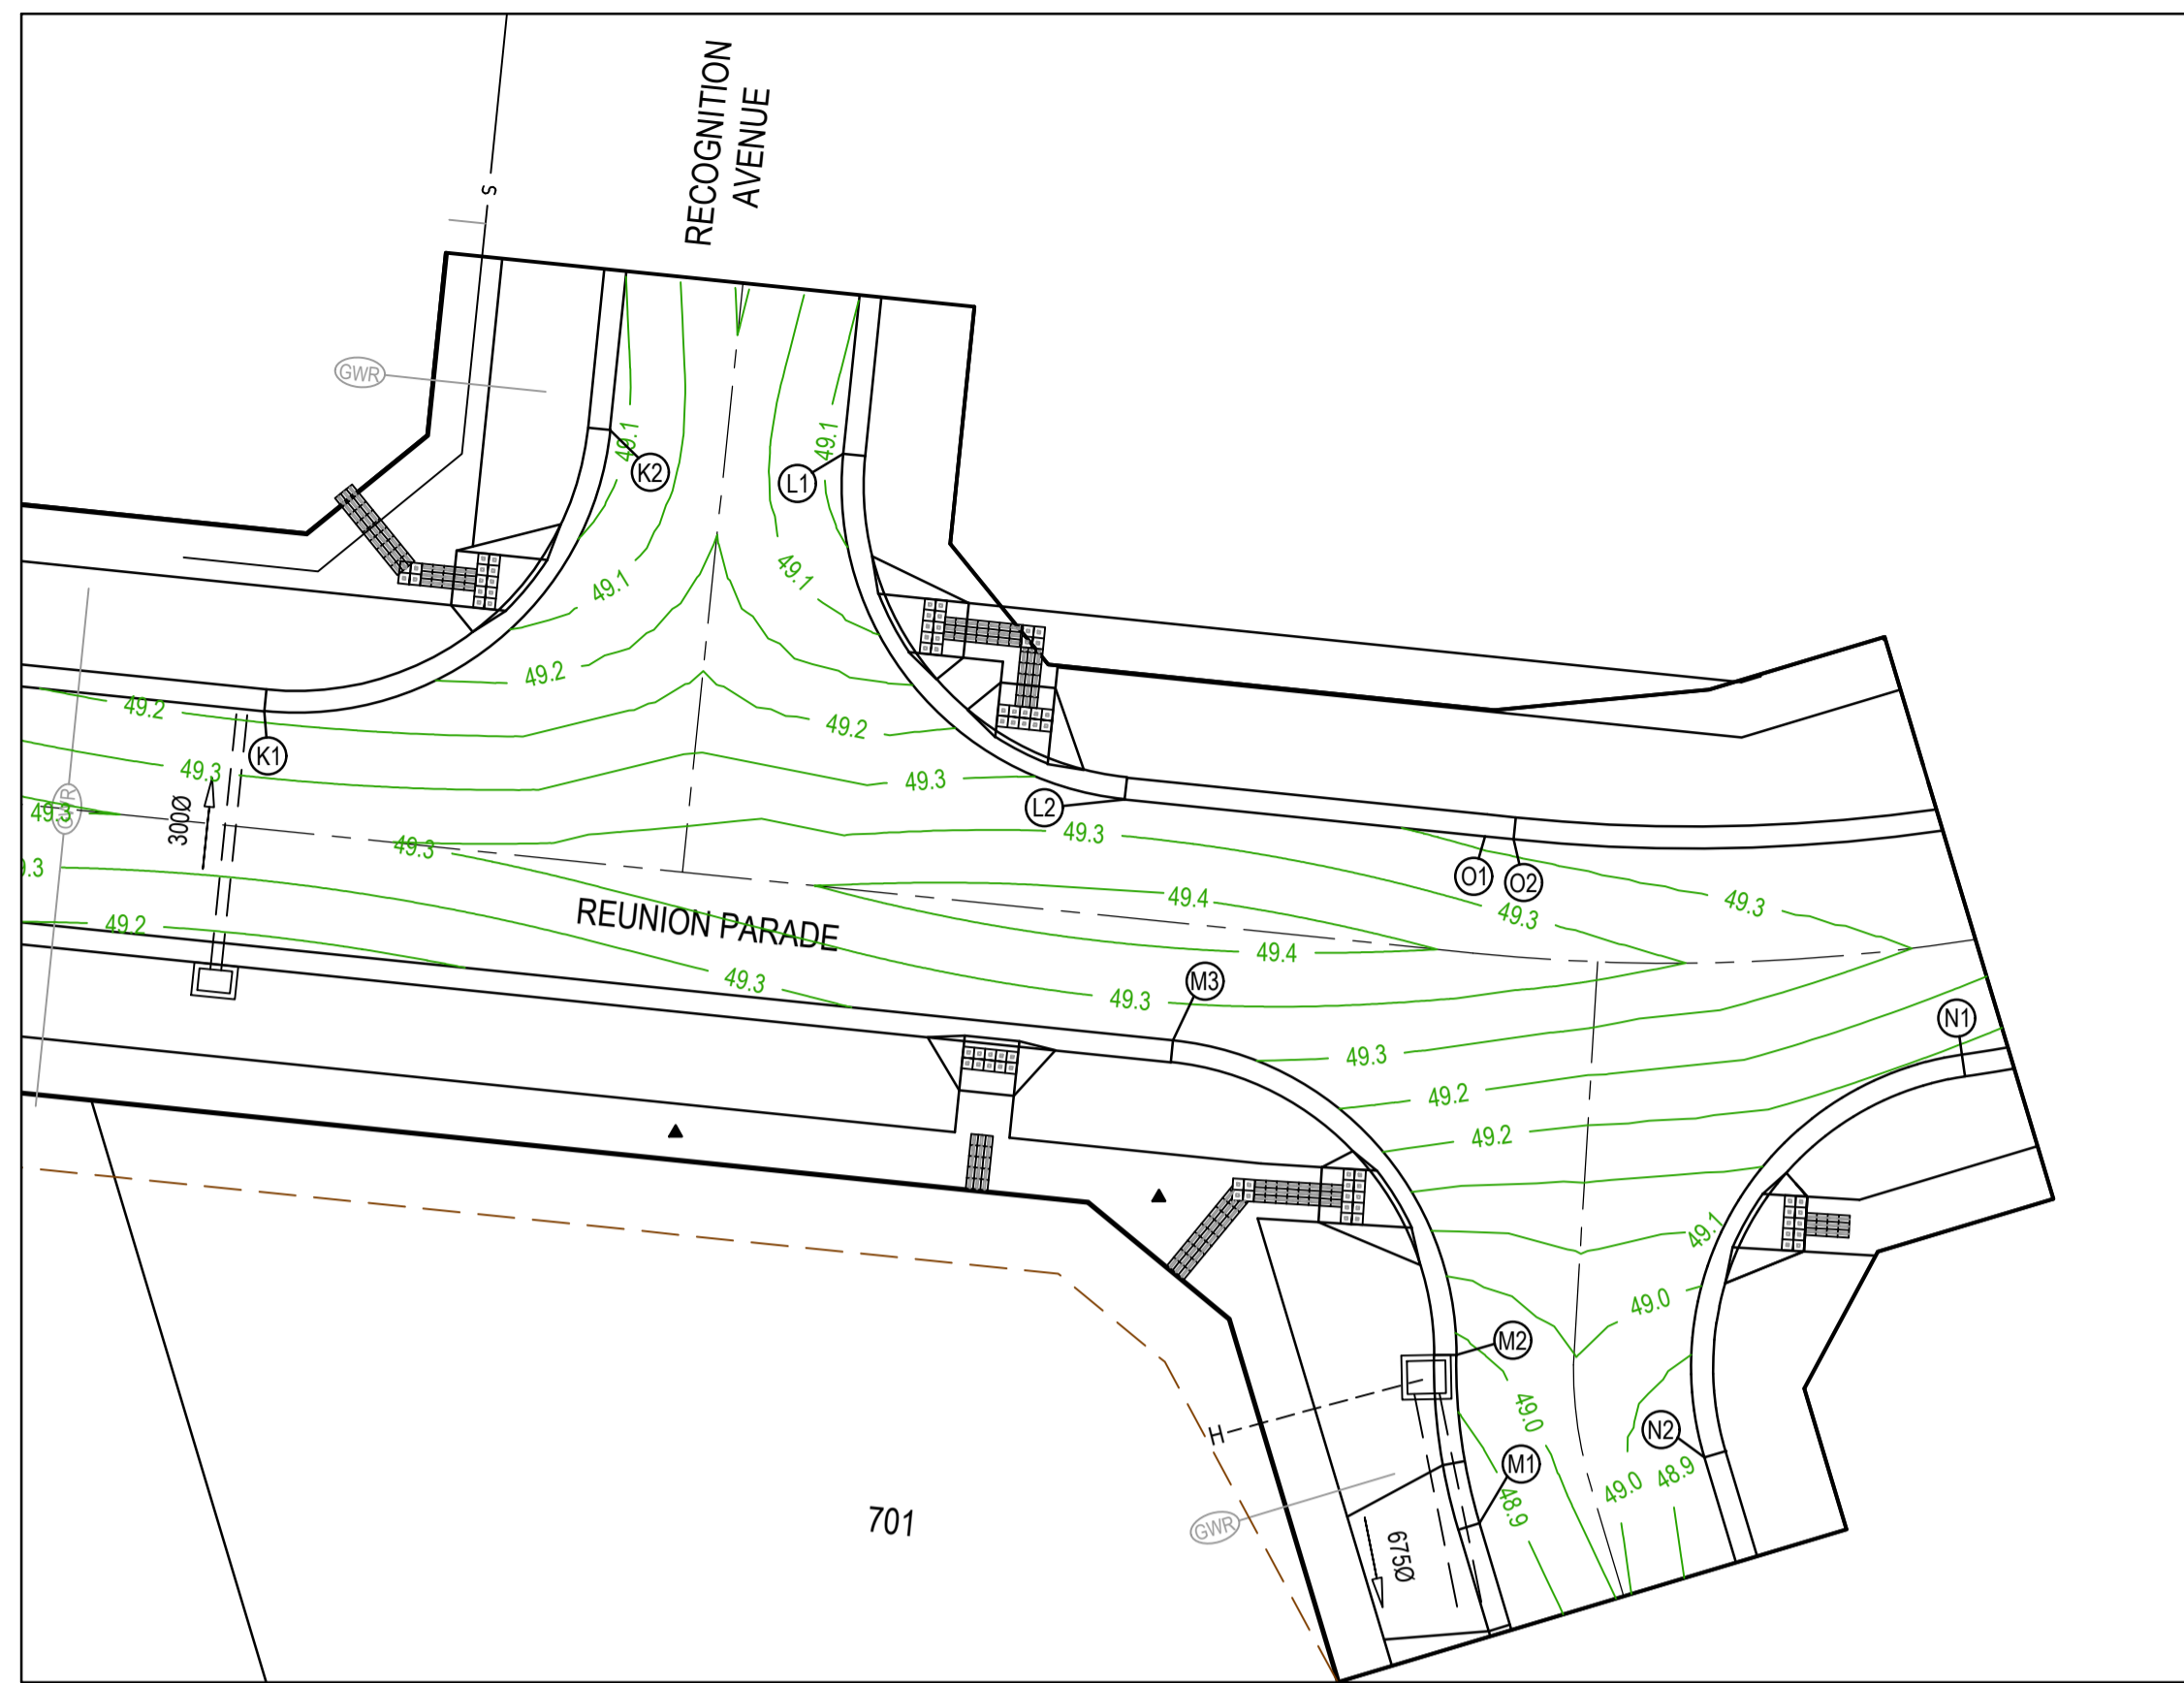

**LEGEND - INTERSECTION DETAIL PLAN**  
ALL PROPOSED, FUTURE & EXISTING SERVICE LOCATIONS ARE SHOWN INDICATIVELY

	STORMWATER DRAIN, PIT & PROPERTY INLET
	MAIN DRAIN
	SEWER & MAINTENANCE STRUCTURES
	HOUSE DRAIN
	SERVICE CONDUITS
	TACTILE PAVERS
	EXISTING STORMWATER DRAIN
	EXISTING MAIN DRAIN
	EXISTING SEWER & MAINTENANCE STRUCTURES
	EXISTING SERVICE CONDUITS
	EXISTING TACTILE PAVERS
	FUTURE STORMWATER DRAIN
	FUTURE MAIN DRAIN
	FUTURE SEWER & MAINTENANCE STRUCTURES
	FUTURE HOUSE DRAIN
	FUTURE SERVICE CONDUITS
	FUTURE TACTILE PAVERS
	EXISTING RETAINING WALL
	RETAINING WALL
	FUTURE RETAINING WALL
	EDGE STRIP, SUBSOIL DRAIN, 'NO ROAD' SIGN & BARRIER
	PERMANENT SURVEY MARK
	TEMPORARY BENCH MARK
	PROPOSED DRIVEWAY & FOOTPATH

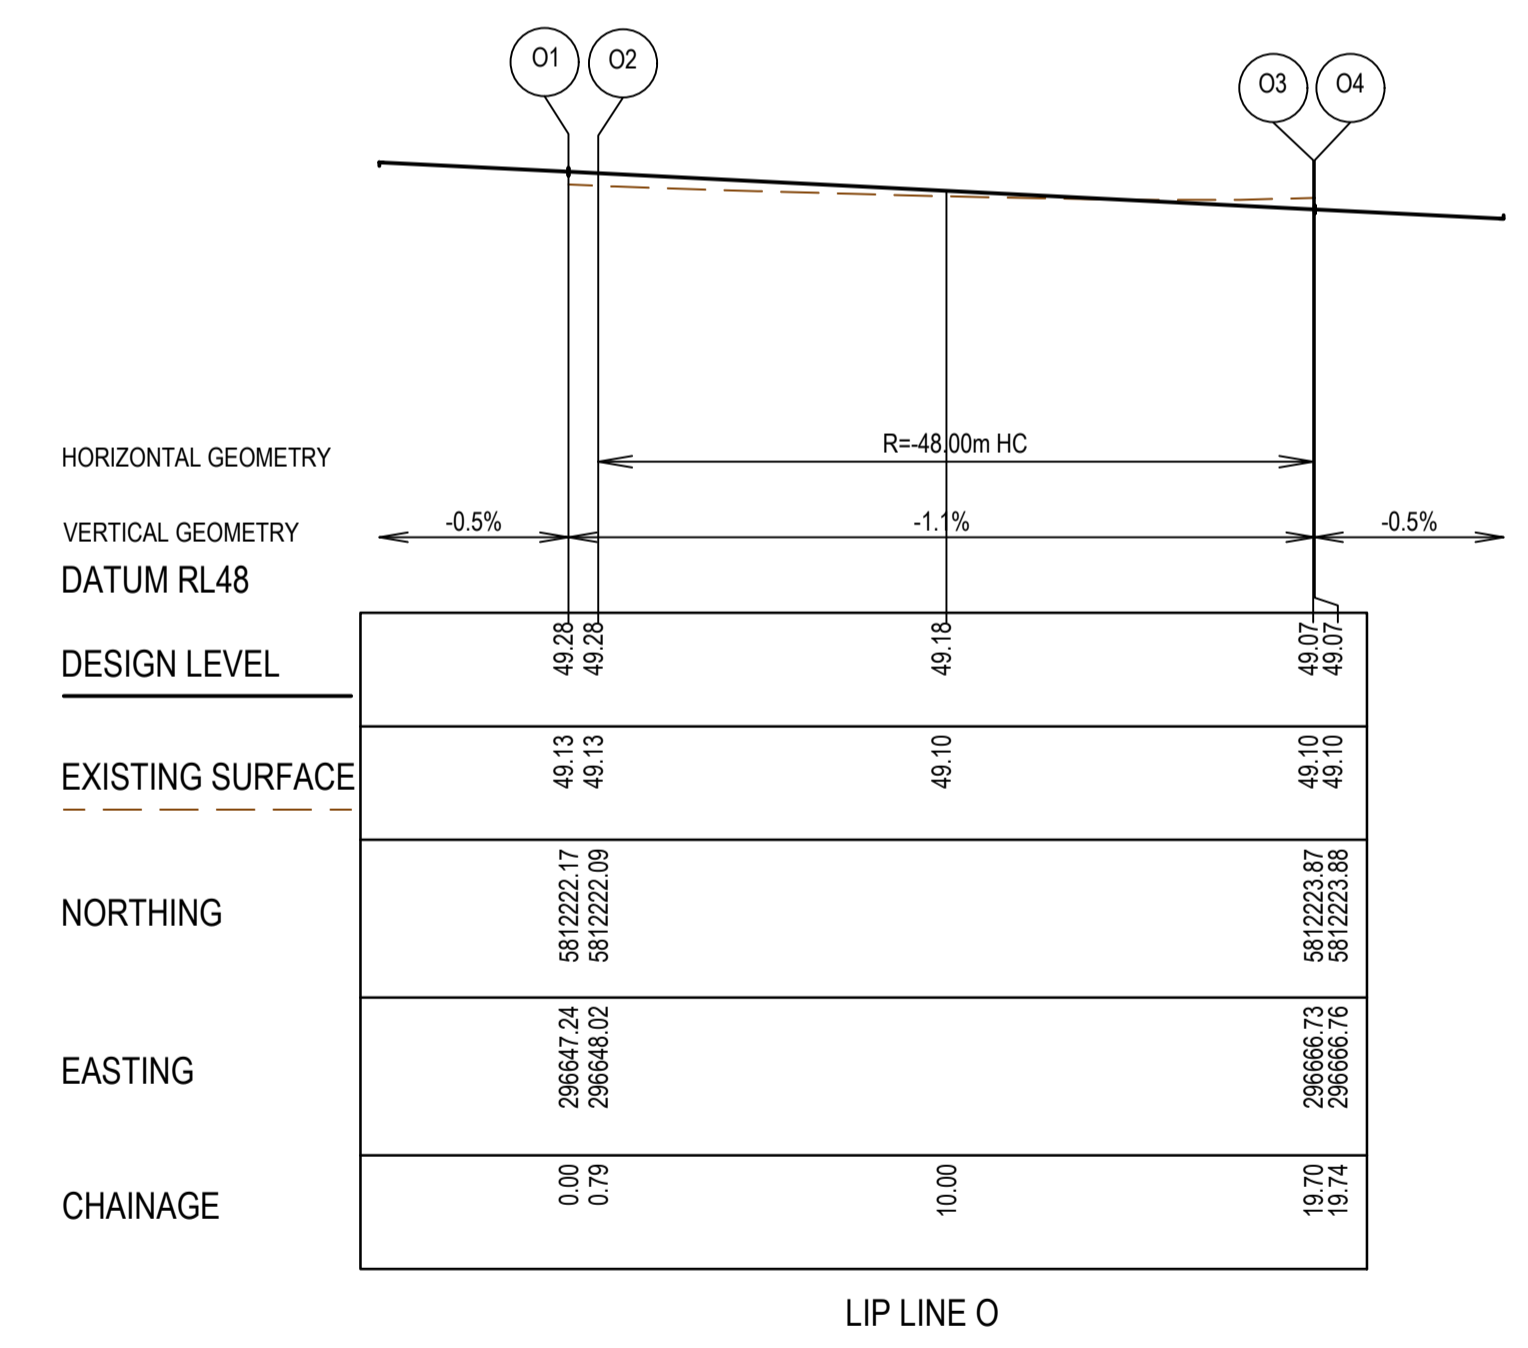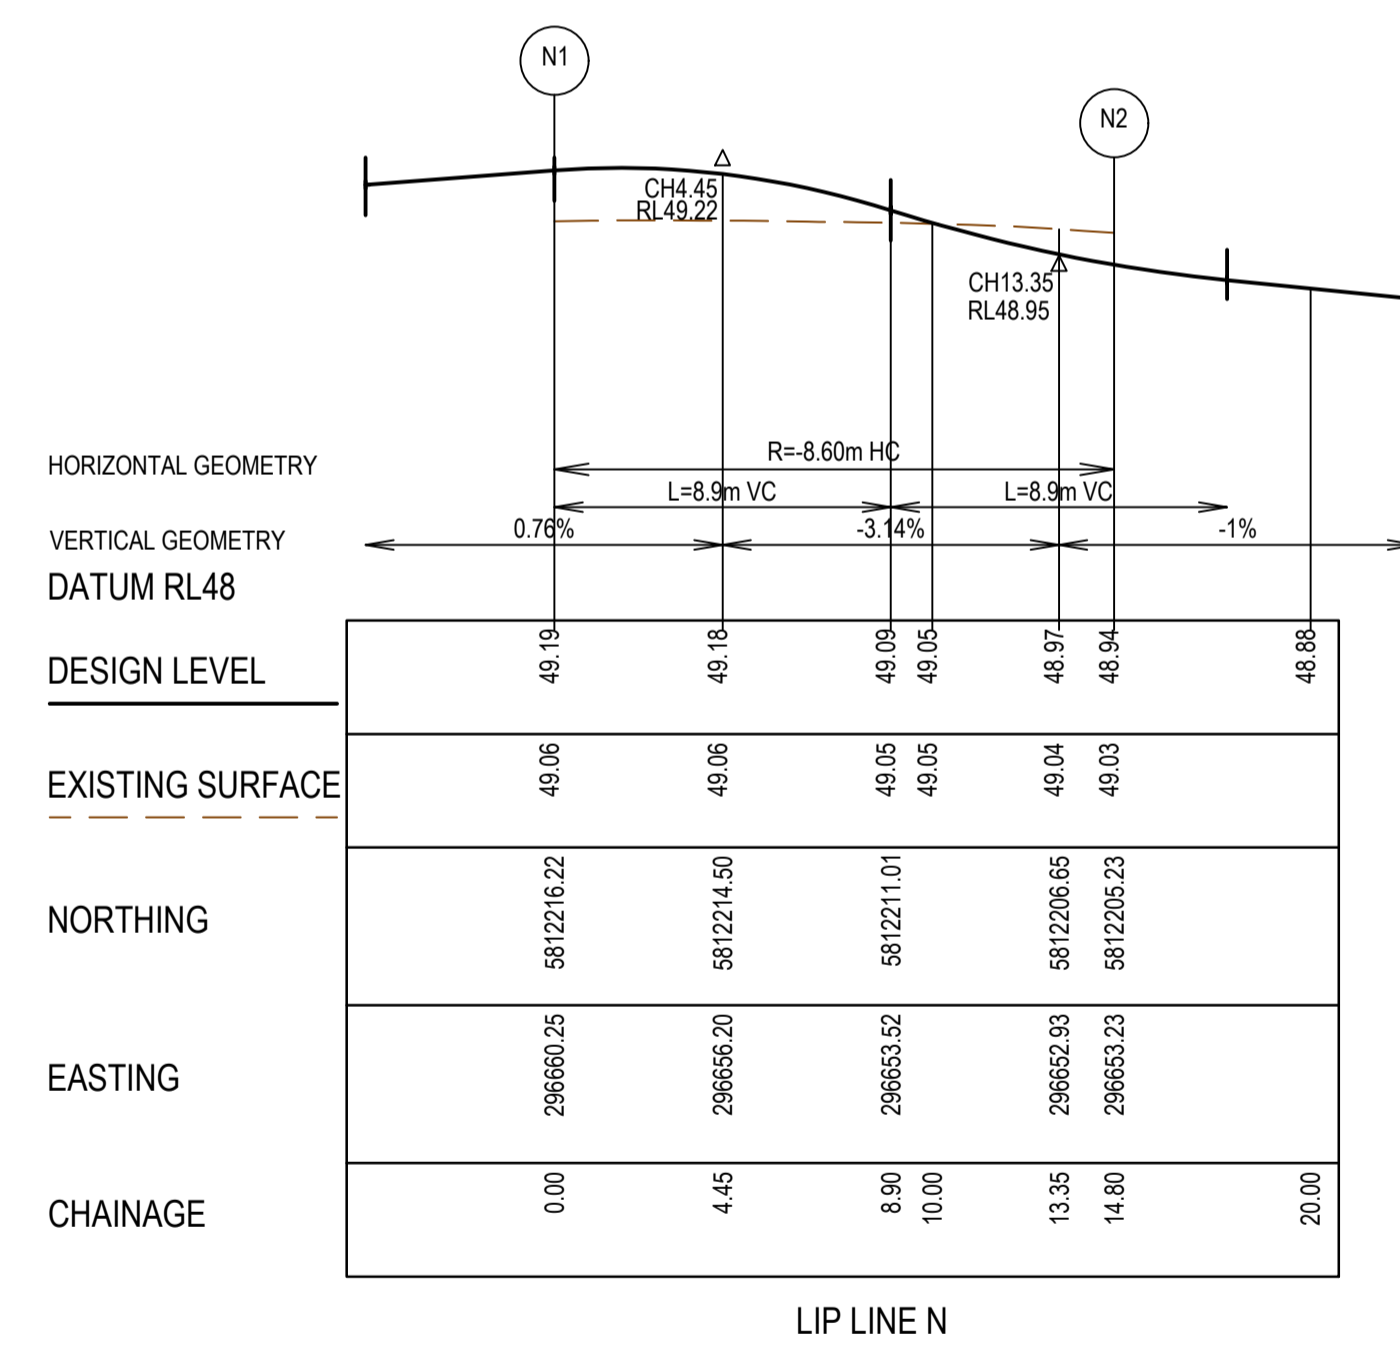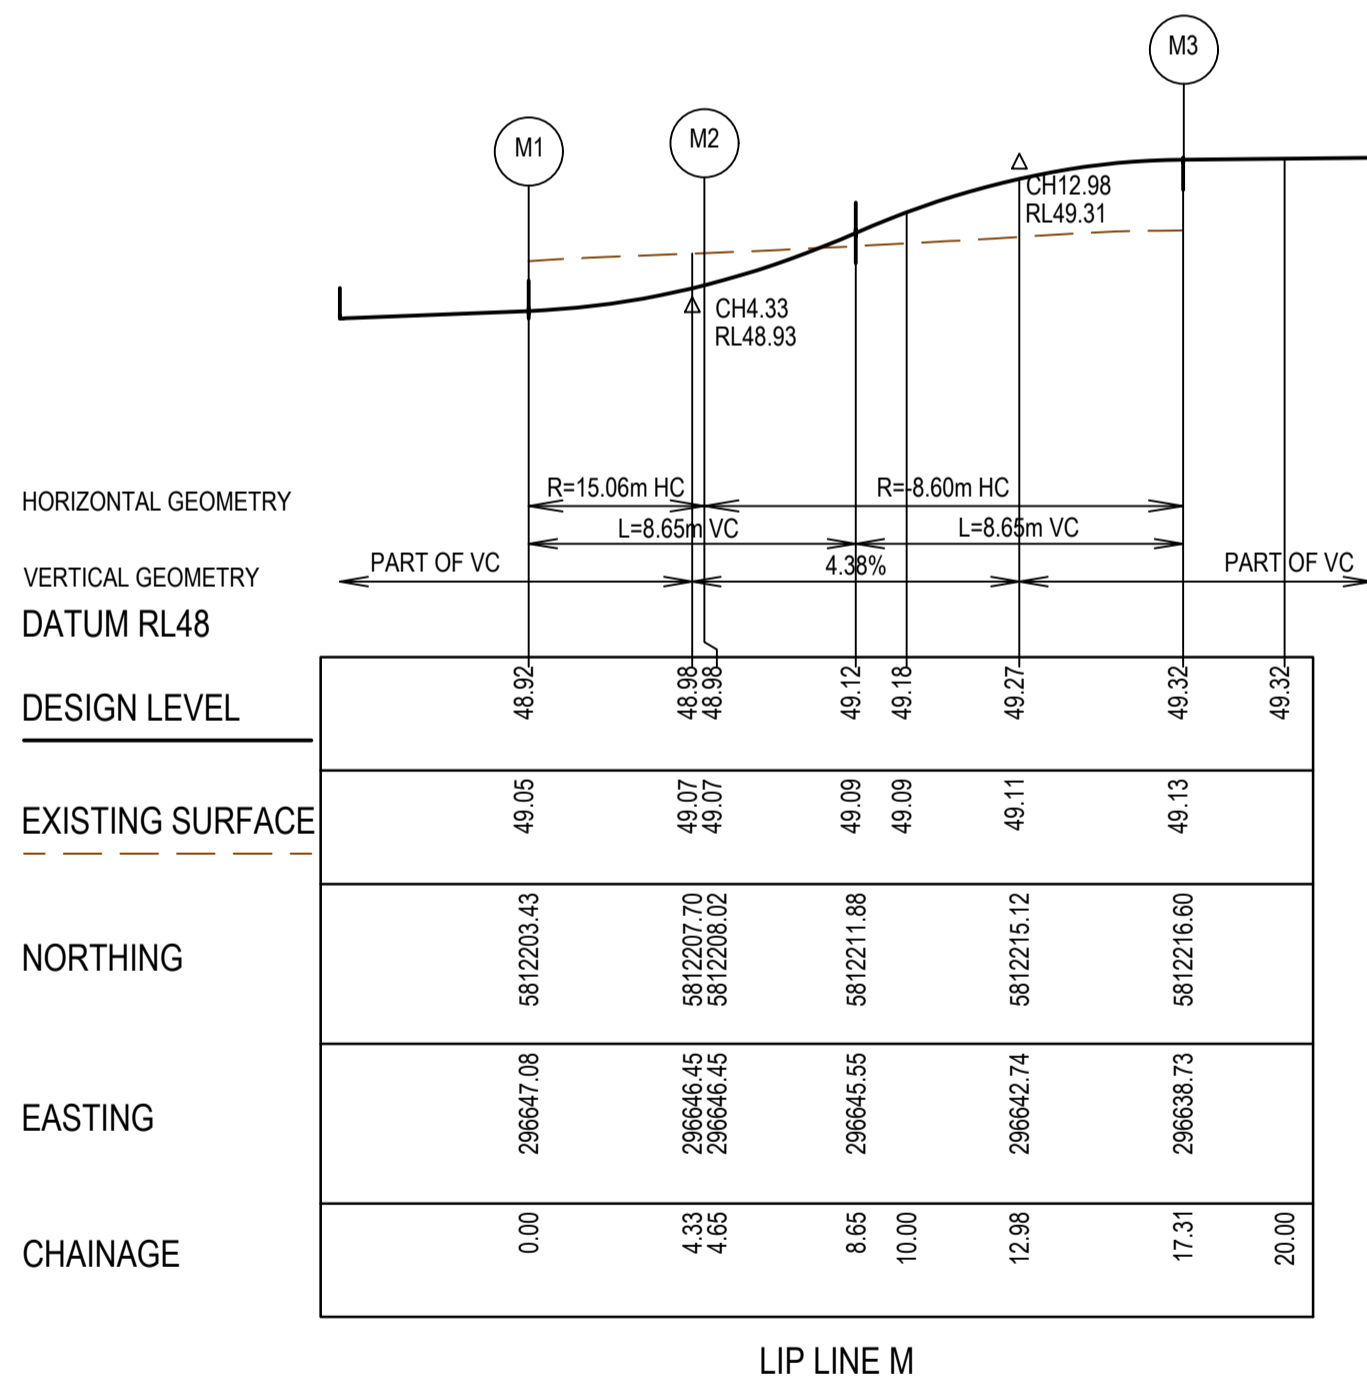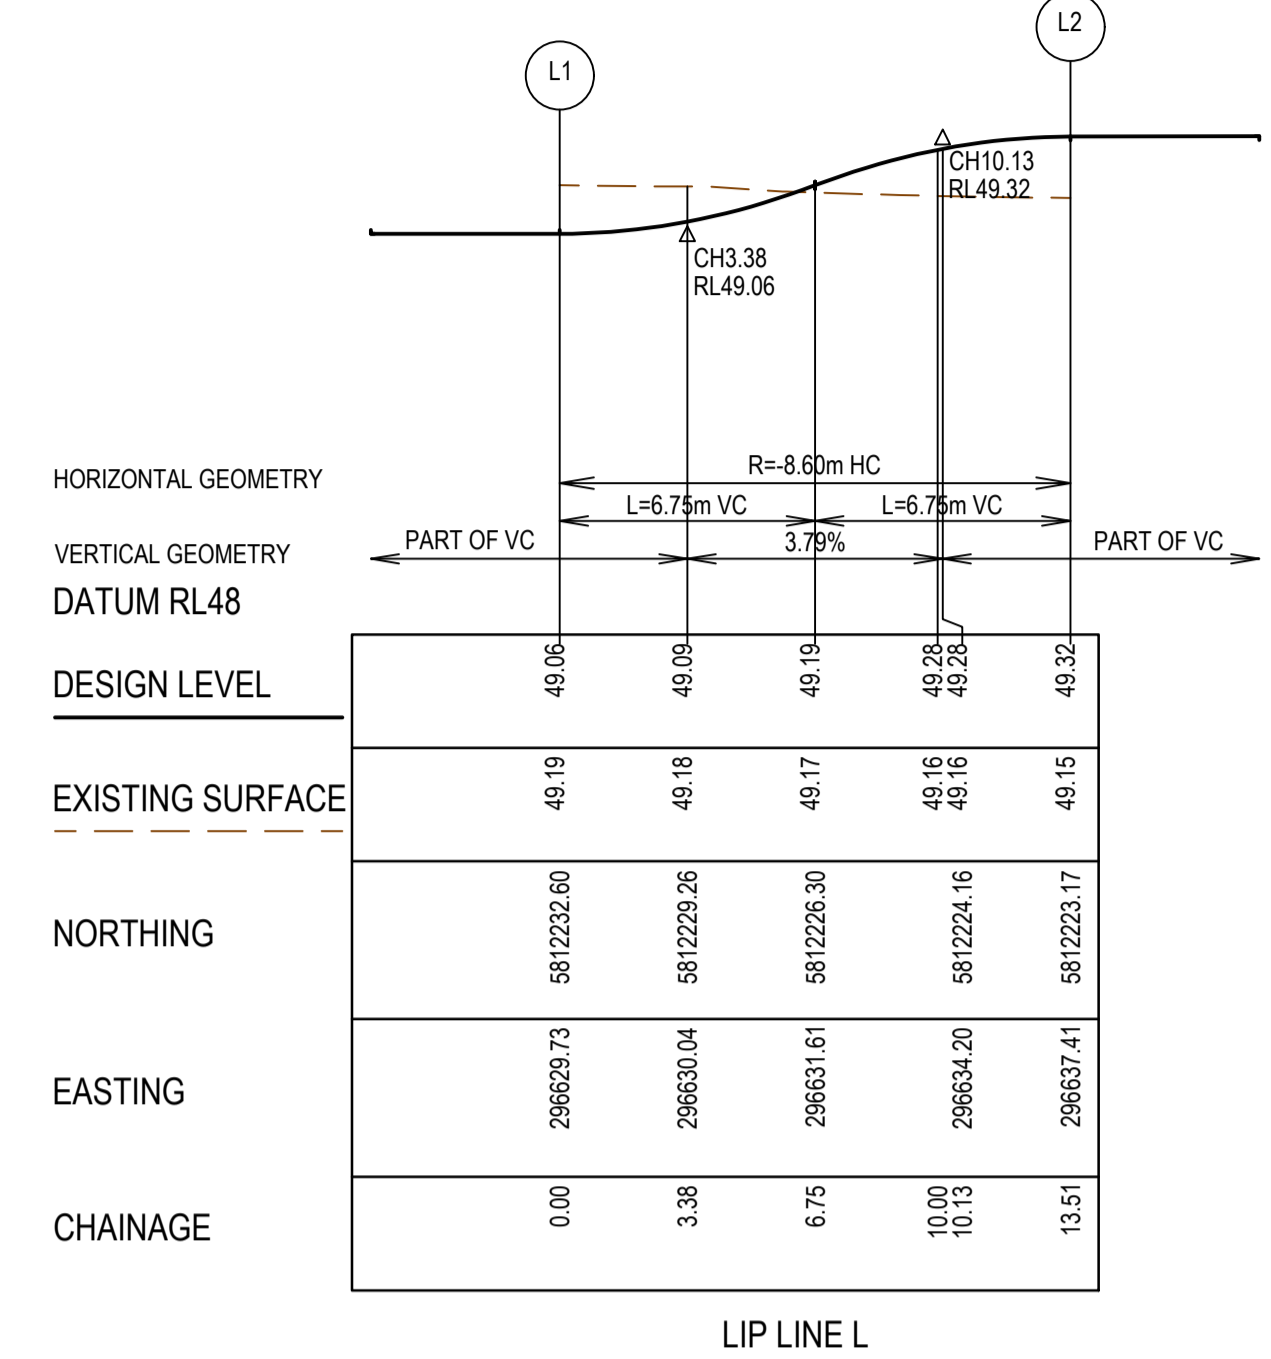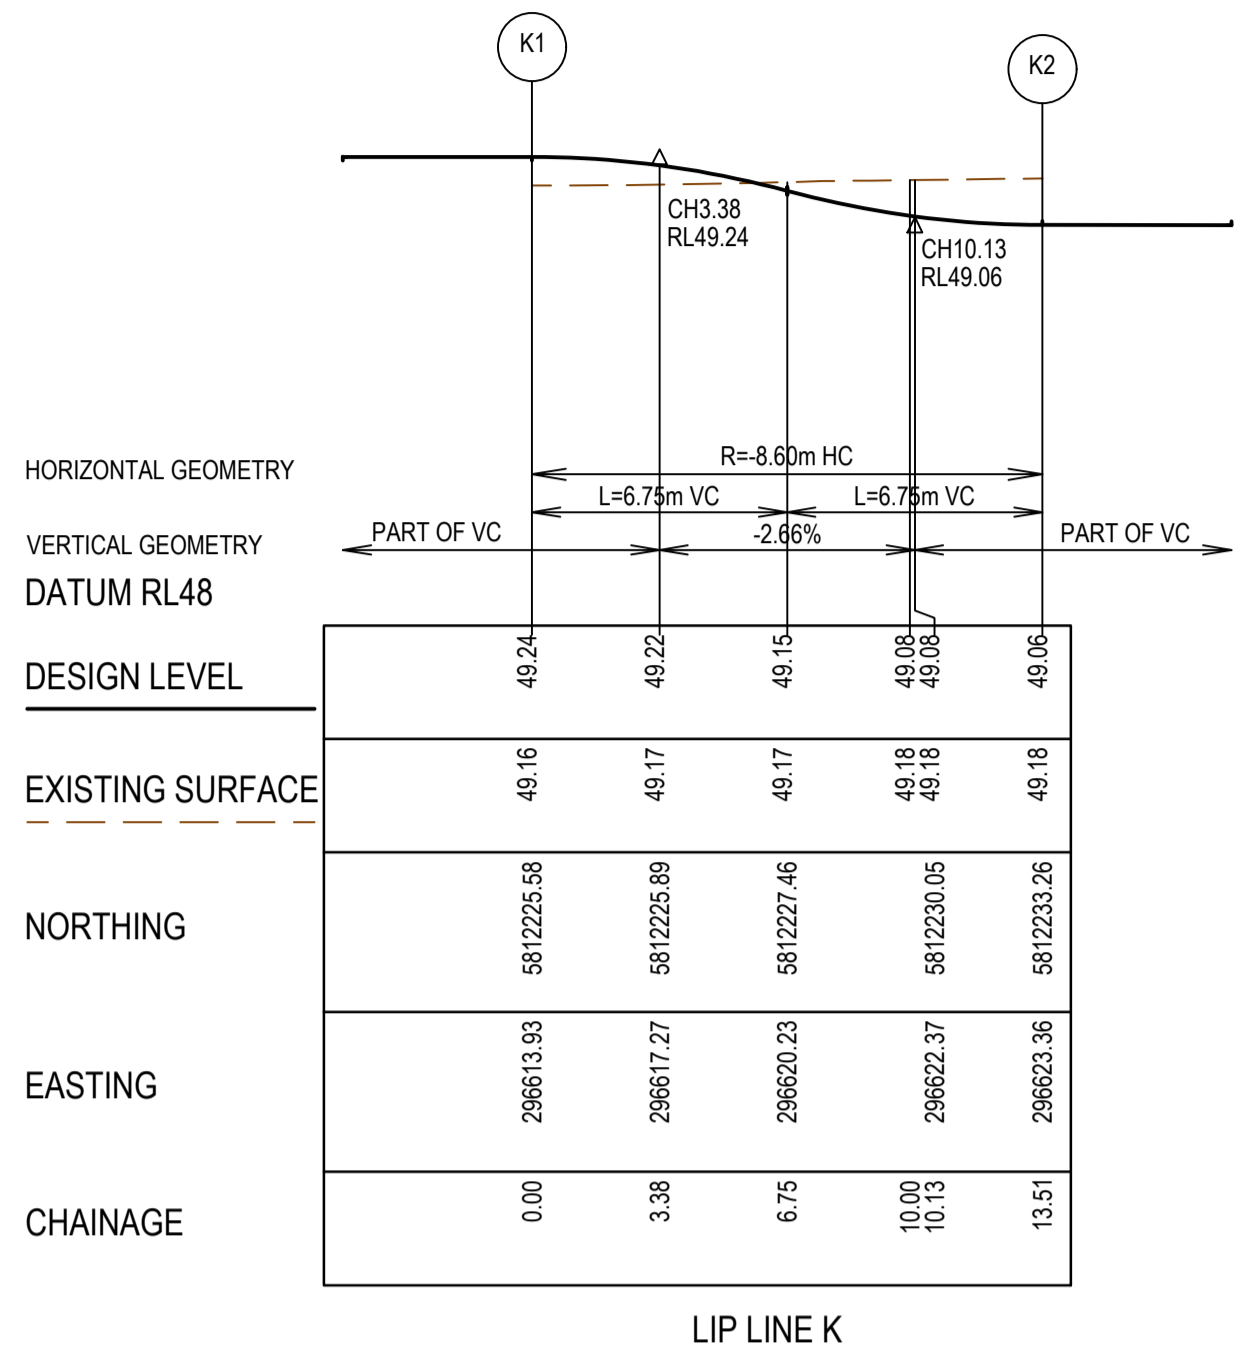

- NOTES**
- ALL VEHICLE CROSSINGS AND PRAM CROSSINGS TO BE MINIMUM OF 0.75m FROM PITS.
  - ALL PRAM CROSSINGS TO BE MINIMUM OF 2.0m FROM VEHICLE CROSSINGS.
  - VEHICLE EXCLUSION MEASURES BETWEEN ROAD RESERVE AND RESERVE TO FORM PART OF THE LANDSCAPE WORKS.
  - INDUSTRIAL DRIVEWAYS TO COUNCIL RESERVES TO BE PROVIDED AS PART OF LANDSCAPE WORKS.
  - SHARE PATH THROUGH CREEK CORRIDOR TO FORM PART OF LANDSCAPE WORKS.

**AS CONSTRUCTED PLANS**  
The purpose of these as-constructed plans is to update the design drawings to show significant changes which occurred during construction. Note that the levels shown on these plans are design levels, and have not been verified by survey. All information shown on these plans should be verified on site. SMEC Australia Pty Ltd accept no responsibility for loss or damages resulting from the inappropriate usage of these plans.

Quality Management ISO 9001  
OH&S Management AS/NZS 4801  
Environmental Management ISO 14001

Global-Mark.com.au®

**AS CONSTRUCTED**

PLAN OF SUB. NO.  
PS900882T  
PERMIT REF. NO.  
WYP10365/17.01

Scale 1:200

Scale H1:200, V1:20  
SCALE AS SHOWN AT 1

**SMEC**  
Member of the **Surbana Jurong Group**  
ABN 47 065 475 149  
Collins Square, Tower 4, Level 20, 727 Collins St  
Melbourne, VIC 3008  
Ph 03 9514 1500



**GROWLAND**

Marigold - Stage 7  
Wyndham City Council  
Road and Drainage  
Intersection Detail Plan - 4

MELWAYS REF: 359 F9  
PROJECT / DRAWING No: 2360E-007-184  
SHEET No: 09 of 28  
REVISION: 1

TYPE A CRUSHED ROCK OR GRANULAR CLASS 3 FOR STRUCTURAL FILL REQUIRED UNDER PAVEMENT AND FOOTPATHS WHERE CONSTRUCTED ABOVE EXISTING SURFACE (TO BE DETERMINED DURING CONSTRUCTION SUBJECT TO COUNCIL APPROVAL)

**LEGEND**  
  
 --- EXISTING SURFACE  
 ——— DESIGN LINE  
 ..... FUTURE DESIGN LINE

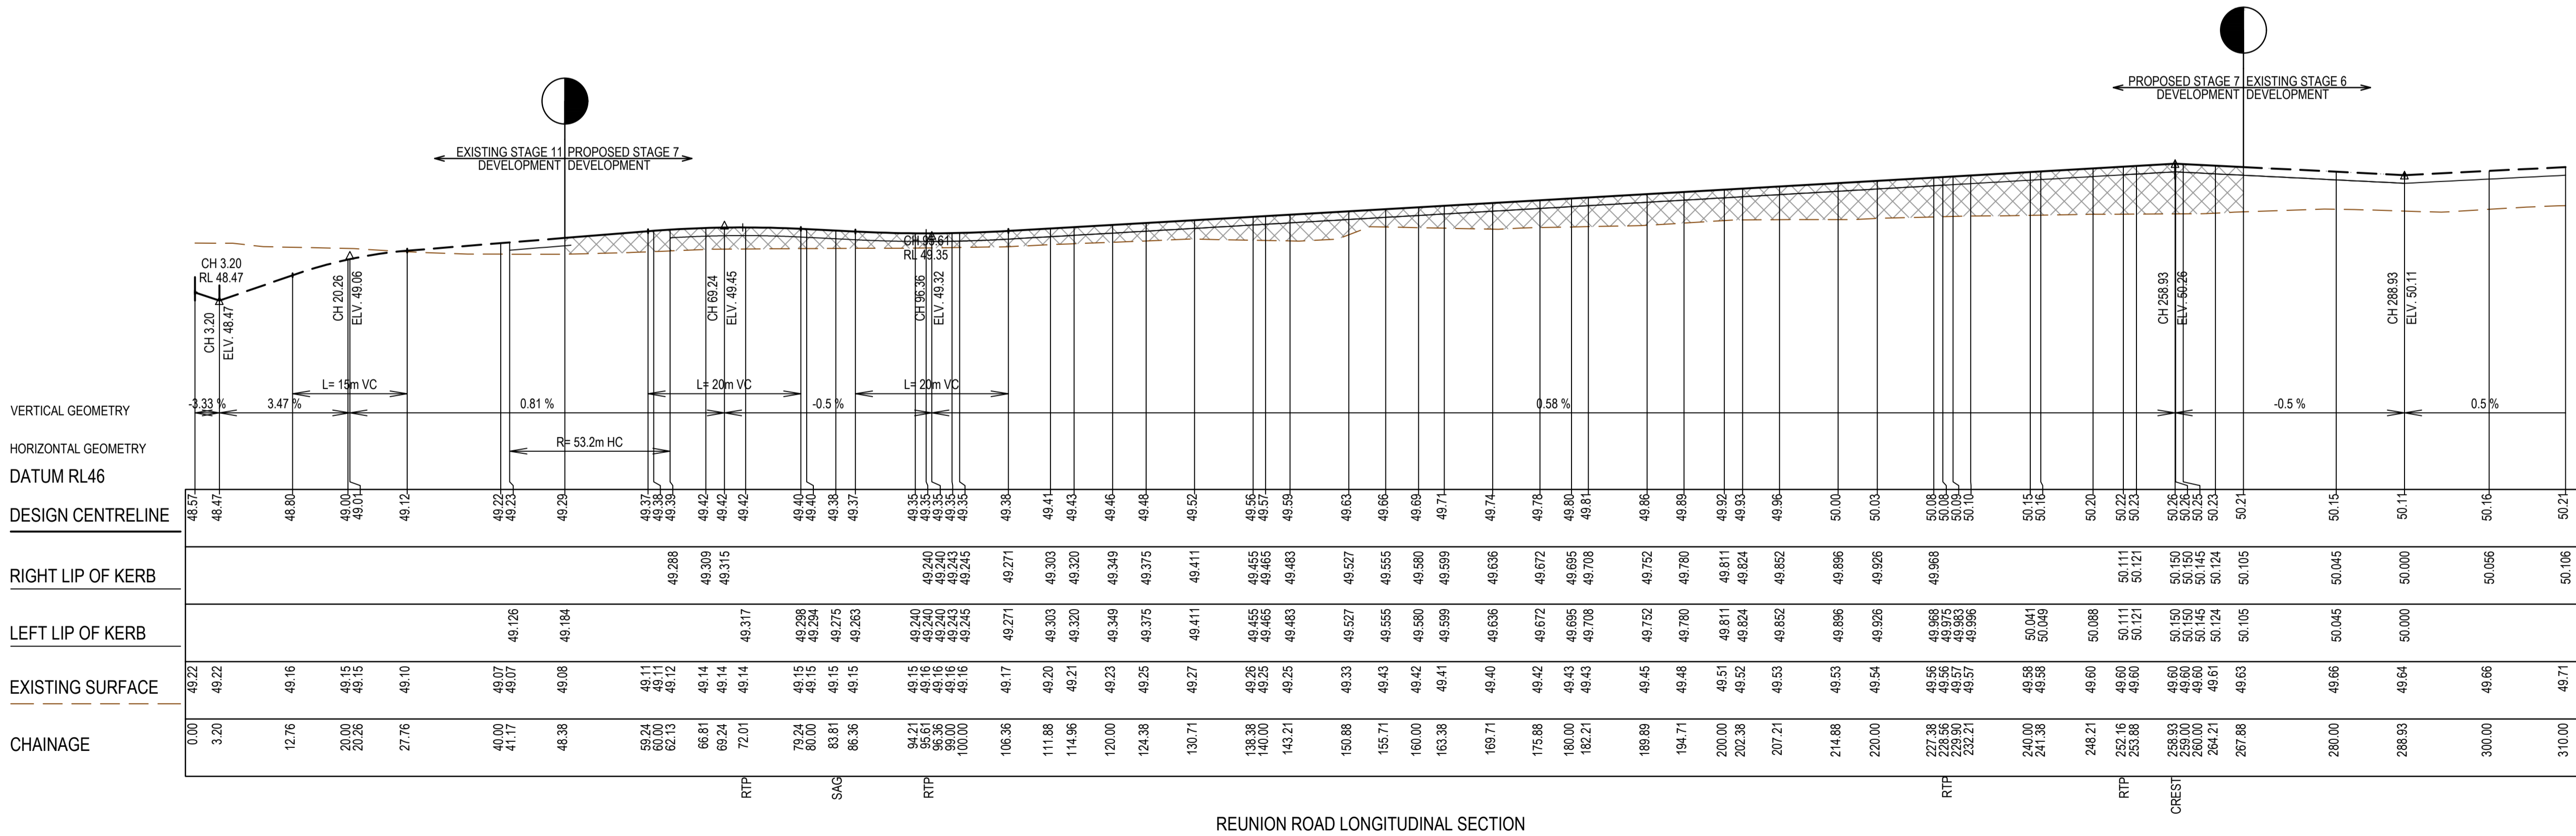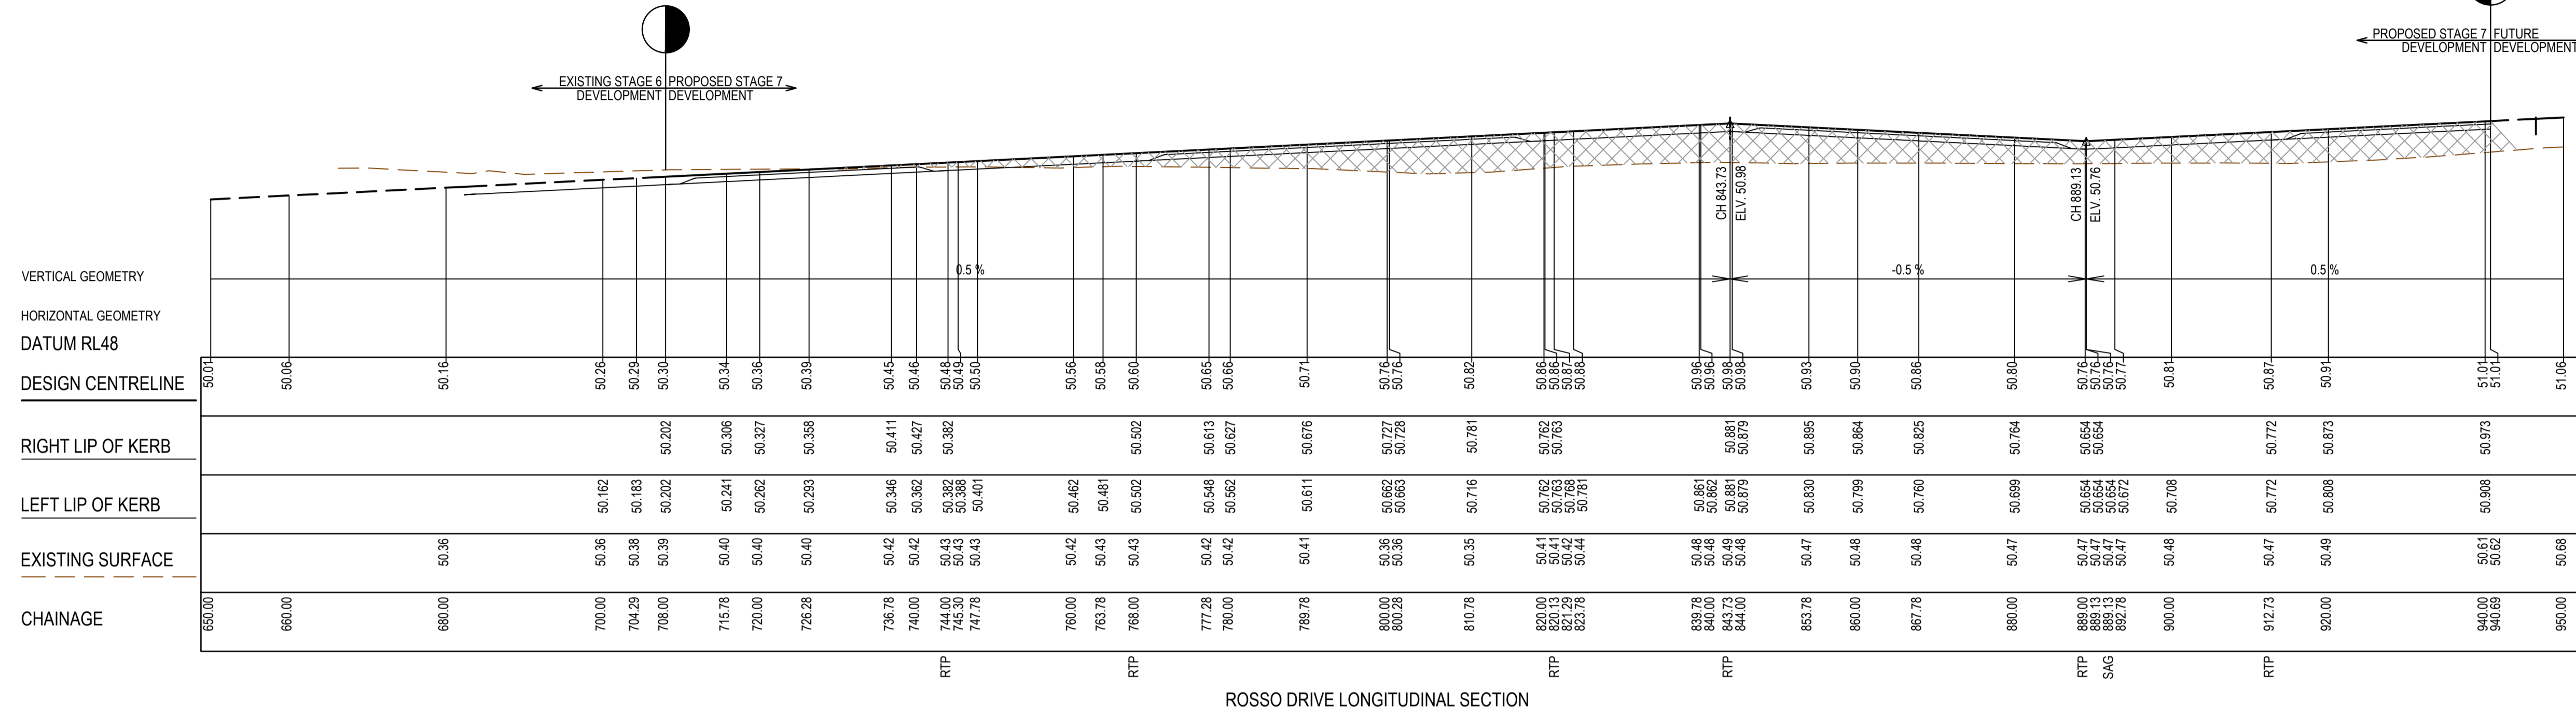



**AS CONSTRUCTED PLANS**

The purpose of these as-constructed plans is to update the design drawings to show significant changes which occurred during construction. Note that the levels shown on these plans are design levels, and have not been verified by survey. All information shown on these plans should be verified on site. SMEC Australia Pty Ltd accept no responsibility for loss or damages resulting from the inappropriate usage of these plans.



PLAN OF SUB. NO.  
 PS900882T  
 PERMIT REF. NO.  
 WYP10365/17.01

**AS CONSTRUCTED**


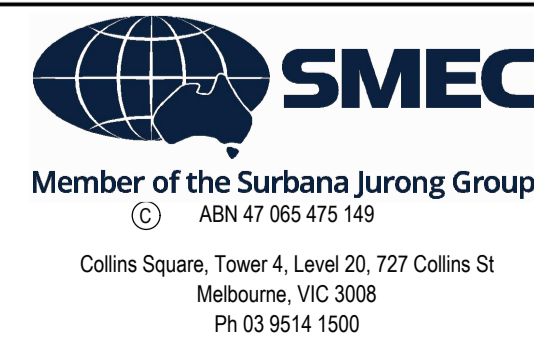
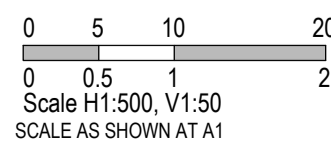


Marigold - Stage 7  
 Wyndham City Council  
 Road and Drainage  
 Longitudinal Sections - 1

MELWAYS REF 359 F9	PROJECT / DRAWING No. 2360E-007-201	SHEET No. 10 of 28	REVISION 1
-----------------------	--	-----------------------	---------------

TYPE A CRUSHED ROCK OR GRANULAR CLASS 3 FOR STRUCTURAL FILL REQUIRED UNDER PAVEMENT AND FOOTPATHS WHERE CONSTRUCTED ABOVE EXISTING SURFACE (TO BE DETERMINED DURING CONSTRUCTION SUBJECT TO COUNCIL APPROVAL)

**LEGEND**  
 - - - EXISTING SURFACE  
 ——— DESIGN LINE  
 - - - FUTURE DESIGN LINE

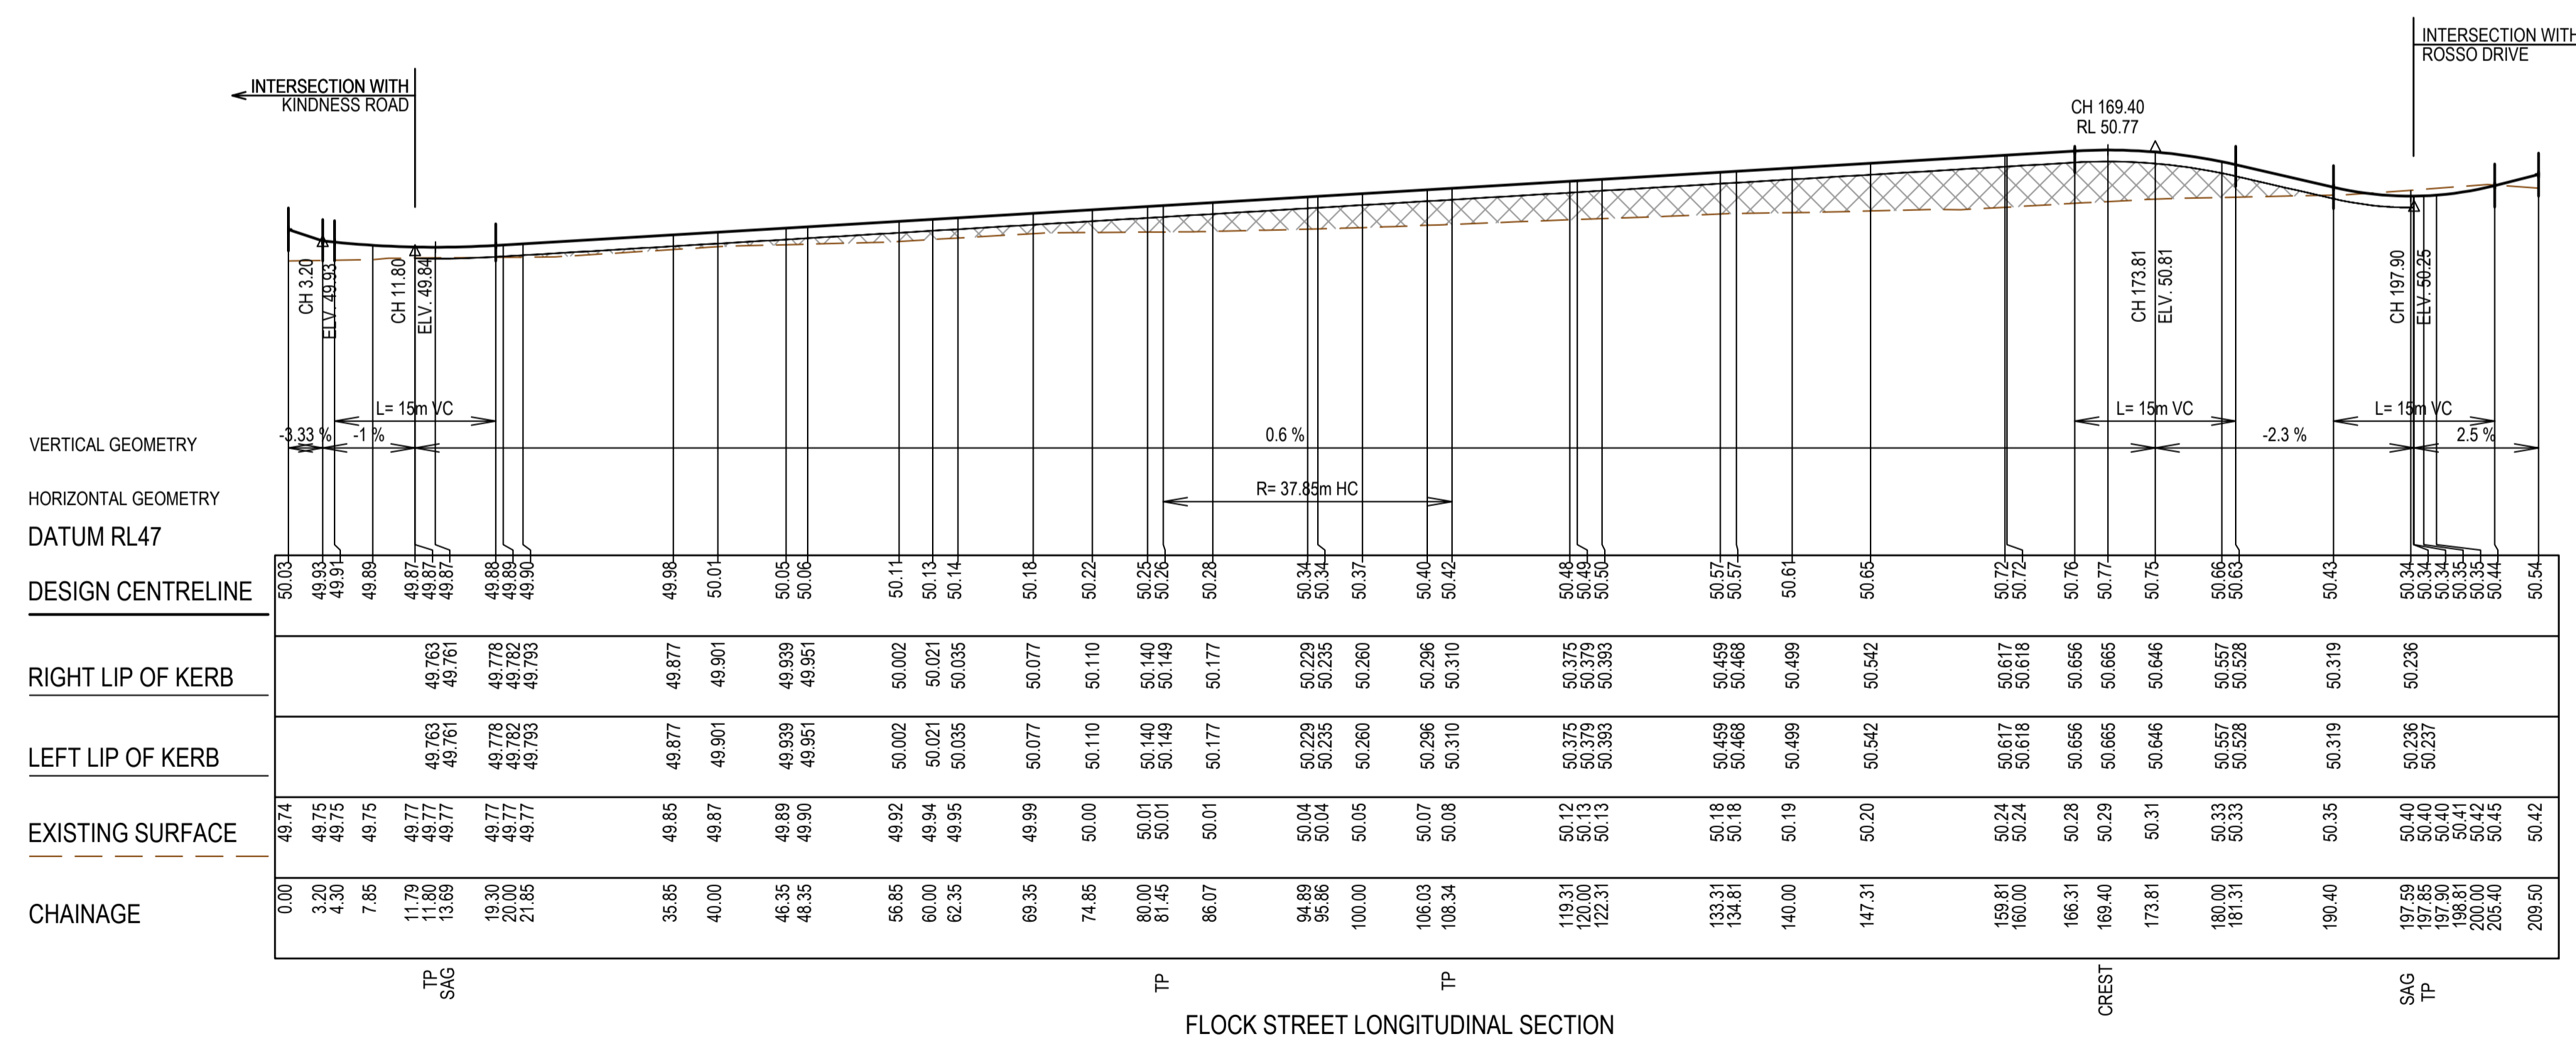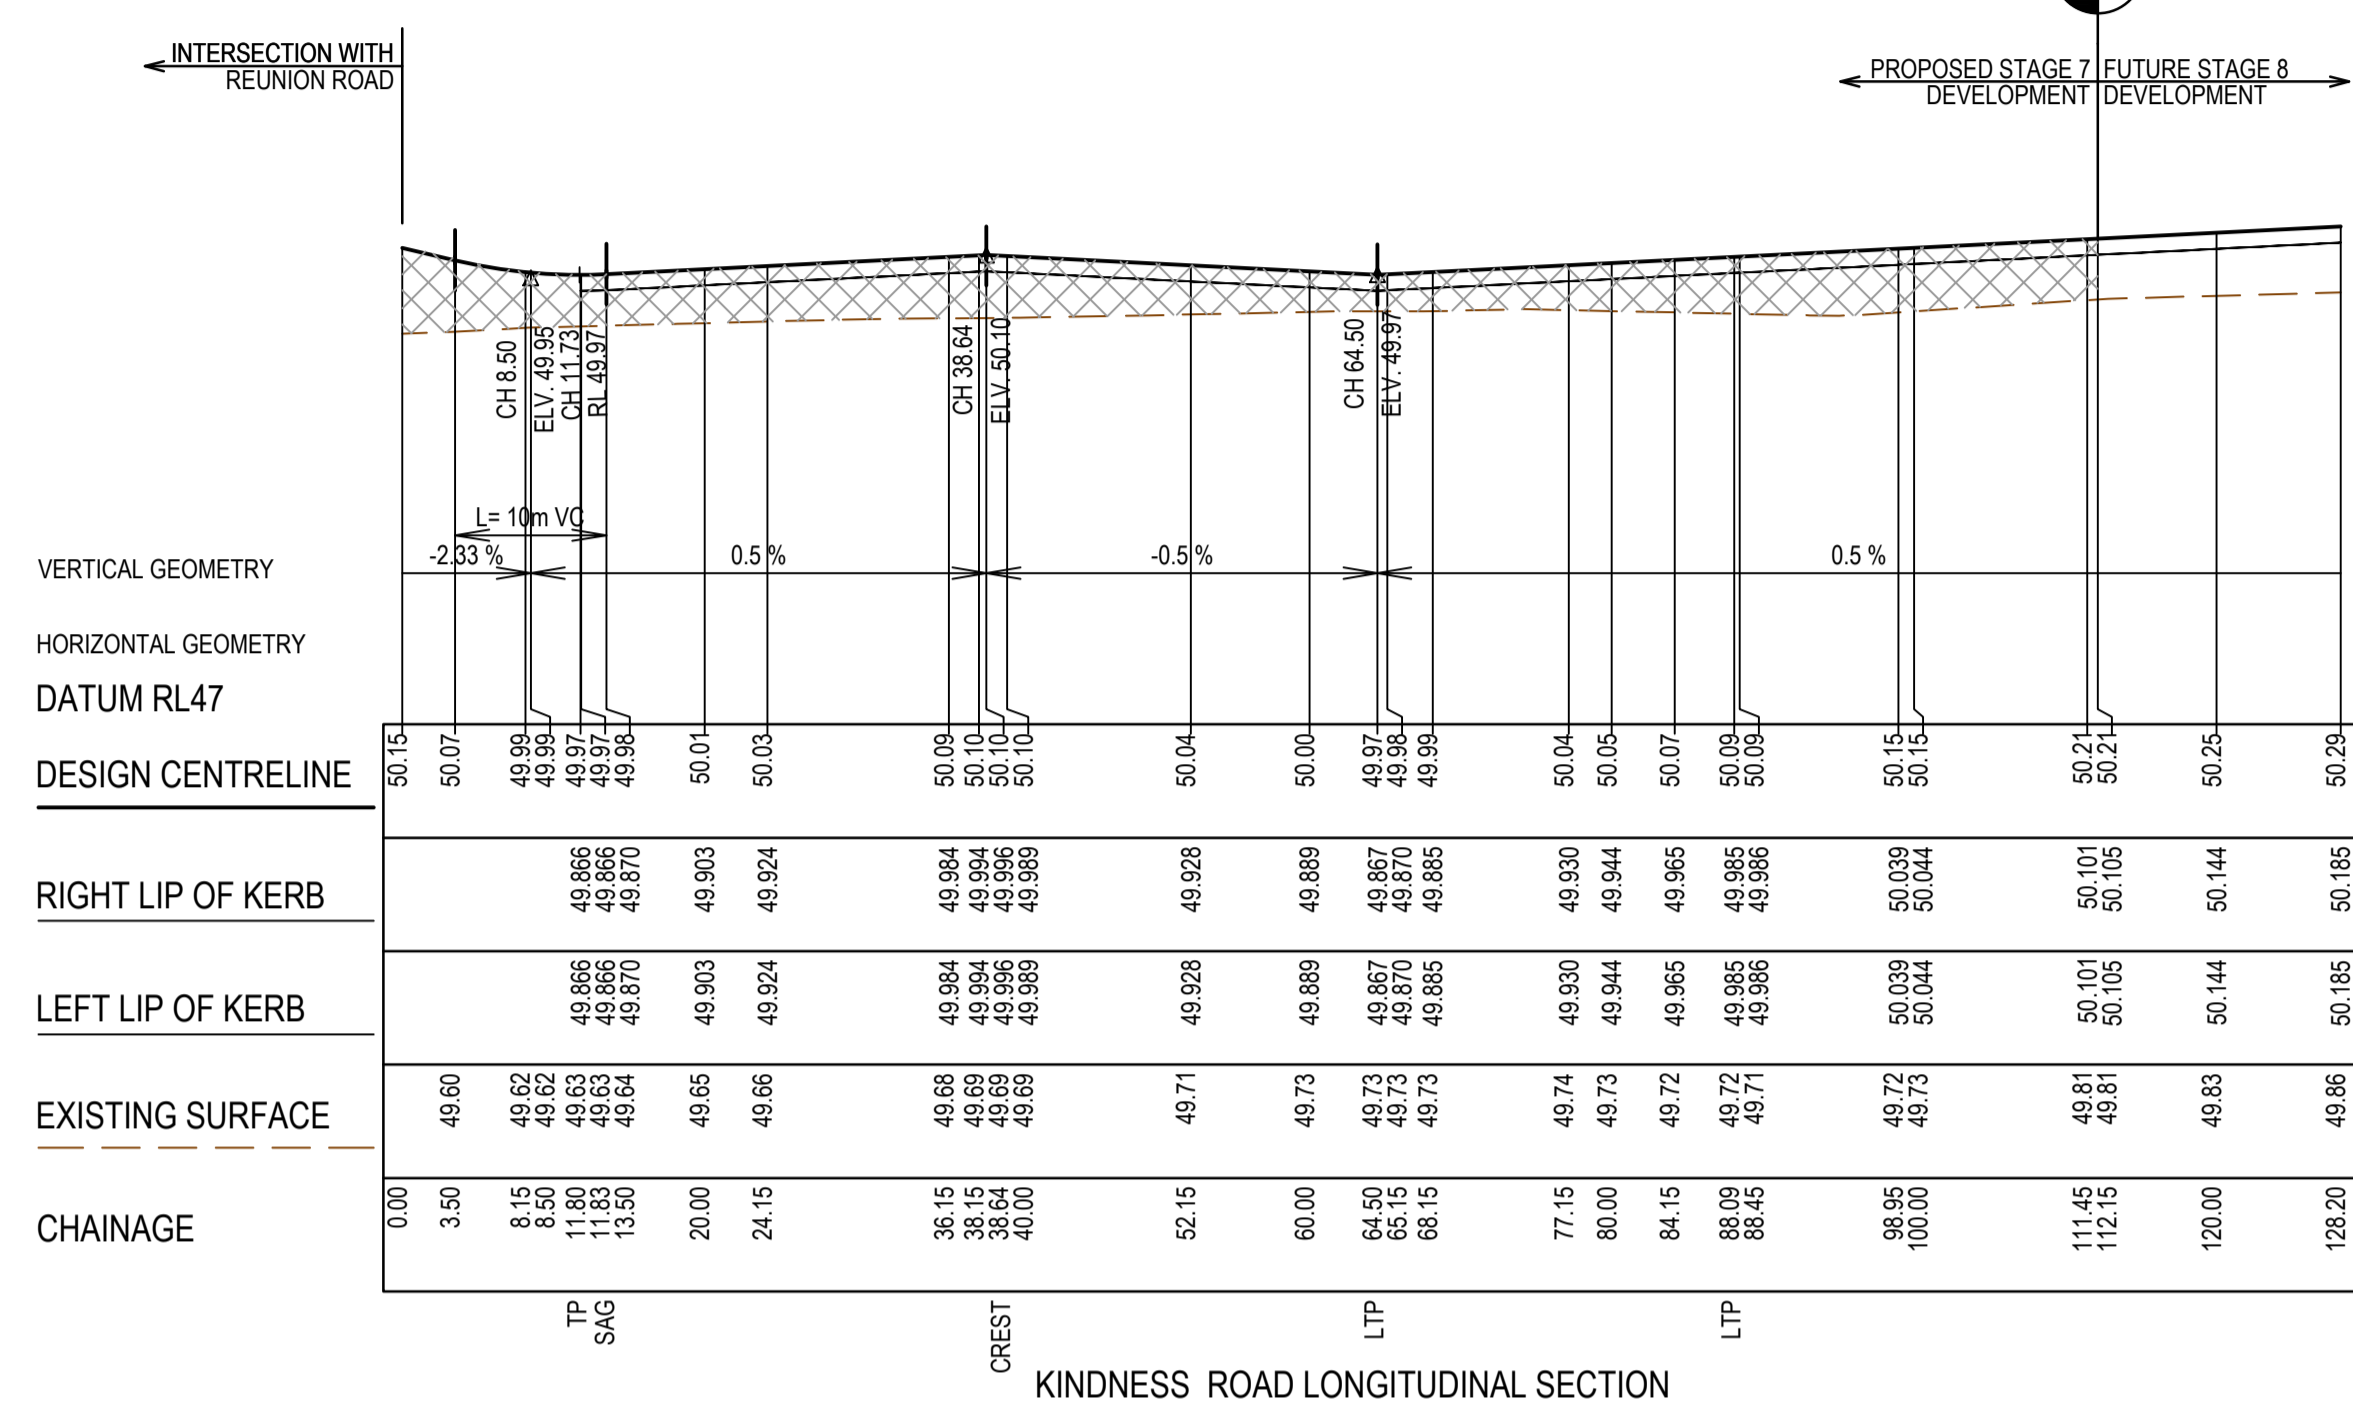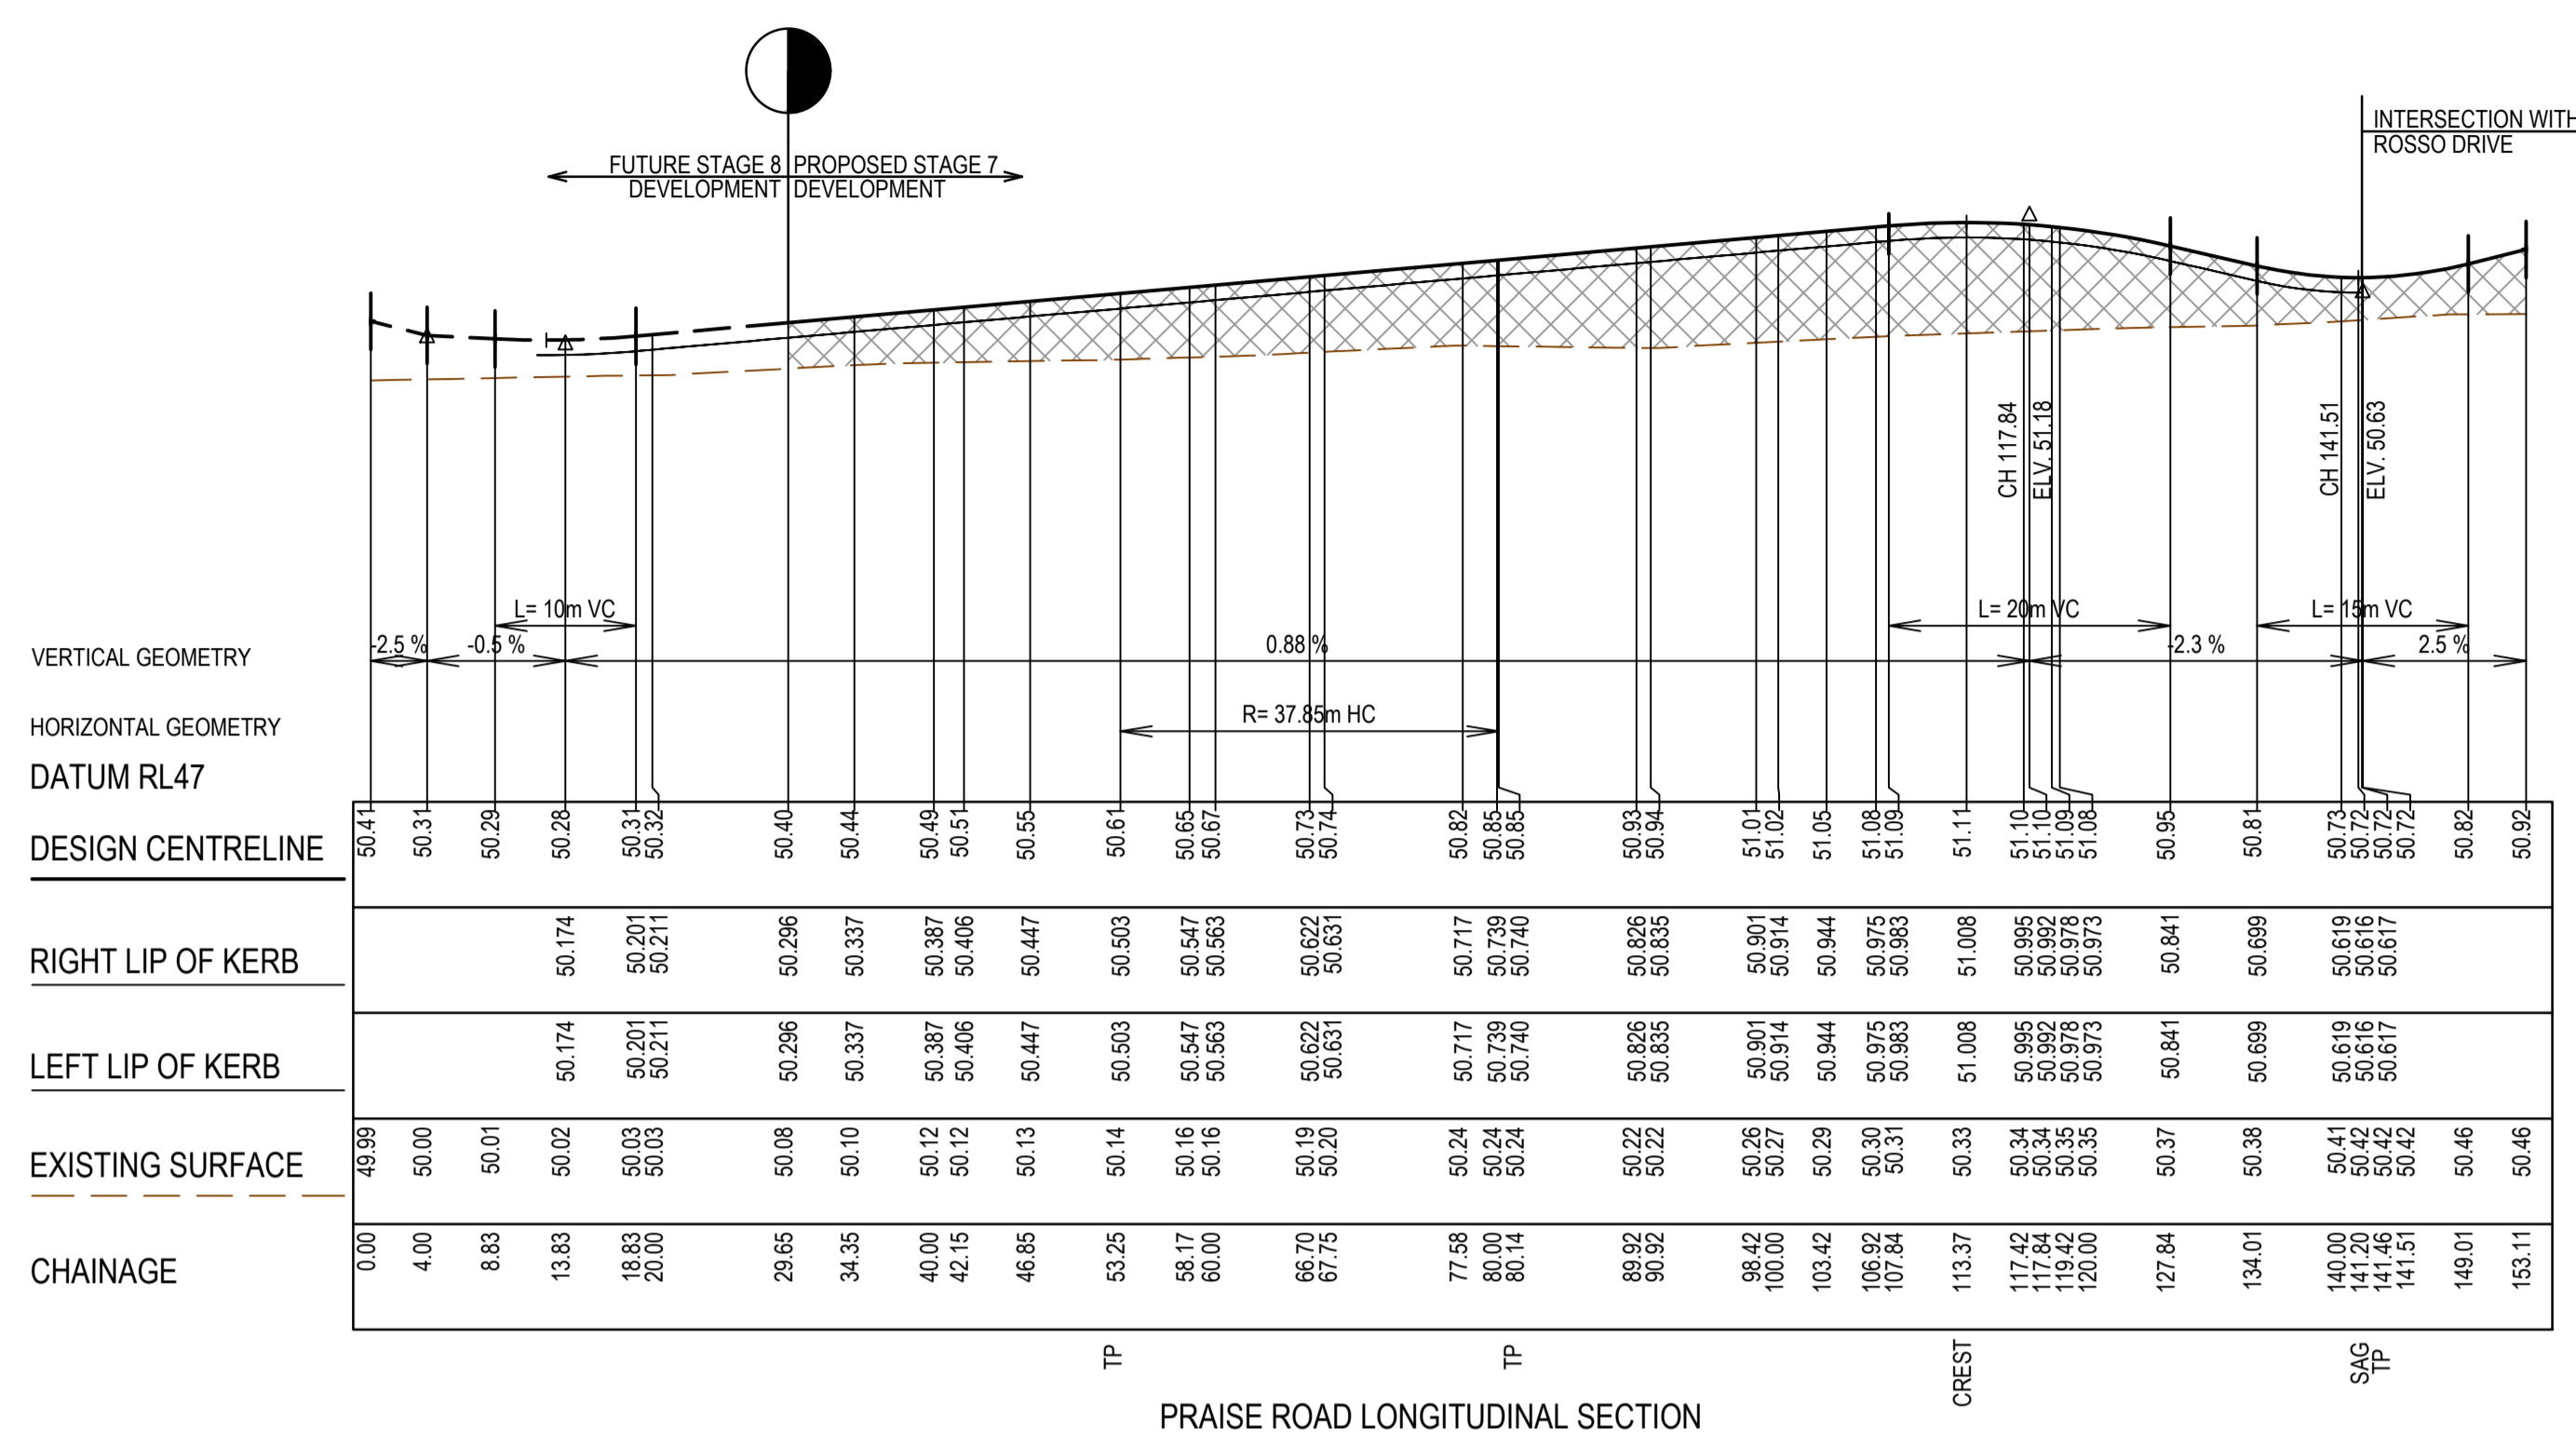

**AS CONSTRUCTED PLANS**  
 The purpose of these as-constructed plans is to update the design drawings to show significant changes which occurred during construction. Note that the levels shown on these plans are design levels, and have not been verified by survey. All information shown on these plans should be verified on site. SMEC Australia Pty Ltd accept no responsibility for loss or damages resulting from the inappropriate usage of these plans.

Quality Management - ISO 9001  
 OHS Management - AS/NZS 4801  
 Environmental Management - ISO 14001

Global-Mark.com.au®

**AS CONSTRUCTED**

PLAN OF SUB. NO. PS90082T  
 PERMIT REF. NO. WYP10365/17.01


0 5 10 20  
 0 0.5 1 2  
 Scale H1:500, V1:50  
 SCALE AS SHOWN AT 1

**SMEC**  
 Member of the Surlana Jurong Group  
 ABN 47 065 475 149  
 Collins Square, Tower 4, Level 20, 727 Collins St  
 Melbourne, VIC 3008  
 Ph 03 9514 1500


**GROWLAND**

Marigold - Stage 7  
 Wyndham City Council  
 Road and Drainage  
 Longitudinal Sections - 2


MELWAYS REF: 359 F9  
 PROJECT / DRAWING No: 2360E-007-202  
 SHEET No: 11 of 28  
 REVISION: 1

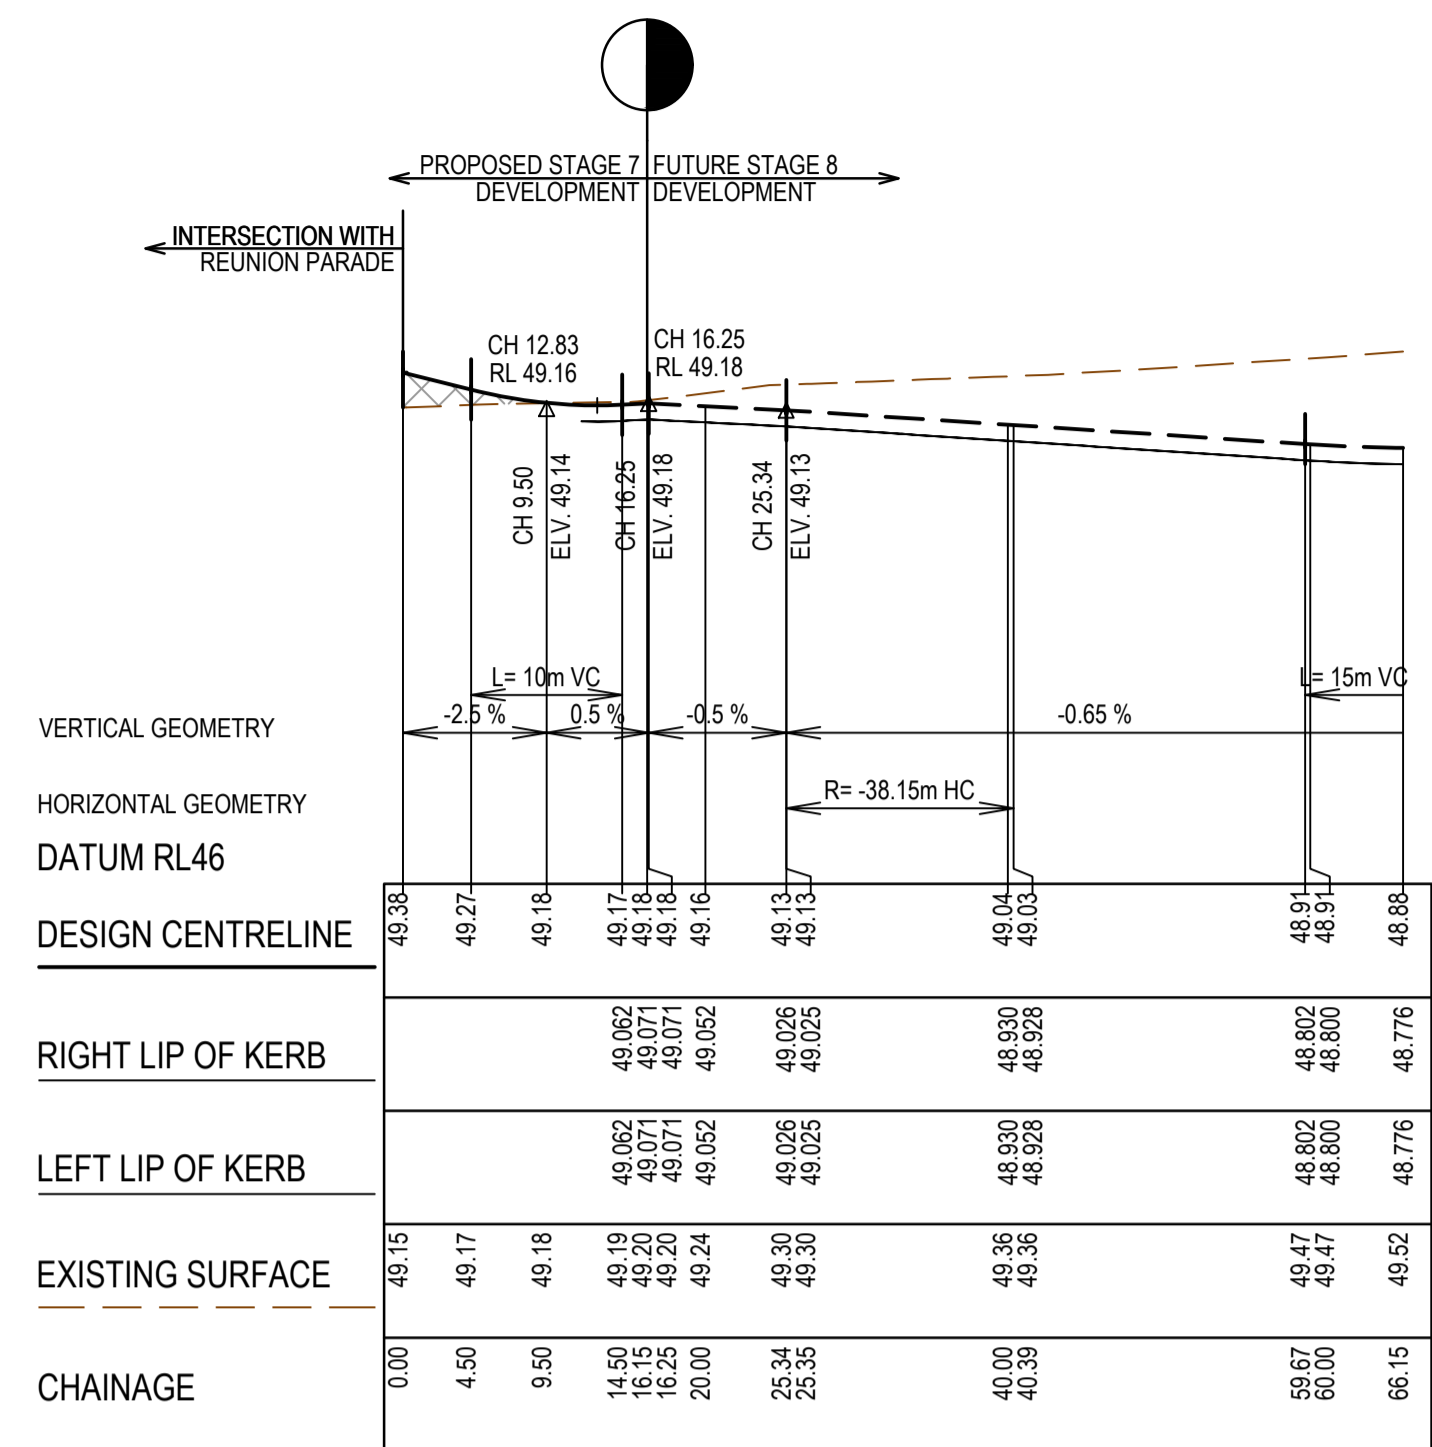

RECOGNITION AVENUE LONGITUDINAL SECTION - 1

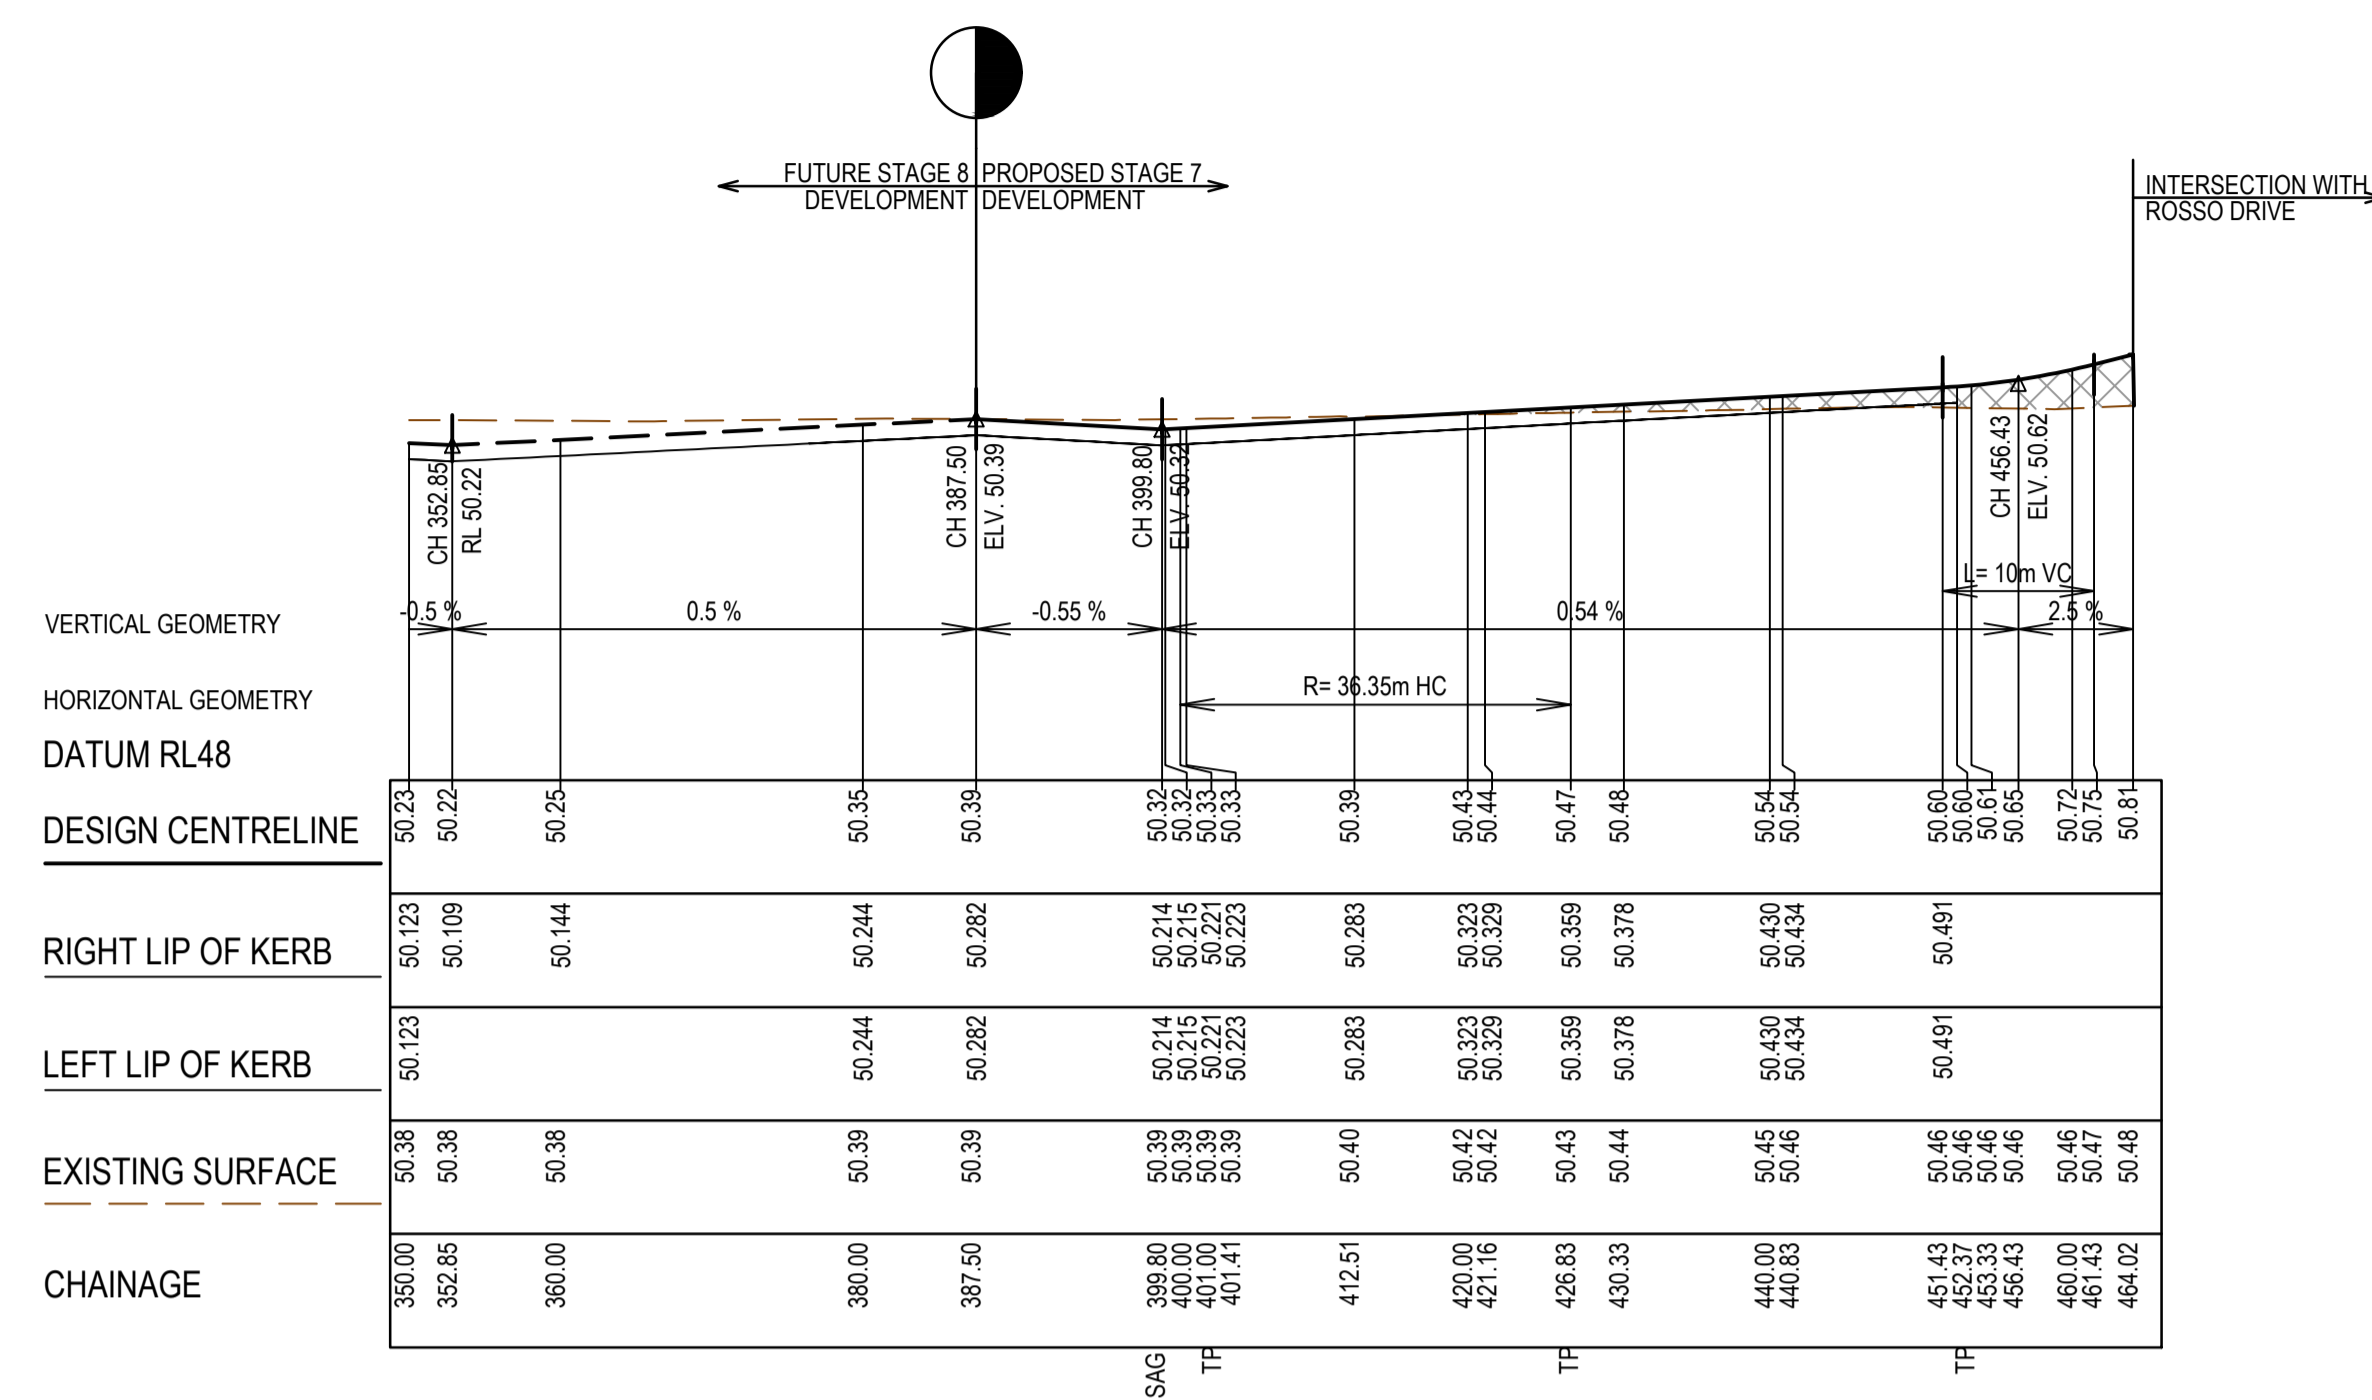

RECOGNITION AVENUE LONGITUDINAL SECTION - 2

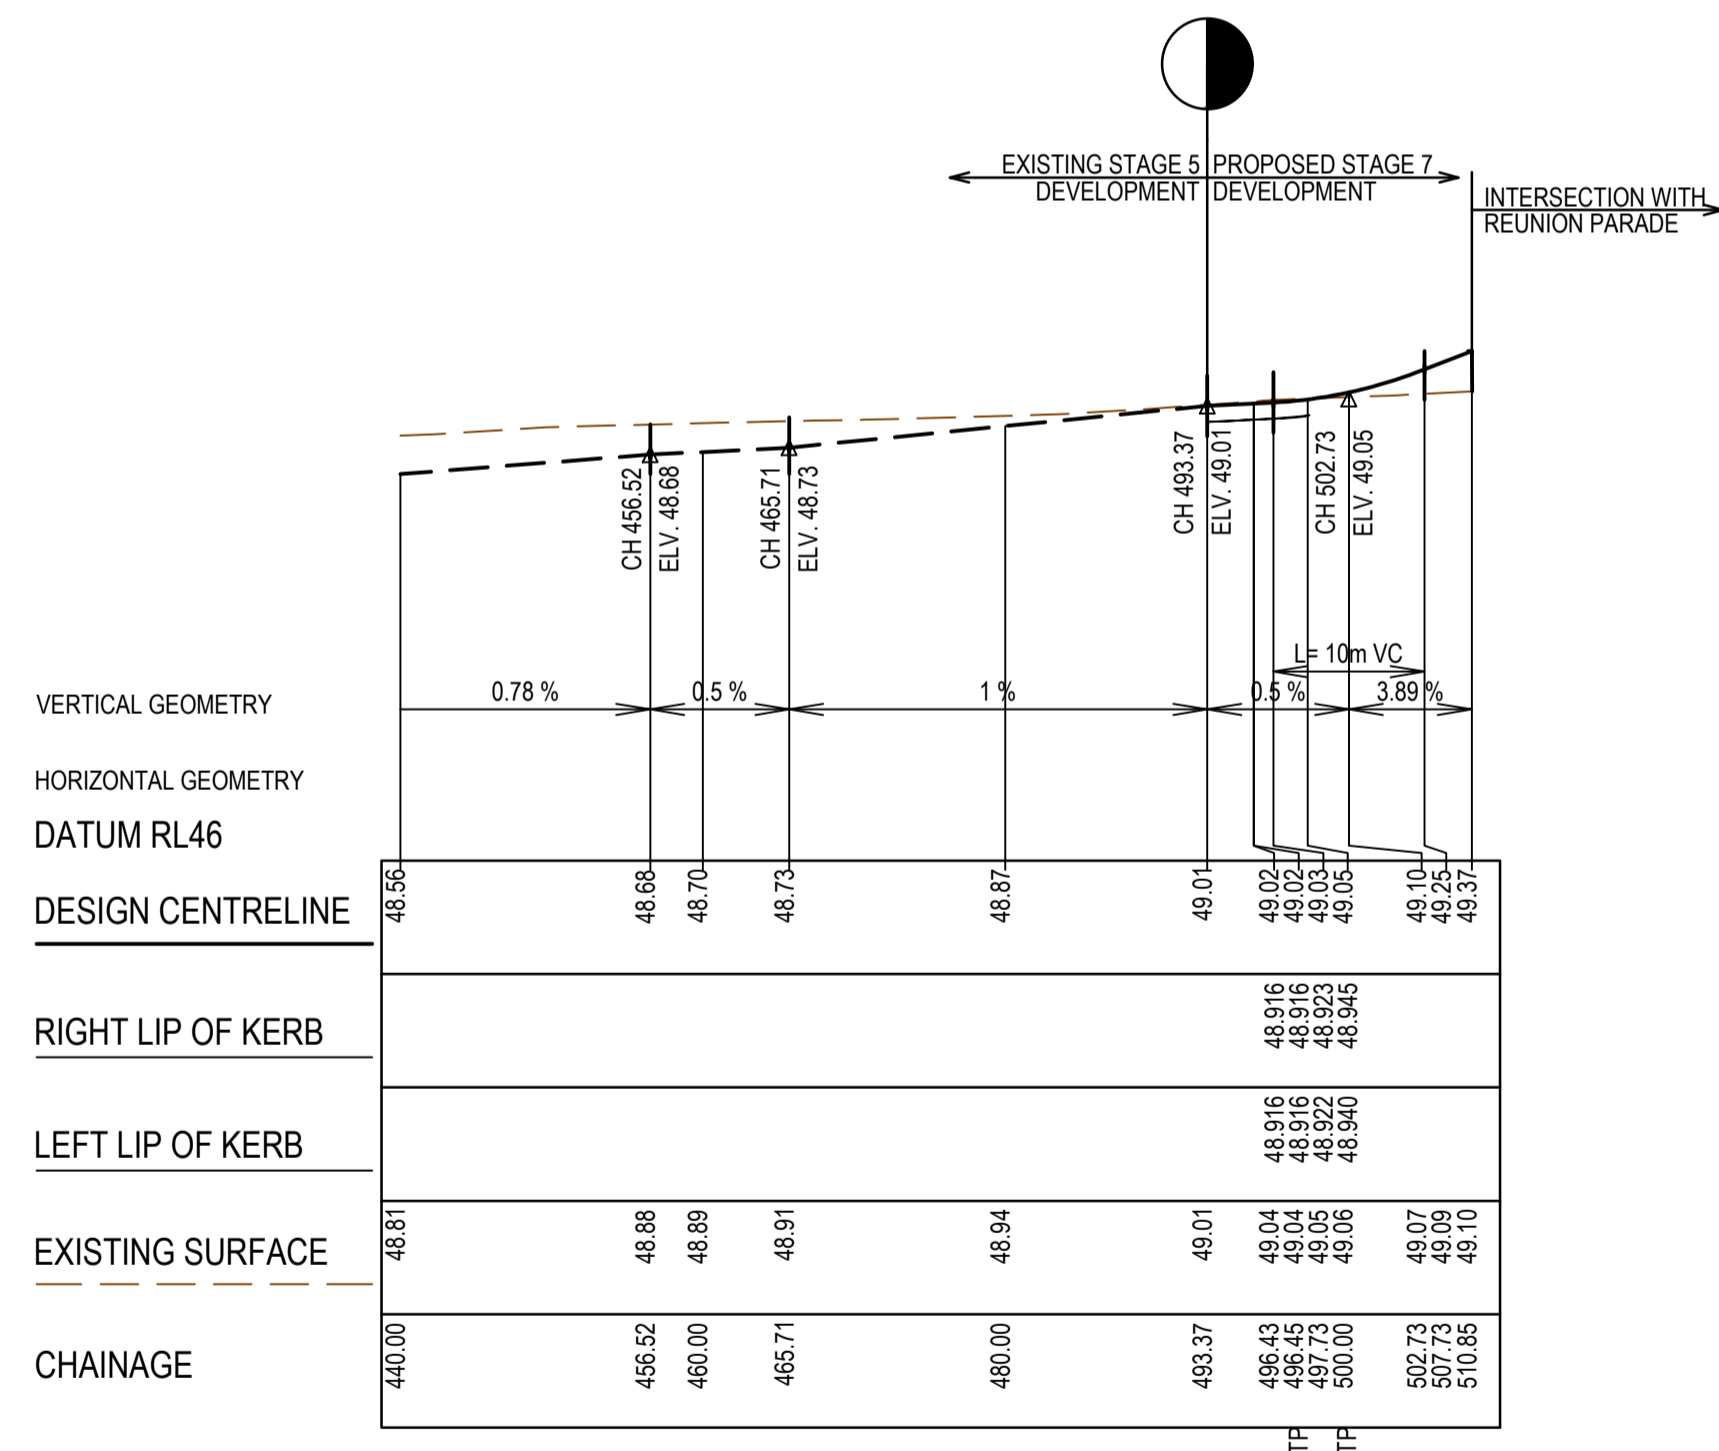

PADMA BOULEVARD LONGITUDINAL SECTION


**AS CONSTRUCTED PLANS**

The purpose of these as-constructed plans is to update the design drawings to show significant changes which occurred during construction. Note that the levels shown on these plans are design levels, and have not been verified by survey. All information shown on these plans should be verified on site. SMEC Australia Pty Ltd accept no responsibility for loss or damages resulting from the inappropriate usage of these plans.

PLAN OF SUB. NO.  
PS900882T

PERMIT REF. NO.  
WYP10365/17.01

**AS CONSTRUCTED**

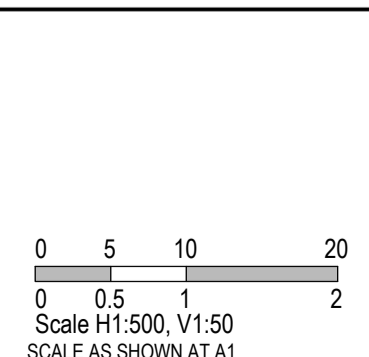

**SMEC**


Member of the Surlana Jurong Group

Collins Square, Tower 4, Level 20, 727 Collins St  
Melbourne, VIC 3008  
Ph 03 9514 1500

**GROWLAND**

Marigold - Stage 7  
Wyndham City Council  
Road and Drainage  
Longitudinal Sections - 3


MELWAYS REF <b>359 F9</b>	PROJECT / DRAWING No. <b>2360E-007-203</b>	SHEET No. <b>12 of 28</b>	REVISION <b>1</b>
------------------------------	---	------------------------------	----------------------

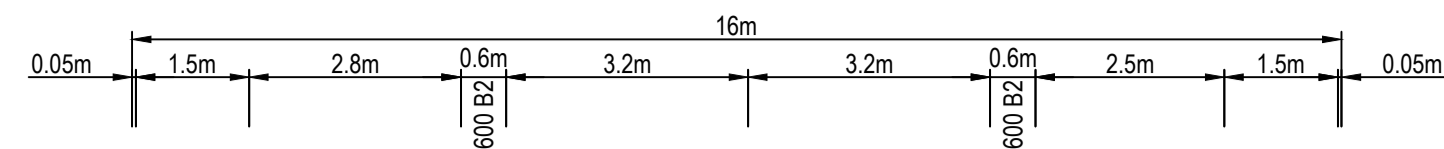

STRUCTURAL FILL REQUIRED UNDER PAVEMENT AND FOOTPATHS WHERE CONSTRUCTED ABOVE EXISTING SURFACE


DATUM49.0										
DESIGN SURFACE	50.69	50.39	50.56	50.42	50.31	50.42	50.31	50.42	50.54	50.57
EXISTING SURFACE	50.08	50.08	50.08	50.08	50.08	50.08	50.08	50.08	50.08	50.08
OFFSET	-8.15	-8.10	-6.60	-3.80	-3.20	0.00	3.20	3.80	6.30	7.85

TPCH 108.34

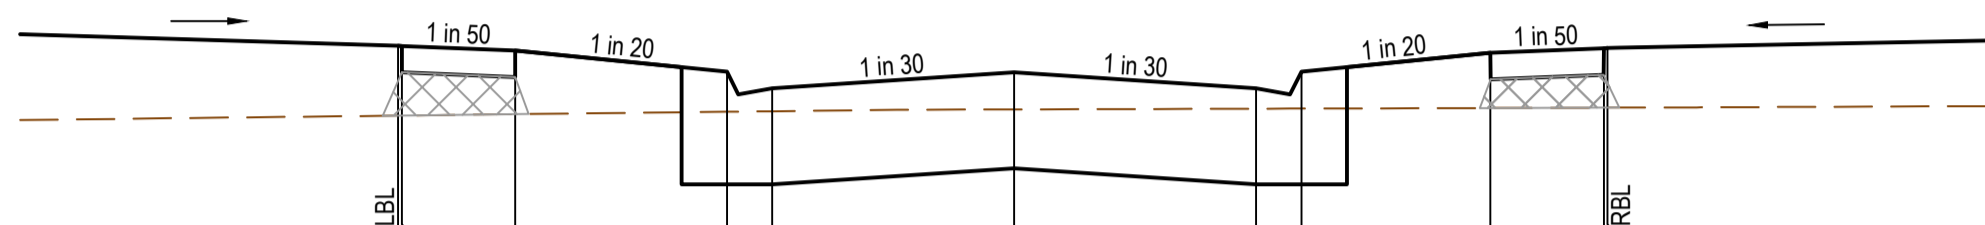


DATUM49.0										
DESIGN SURFACE	50.43	50.43	50.40	50.26	50.15	50.26	50.15	50.38	50.41	50.42
EXISTING SURFACE	49.97	49.97	49.98	49.98	50.00	50.01	50.01	50.02	50.02	50.02
OFFSET	-8.15	-8.10	-6.60	-3.80	-3.20	0.00	3.20	3.80	6.30	7.85

TPCH 81.45

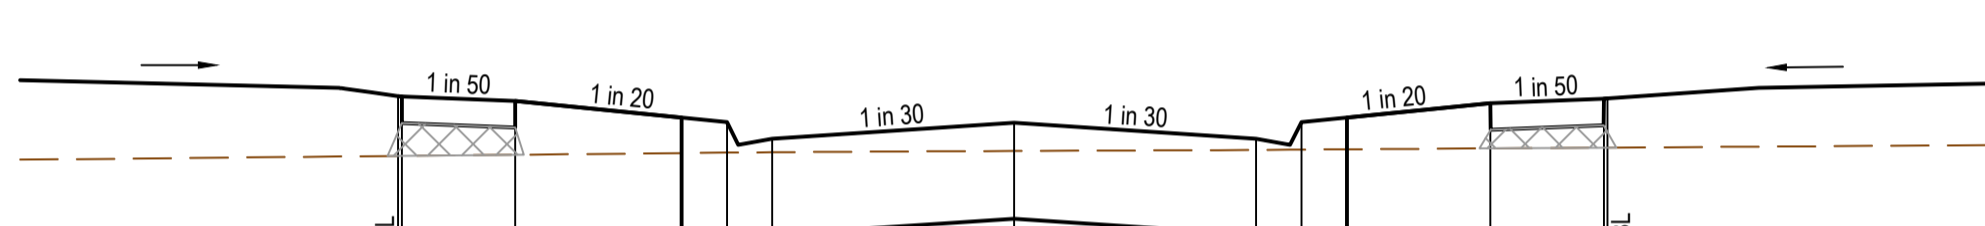


DATUM49.0										
DESIGN SURFACE	50.28	50.28	50.25	50.11	50.00	50.11	50.00	50.11	50.24	50.27
EXISTING SURFACE	49.88	49.88	49.90	49.91	49.91	49.92	49.93	49.93	49.94	49.94
OFFSET	-8.15	-8.10	-6.60	-3.80	-3.20	0.00	3.20	3.80	6.30	7.85

CH 56.85

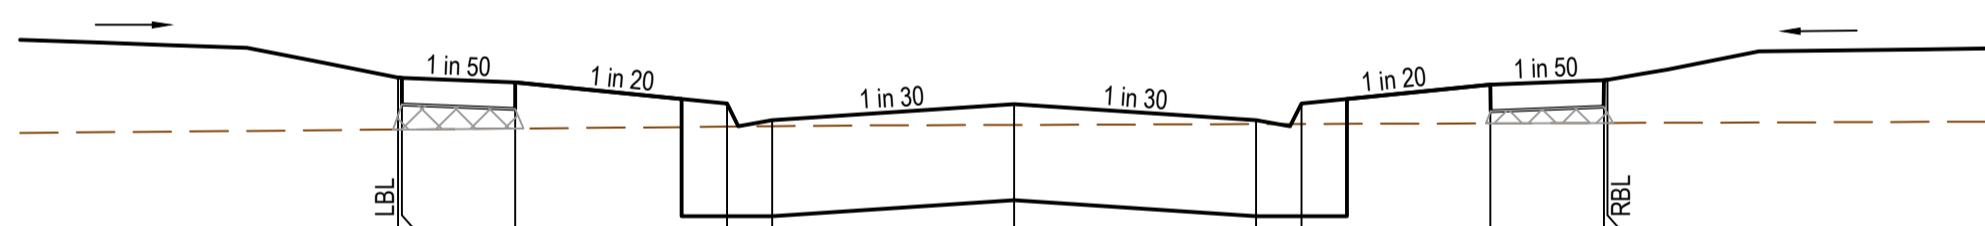


DATUM49.0										
DESIGN SURFACE	50.16	50.16	50.13	49.99	49.88	49.98	49.88	49.99	50.11	50.14
EXISTING SURFACE	49.82	49.82	49.82	49.83	49.84	49.85	49.85	49.85	49.86	49.86
OFFSET	-8.15	-8.10	-6.60	-3.80	-3.20	0.00	3.20	3.80	6.30	7.85

CH 35.85

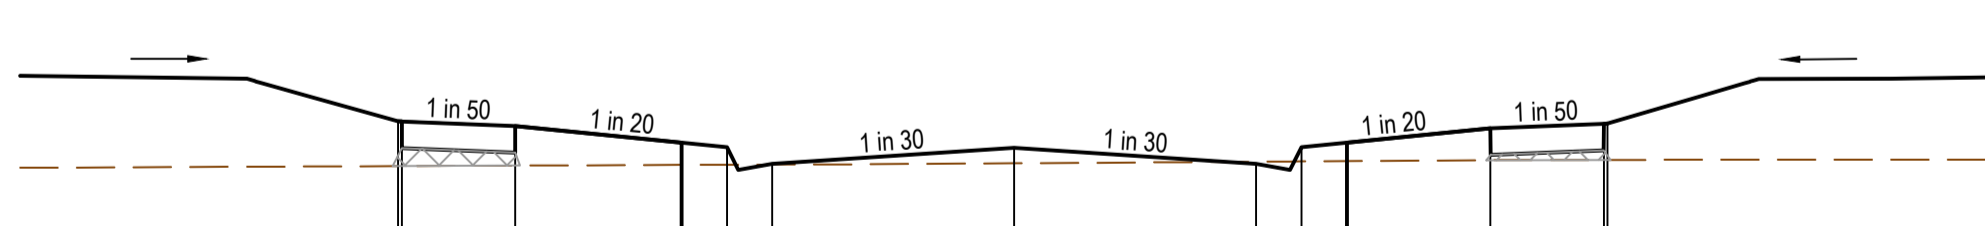


DATUM48.0										
DESIGN SURFACE	50.04	50.04	50.01	49.87	49.76	49.87	49.76	50.00	50.03	50.03
EXISTING SURFACE	49.75	49.75	49.75	49.76	49.76	49.77	49.78	49.78	49.79	49.79
OFFSET	-8.15	-8.10	-6.60	-3.80	-3.20	0.00	3.20	3.80	6.30	7.85

TPCH 11.80

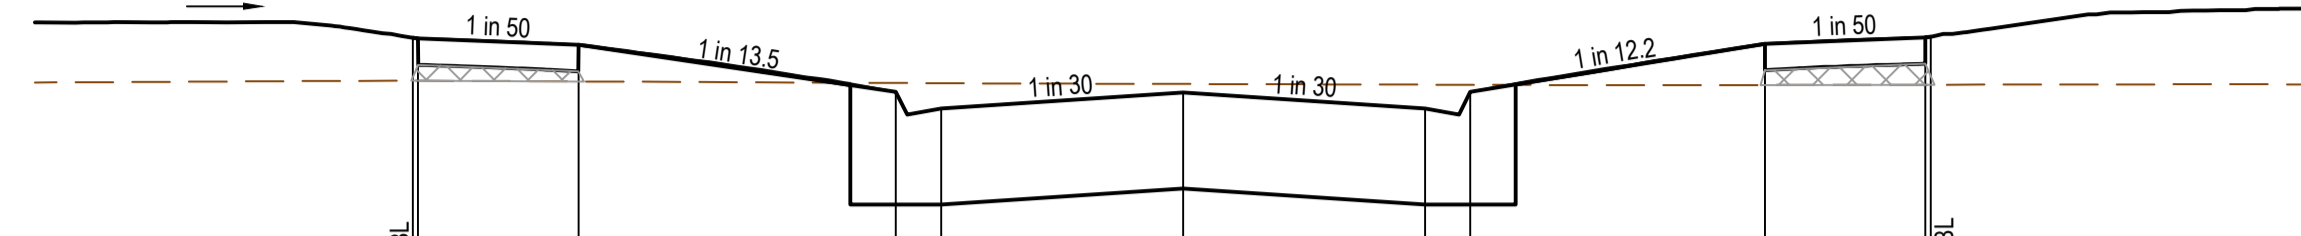


DATUM49.0										
DESIGN SURFACE	50.70	50.70	50.66	50.35	50.24	50.34	50.24	50.35	50.67	50.71
EXISTING SURFACE	50.42	50.42	50.42	50.41	50.40	50.40	50.39	50.39	50.39	50.39
OFFSET	-10.19	-10.12	-8.00	-3.80	-3.20	0.00	3.20	3.80	7.70	9.82

TPCH 197.85

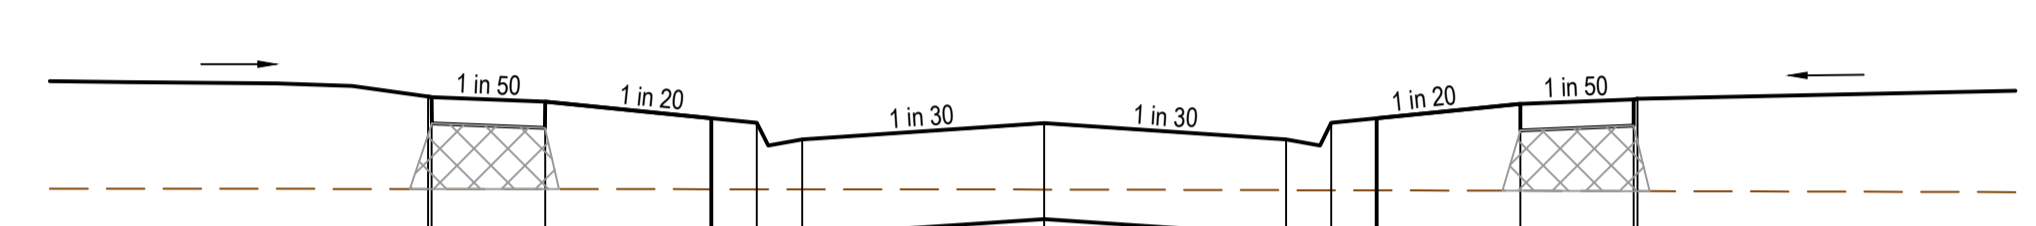


DATUM49.0										
DESIGN SURFACE	50.93	50.93	50.90	50.76	50.65	50.75	50.65	50.76	50.88	50.91
EXISTING SURFACE	50.32	50.32	50.32	50.32	50.32	50.31	50.31	50.31	50.31	50.31
OFFSET	-8.15	-8.10	-6.60	-3.80	-3.20	0.00	3.20	3.80	6.30	7.85

CH 173.81

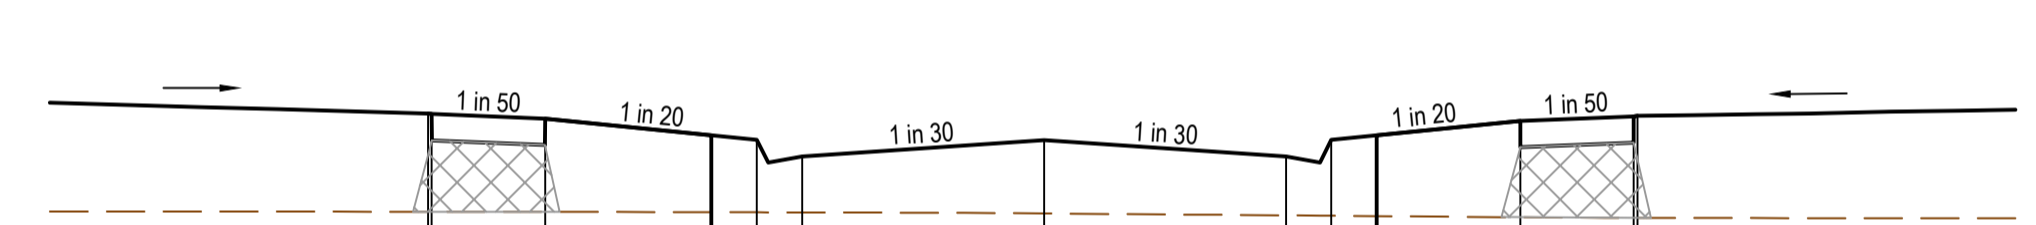

DATUM49.0										
DESIGN SURFACE	50.90	50.90	50.87	50.73	50.62	50.72	50.62	50.73	50.85	50.88
EXISTING SURFACE	50.25	50.25	50.25	50.25	50.25	50.24	50.23	50.23	50.21	50.21
OFFSET	-8.15	-8.10	-6.60	-3.80	-3.20	0.00	3.20	3.80	6.30	7.85

CH 159.81

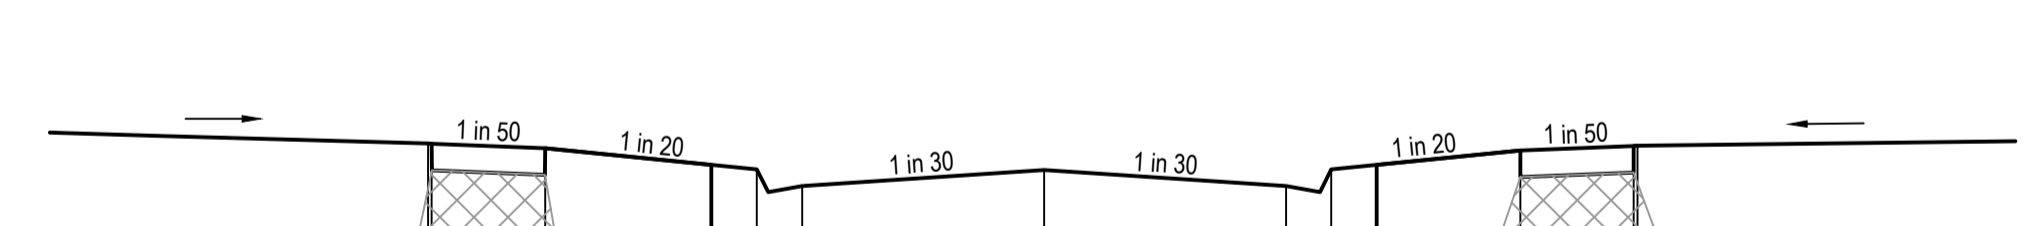

DATUM49.0										
DESIGN SURFACE	50.75	50.75	50.72	50.58	50.47	50.57	50.47	50.58	50.70	50.73
EXISTING SURFACE	50.16	50.16	50.16	50.17	50.17	50.18	50.18	50.18	50.18	50.18
OFFSET	-8.15	-8.10	-6.60	-3.80	-3.20	0.00	3.20	3.80	6.30	7.85

CH 134.81



**AS CONSTRUCTED PLANS**

The purpose of these as-constructed plans is to update the design drawings to show significant changes which occurred during construction. Note that the levels shown on these plans are design levels, and have not been verified by survey. All information shown on these plans should be verified on site. SMEC Australia Pty Ltd accept no responsibility for loss or damages resulting from the inappropriate usage of these plans.



**AS CONSTRUCTED**



PLAN OF SUB. NO.  
PS900882T  
PERMIT REF. NO.  
WYP10365/17.01

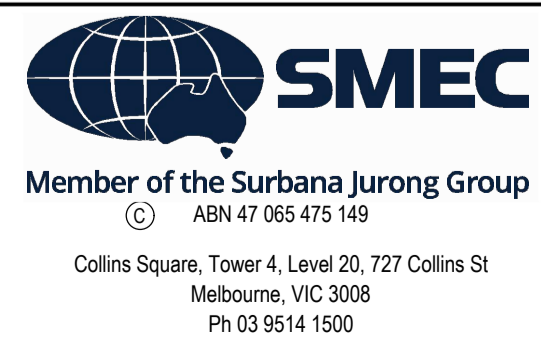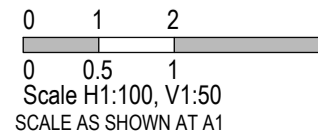


Marigold - Stage 7  
Wyndham City Council  
Road and Drainage  
Cross Sections: Flock Street  
Ch 11.80 - Ch 197.85

MELWAYS REF: 359 F9  
PROJECT / DRAWING No: 2360E-007-251  
SHEET No: 13 of 28  
REVISION: 1


STRUCTURAL FILL REQUIRED UNDER PAVEMENT AND FOOTPATHS WHERE CONSTRUCTED ABOVE EXISTING SURFACE

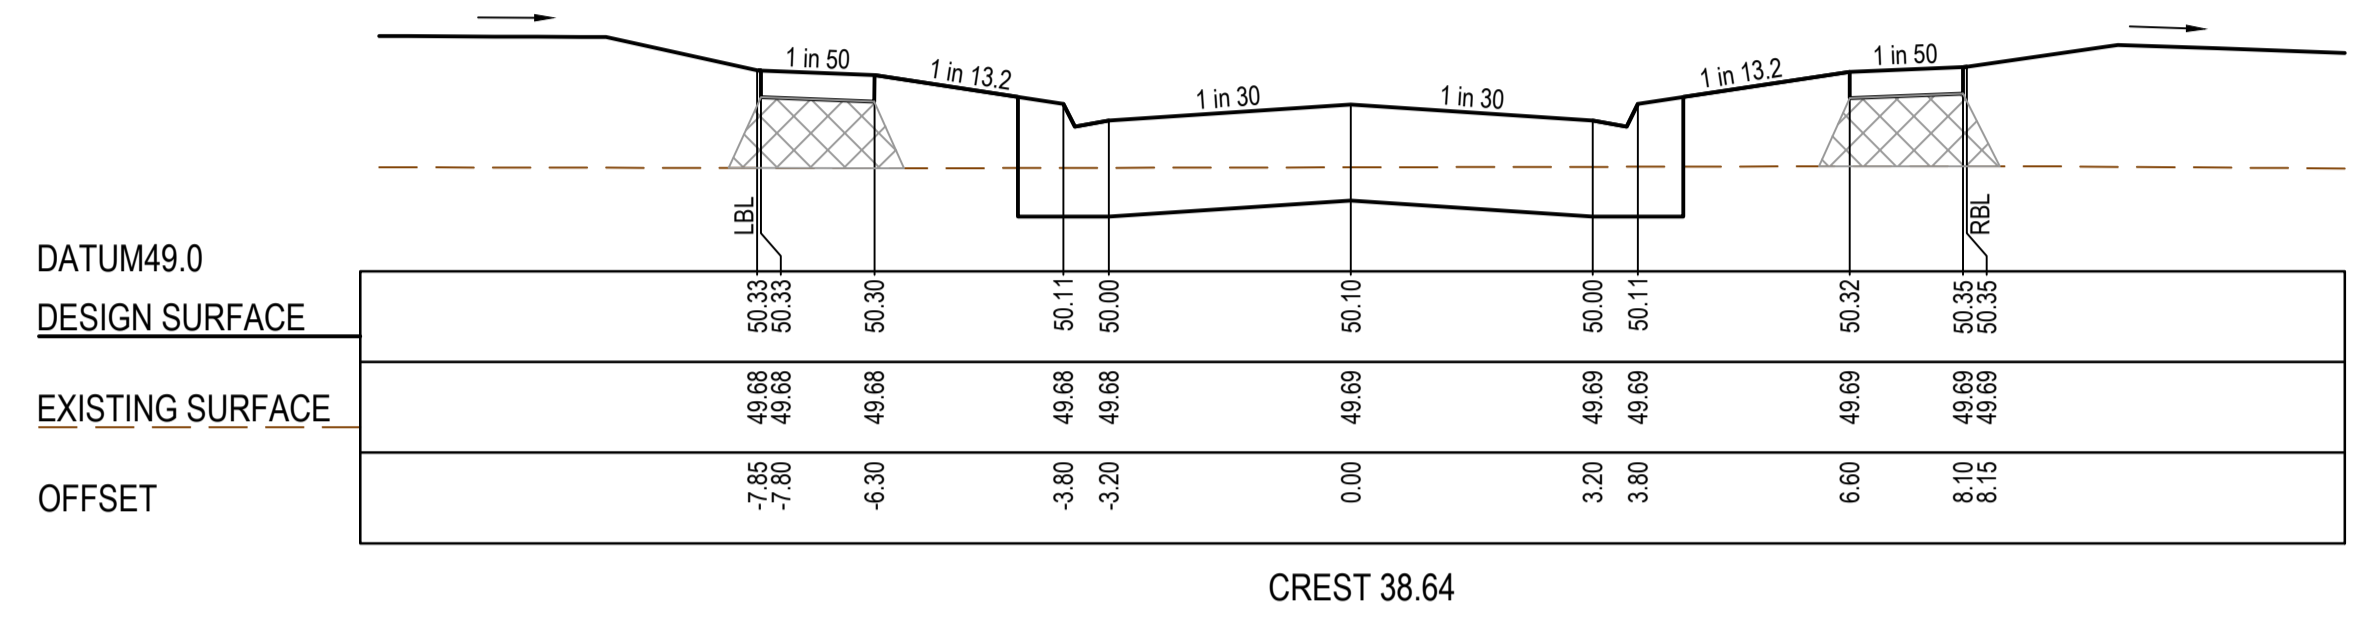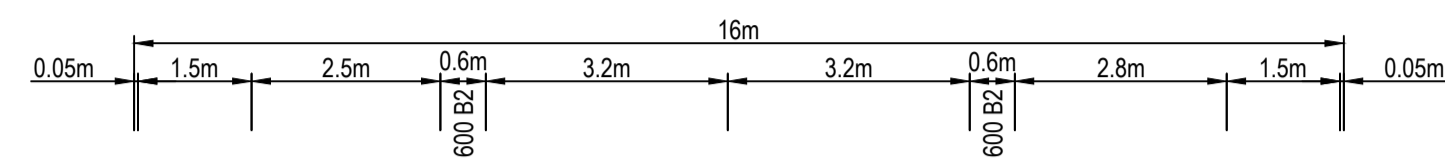


CREST 38.64

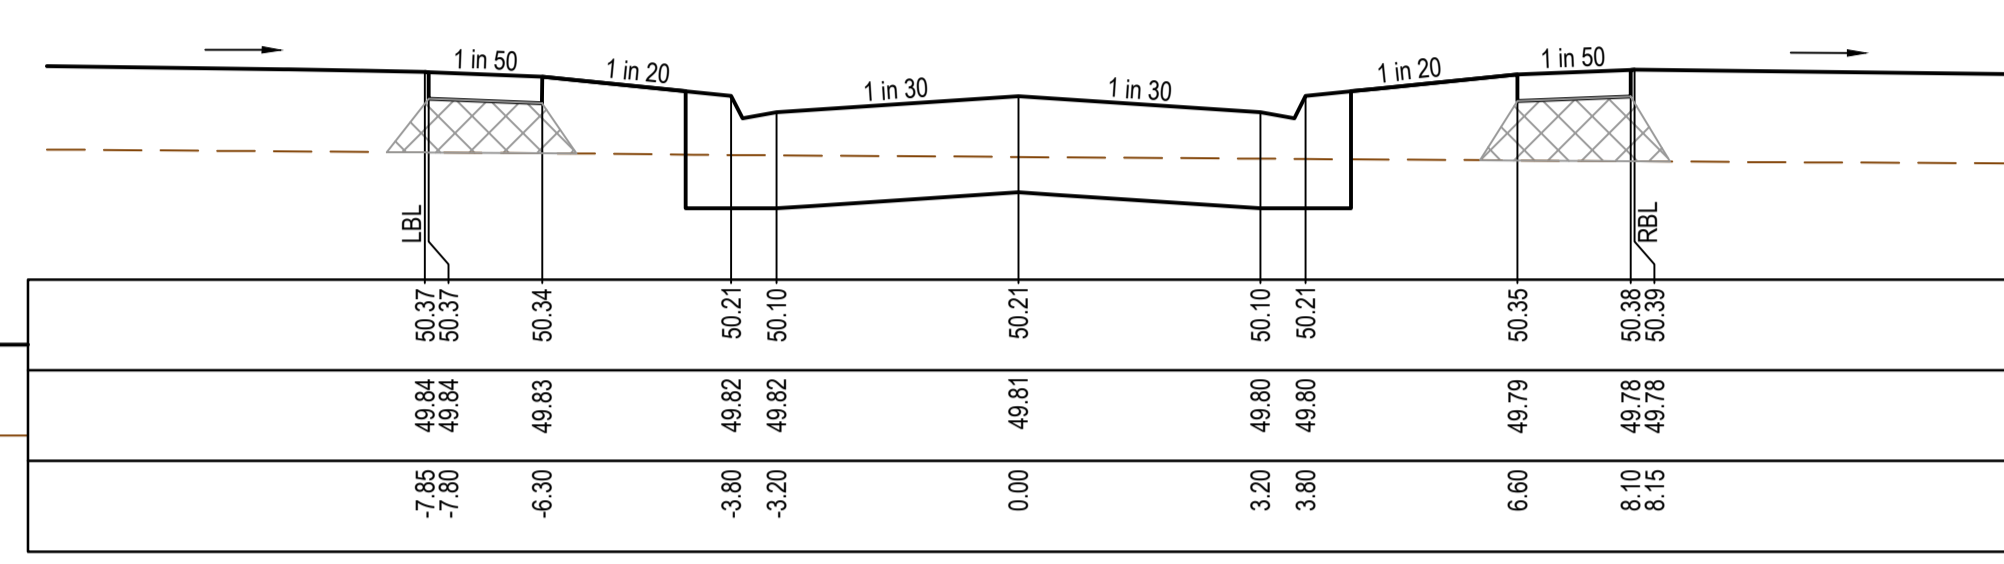


CH 112.15

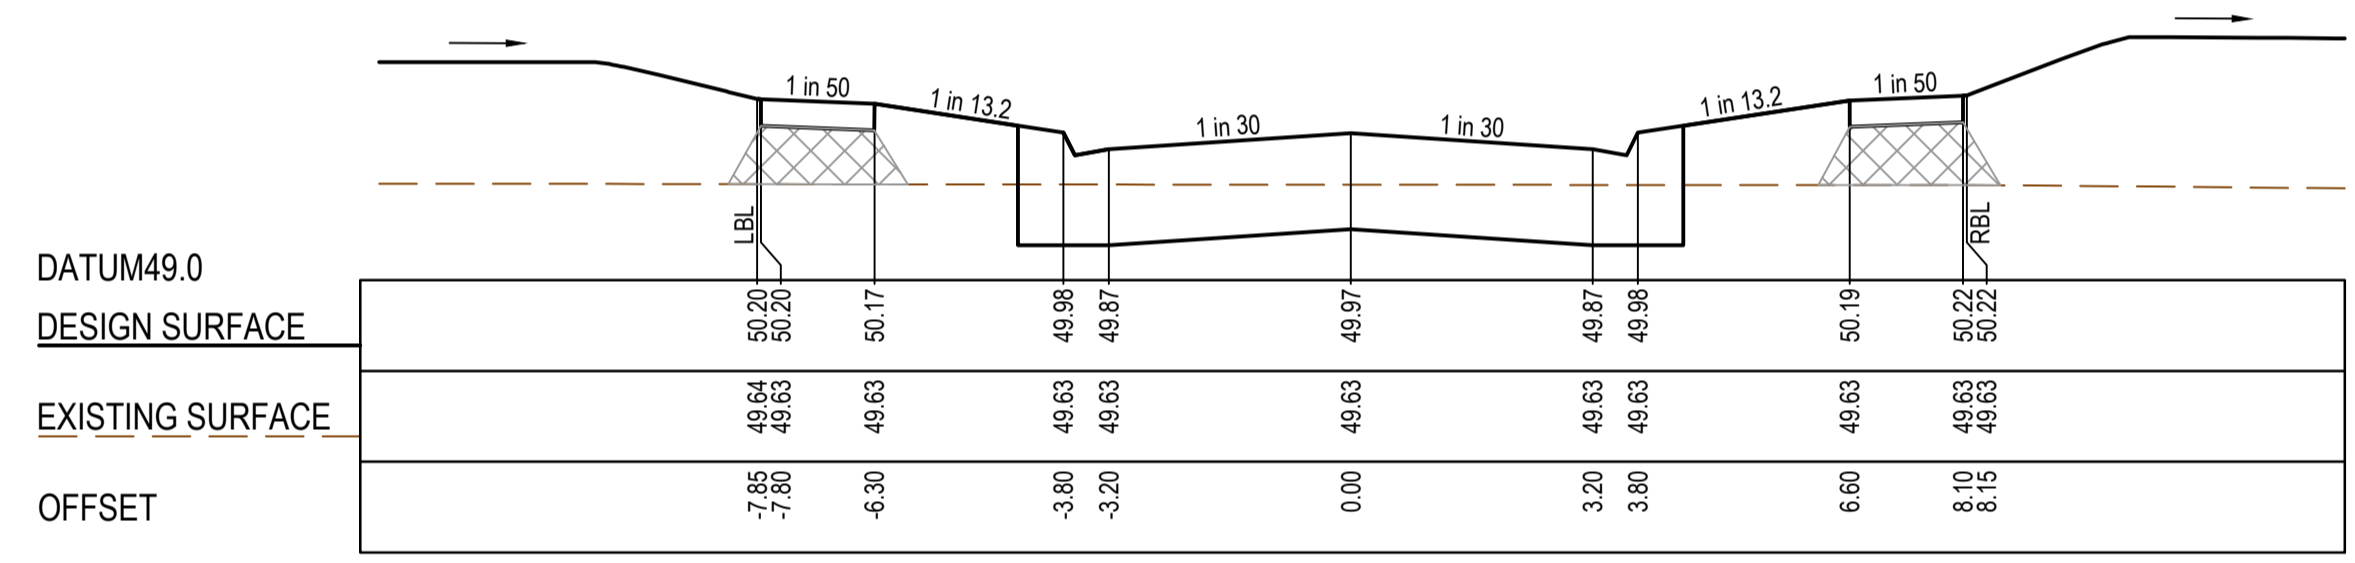


SAG 11.83

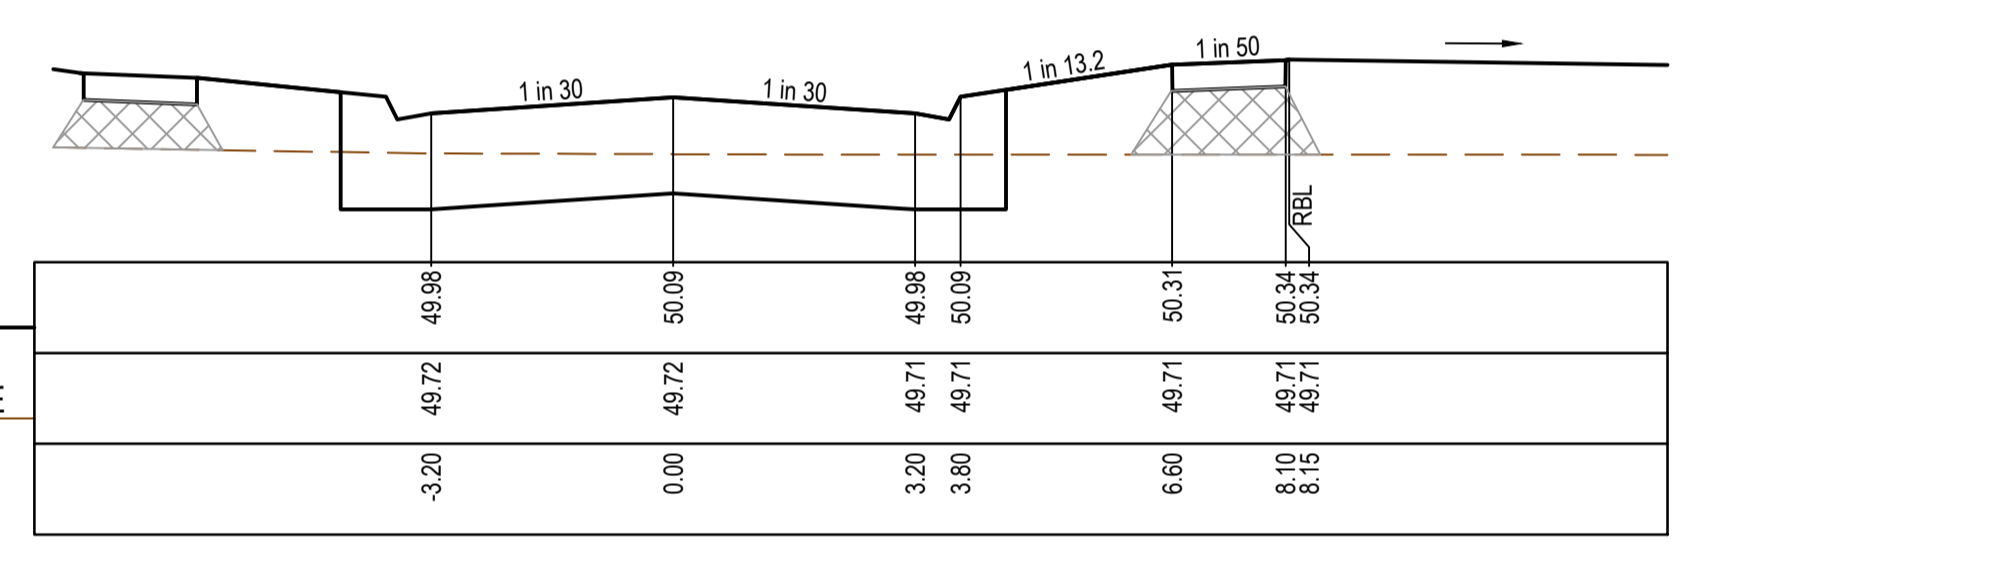

LTPCH 88.09

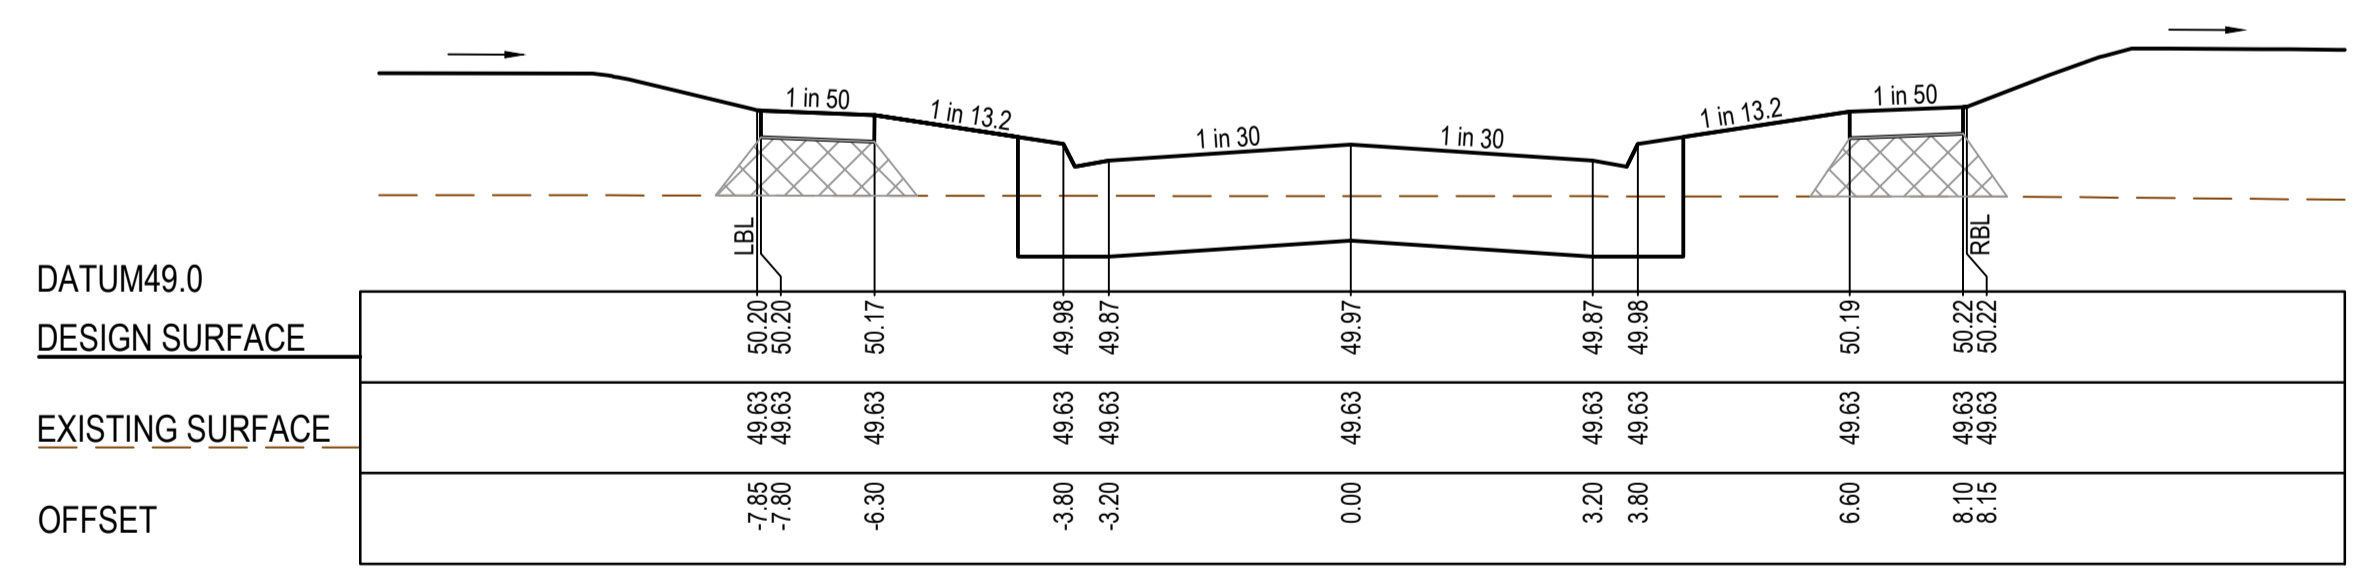

TPCH 11.80

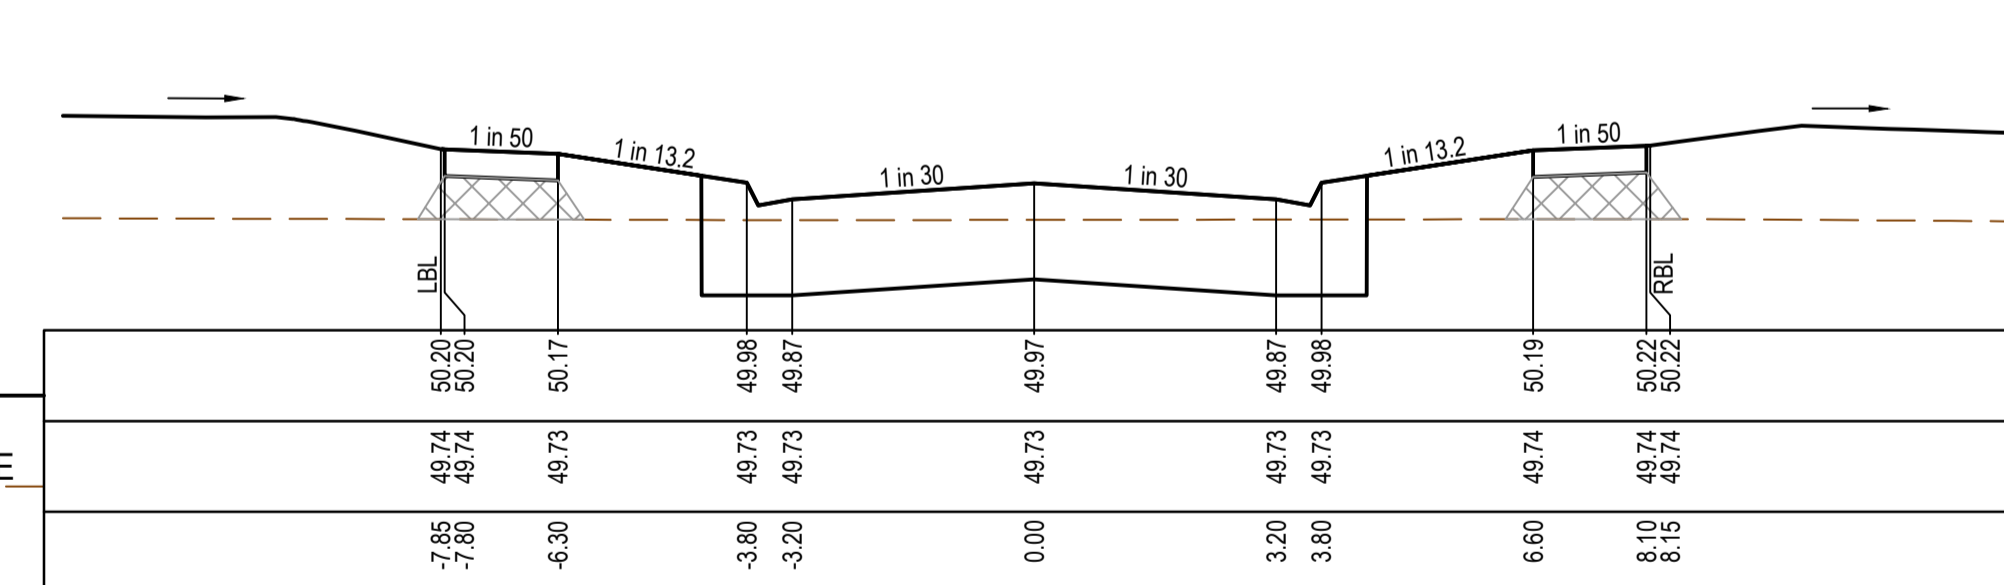

LTPCH 64.50

**AS CONSTRUCTED PLANS**

The purpose of these as-constructed plans is to update the design drawings to show significant changes which occurred during construction. Note that the levels shown on these plans are design levels, and have not been verified by survey. All information shown on these plans should be verified on site. SMEC Australia Pty Ltd accept no responsibility for loss or damages resulting from the inappropriate usage of these plans.

Global-Mark.com.au®

**AS CONSTRUCTED**

PLAN OF SUB. NO.  
PS900882T  
PERMIT REF. NO.  
WYP10365/17.01



0 1 2 4  
0 0.5 1 2  
Scale H1:100, V1:50  
SCALE AS SHOWN AT A1

Member of the Surlana Jurong Group  
ABN 47 065 475 149  
Collins Square, Tower 4, Level 20, 727 Collins St  
Melbourne, VIC 3008  
Ph 03 9514 1900


Marigold - Stage 7  
Wyndham City Council  
Road and Drainage  
Cross Sections: Kindness Road  
Ch 11.80 - Ch 112.15

MELWAYS REF 359 F9	PROJECT / DRAWING No. 2360E-007-252	SHEET No. 14 of 28	REVISION 1
-----------------------	--	-----------------------	---------------


STRUCTURAL FILL REQUIRED UNDER PAVEMENT AND FOOTPATHS WHERE CONSTRUCTED ABOVE EXISTING SURFACE

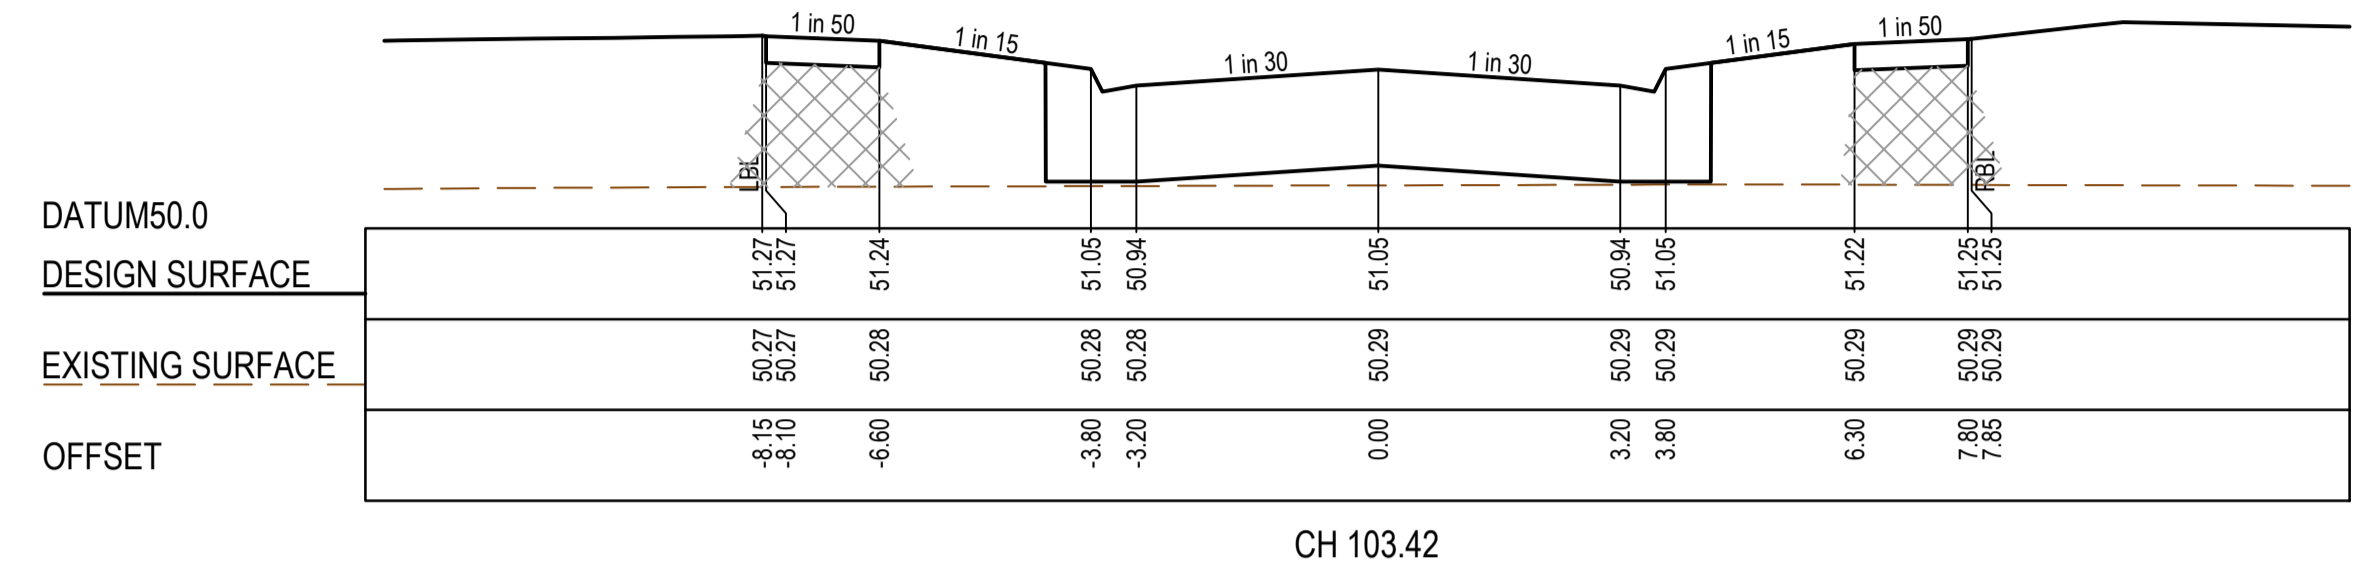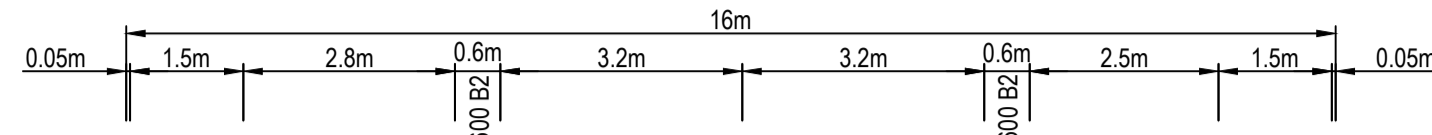


CH 103.42

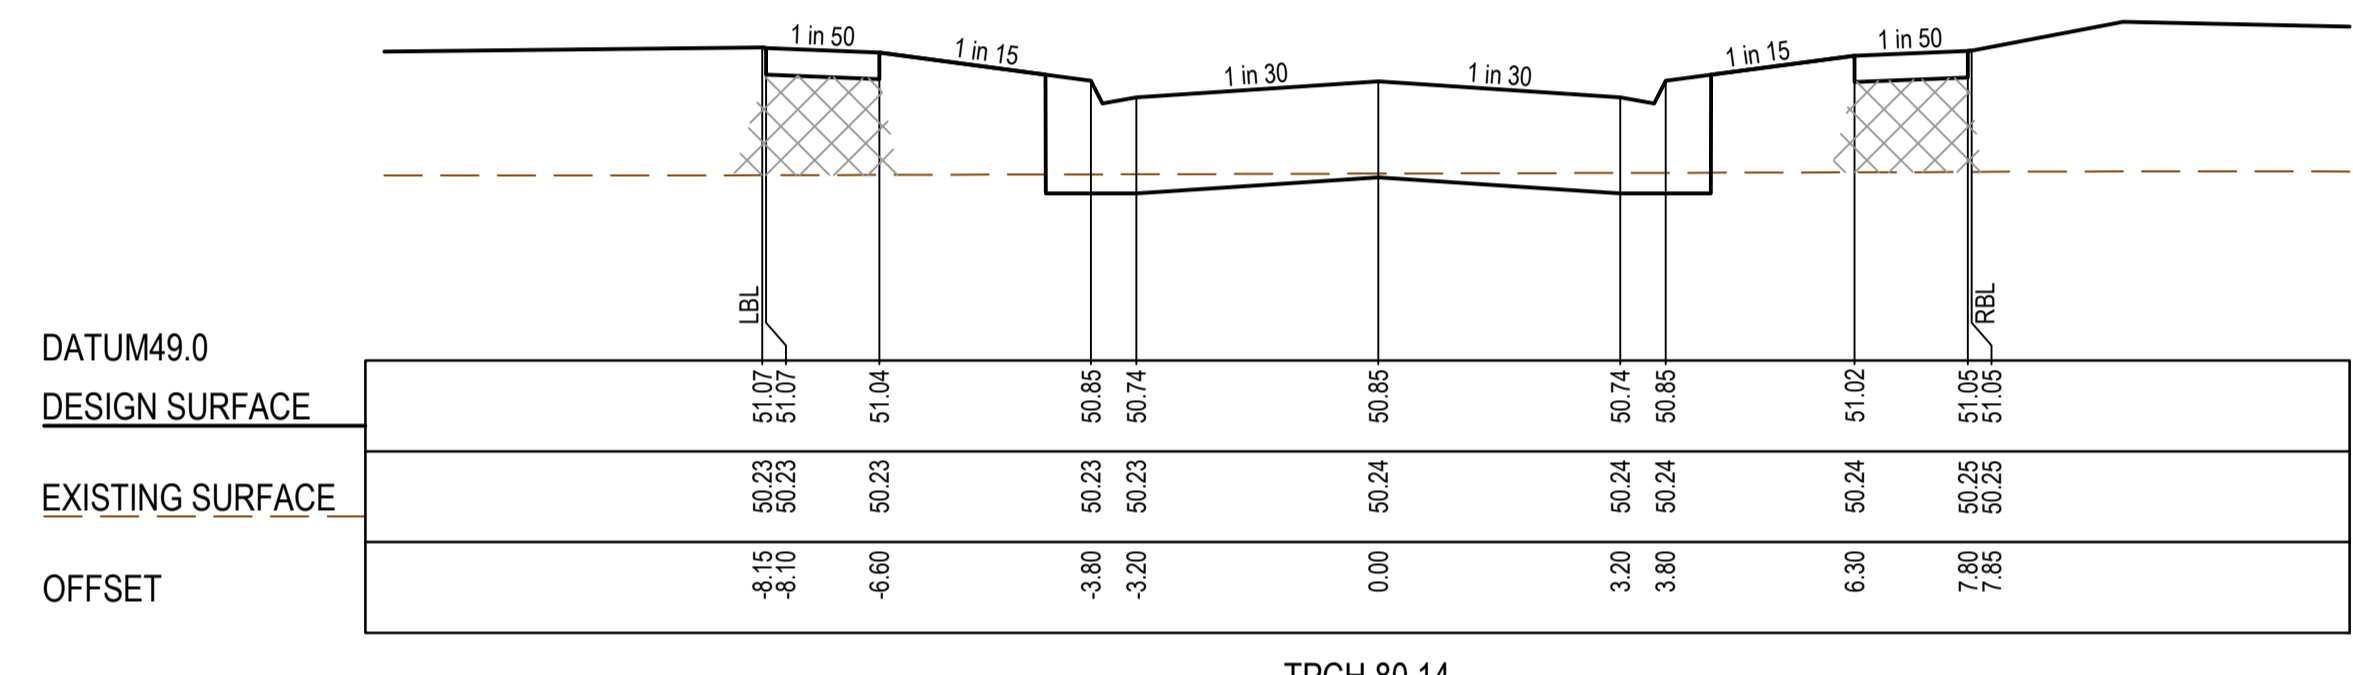


TPCH 80.14

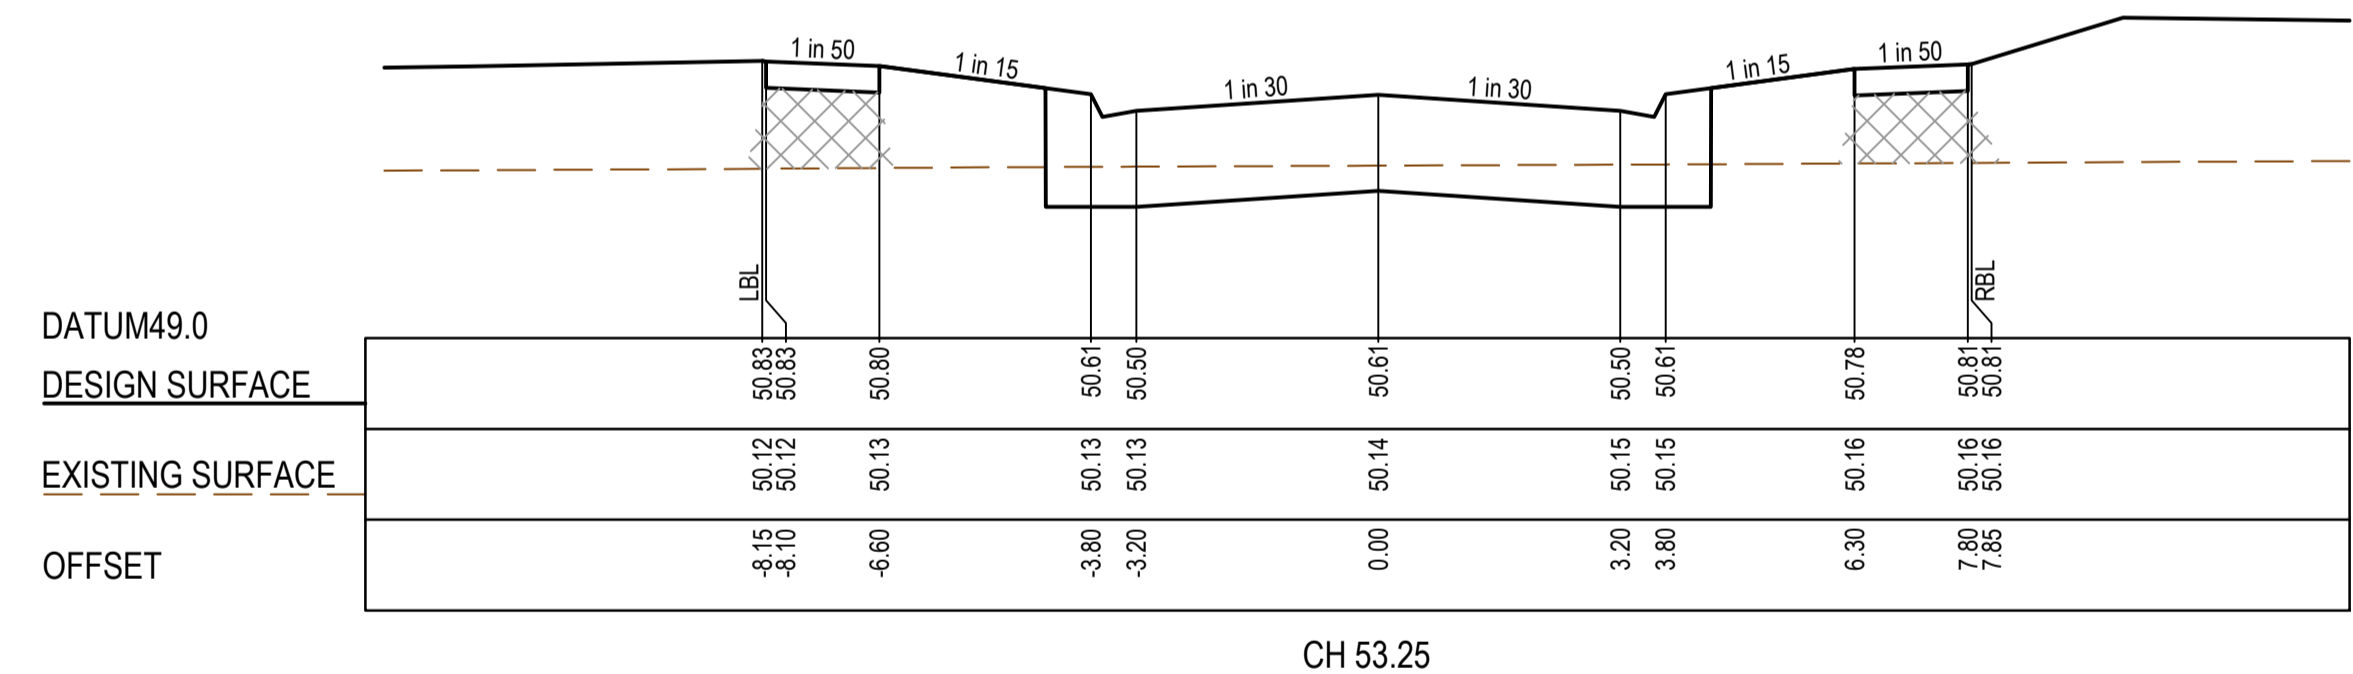


CH 53.25

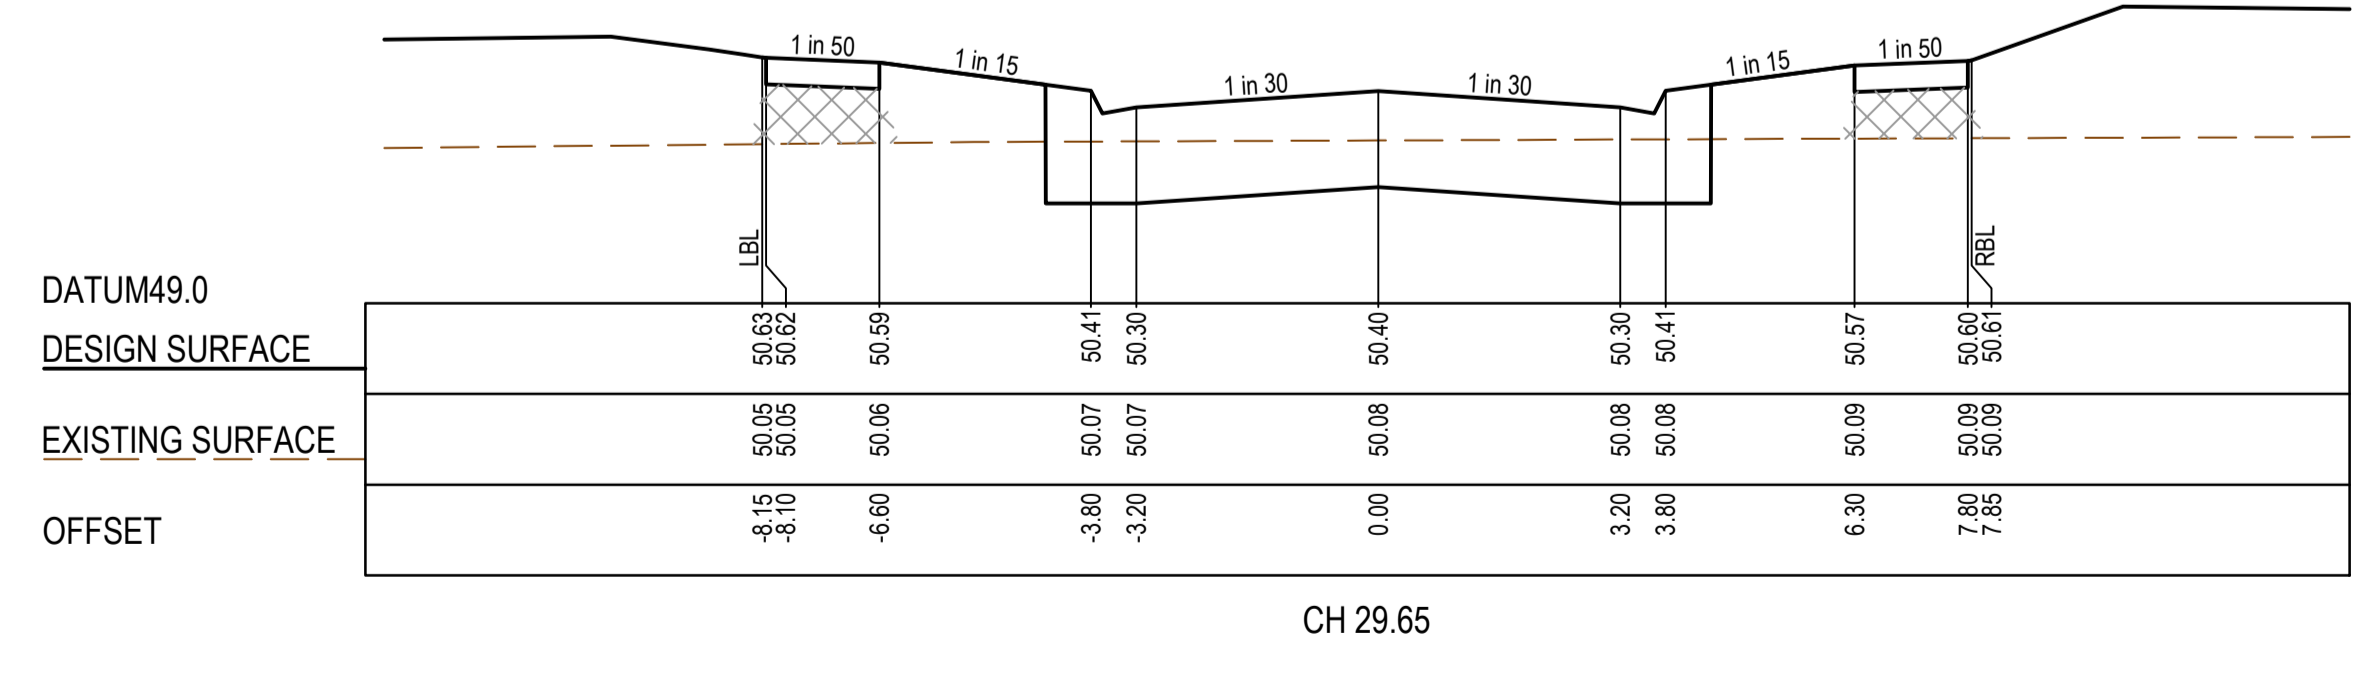


CH 29.65

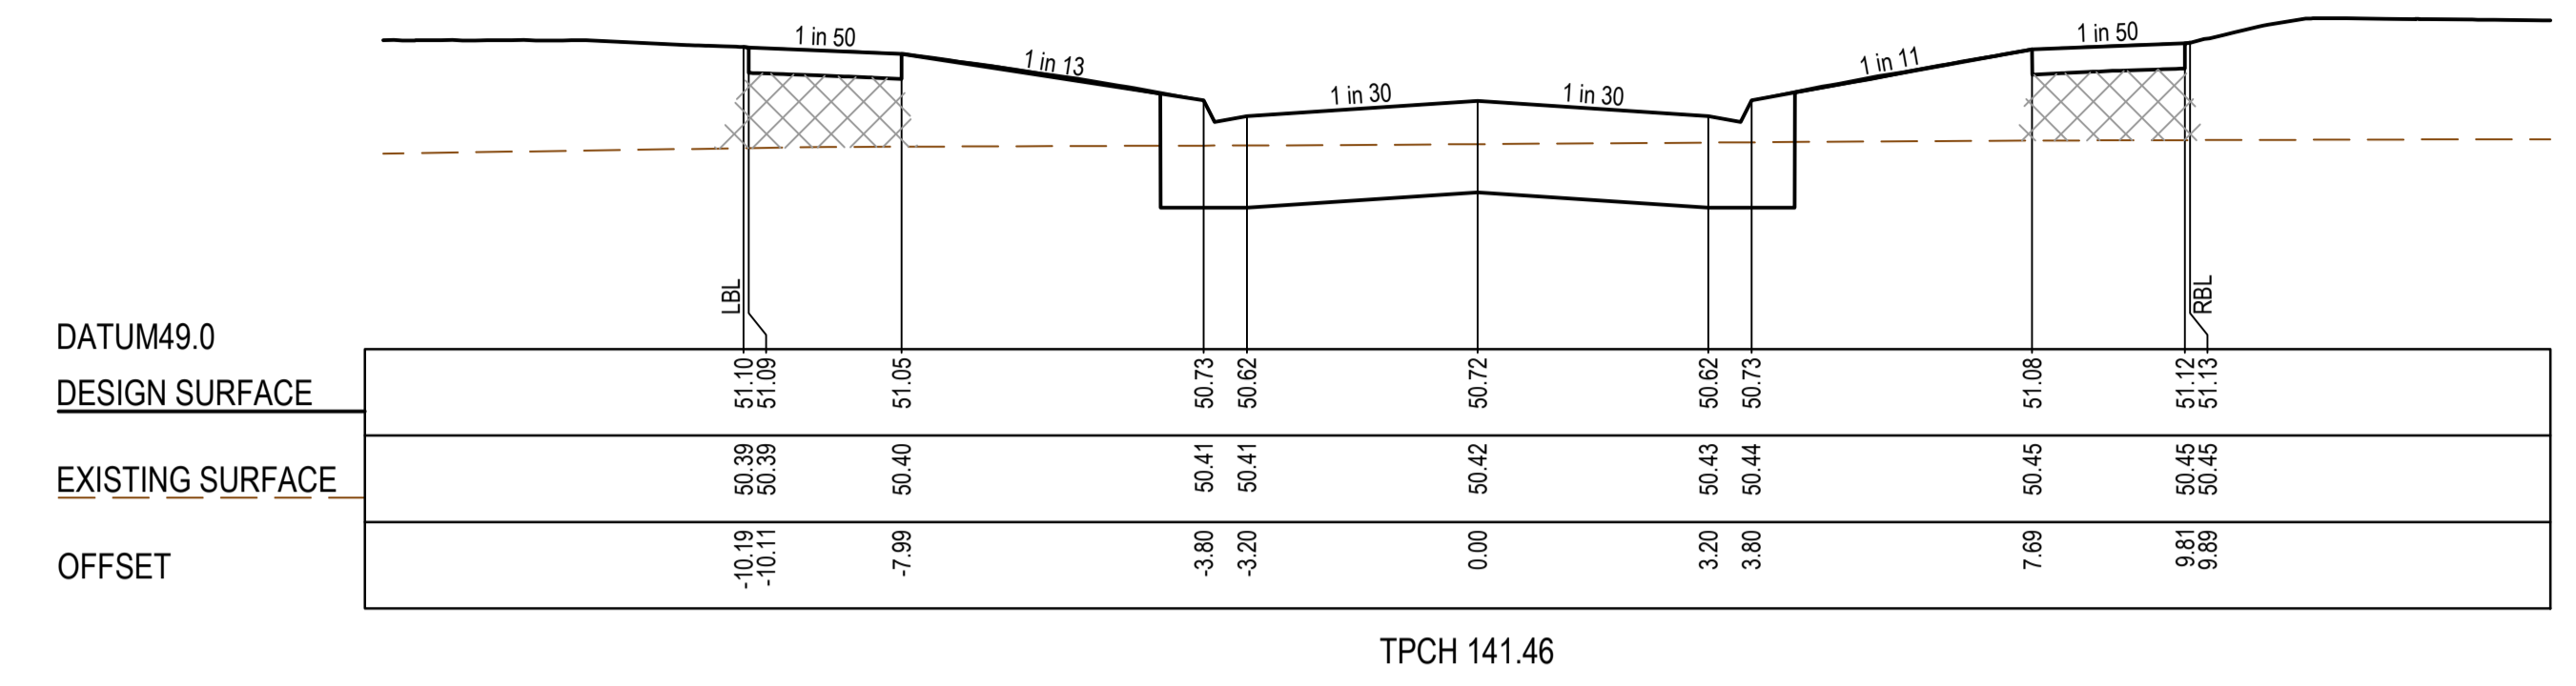


TPCH 141.46

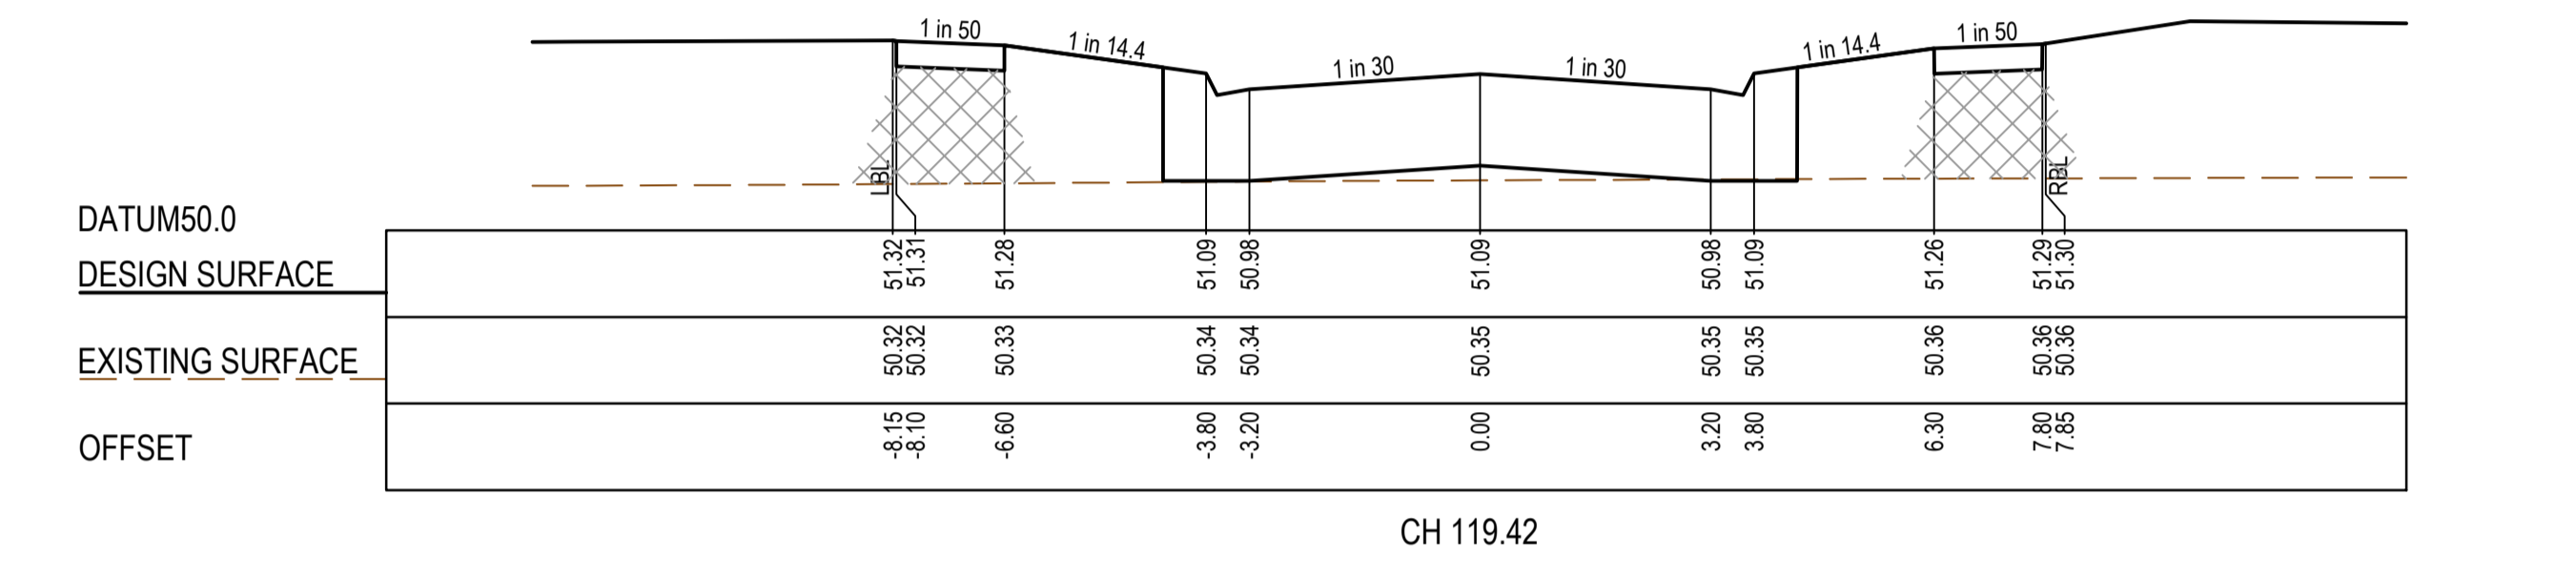

CH 119.42

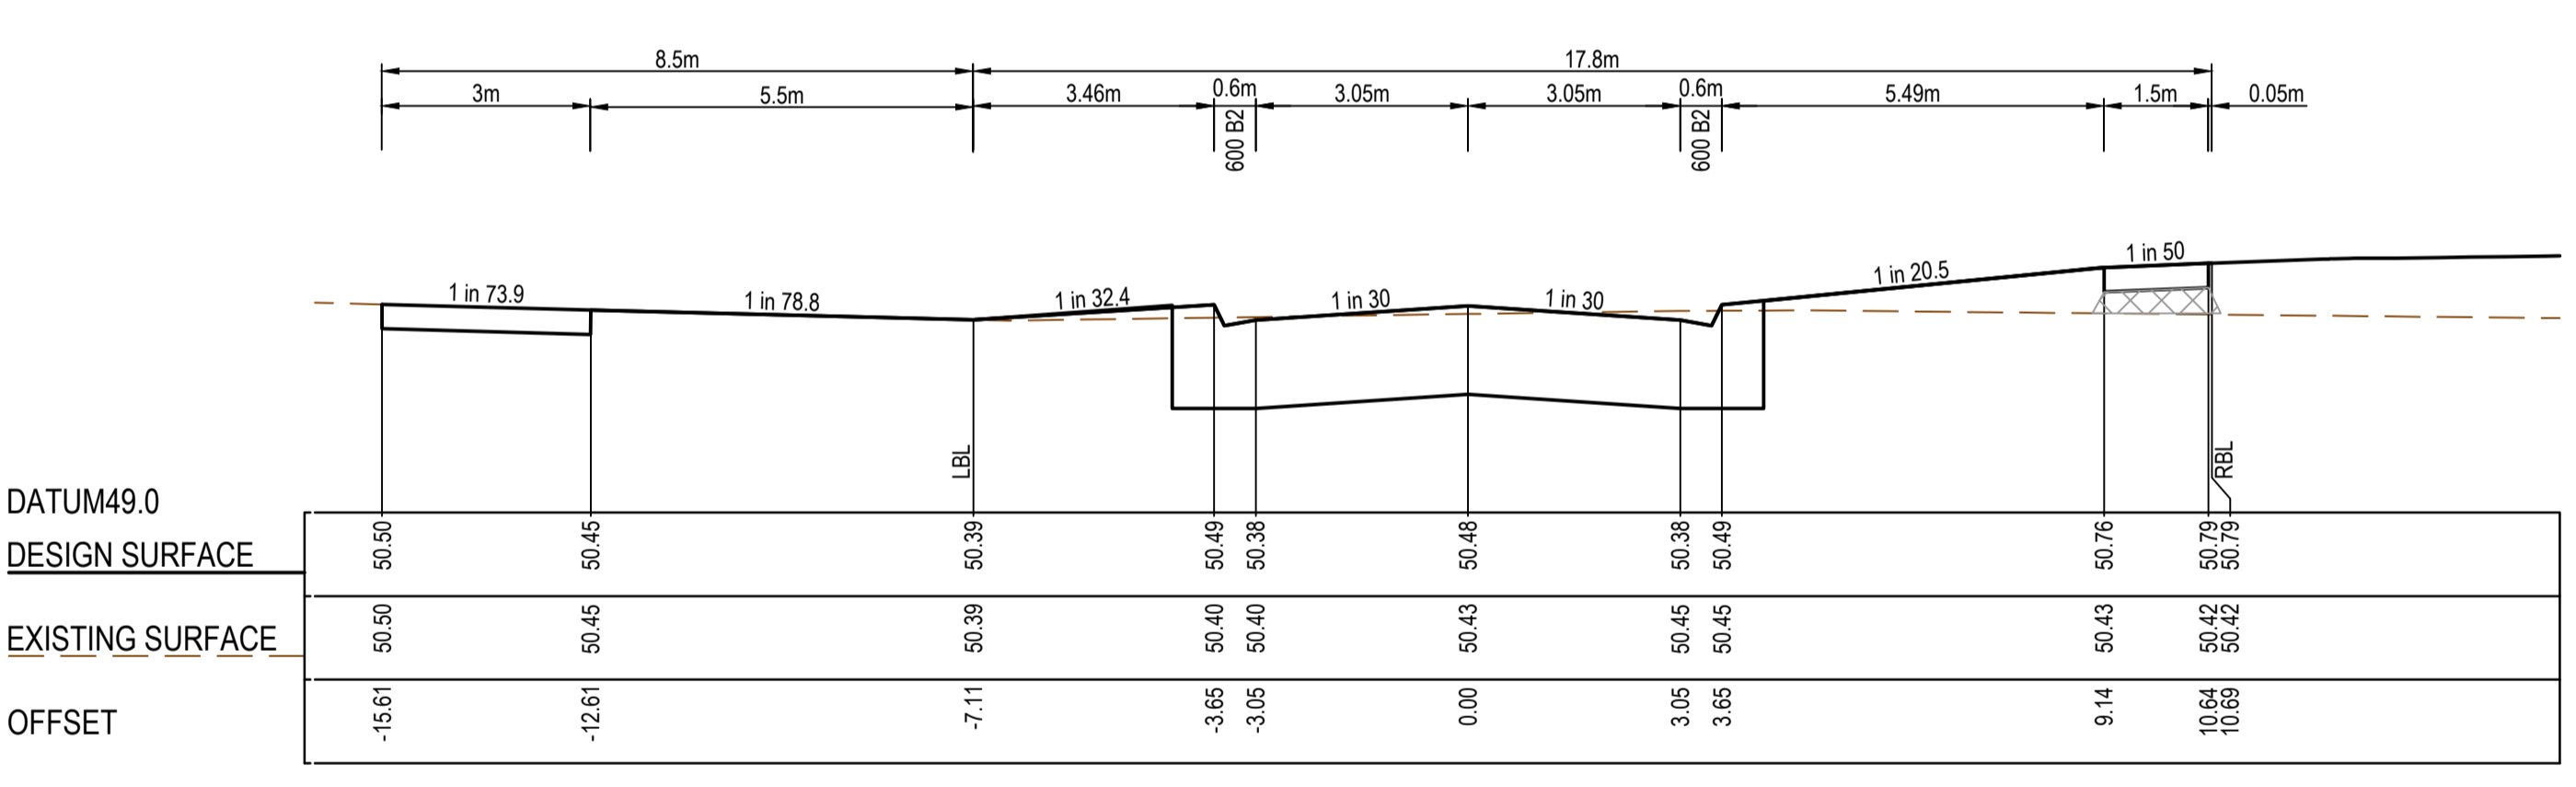

RTPCH 744.00

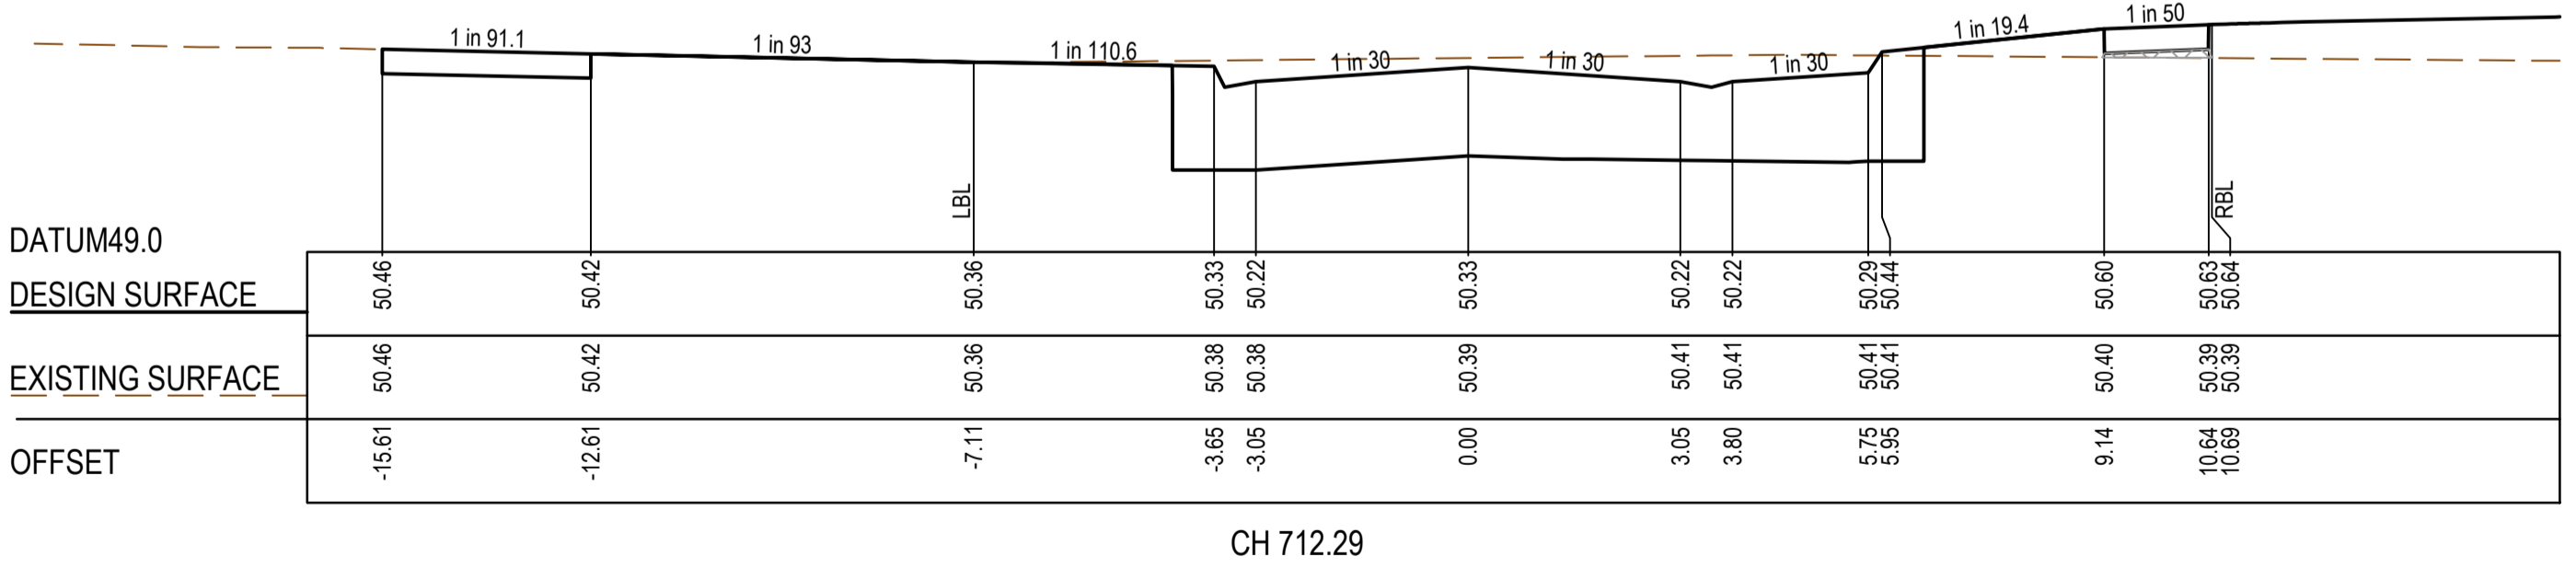

CH 712.29

ROSSO DRIVE CROSS SECTIONS

AS CONSTRUCTED PLANS

The purpose of these as-constructed plans is to update the design drawings to show significant changes which occurred during construction. Note that the levels shown on these plans are design levels, and have not been verified by survey. All information shown on these plans should be verified on site. SMEC Australia Pty Ltd accept no responsibility for loss or damages resulting from the inappropriate usage of these plans.

Quality Management ISO 9001  
 OHS Management AS/NZS 4801  
 Environmental Management ISO 14001  
 Global-Mark.com.au®

PLAN OF SUB. NO. PS90082T  
 PERMIT REF. NO. WYP10365/17.01

**AS CONSTRUCTED**

Scale H1:100, V1:50  
 SCALE AS SHOWN AT A1


**SMEC**  
 Member of the Surlana Jurong Group  
 ABN 47 065 475 149  
 Collins Square, Tower 4, Level 20, 727 Collins St  
 Melbourne, VIC 3008  
 Ph 03 9514 1500

**GROWLAND**


Marigold - Stage 7  
 Wyndham City Council  
 Road and Drainage  
 Cross Sections: Praise Road & Rosso Drive  
 Ch 29.65 - Ch 141.46

MELWAYS REF 359 F9	PROJECT / DRAWING No. 2360E-007-253	SHEET No. 15 of 28	REVISION 1
-----------------------	--	-----------------------	---------------


STRUCTURAL FILL REQUIRED UNDER PAVEMENT AND FOOTPATHS WHERE CONSTRUCTED ABOVE EXISTING SURFACE

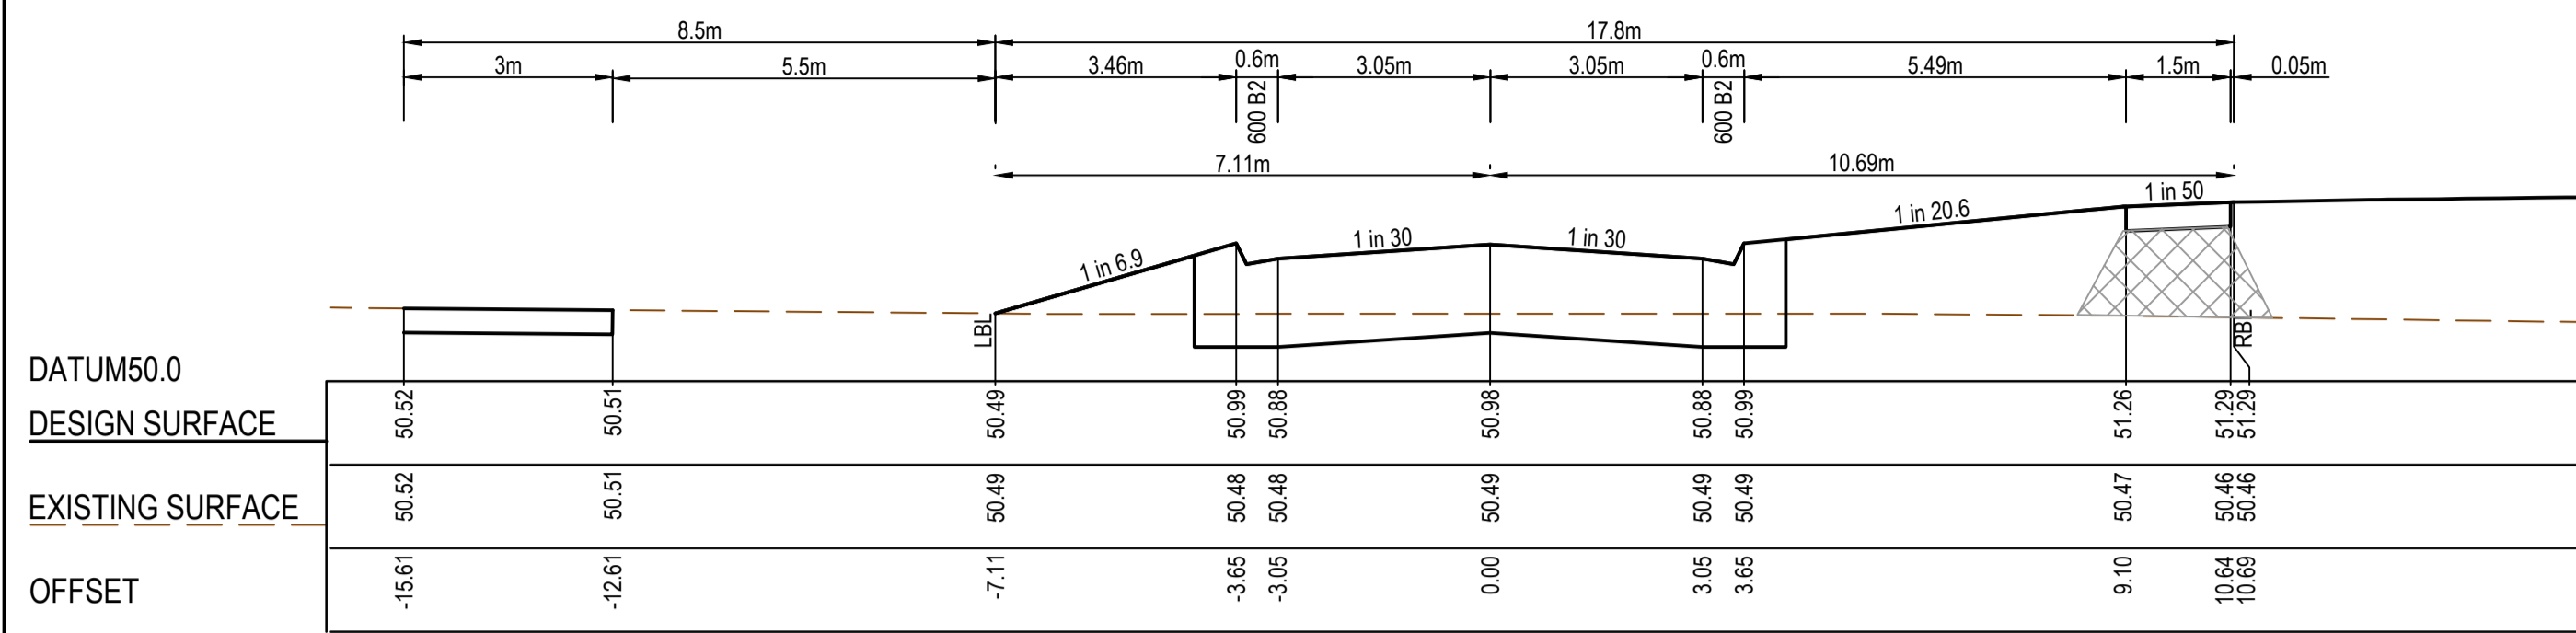


RTPCH 843.73

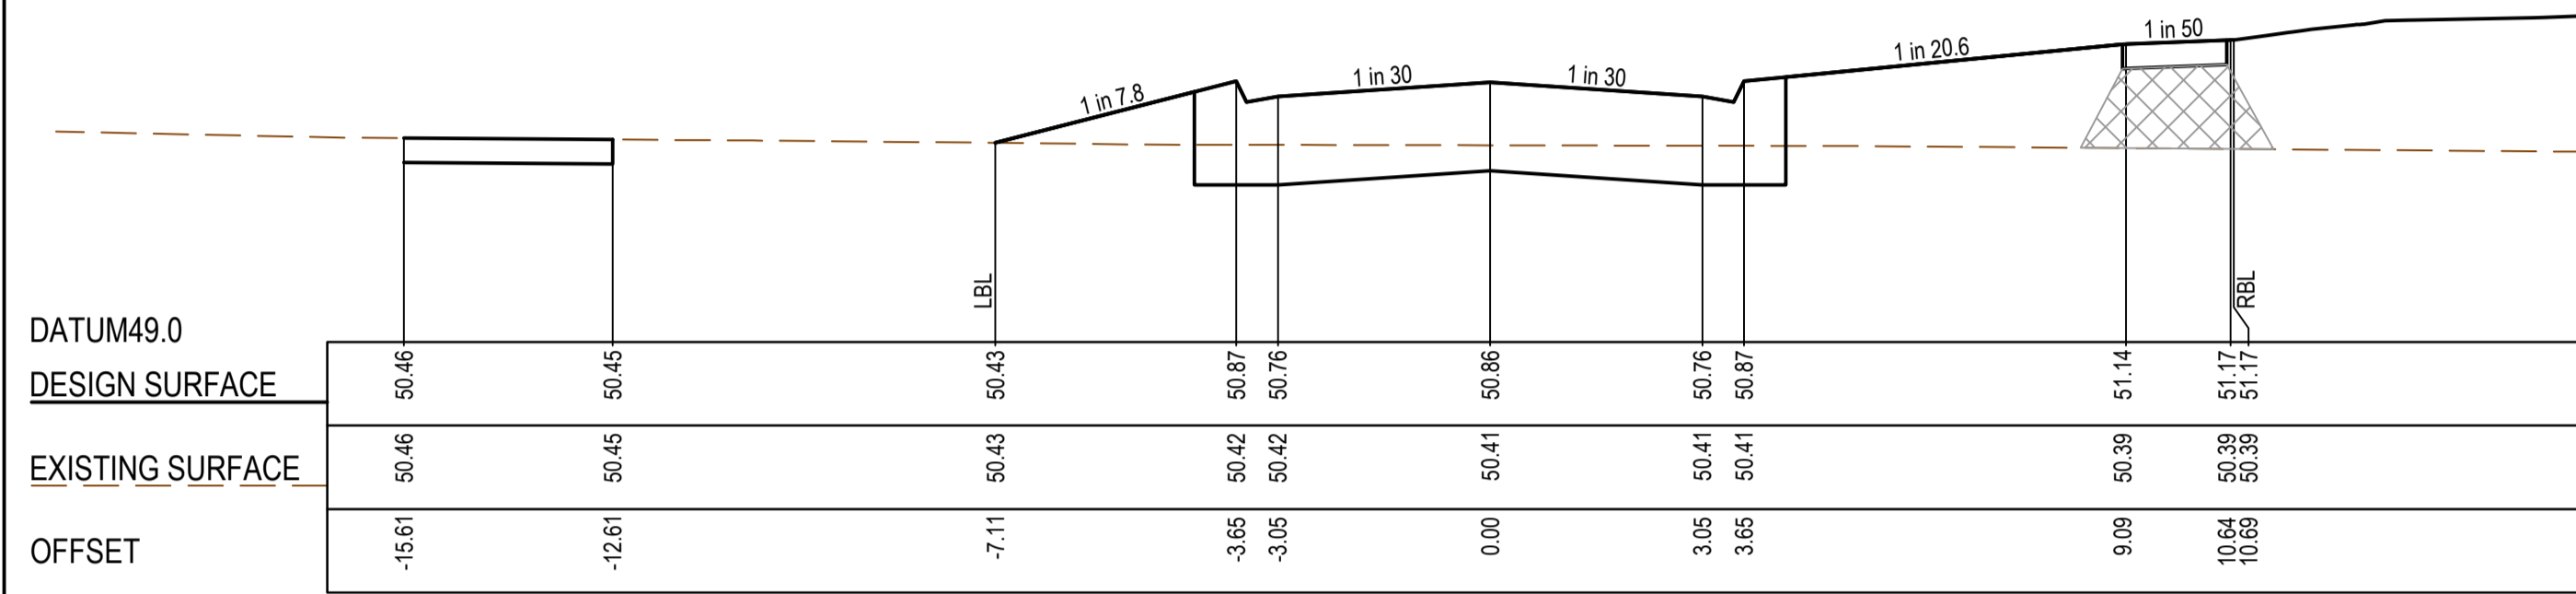


RTPCH 820.13

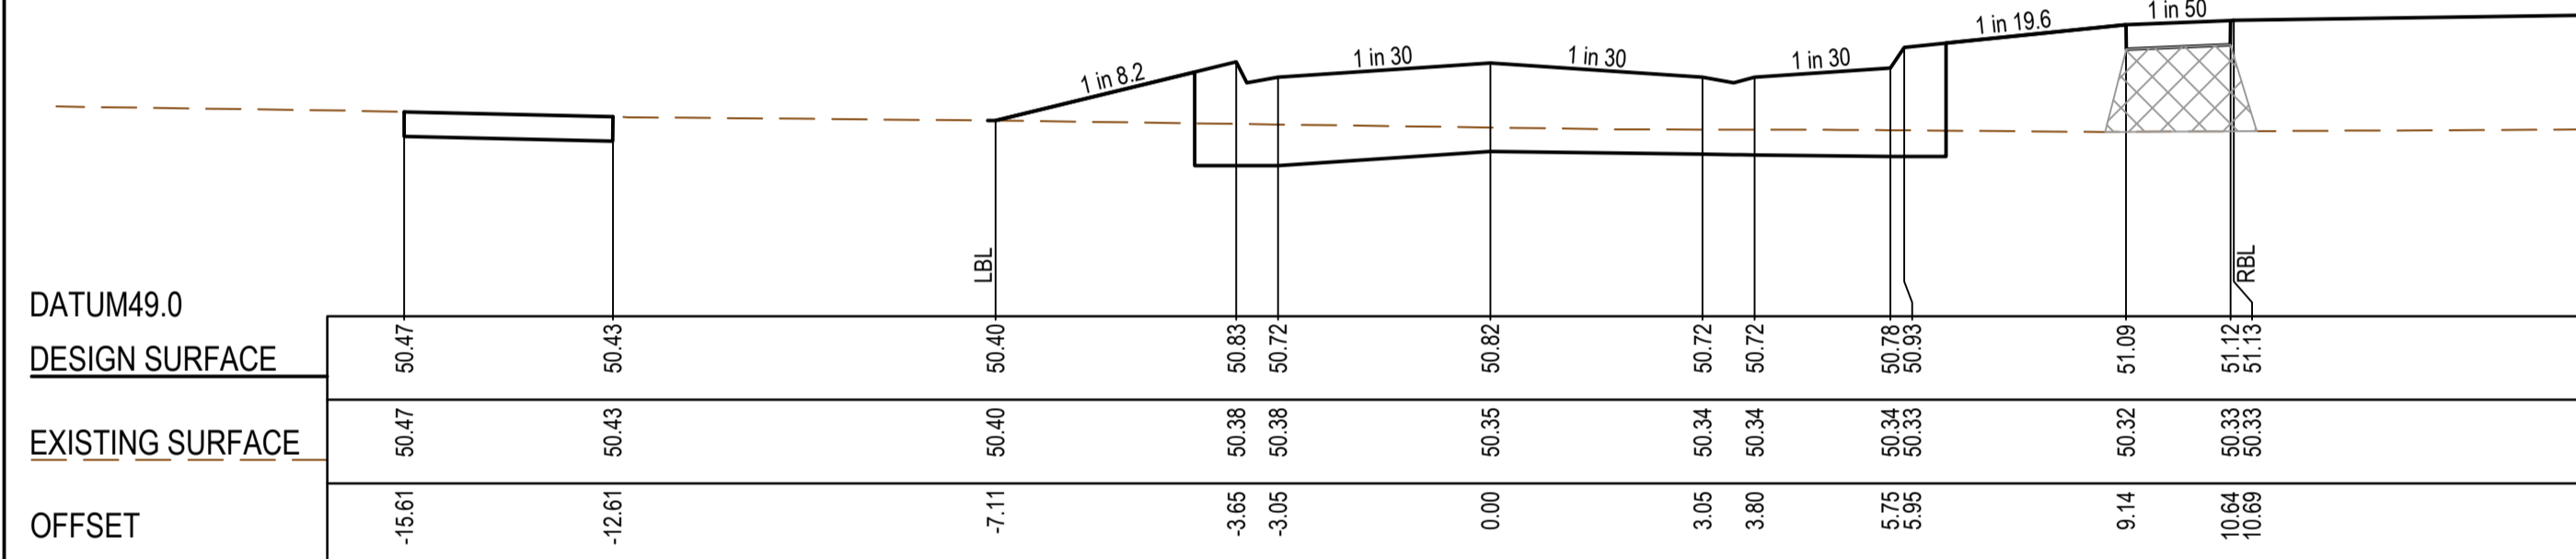


CH 810.78

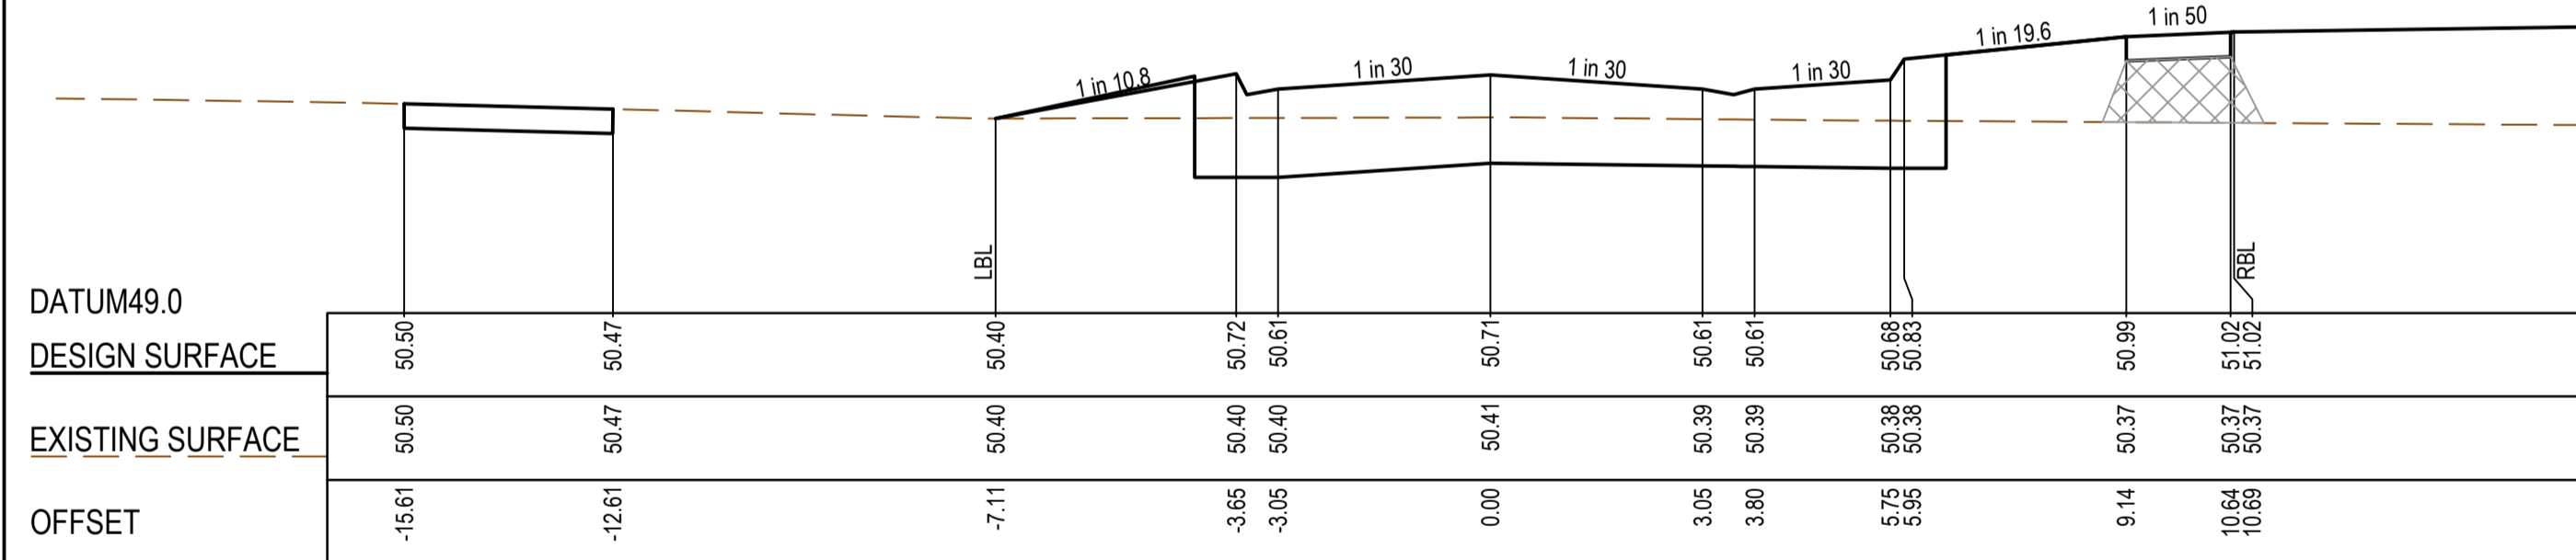


CH 789.78

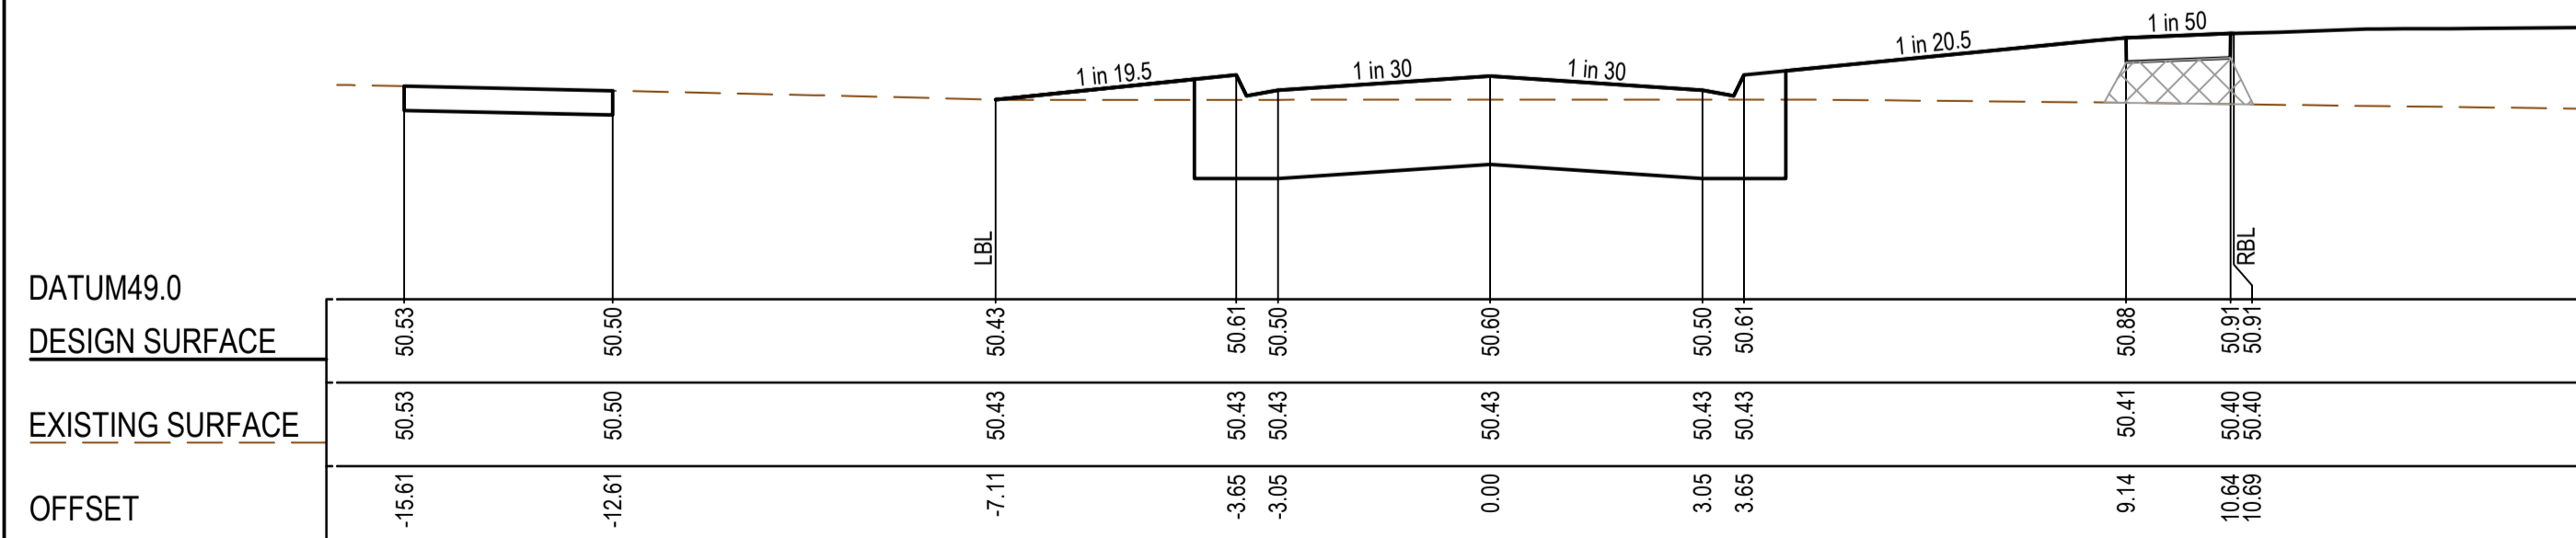


RTPCH 768.00

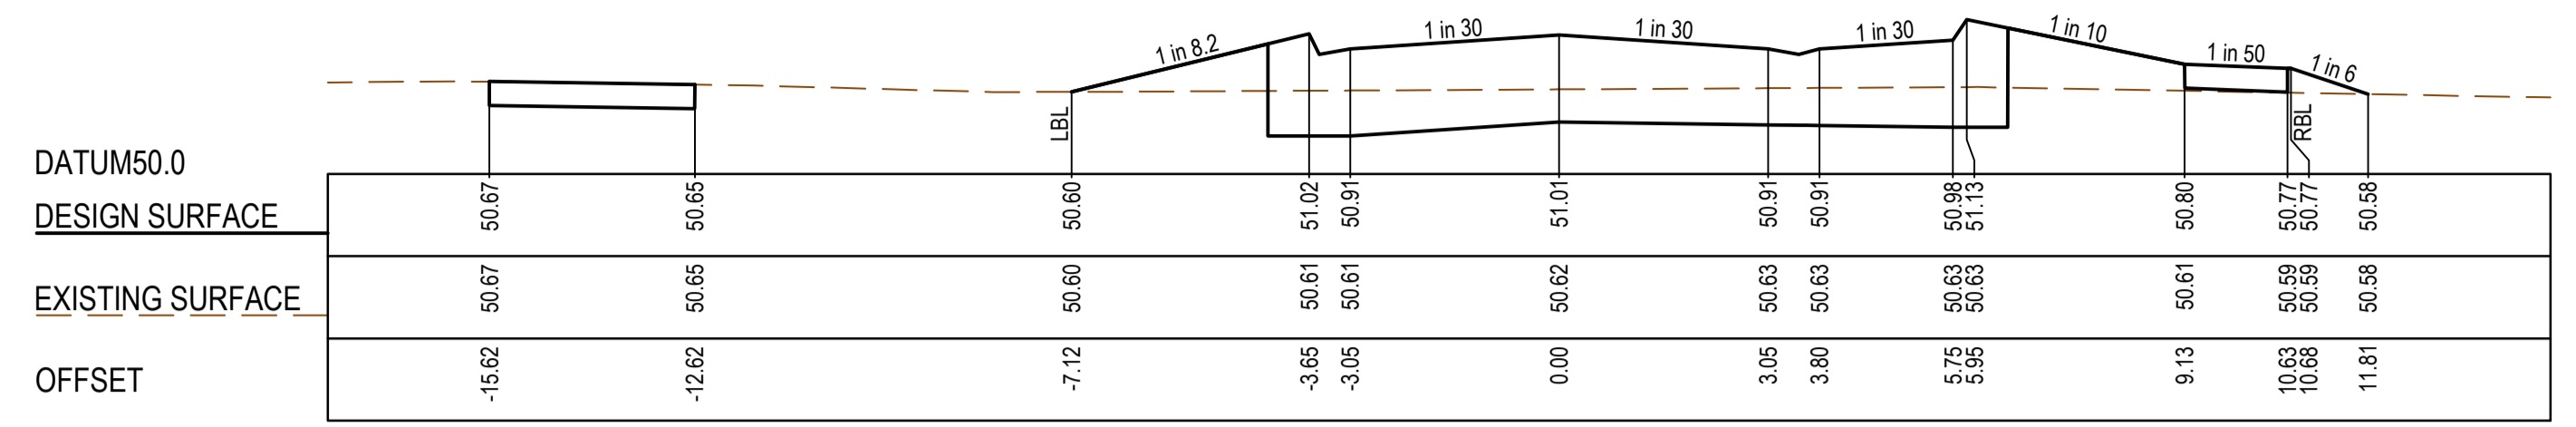


CH 940.69

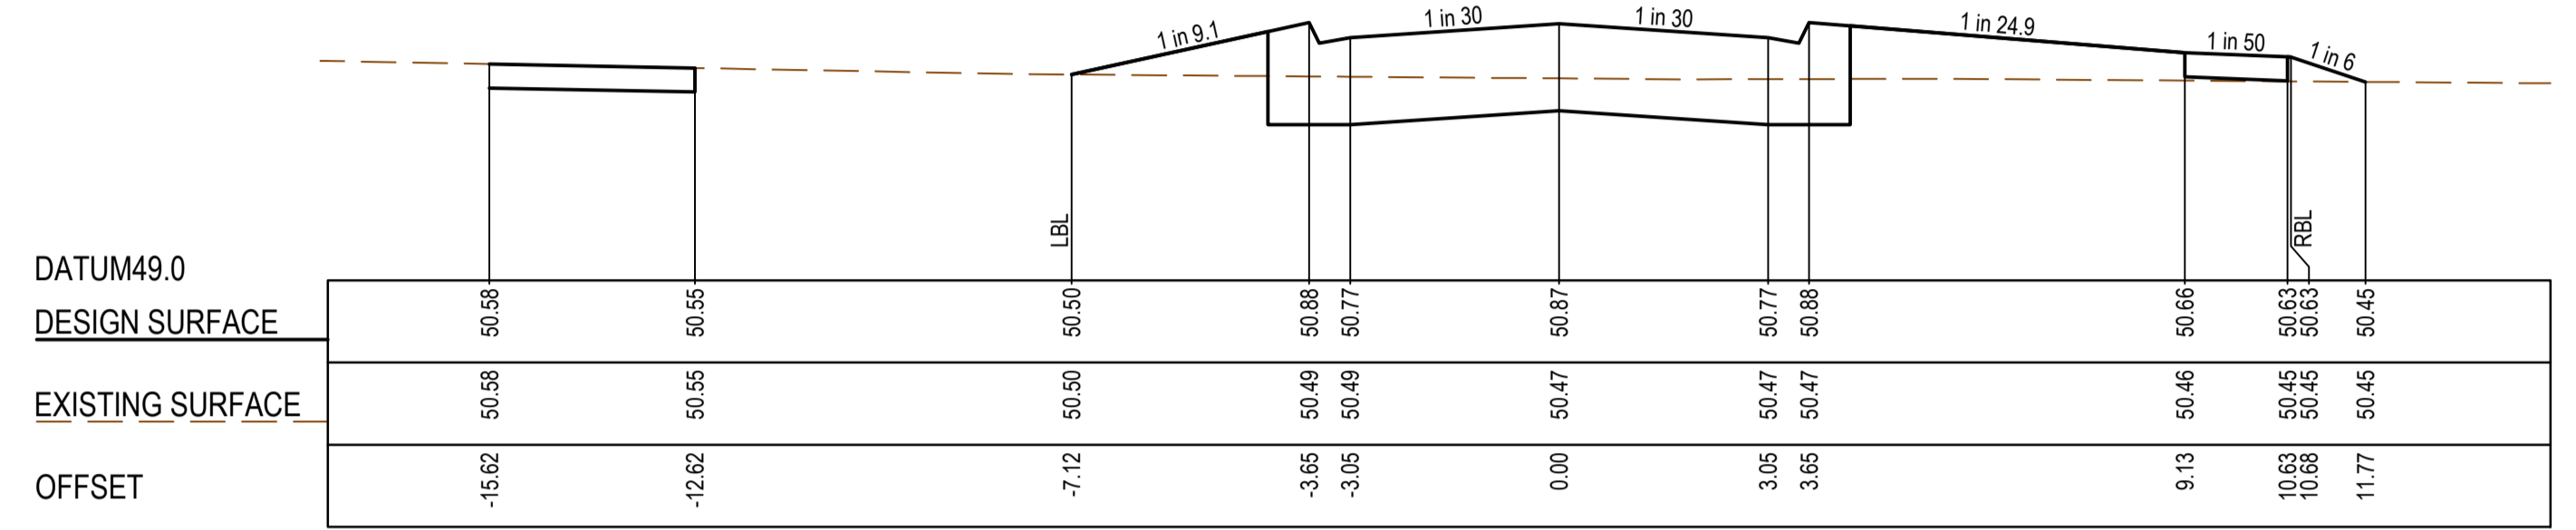


RTPCH 912.73

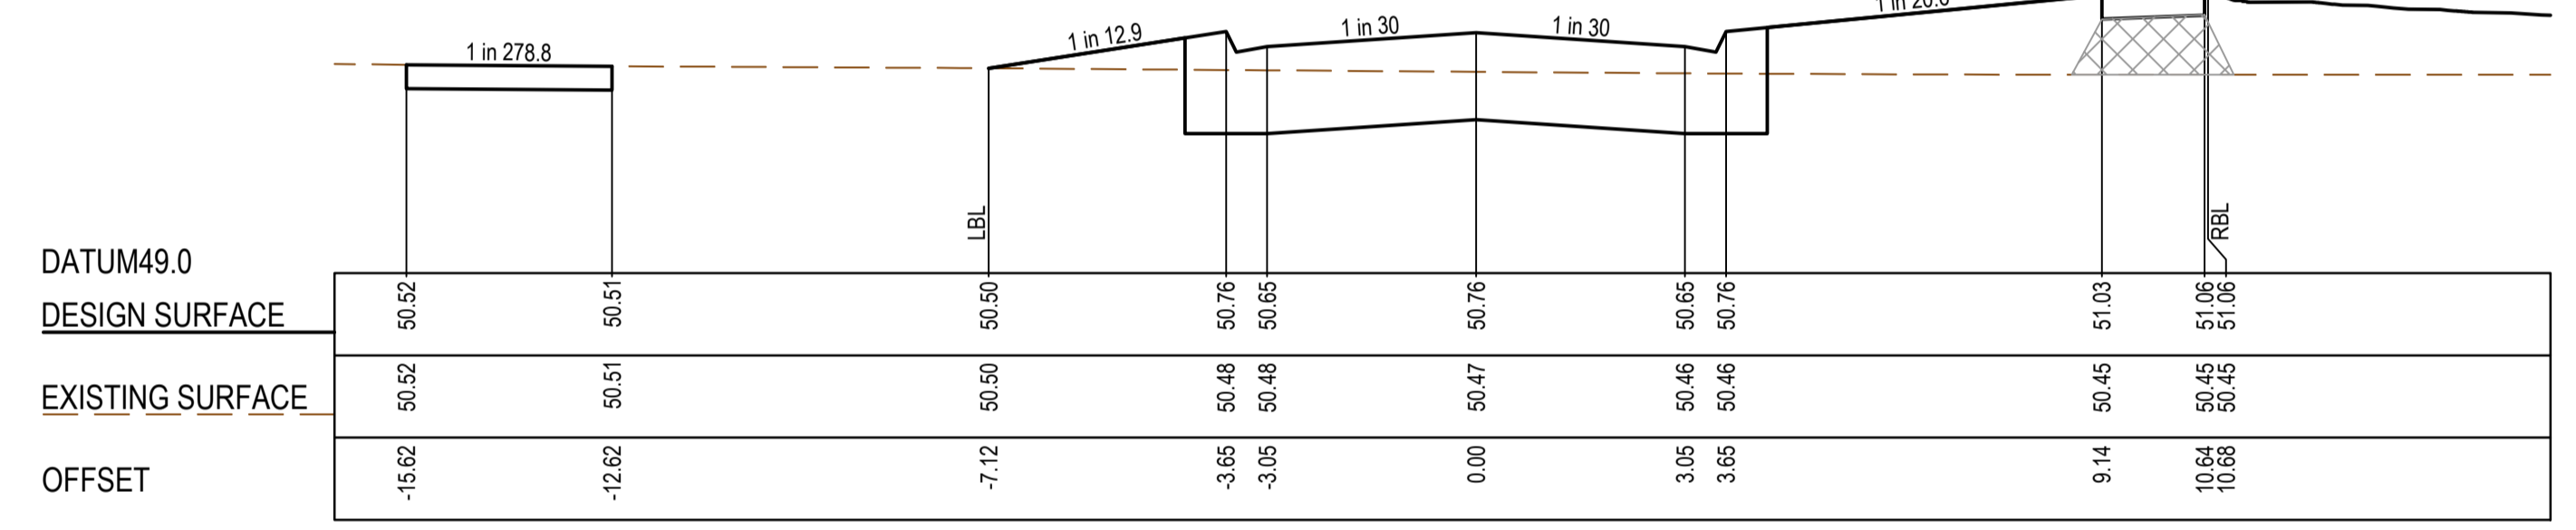

SAG 889.13

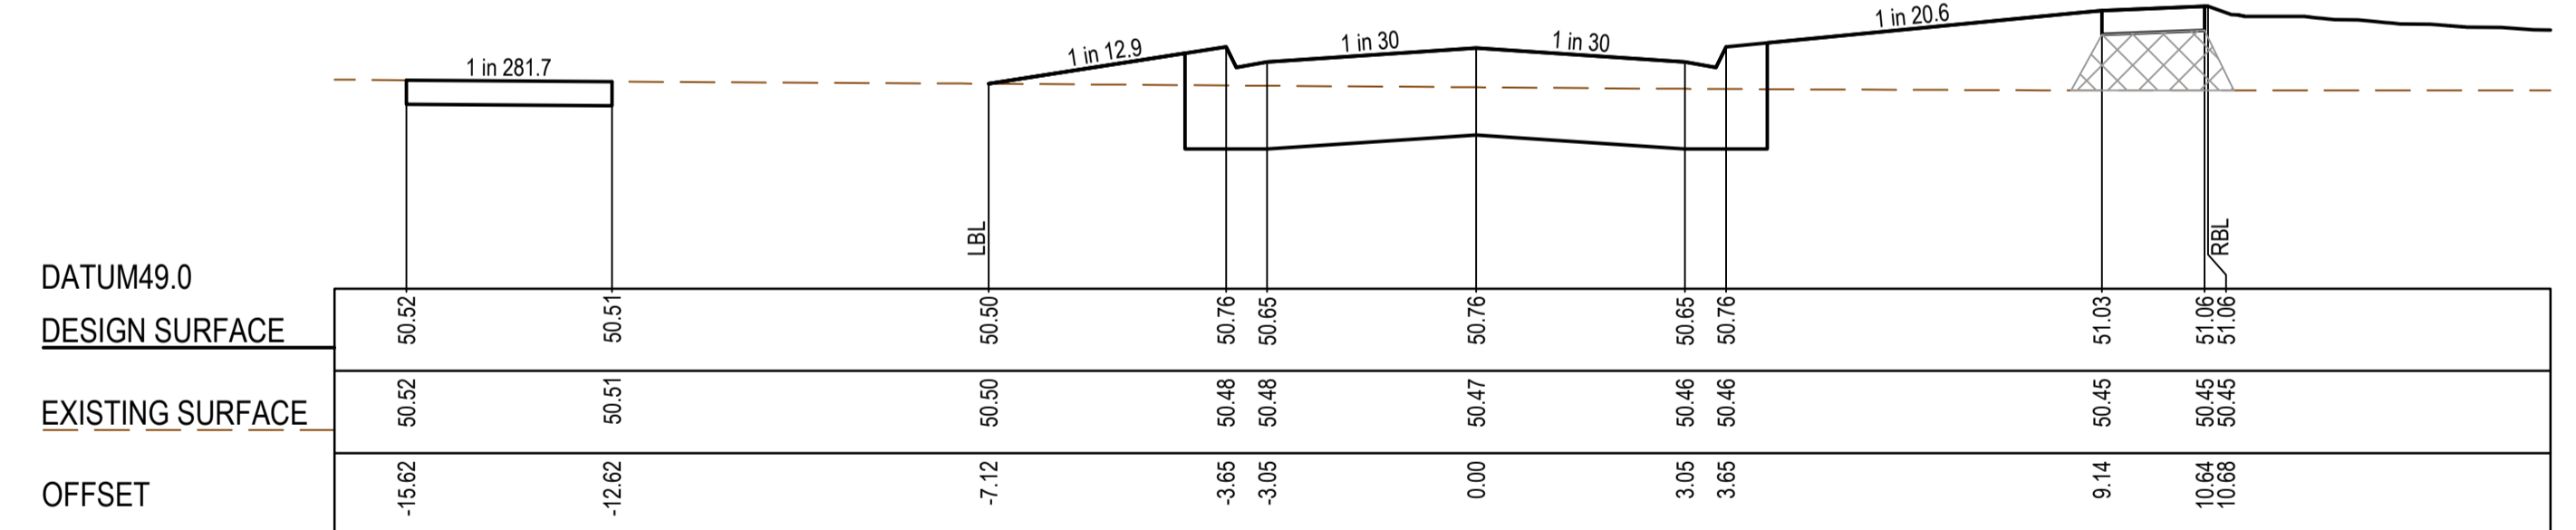

RTPCH 889.00

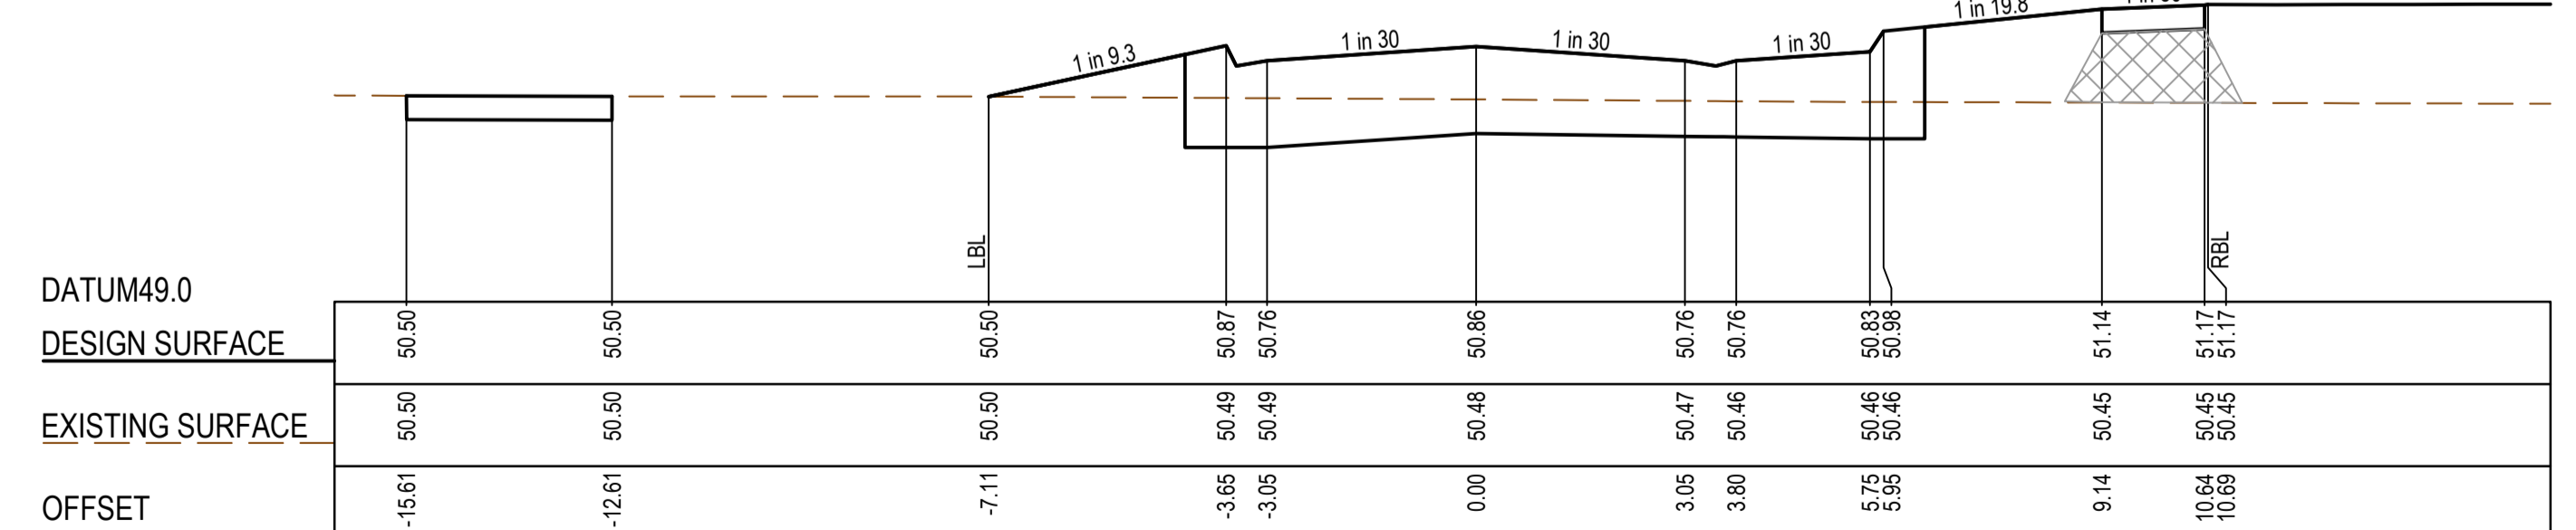


CH 867.78

**AS CONSTRUCTED PLANS**

The purpose of these as-constructed plans is to update the design drawings to show significant changes which occurred during construction. Note that the levels shown on these plans are design levels, and have not been verified by survey. All information shown on these plans should be verified on site. SMEC Australia Pty Ltd accept no responsibility for loss or damages resulting from the inappropriate usage of these plans.

PLAN OF SUB. NO.  
PS900882T  
PERMIT REF. NO.  
WYP10365/17.01

**AS CONSTRUCTED**

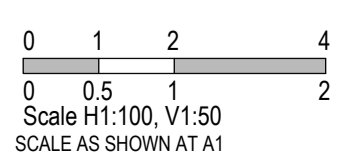

**SMEC**  
Member of the Surlana Jurong Group  
Collins Square, Tower 4, Level 20, 727 Collins St  
Melbourne, VIC 3008  
Ph 03 9514 1500



**GROWLAND**

Marigold - Stage 7  
Wyndham City Council  
Road and Drainage  
Cross Sections: Rosso Drive  
Ch 712.29 - Ch 940.69


MELWAYS REF <b>359 F9</b>	PROJECT / DRAWING No. <b>2360E-007-254</b>	SHEET No. <b>16 of 28</b>	REVISION <b>1</b>
------------------------------	---	------------------------------	----------------------




STRUCTURAL FILL REQUIRED UNDER PAVEMENT AND FOOTPATHS WHERE CONSTRUCTED ABOVE EXISTING SURFACE

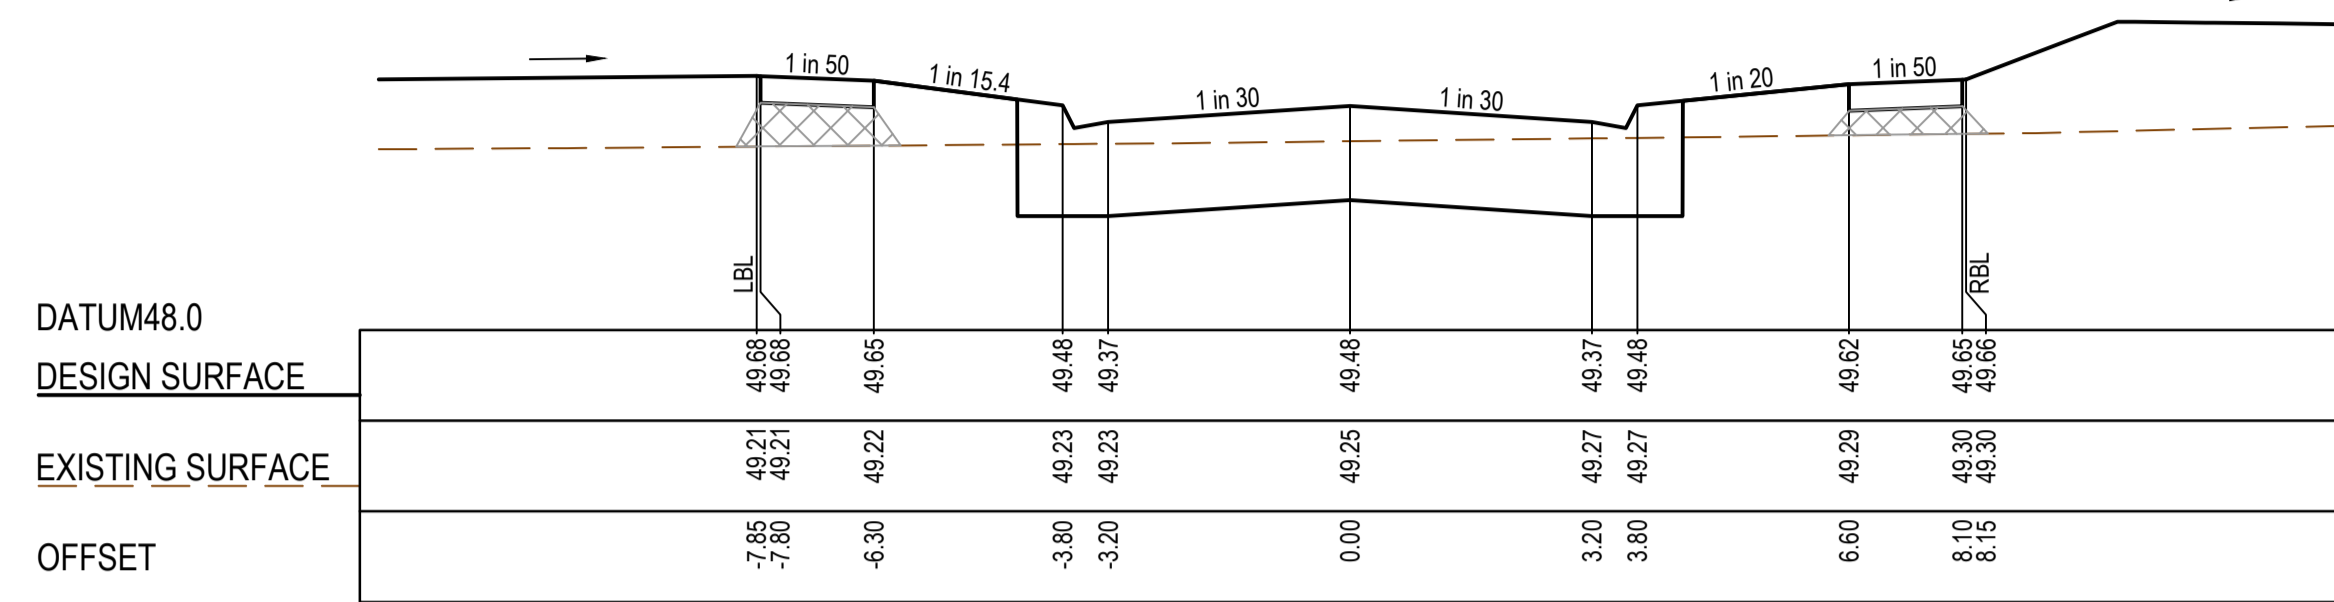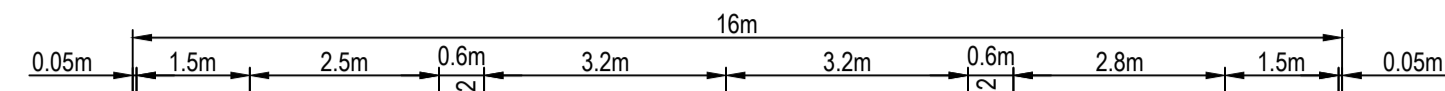


CH 124.38

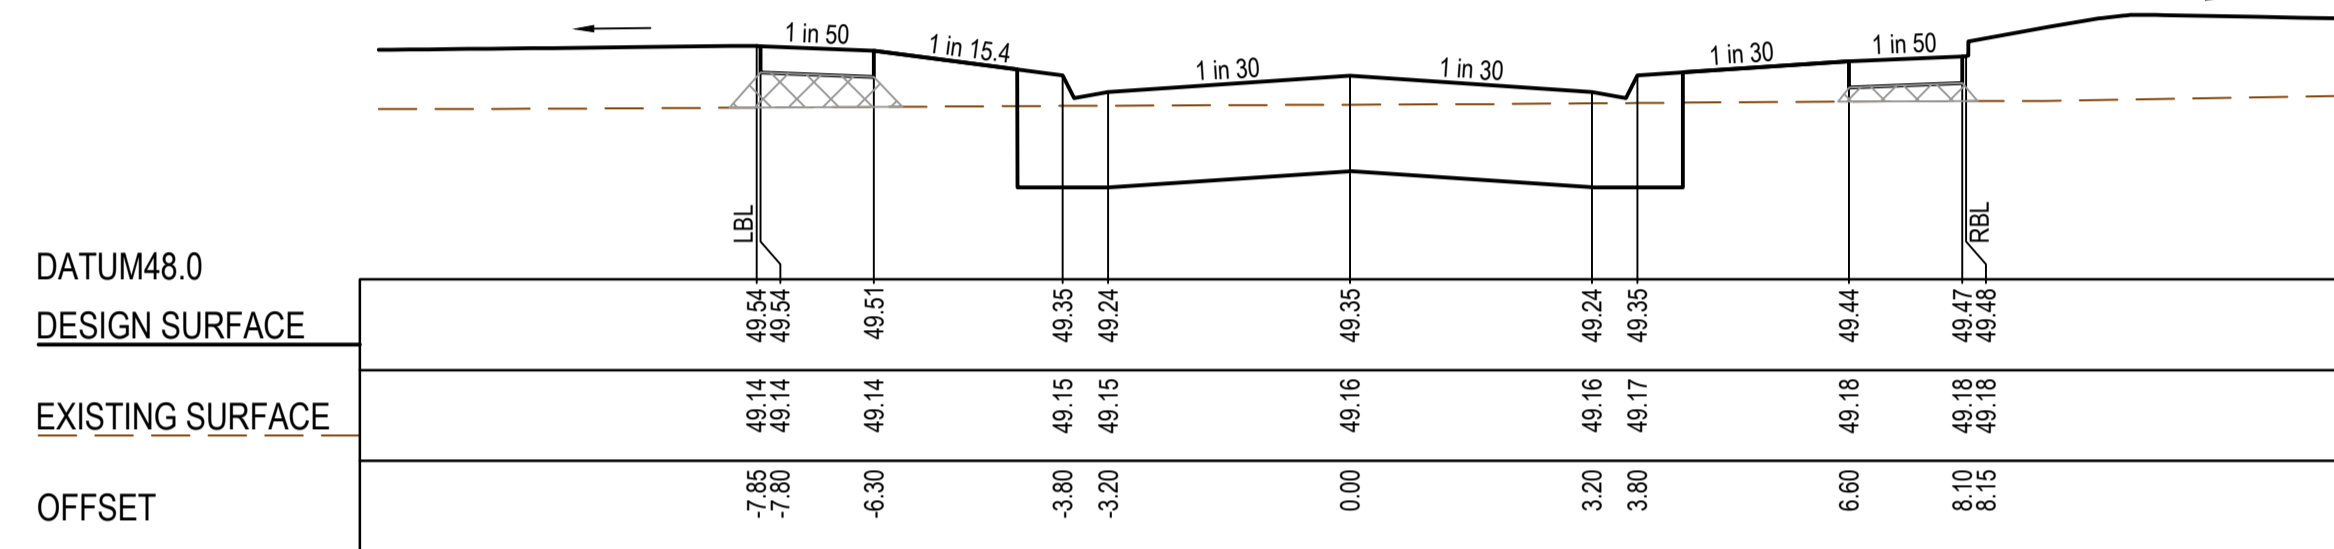


RTPCH 95.61

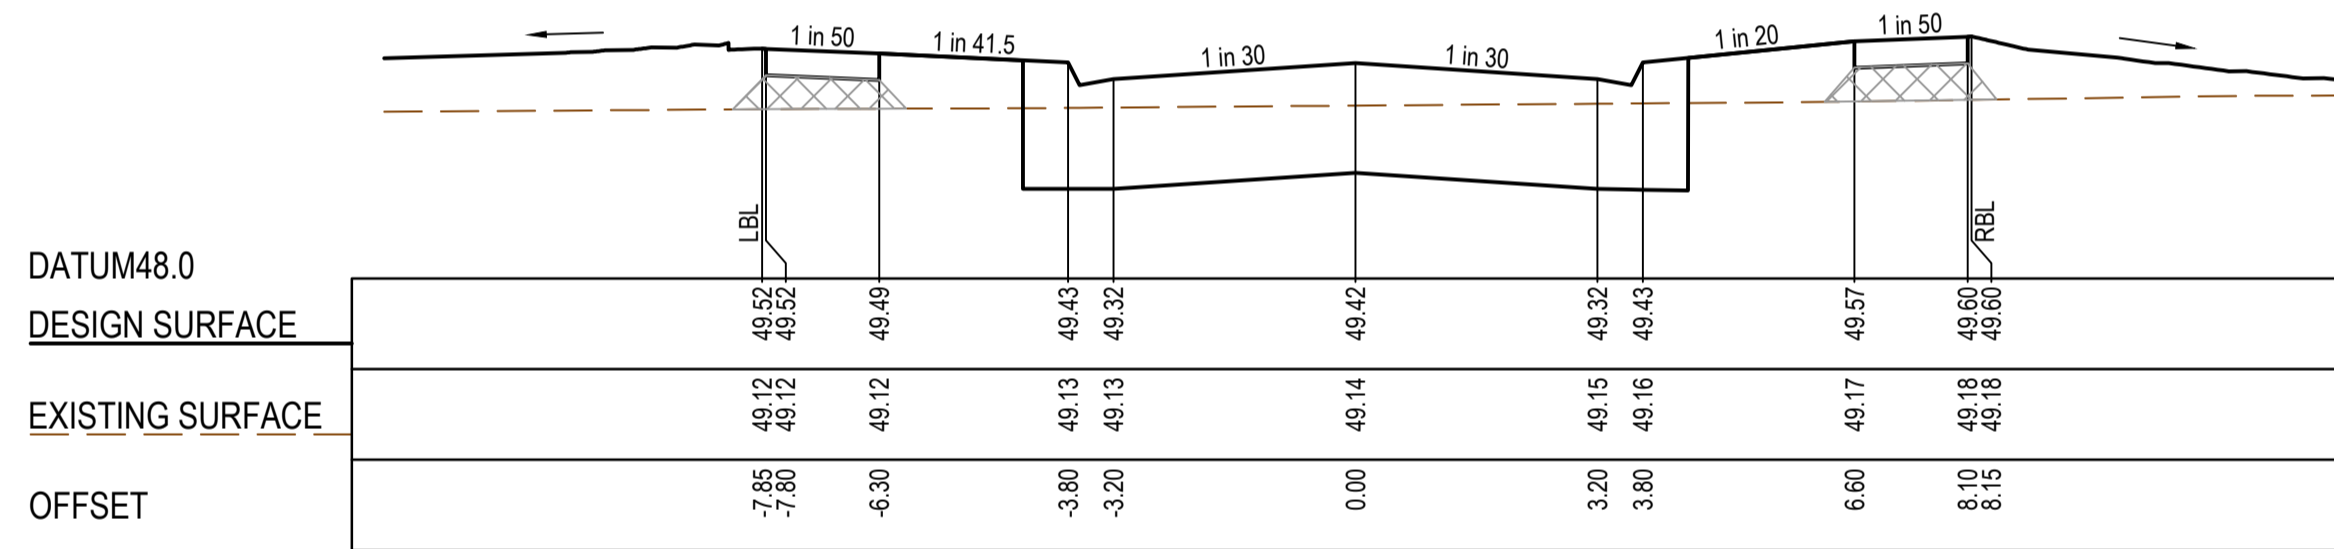


RTPCH 72.01

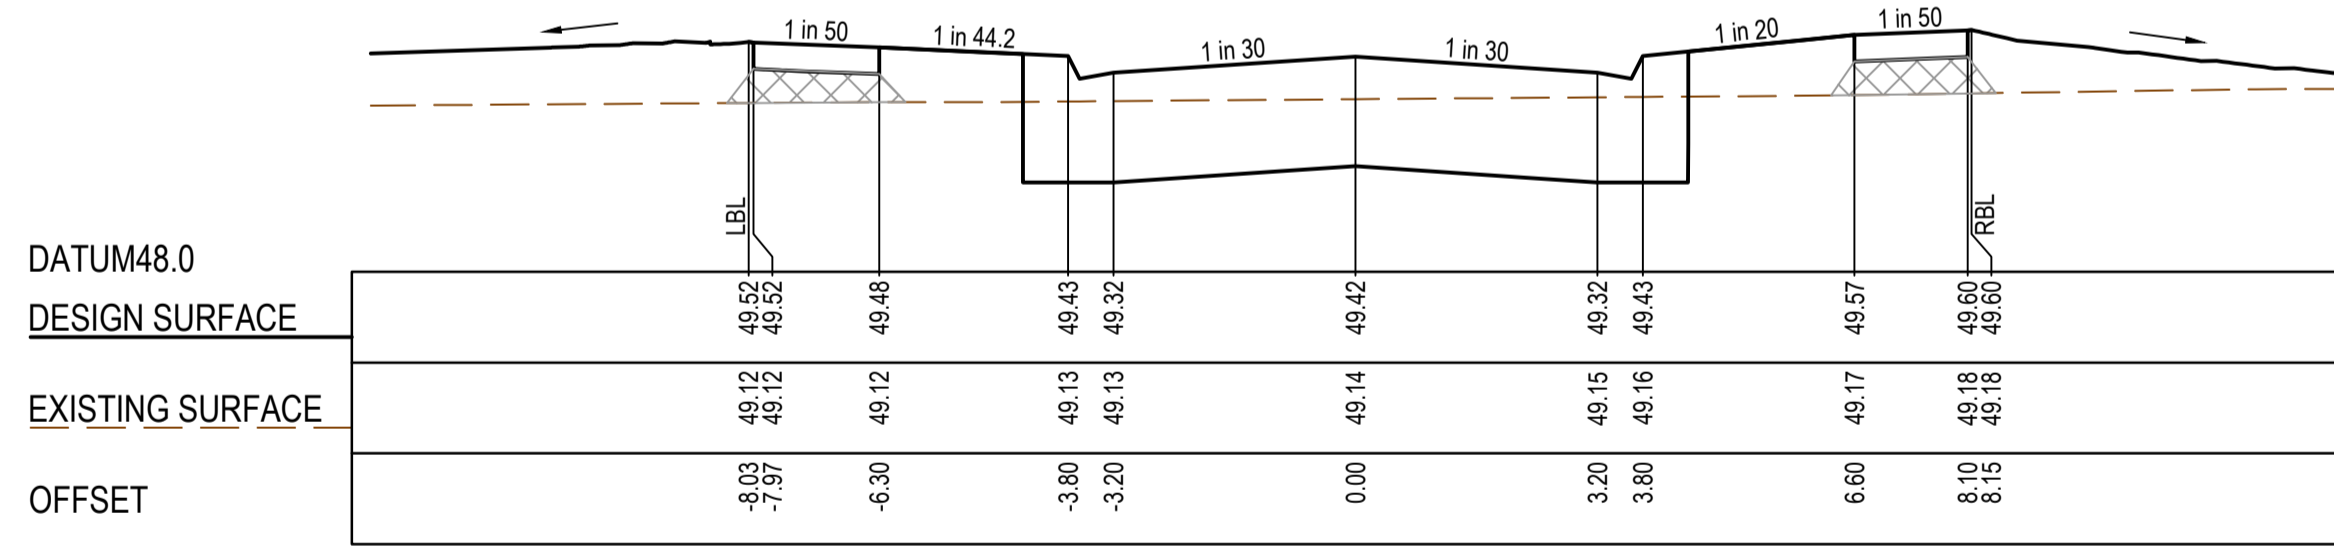


CREST 71.59

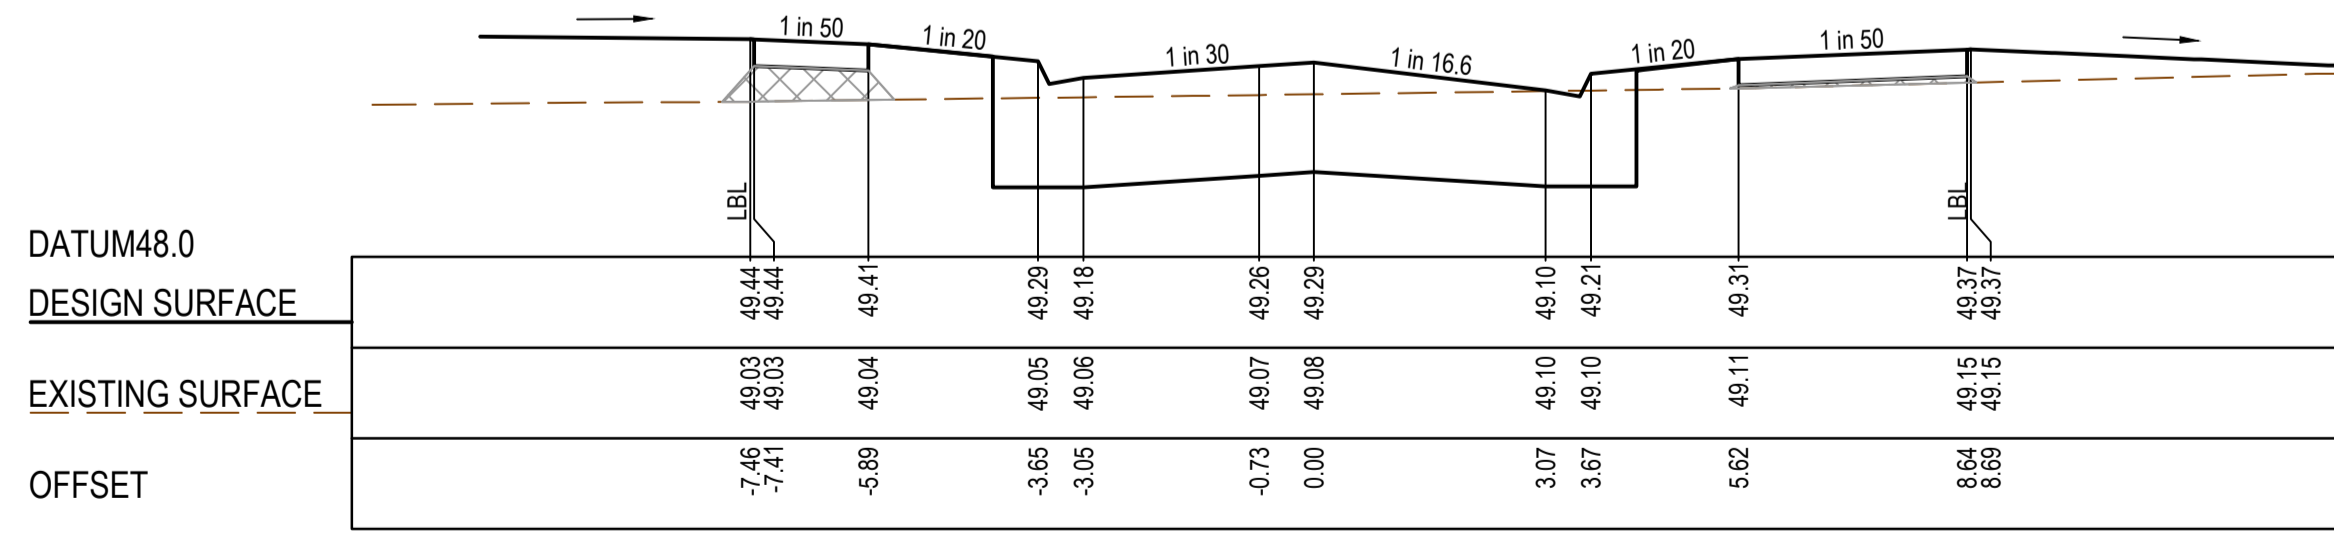


CH 48.38

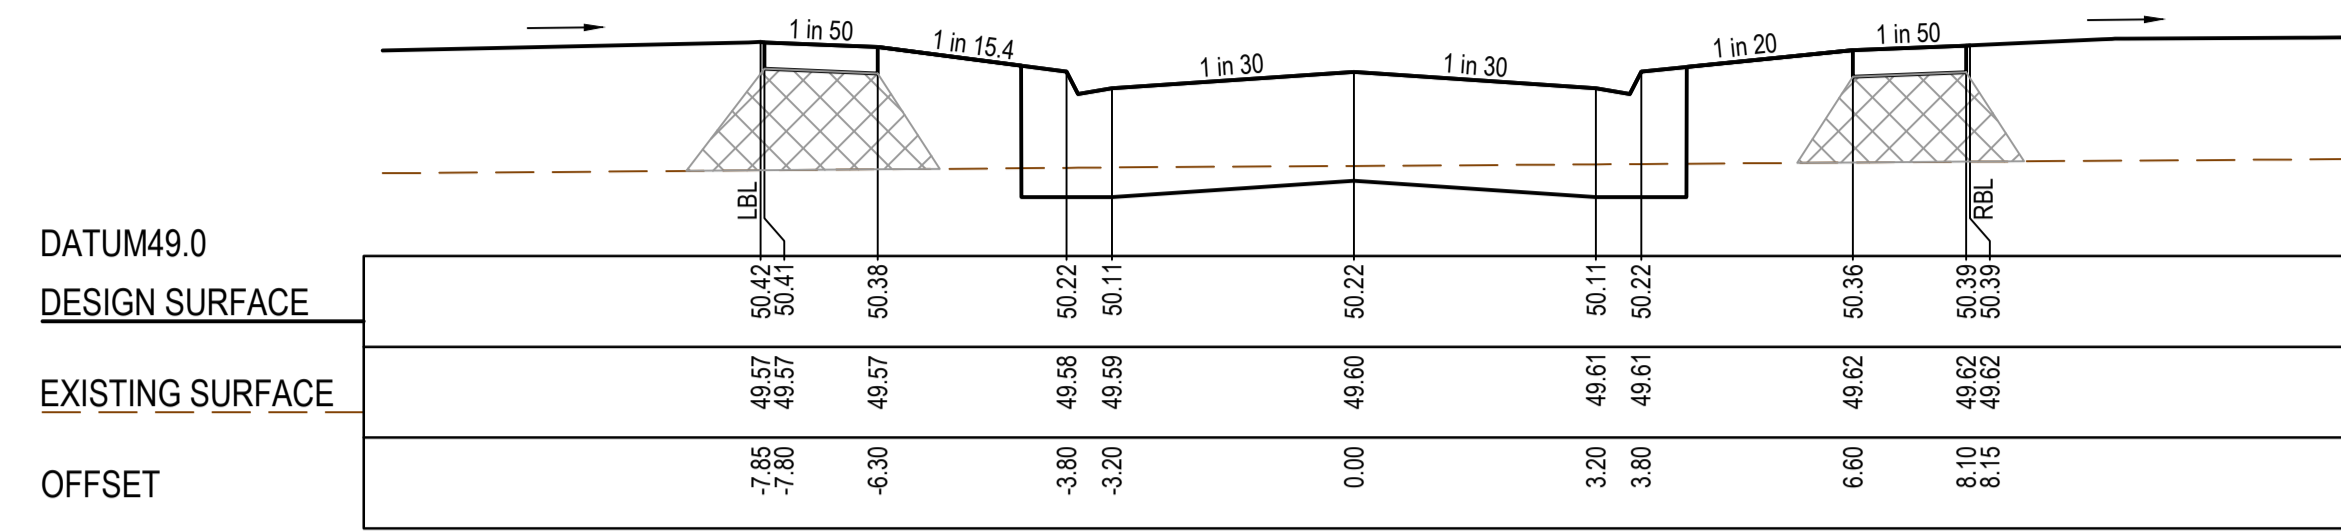


RTPCH 252.16

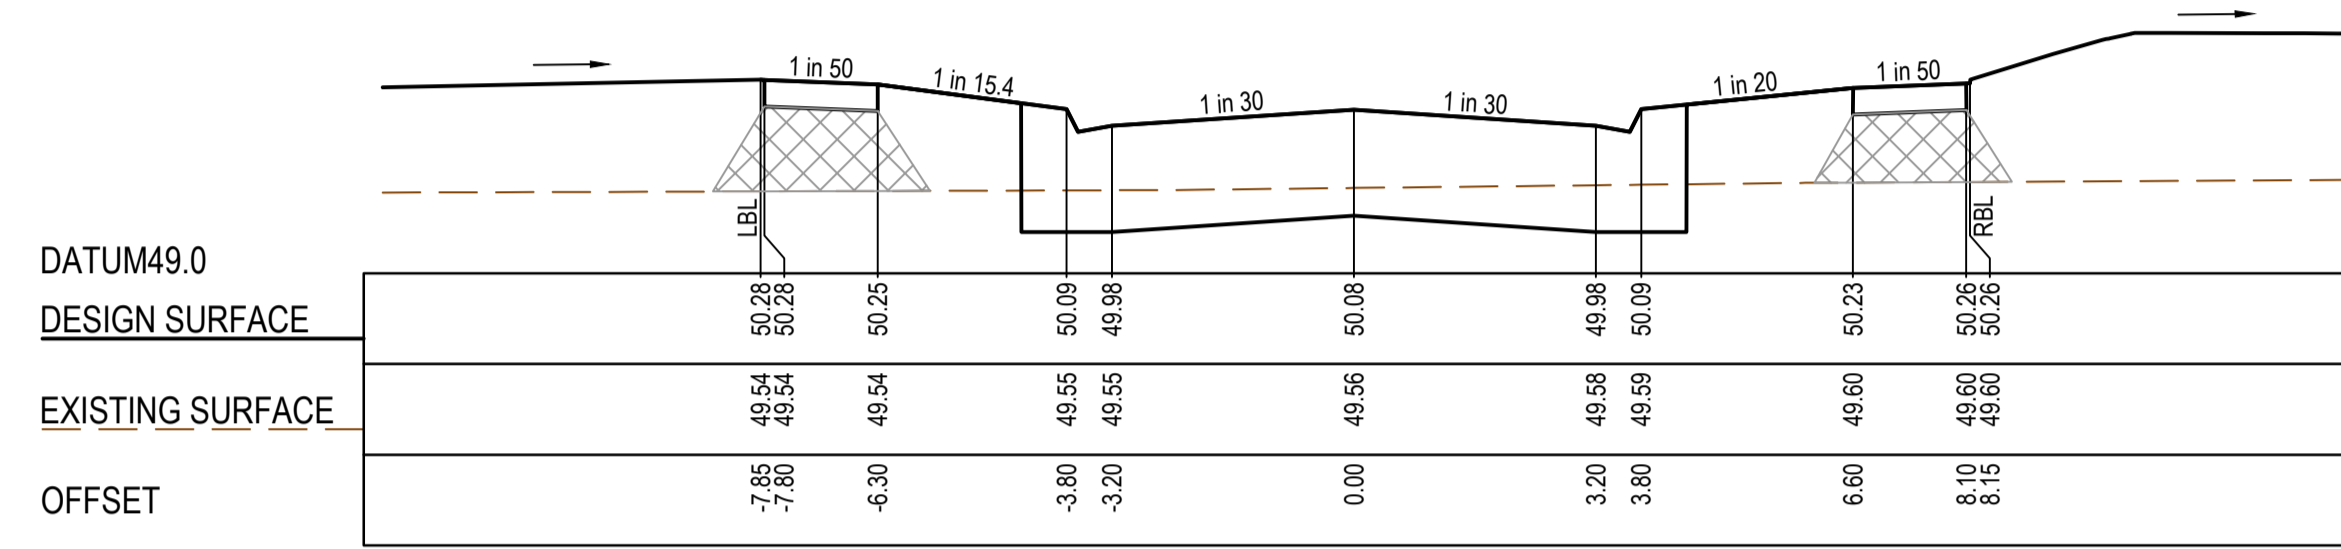


RTPCH 228.56

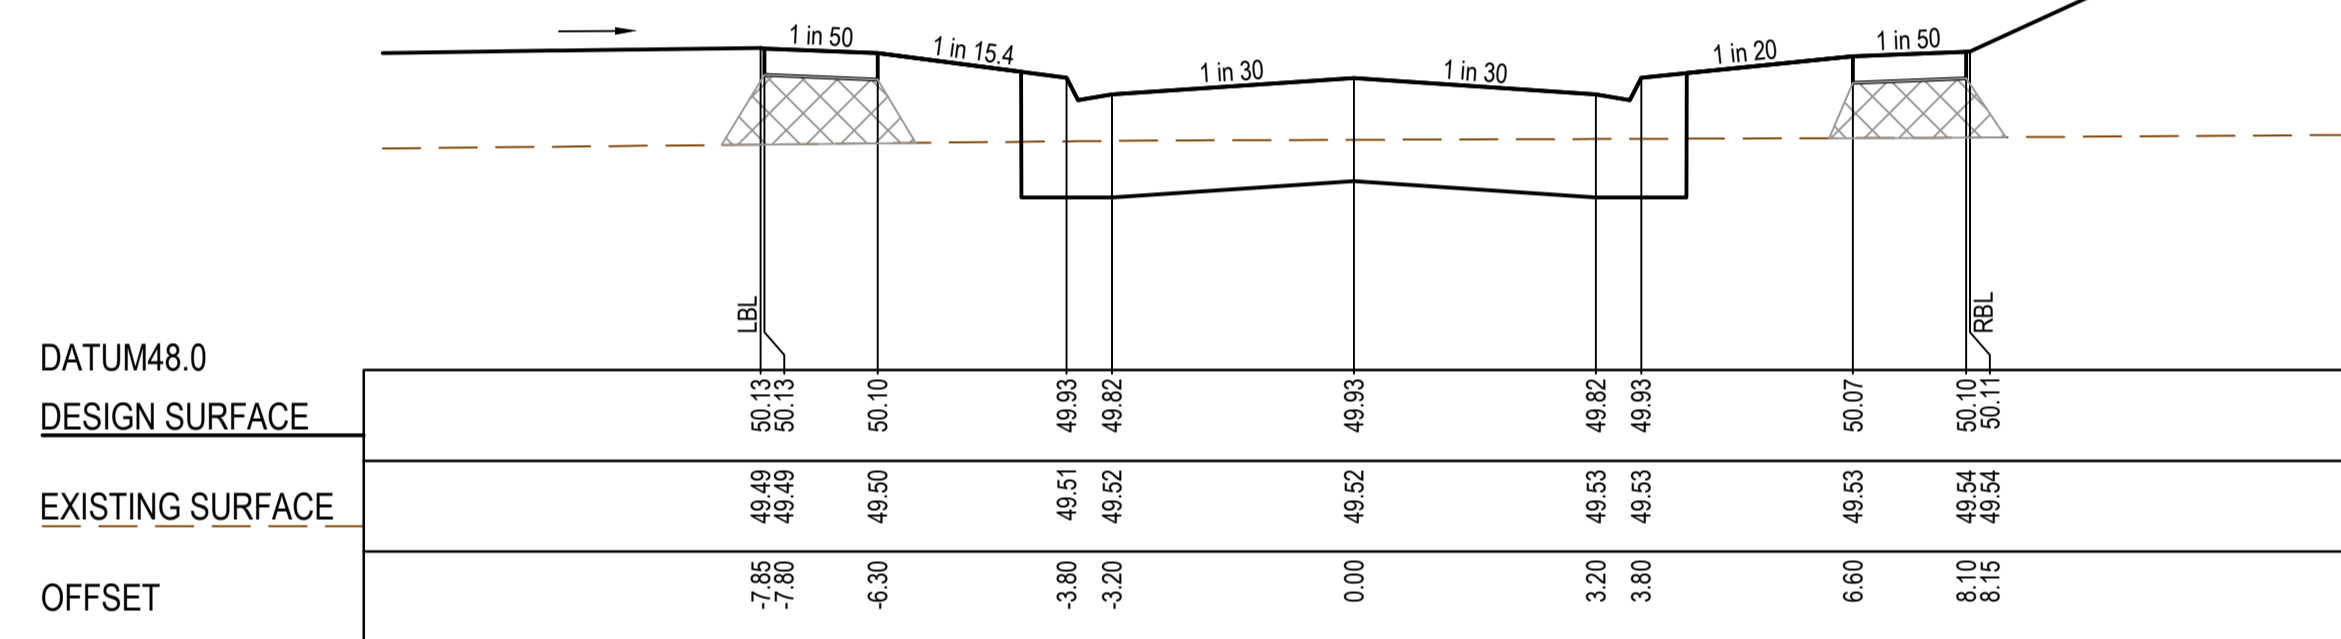

CH 202.38

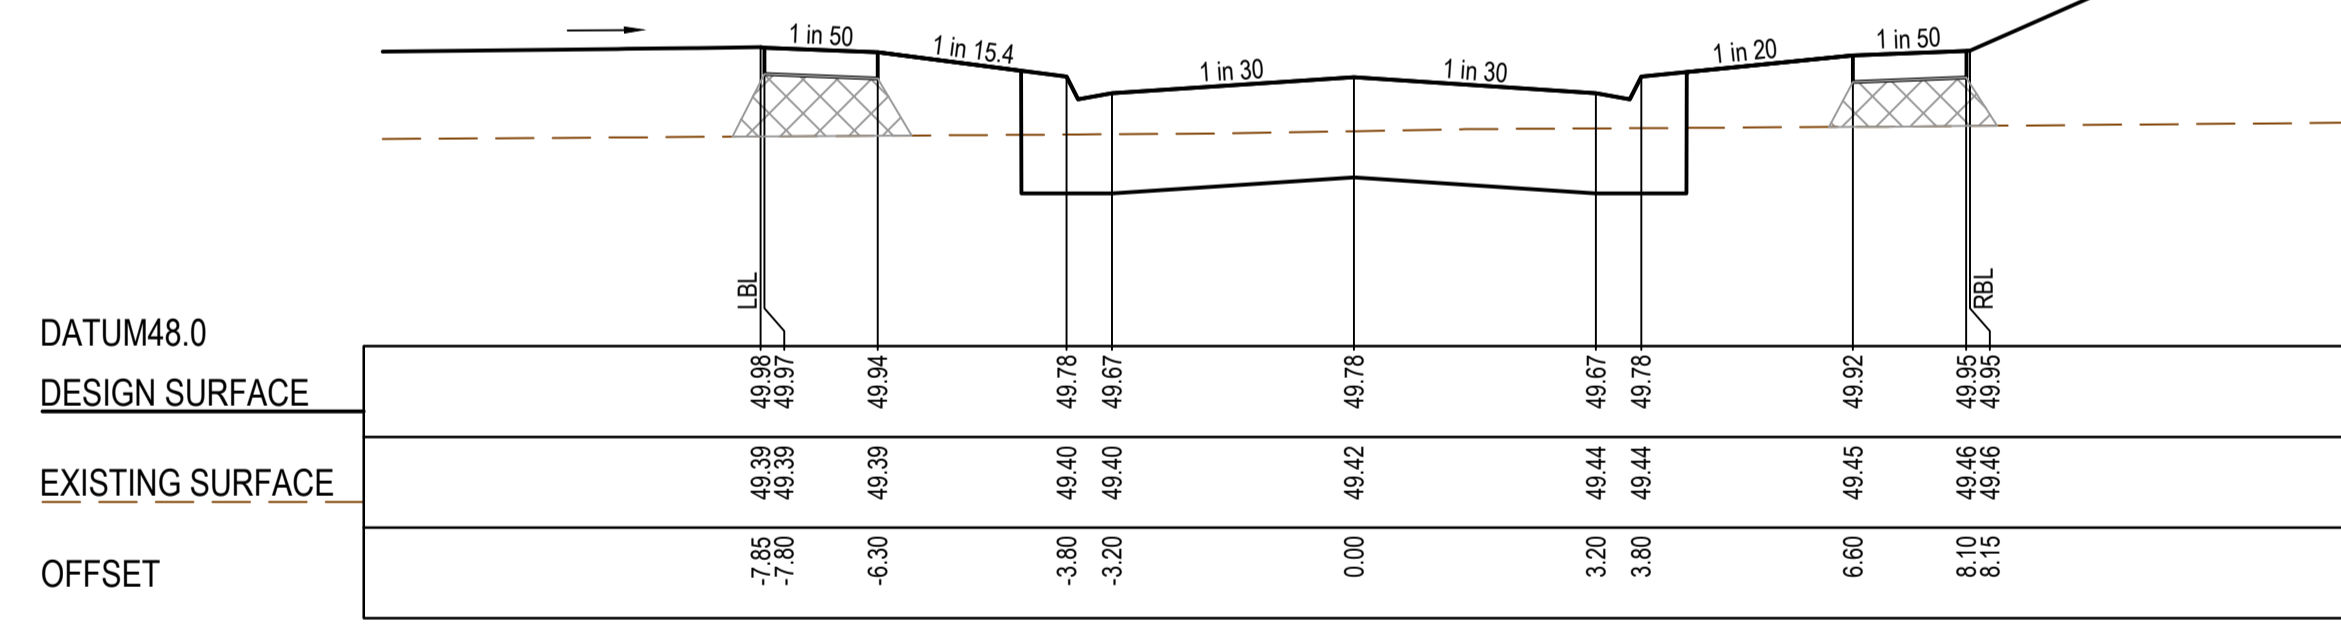

CH 175.88

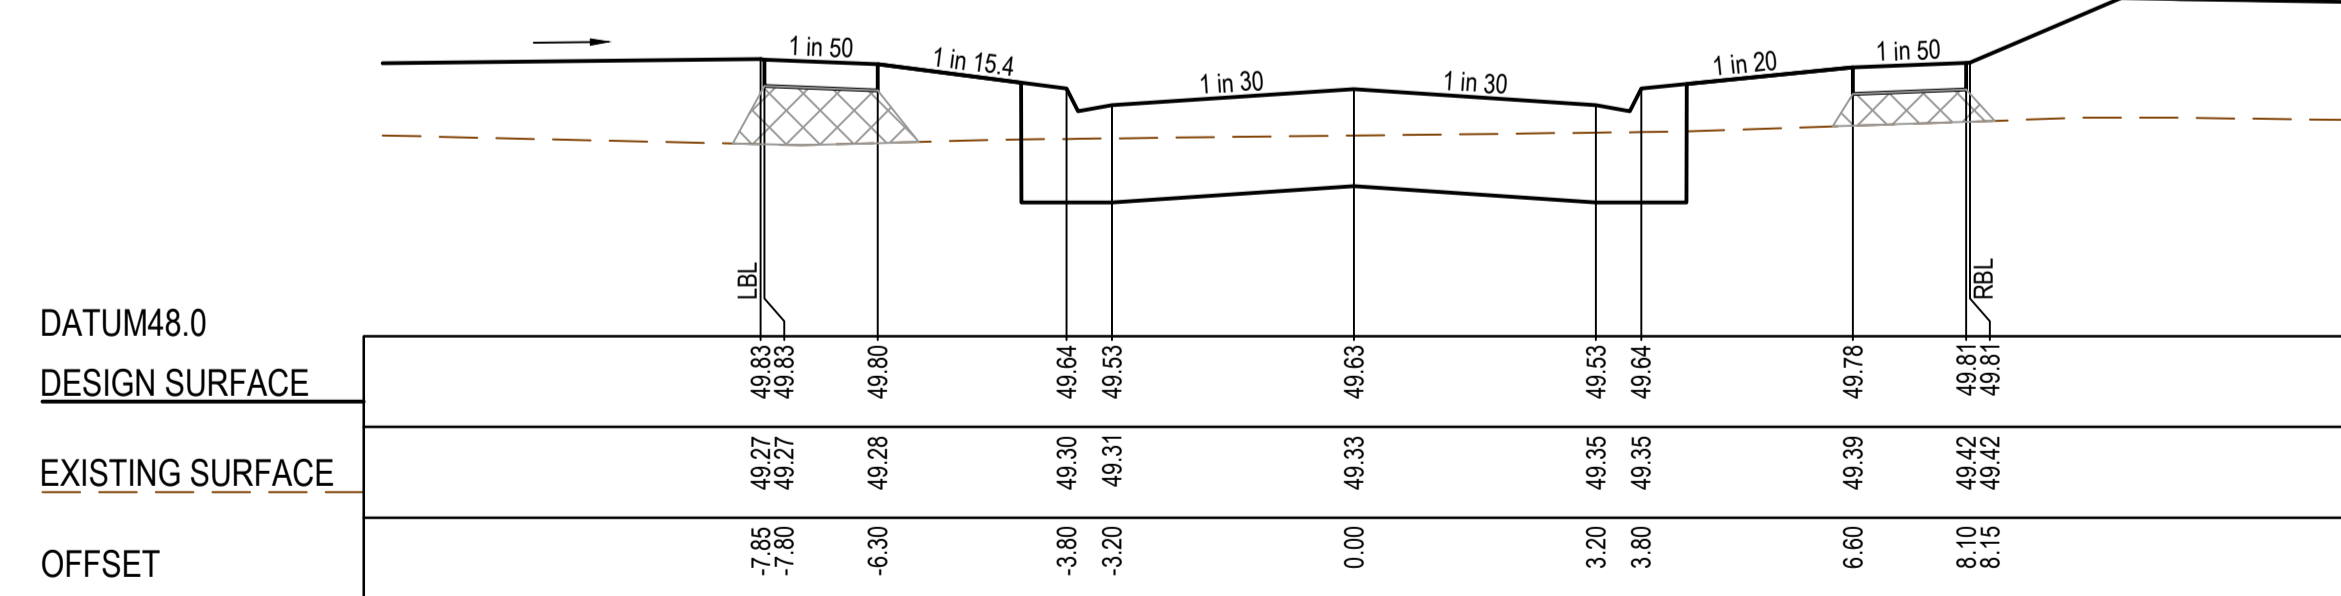

CH 150.88


**AS CONSTRUCTED PLANS**

The purpose of these as-constructed plans is to update the design drawings to show significant changes which occurred during construction. Note that the levels shown on these plans are design levels, and have not been verified by survey. All information shown on these plans should be verified on site. SMEC Australia Pty Ltd accept no responsibility for loss or damages resulting from the inappropriate usage of these plans.




PLAN OF SUB. NO.  
PS900882T  
PERMIT REF. NO.  
WYP10365/17.01

**AS CONSTRUCTED**

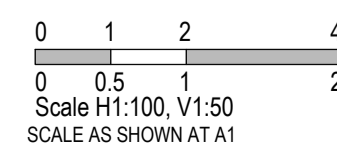


Collins Square, Tower 4, Level 20, 727 Collins St  
Melbourne, VIC 3008  
Ph 03 9514 1500

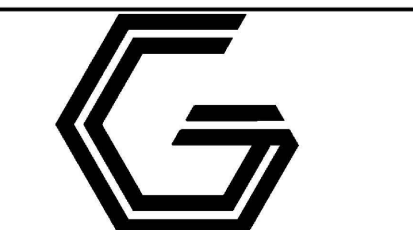

**GROWLAND**


Marigold - Stage 7  
Wyndham City Council  
Road and Drainage  
Cross Sections: Reunion Road  
Ch 48.38 - Ch 252.16

MELWAYS REF <b>359 F9</b>	PROJECT / DRAWING No. <b>2360E-007-255</b>	SHEET No. <b>17 of 28</b>	REVISION <b>1</b>
------------------------------	---	------------------------------	----------------------

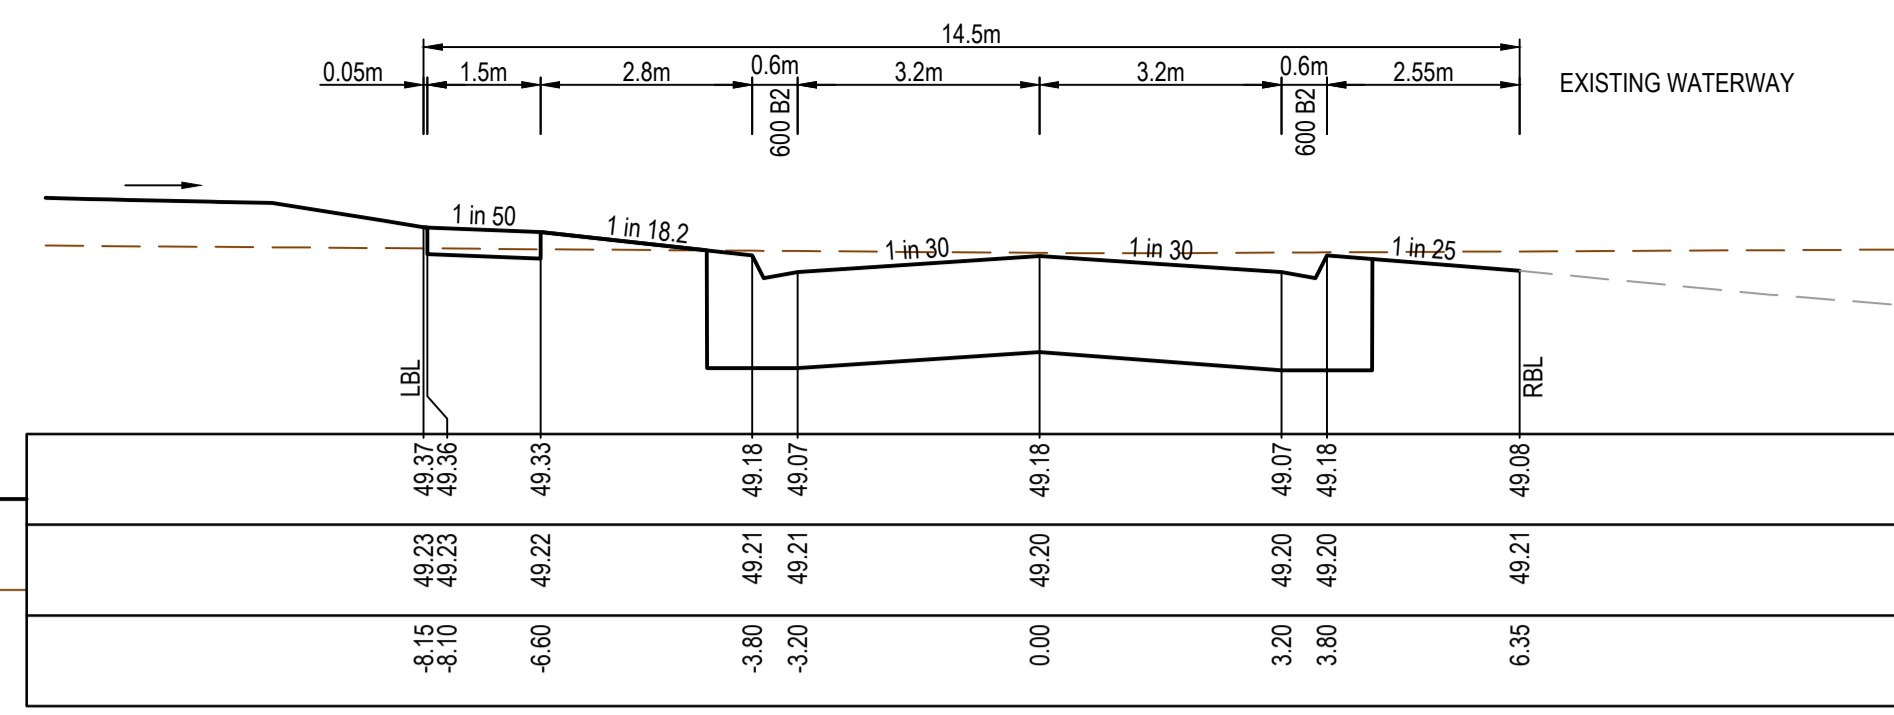


STRUCTURAL FILL REQUIRED UNDER PAVEMENT AND FOOTPATHS WHERE CONSTRUCTED ABOVE EXISTING SURFACE

Waterway Q100 LEVEL: 47.59 RL

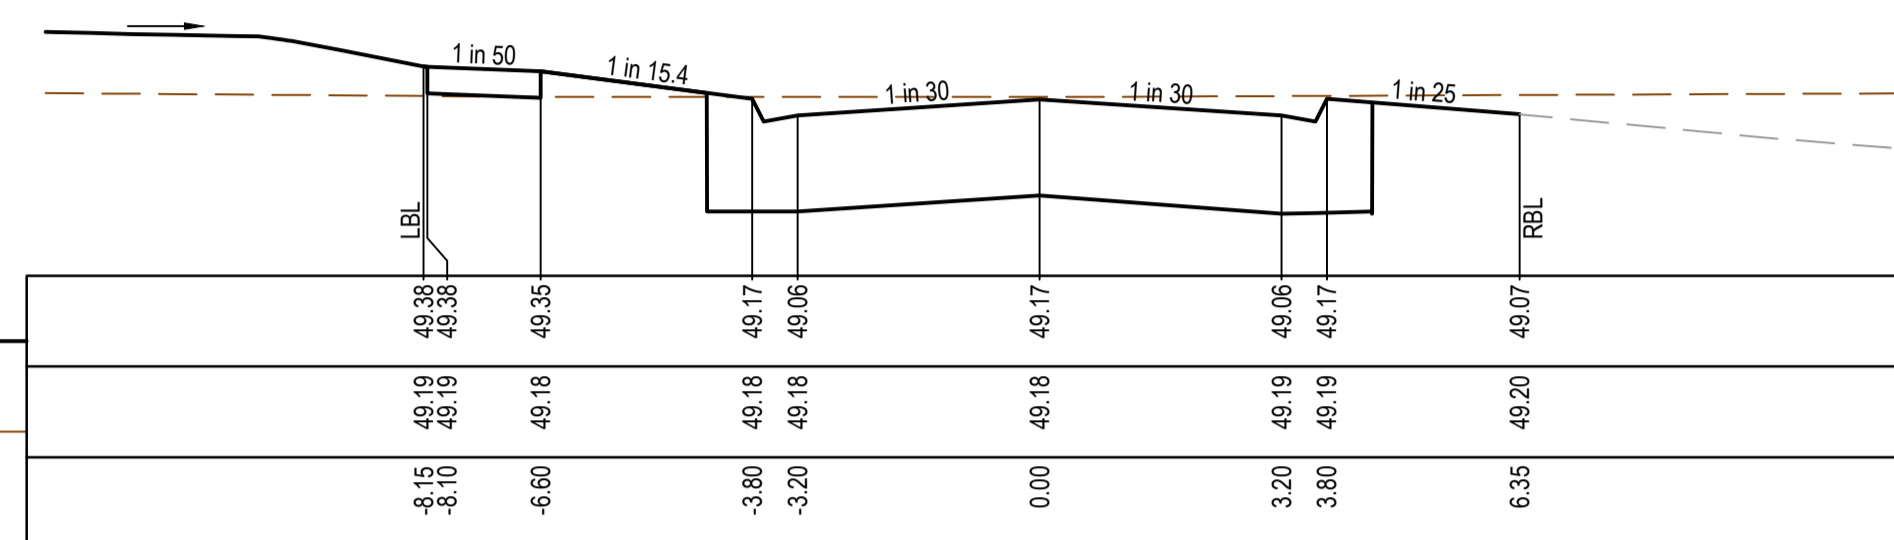


Waterway Q100 LEVEL: 47.59 RL

RECOGNITION AVENUE CROSS SECTION

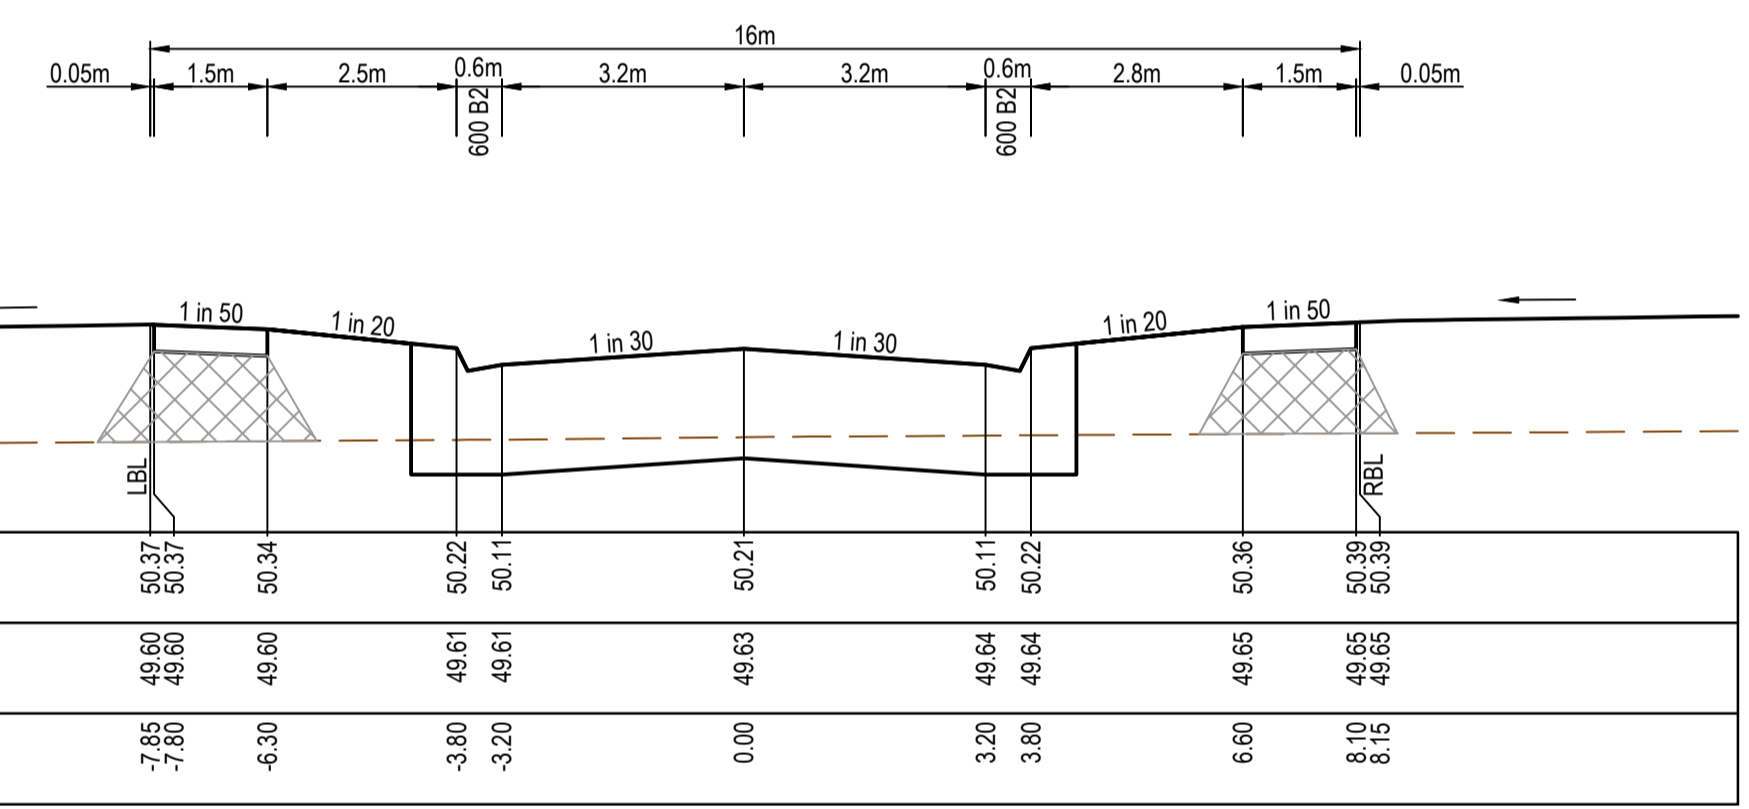

CH 267.88

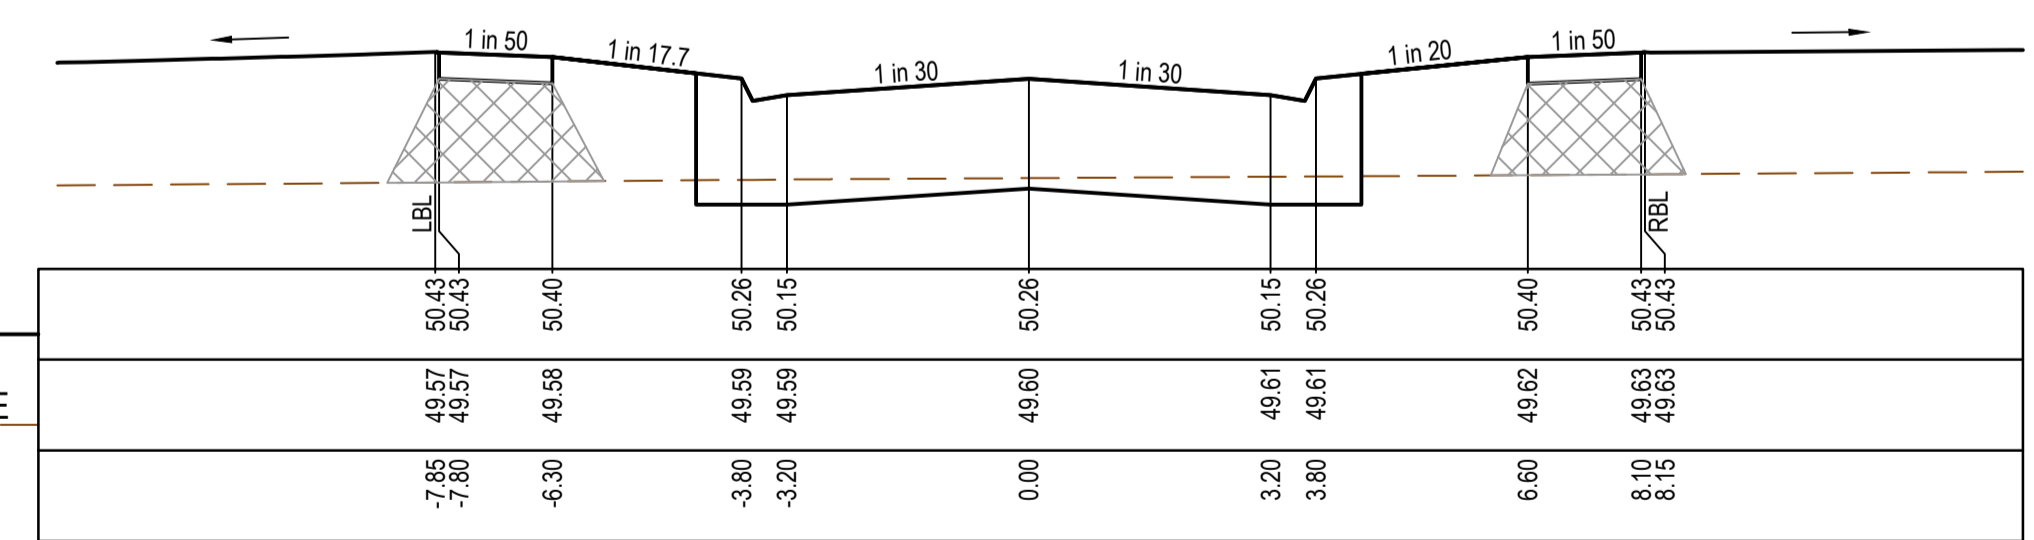

CREST 258.93

REUNION ROAD CROSS SECTION


AS CONSTRUCTED PLANS

The purpose of these as-constructed plans is to update the design drawings to show significant changes which occurred during construction. Note that the levels shown on these plans are design levels, and have not been verified by survey. All information shown on these plans should be verified on site. SMEC Australia Pty Ltd accept no responsibility for loss or damages resulting from the inappropriate usage of these plans.

Quality Management ISO 9001  
 OHS Management AS/NZS 4801  
 Environmental Management ISO 14001  
 Global-Mark.com.au®

PLAN OF SUB. NO. PS900882T  
 PERMIT REF. NO. WYP10365/17.01

**AS CONSTRUCTED**

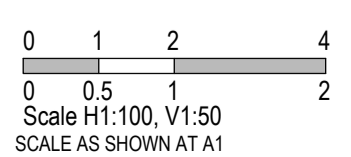





**SMEC**  
 Member of the Surlana Jurong Group  
 ABN 47 065 475 149  
 Collins Square, Tower 4, Level 20, 727 Collins St  
 Melbourne, VIC 3008  
 Ph 03 9514 1500

**GROWLAND**

Marigold - Stage 7  
 Wyndham City Council  
 Road and Drainage  
 Cross Sections: Reunion Road Ch 258.93 - Ch 267.88  
 Recognition Ave. Ch 11.80 - Ch 16.15

MELWAYS REF 359 F9	PROJECT / DRAWING No. 2360E-007-256	SHEET No. 18 of 28	REVISION 1
-----------------------	--	-----------------------	---------------

STRUCTURAL FILL REQUIRED UNDER PAVEMENT AND FOOTPATHS WHERE CONSTRUCTED ABOVE EXISTING SURFACE

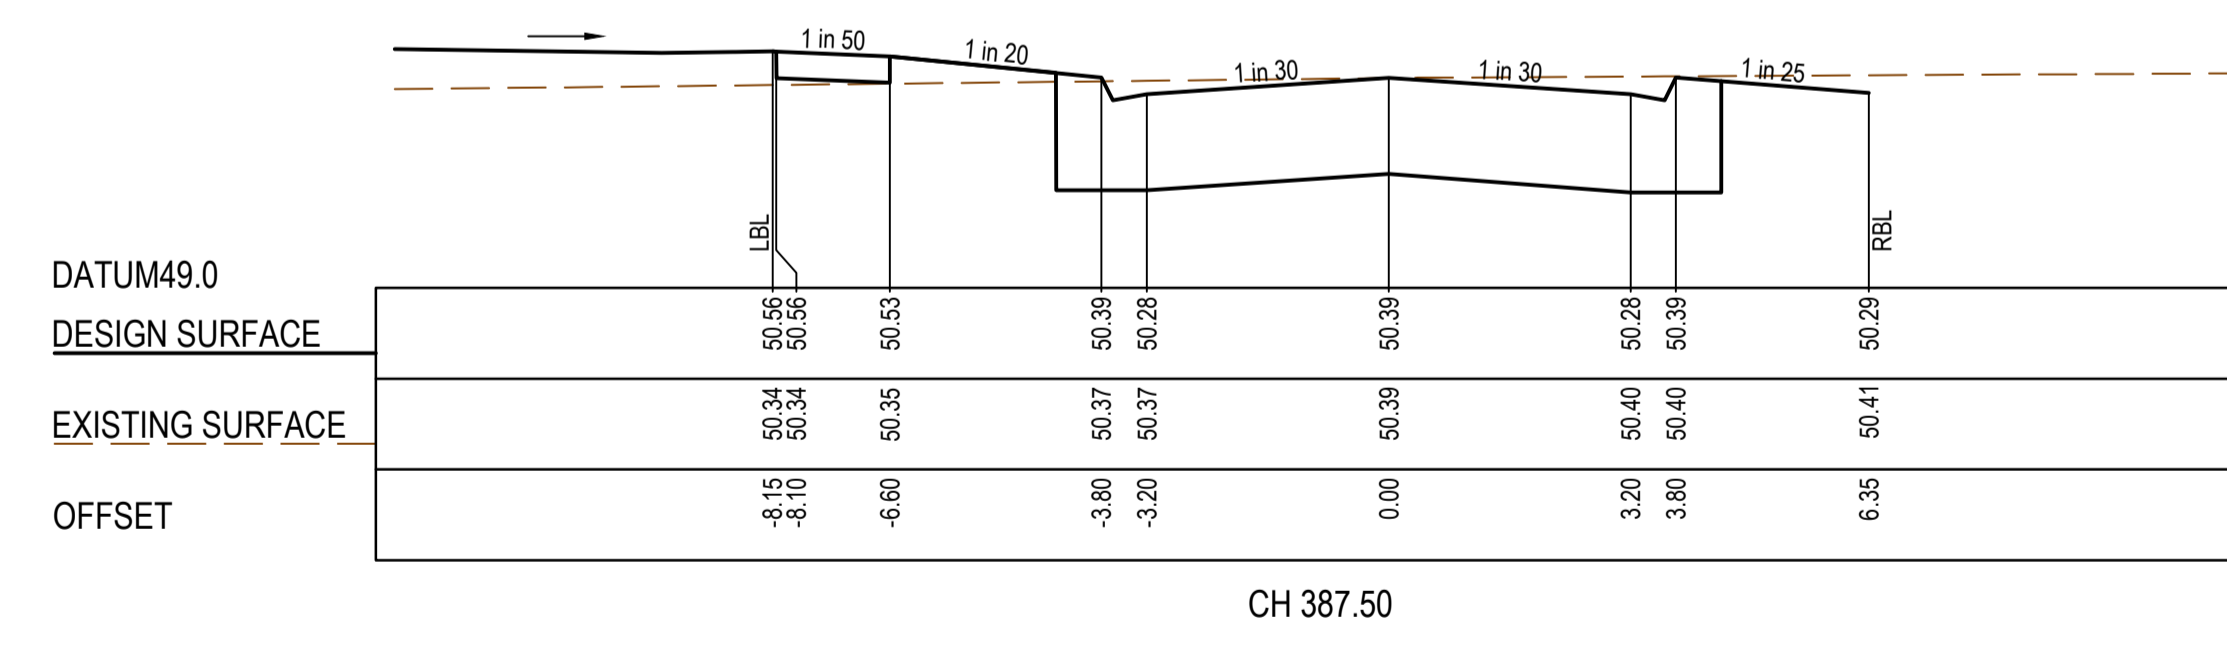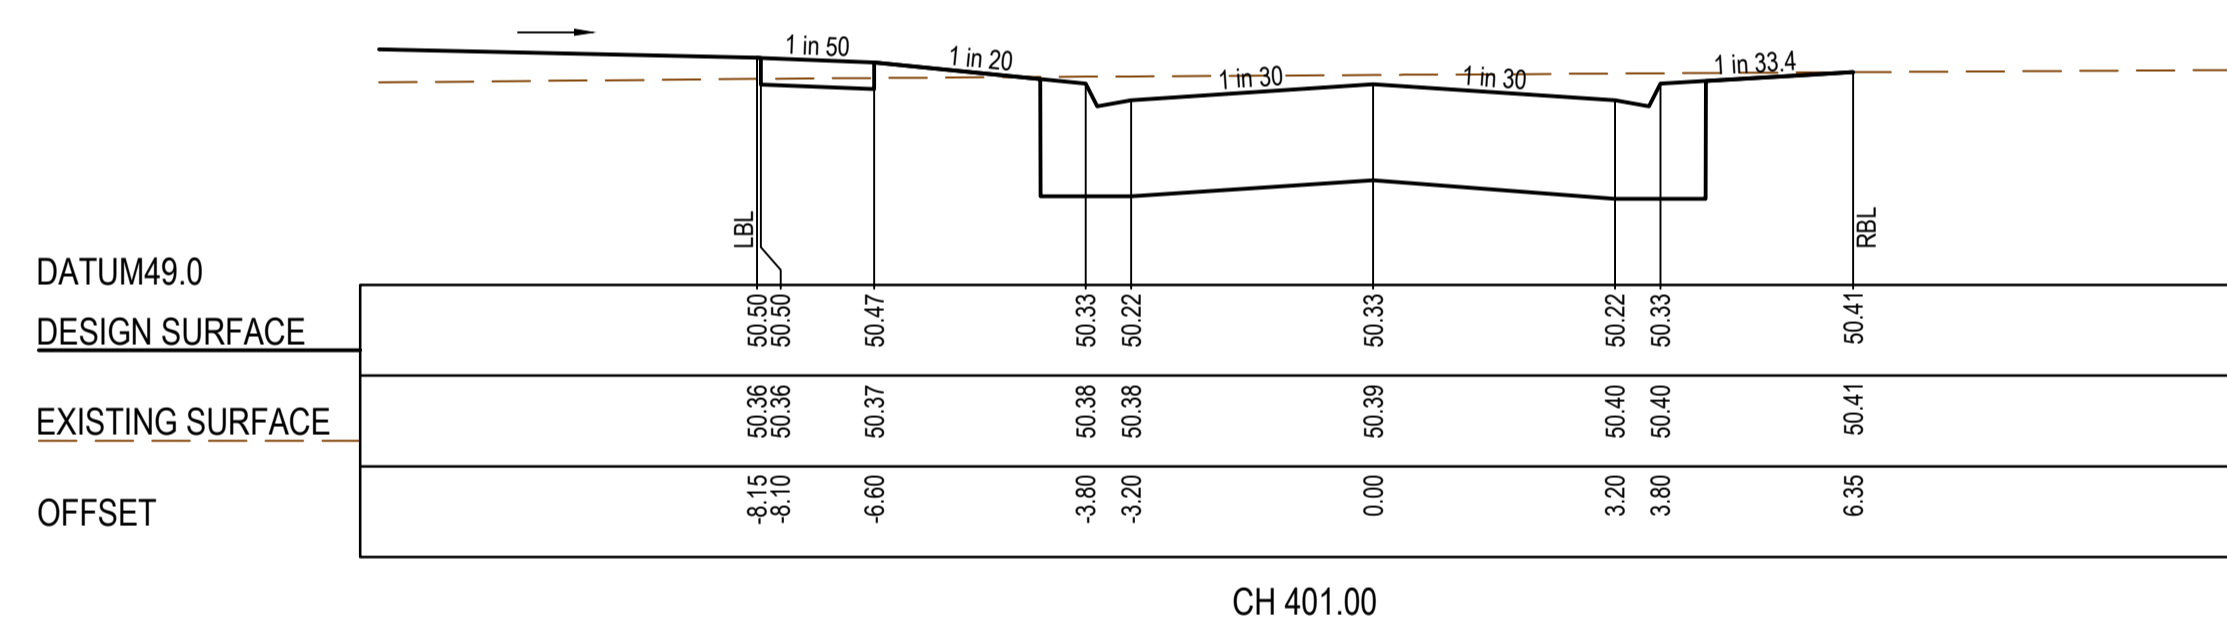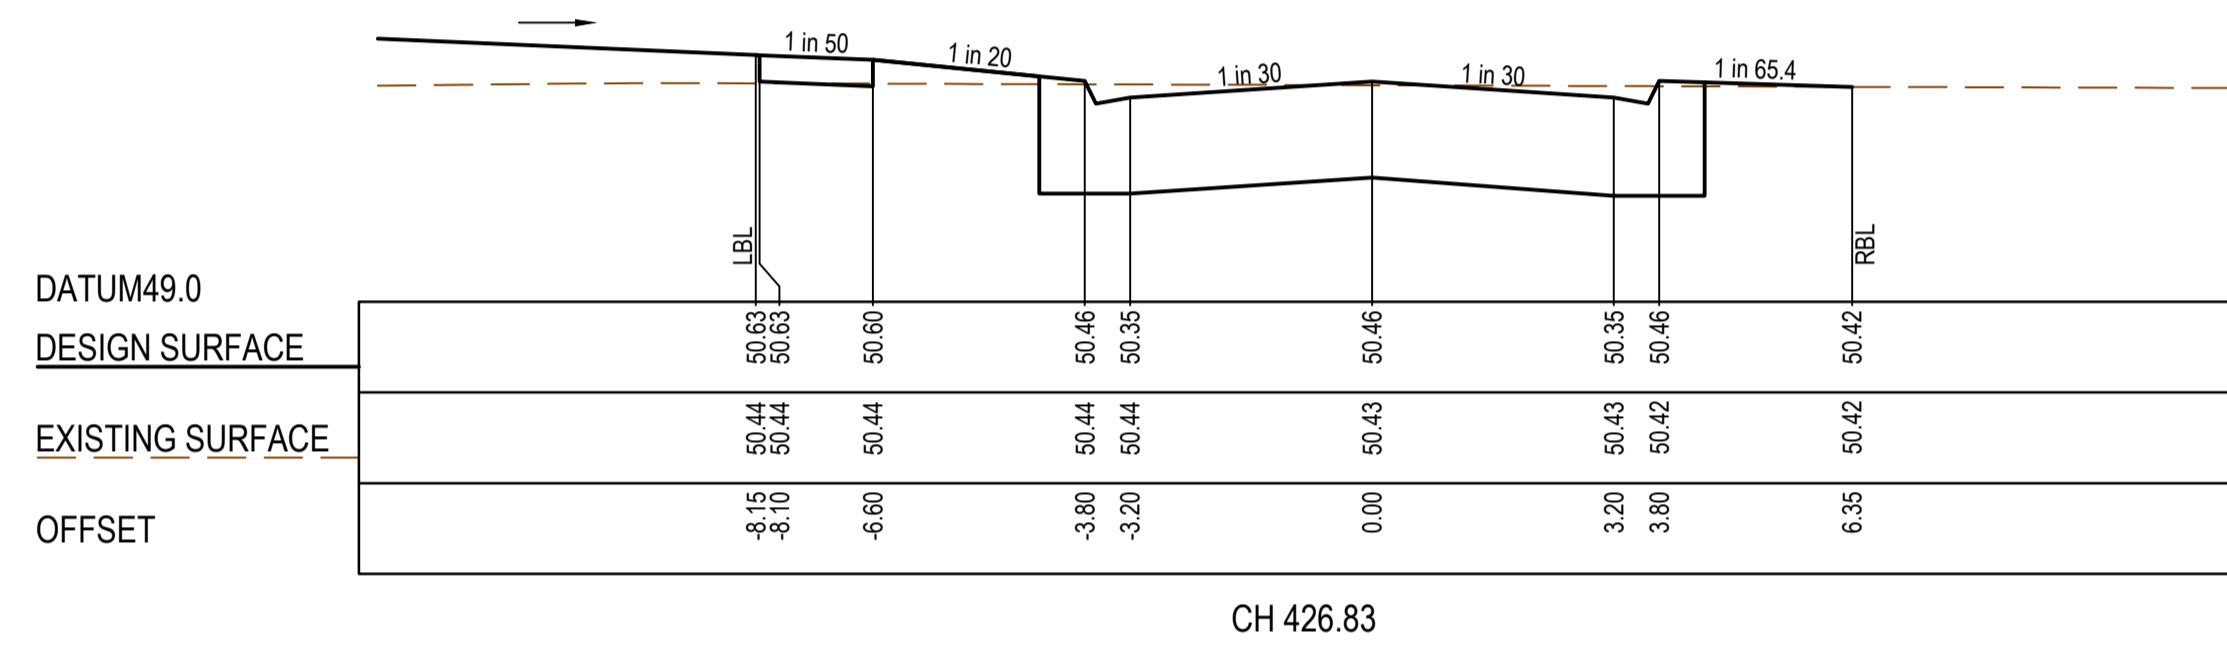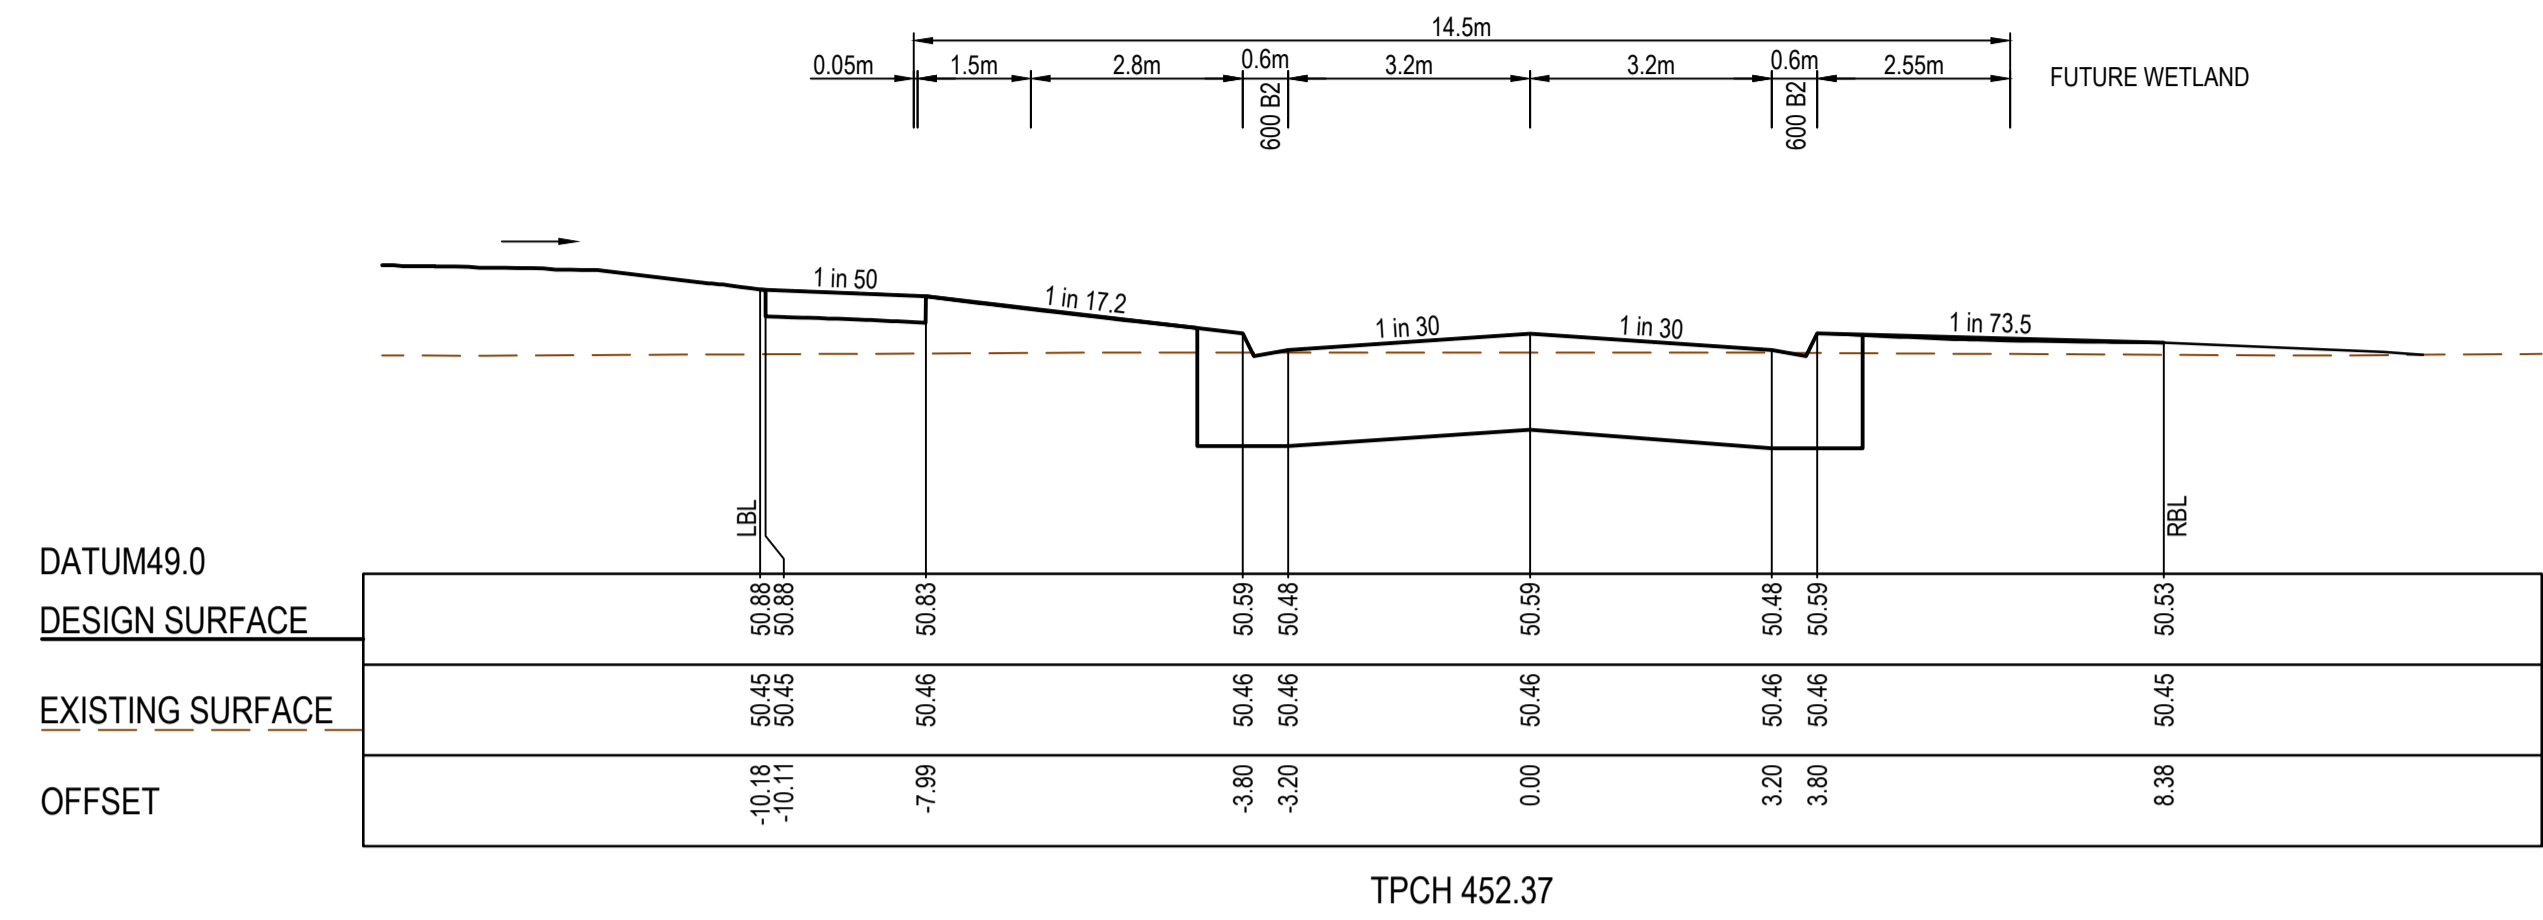

**AS CONSTRUCTED PLANS**


The purpose of these as-constructed plans is to update the design drawings to show significant changes which occurred during construction. Note that the levels shown on these plans are design levels, and have not been verified by survey. All information shown on these plans should be verified on site. SMEC Australia Pty Ltd accept no responsibility for loss or damages resulting from the inappropriate usage of these plans.

Quality Management ISO 9001  
 OHS Management AS/NZS 4500  
 Environmental Management ISO 14001  
 Global-Mark.com.au®

**AS CONSTRUCTED**

PLAN OF SUB. NO.  
PS900882T  
 PERMIT REF. NO.  
WYP10365/17.01

0 5 10 20  
Scale 1:500  
SCALE AS SHOWN AT A1

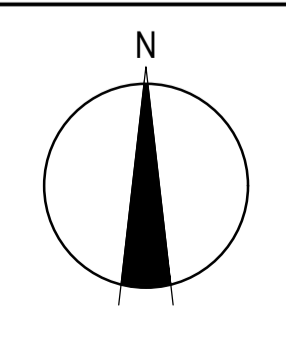



**SMEC**  
 Member of the Surlana Jurong Group  
 ABN 47 065 475 149  
 Collins Square, Tower 4, Level 20, 727 Collins St  
 Melbourne, VIC 3008  
 Ph 03 9514 1500

**GROWLAND**


Marigold - Stage 7  
 Wyndham City Council  
 Road and Drainage  
 Cross Sections: Recognition Avenue  
 Recognition Ave. Ch 387.50 - Ch 452.37

MELWAYS REF 359 F9	PROJECT / DRAWING No 2360E-007-257	SHEET No. 19 of 28	REVISION 1
-----------------------	---------------------------------------	-----------------------	---------------


STRUCTURAL FILL REQUIRED UNDER PAVEMENT AND FOOTPATHS WHERE CONSTRUCTED ABOVE EXISTING SURFACE

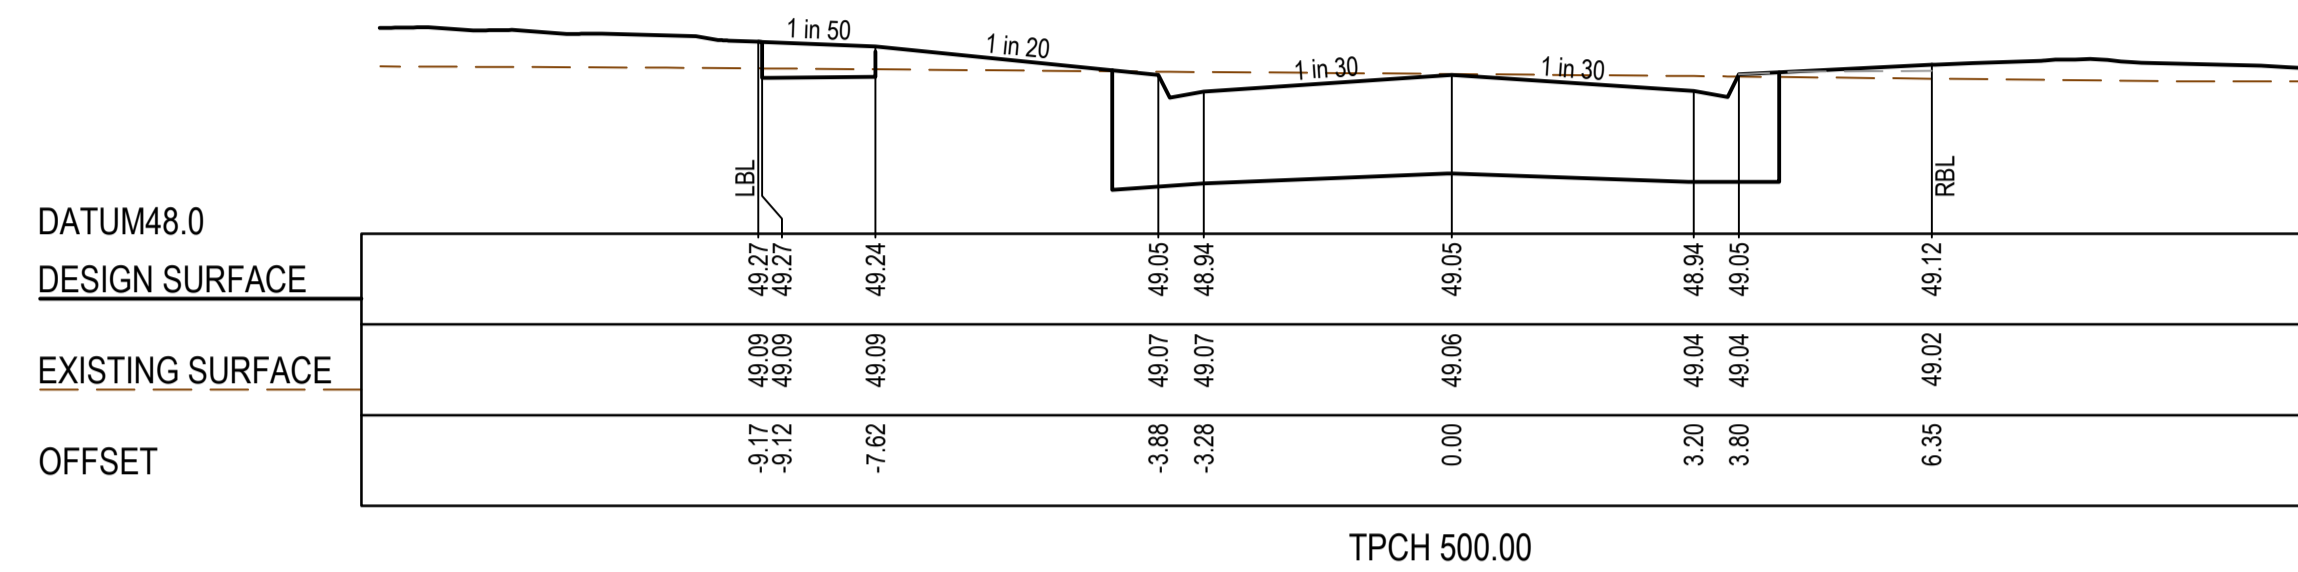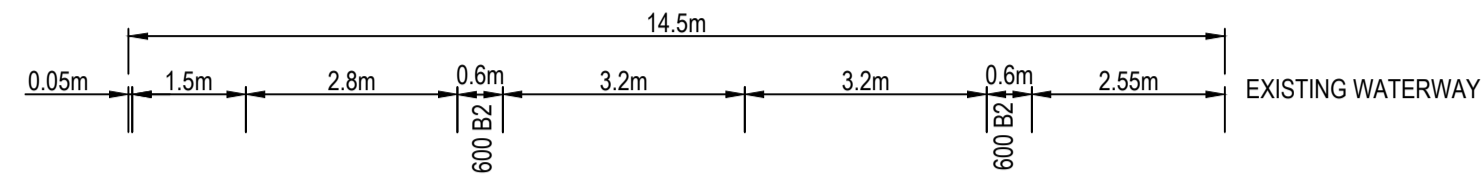

Waterway Q100 LEVEL: 47.36 RL

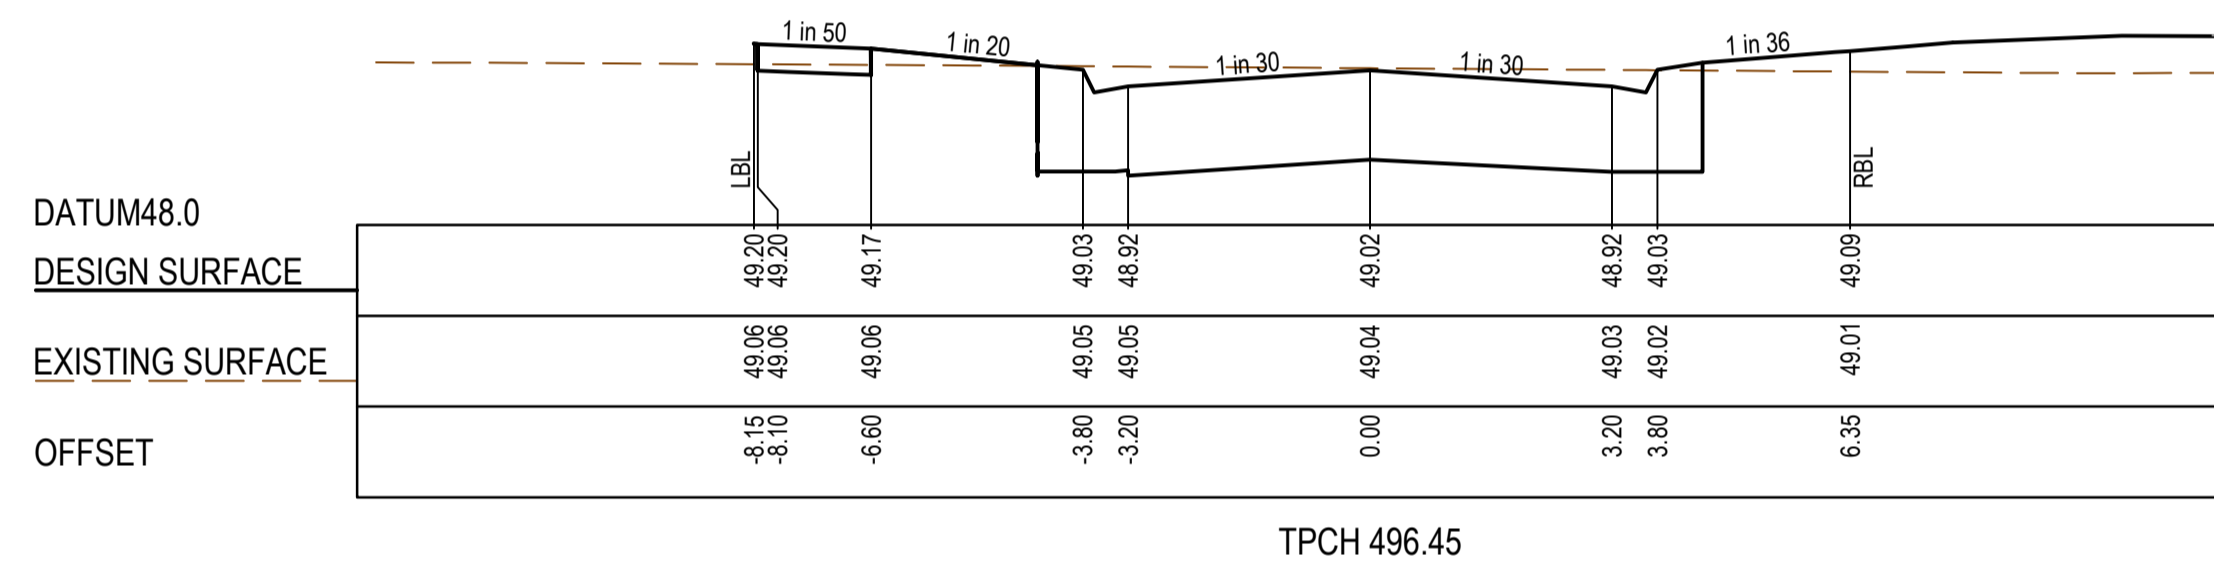

Waterway Q100 LEVEL: 47.35 RL

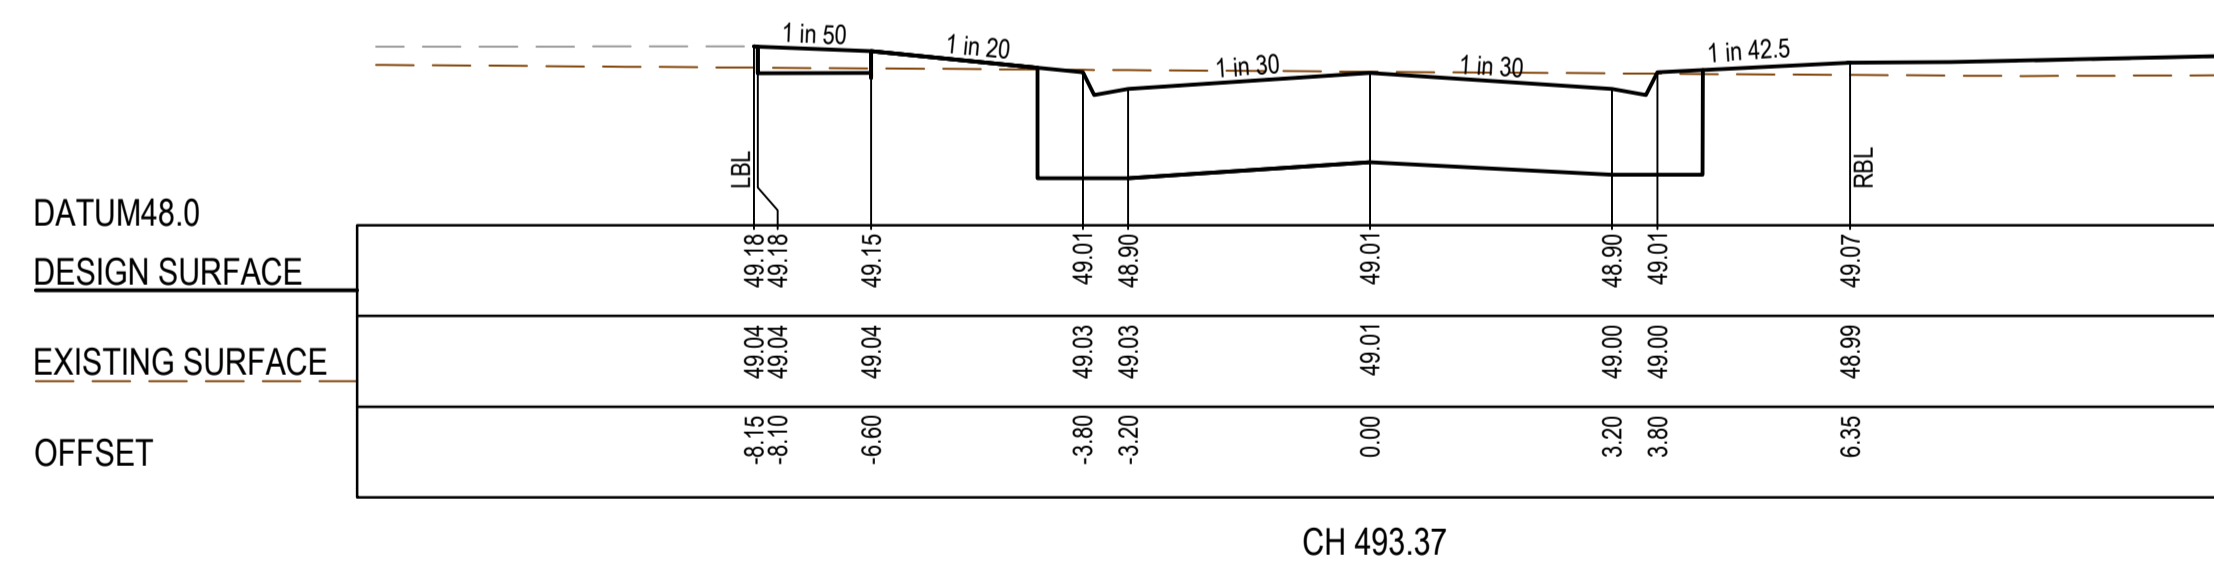

Waterway Q100 LEVEL: 47.29 RL




**AS CONSTRUCTED PLANS**

The purpose of these as-constructed plans is to update the design drawings to show significant changes which occurred during construction. Note that the levels shown on these plans are design levels, and have not been verified by survey. All information shown on these plans should be verified on site. SMEC Australia Pty Ltd accept no responsibility for loss or damages resulting from the inappropriate usage of these plans.



**AS CONSTRUCTED**





PLAN OF SUB. NO.  
PS900882T  
PERMIT REF. NO.  
WYP10365/17.01

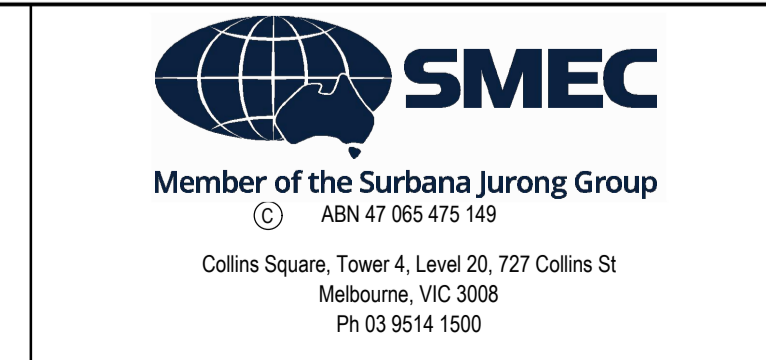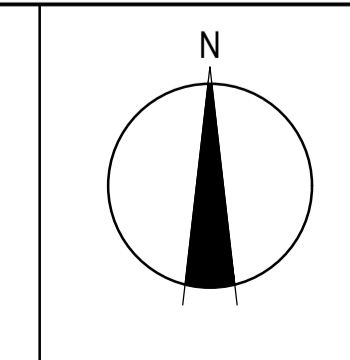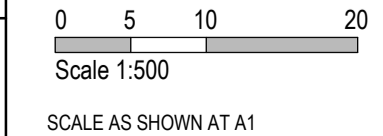

MELWAYS REF <b>359 F9</b>		PROJECT / DRAWING No. <b>2360E-007-258</b>		SHEET No. <b>20 of 28</b>	REVISION <b>1</b>
------------------------------	--	---	--	------------------------------	----------------------

Marigold - Stage 7  
Wyndham City Council  
Road and Drainage  
Cross Sections: Padma Boulevard  
Ch 493.365 - 500.00


**CRUSHED ROCK BACKFILL**  
 CRB INDICATES CRUSHED ROCK BACKFILL COMPACTED IN ACCORDANCE WITH COUNCIL STANDARDS & SPECIFICATIONS, CLASS 3 UNLESS SPECIFIED OTHERWISE

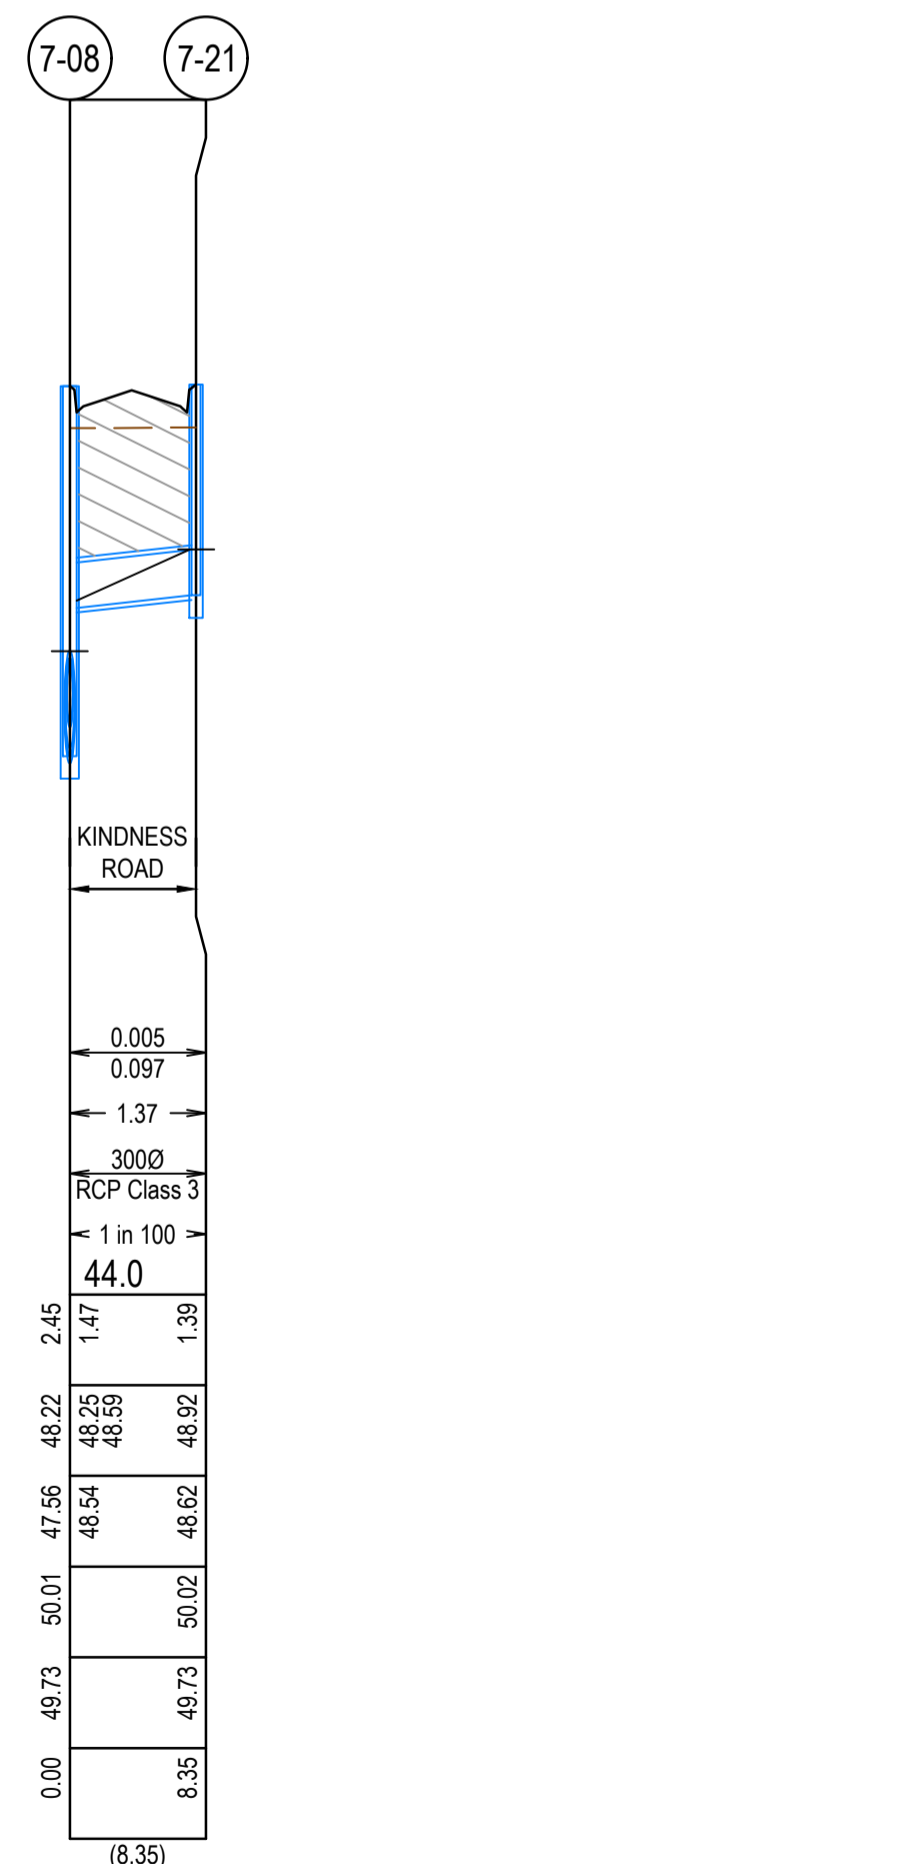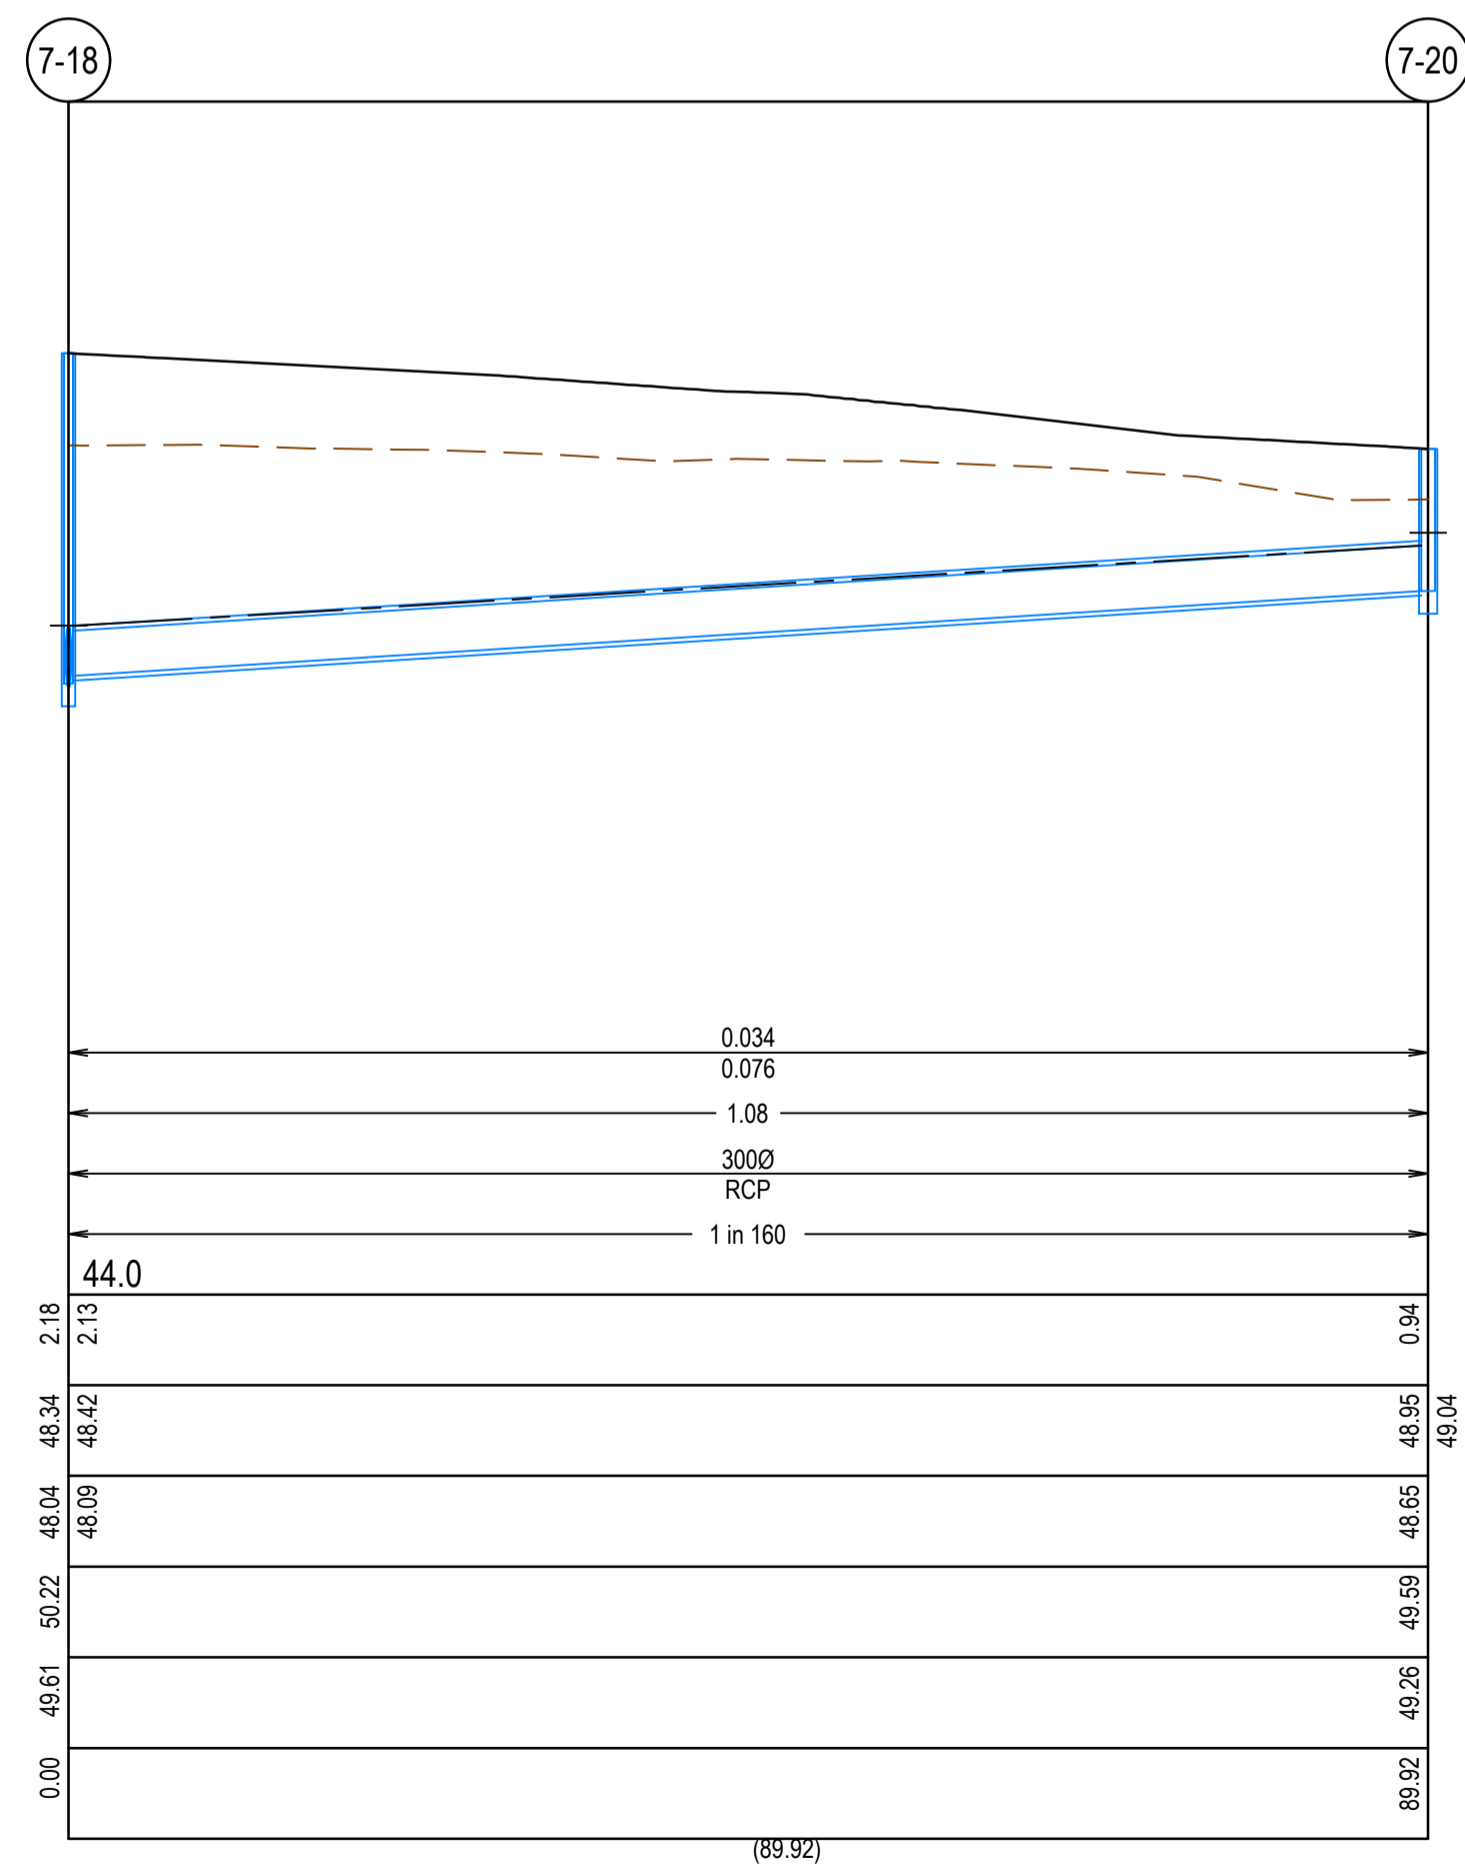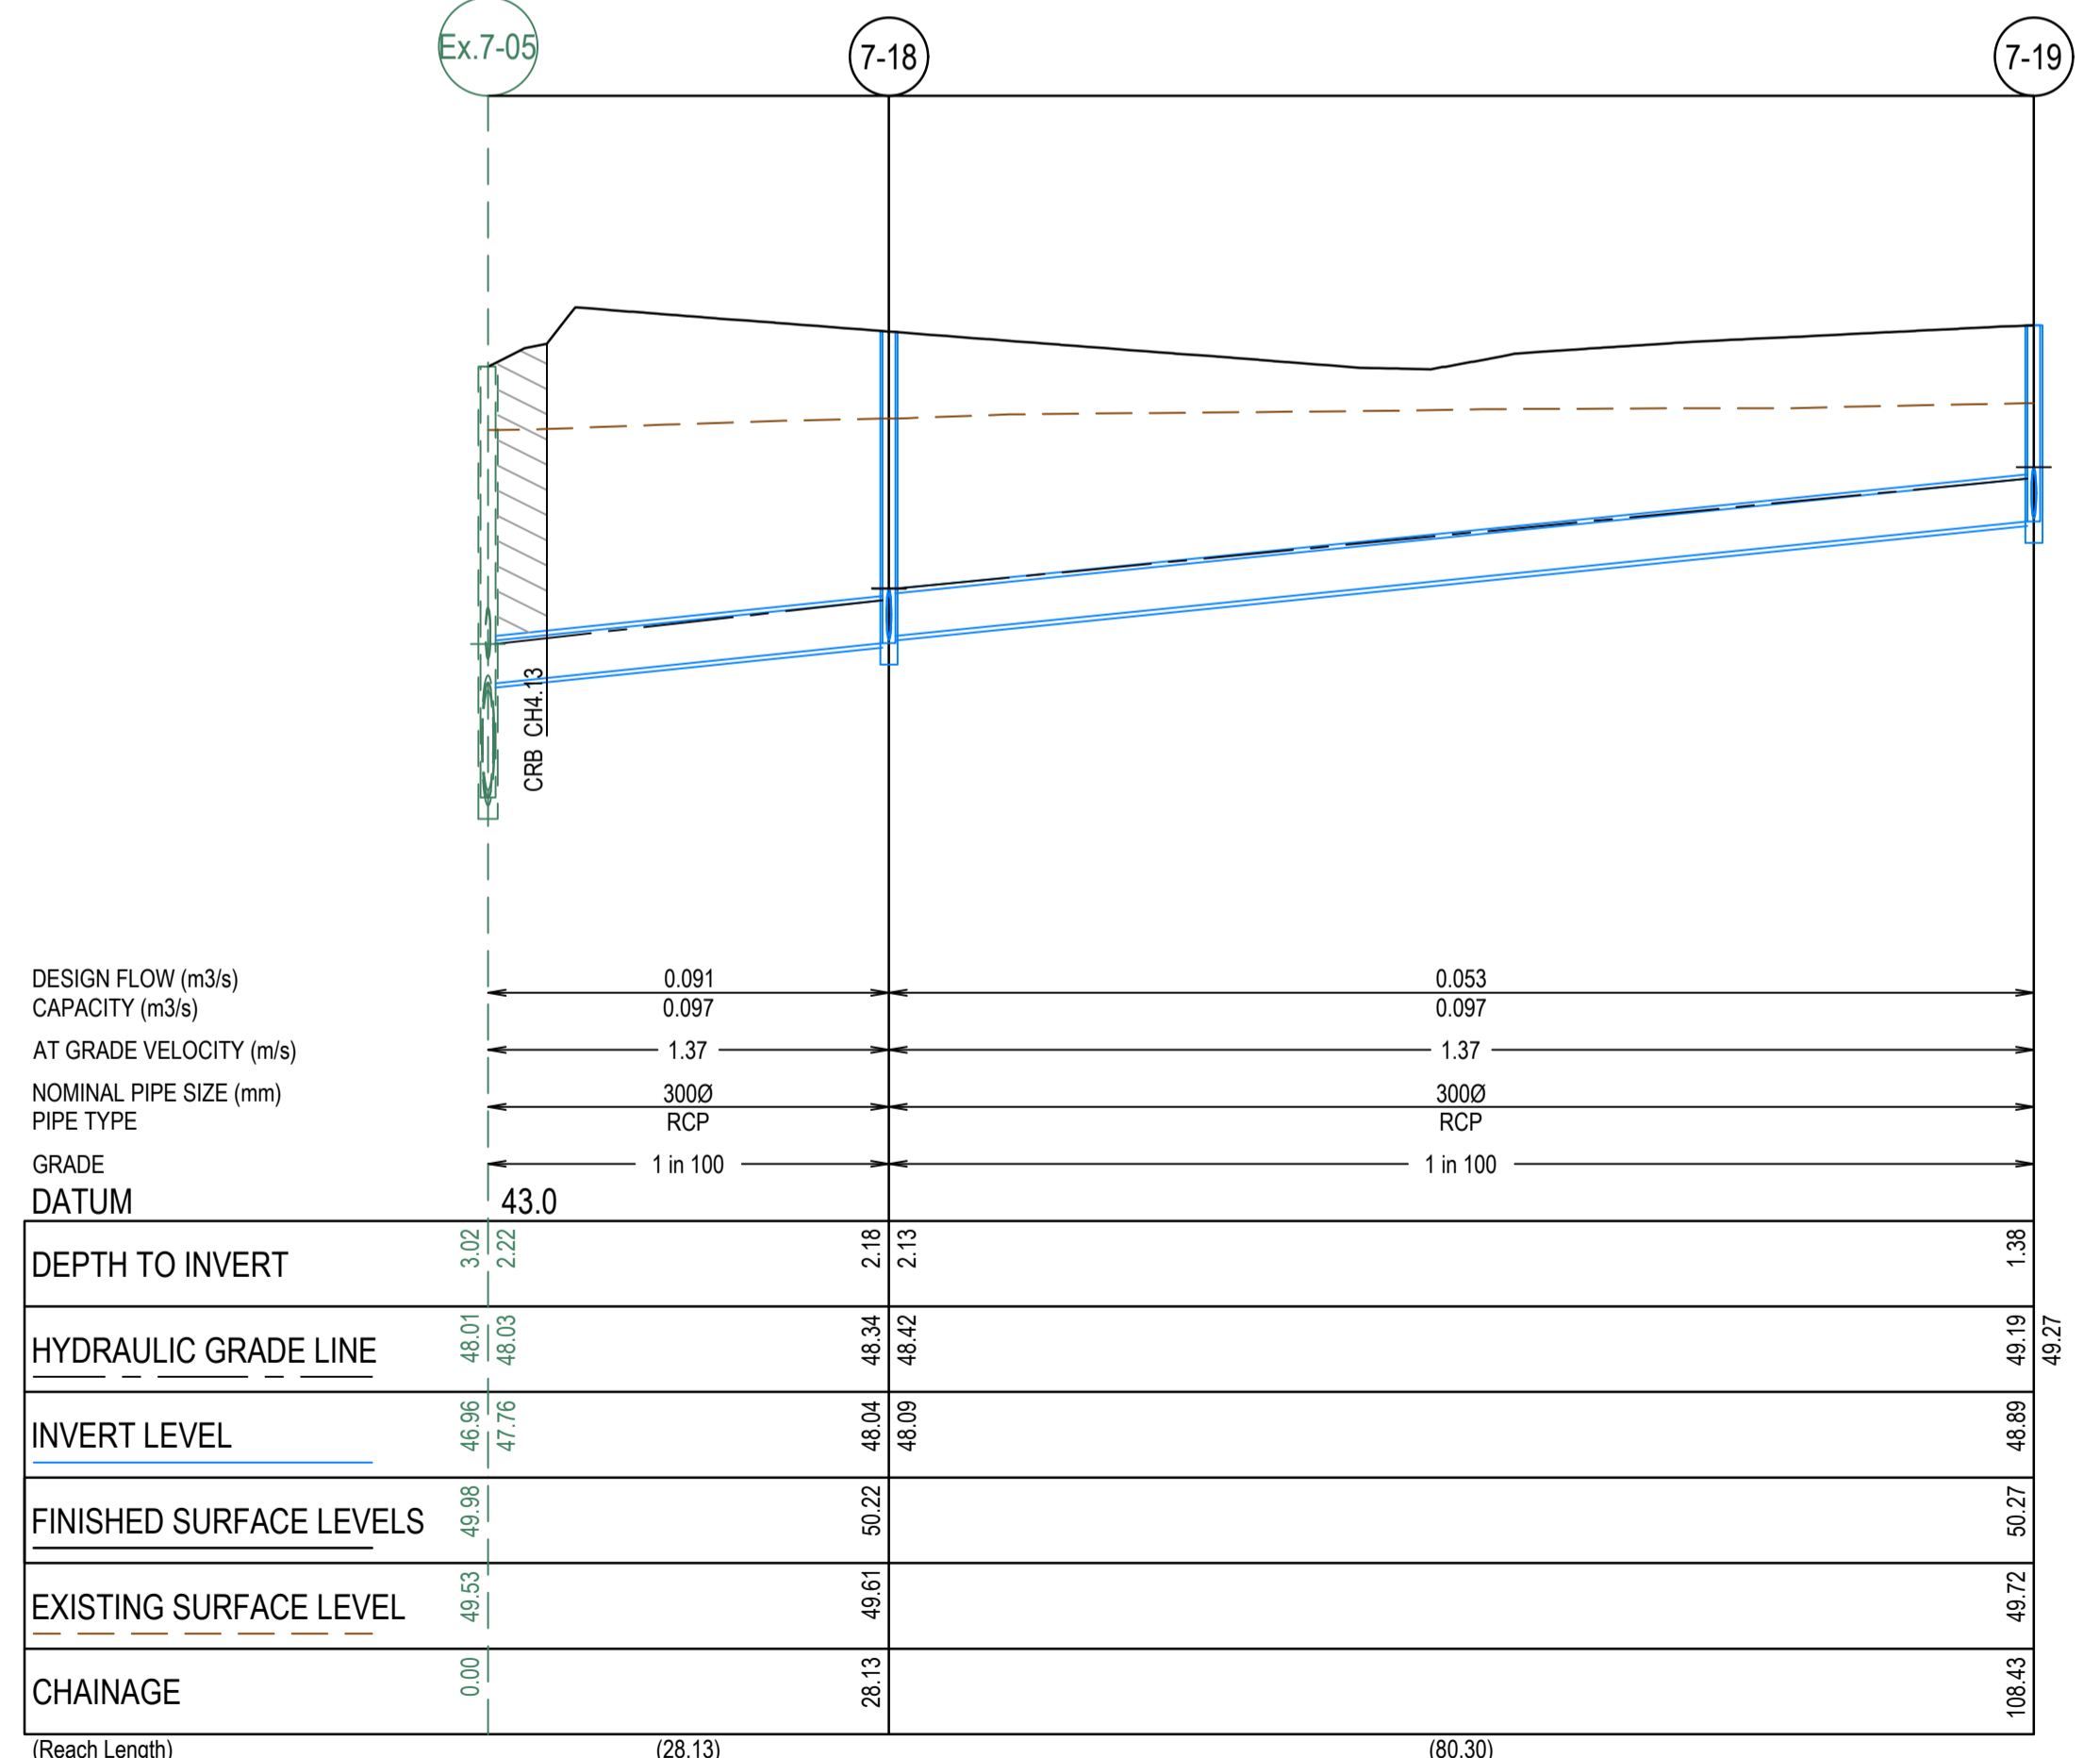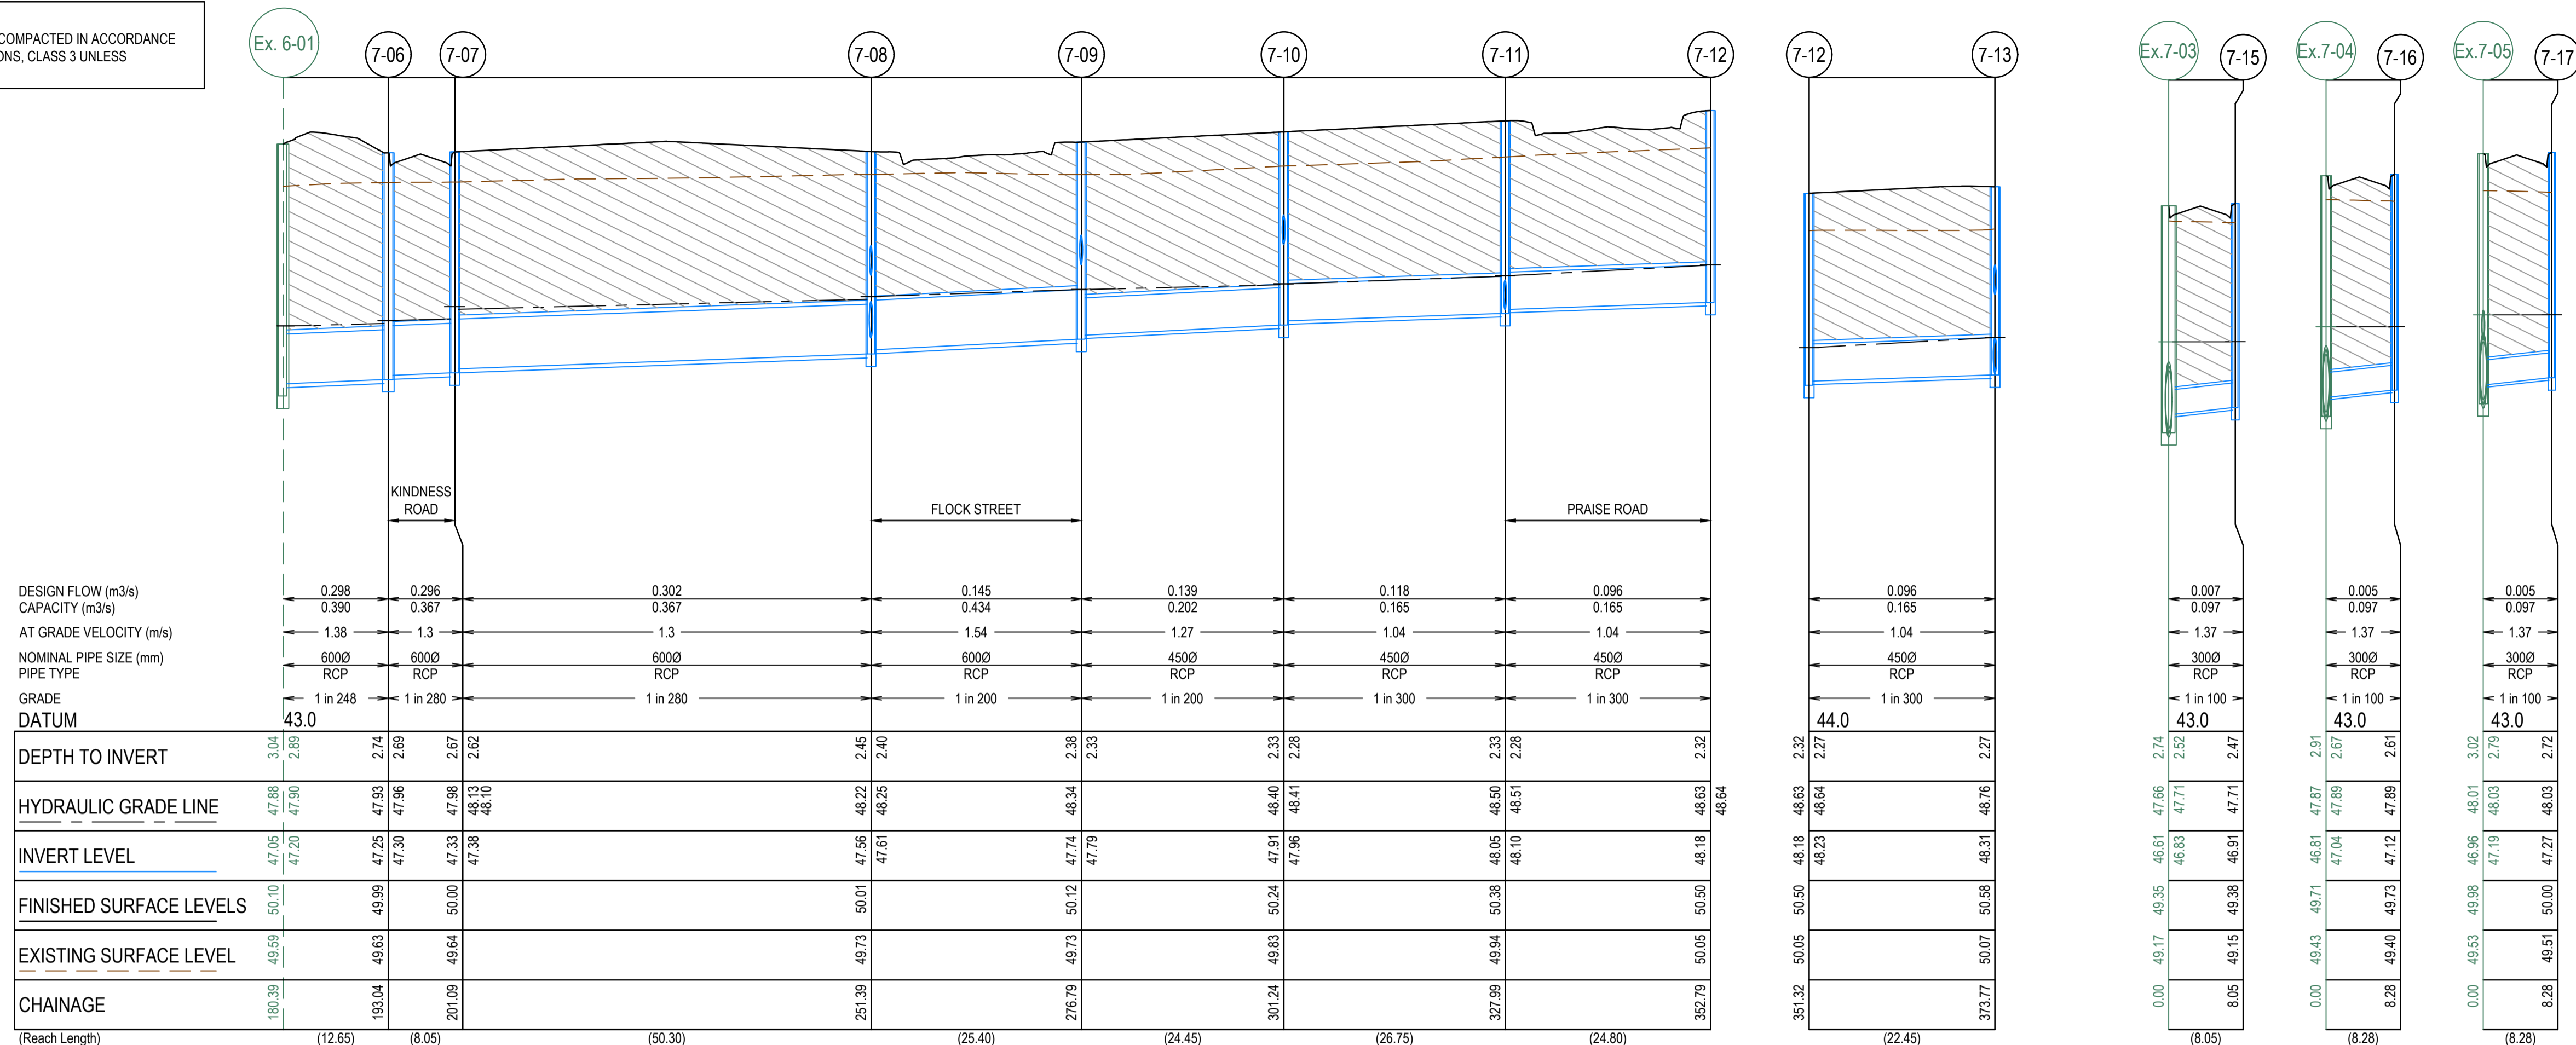

**AS CONSTRUCTED PLANS**

The purpose of these as-constructed plans is to update the design drawings to show significant changes which occurred during construction. Note that the levels shown on these plans are design levels, and have not been verified by survey. All information shown on these plans should be verified on site. SMEC Australia Pty Ltd accept no responsibility for loss or damages resulting from the inappropriate usage of these plans.

PLAN OF SUB. NO. PS900882T  
 PERMIT REF. NO. WYP10365/17.01  
**AS CONSTRUCTED**






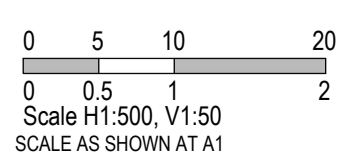


Member of the Surlana Jurong Group  
 Collins Square, Tower 4, Level 20, 727 Collins St  
 Melbourne, VIC 3008  
 Ph 03 9514 1500

Marigold - Stage 7  
 Wyndham City Council  
 Road and Drainage  
 Drainage Longitudinal Sections - 1

MELWAYS REF	PROJECT / DRAWING No	SHEET No	REVISION
359 F9	2360E-007-301	21 of 28	2


**CRUSHED ROCK BACKFILL**  
 CRB INDICATES CRUSHED ROCK BACKFILL COMPACTED IN ACCORDANCE WITH COUNCIL STANDARDS & SPECIFICATIONS, CLASS 3 UNLESS SPECIFIED OTHERWISE

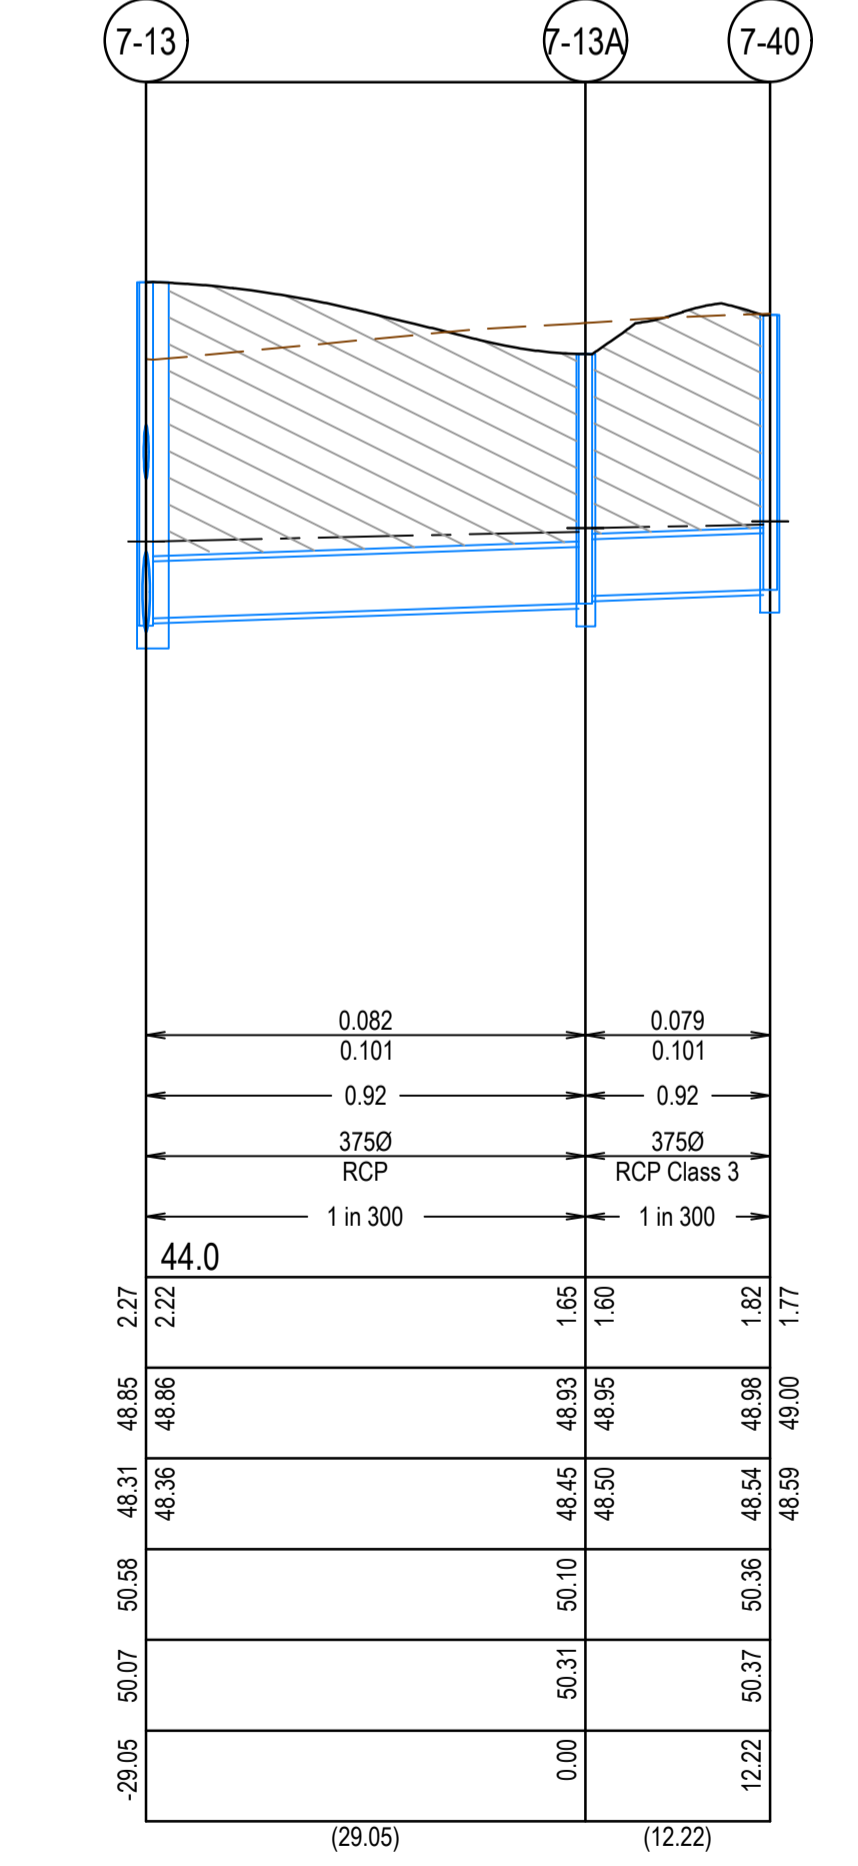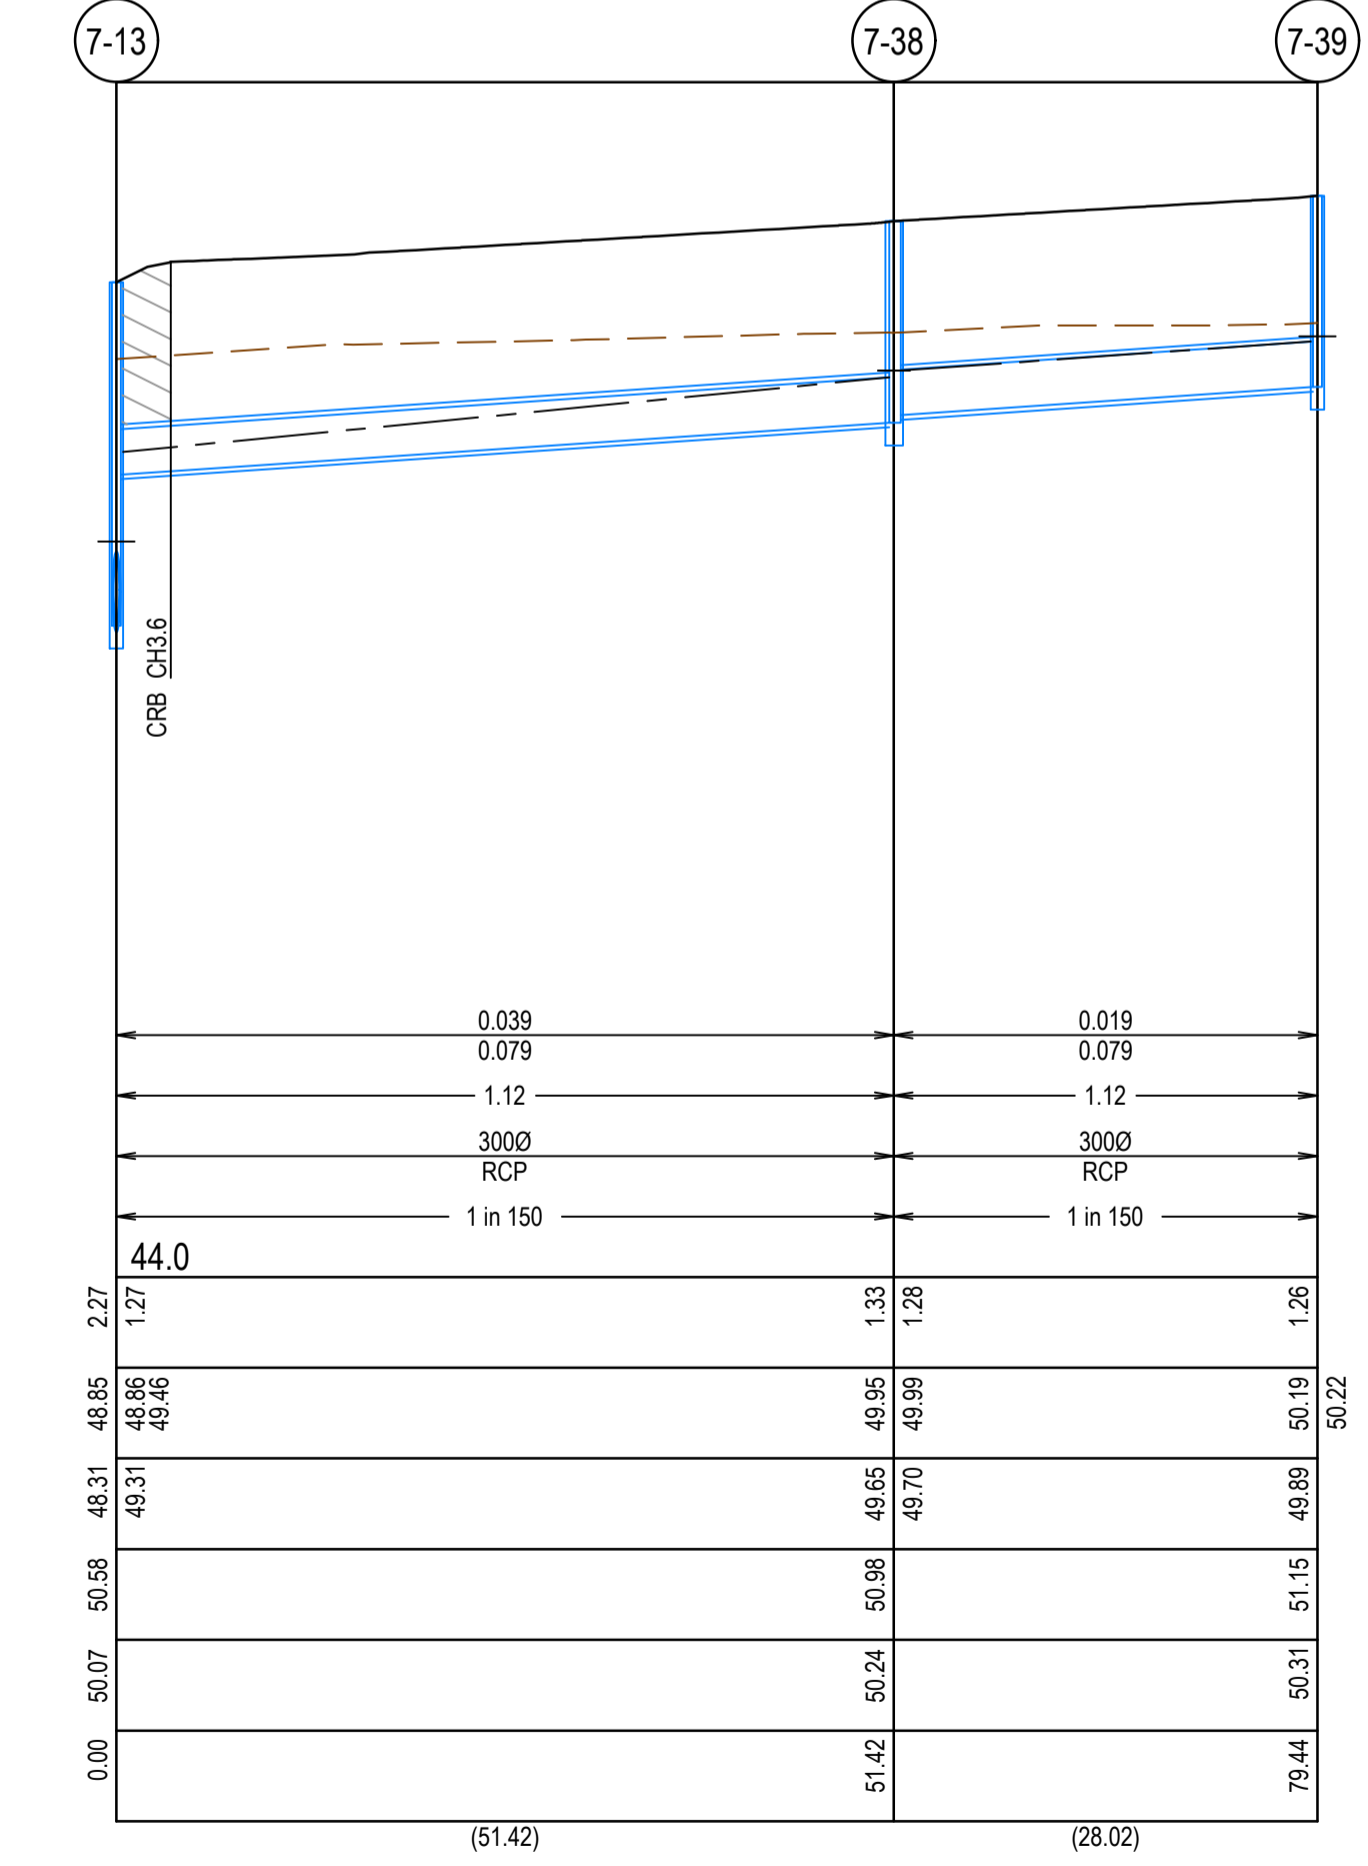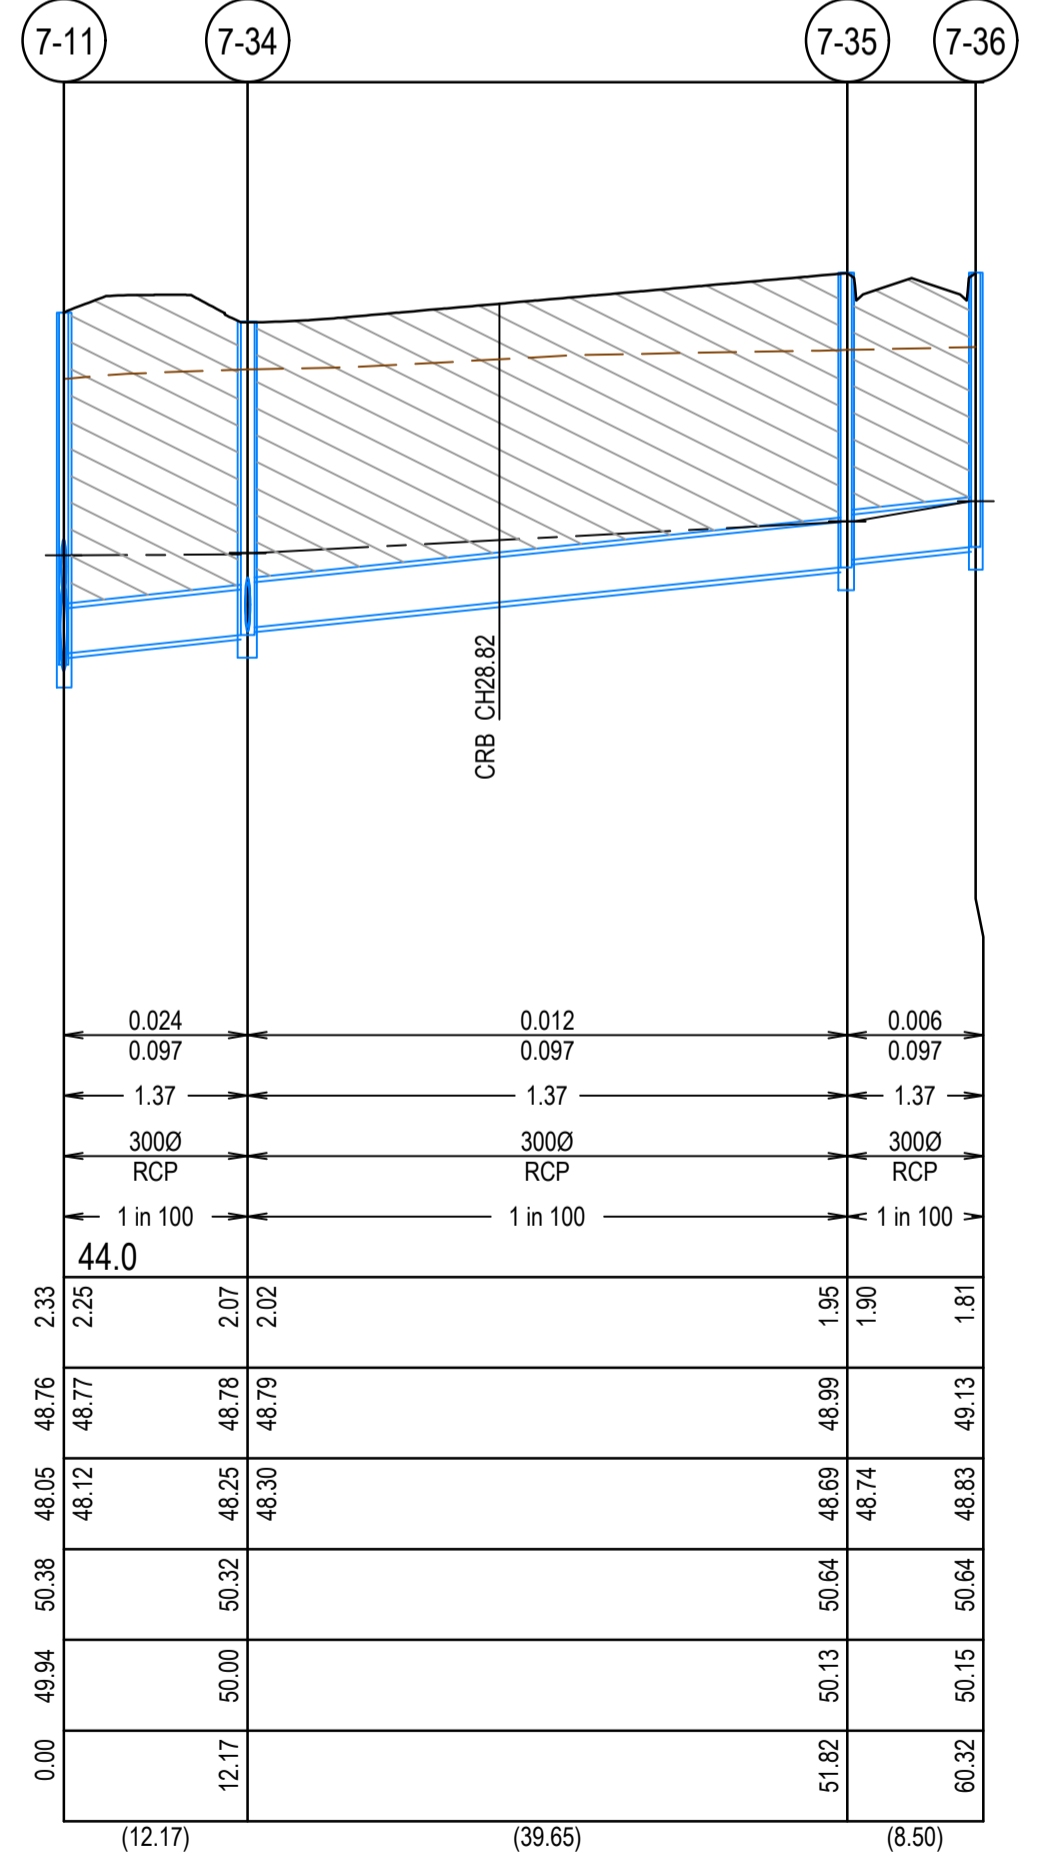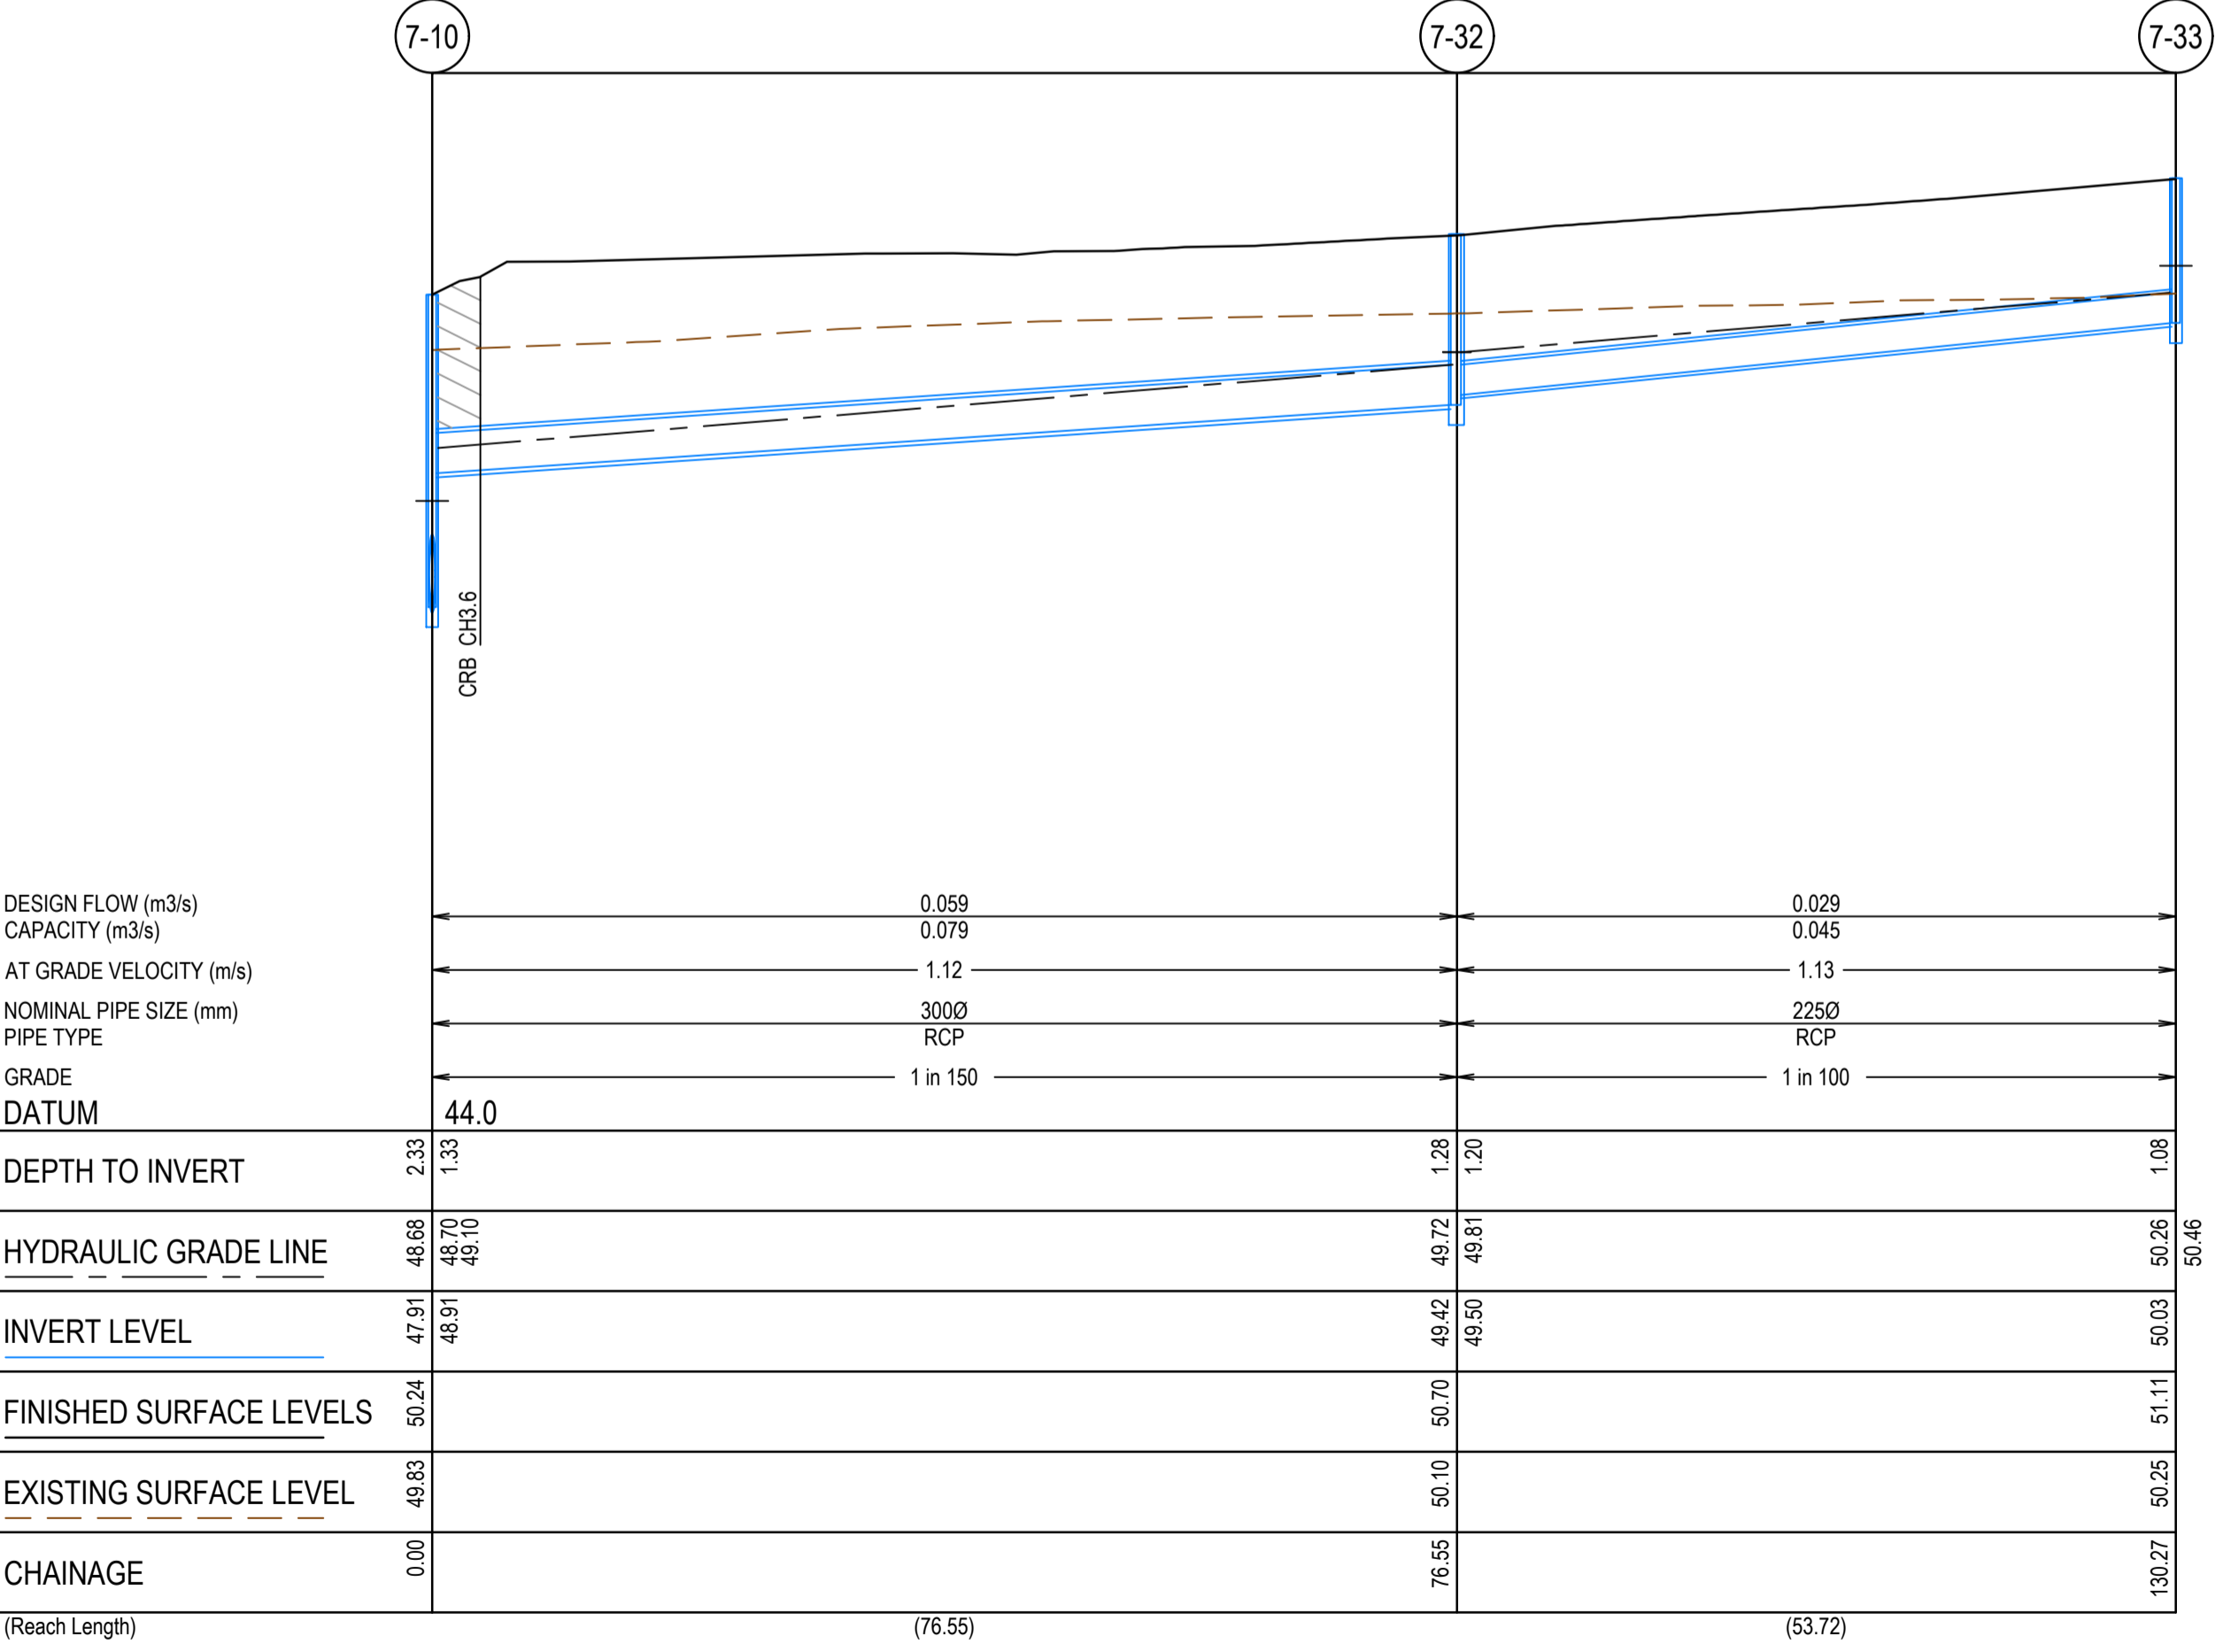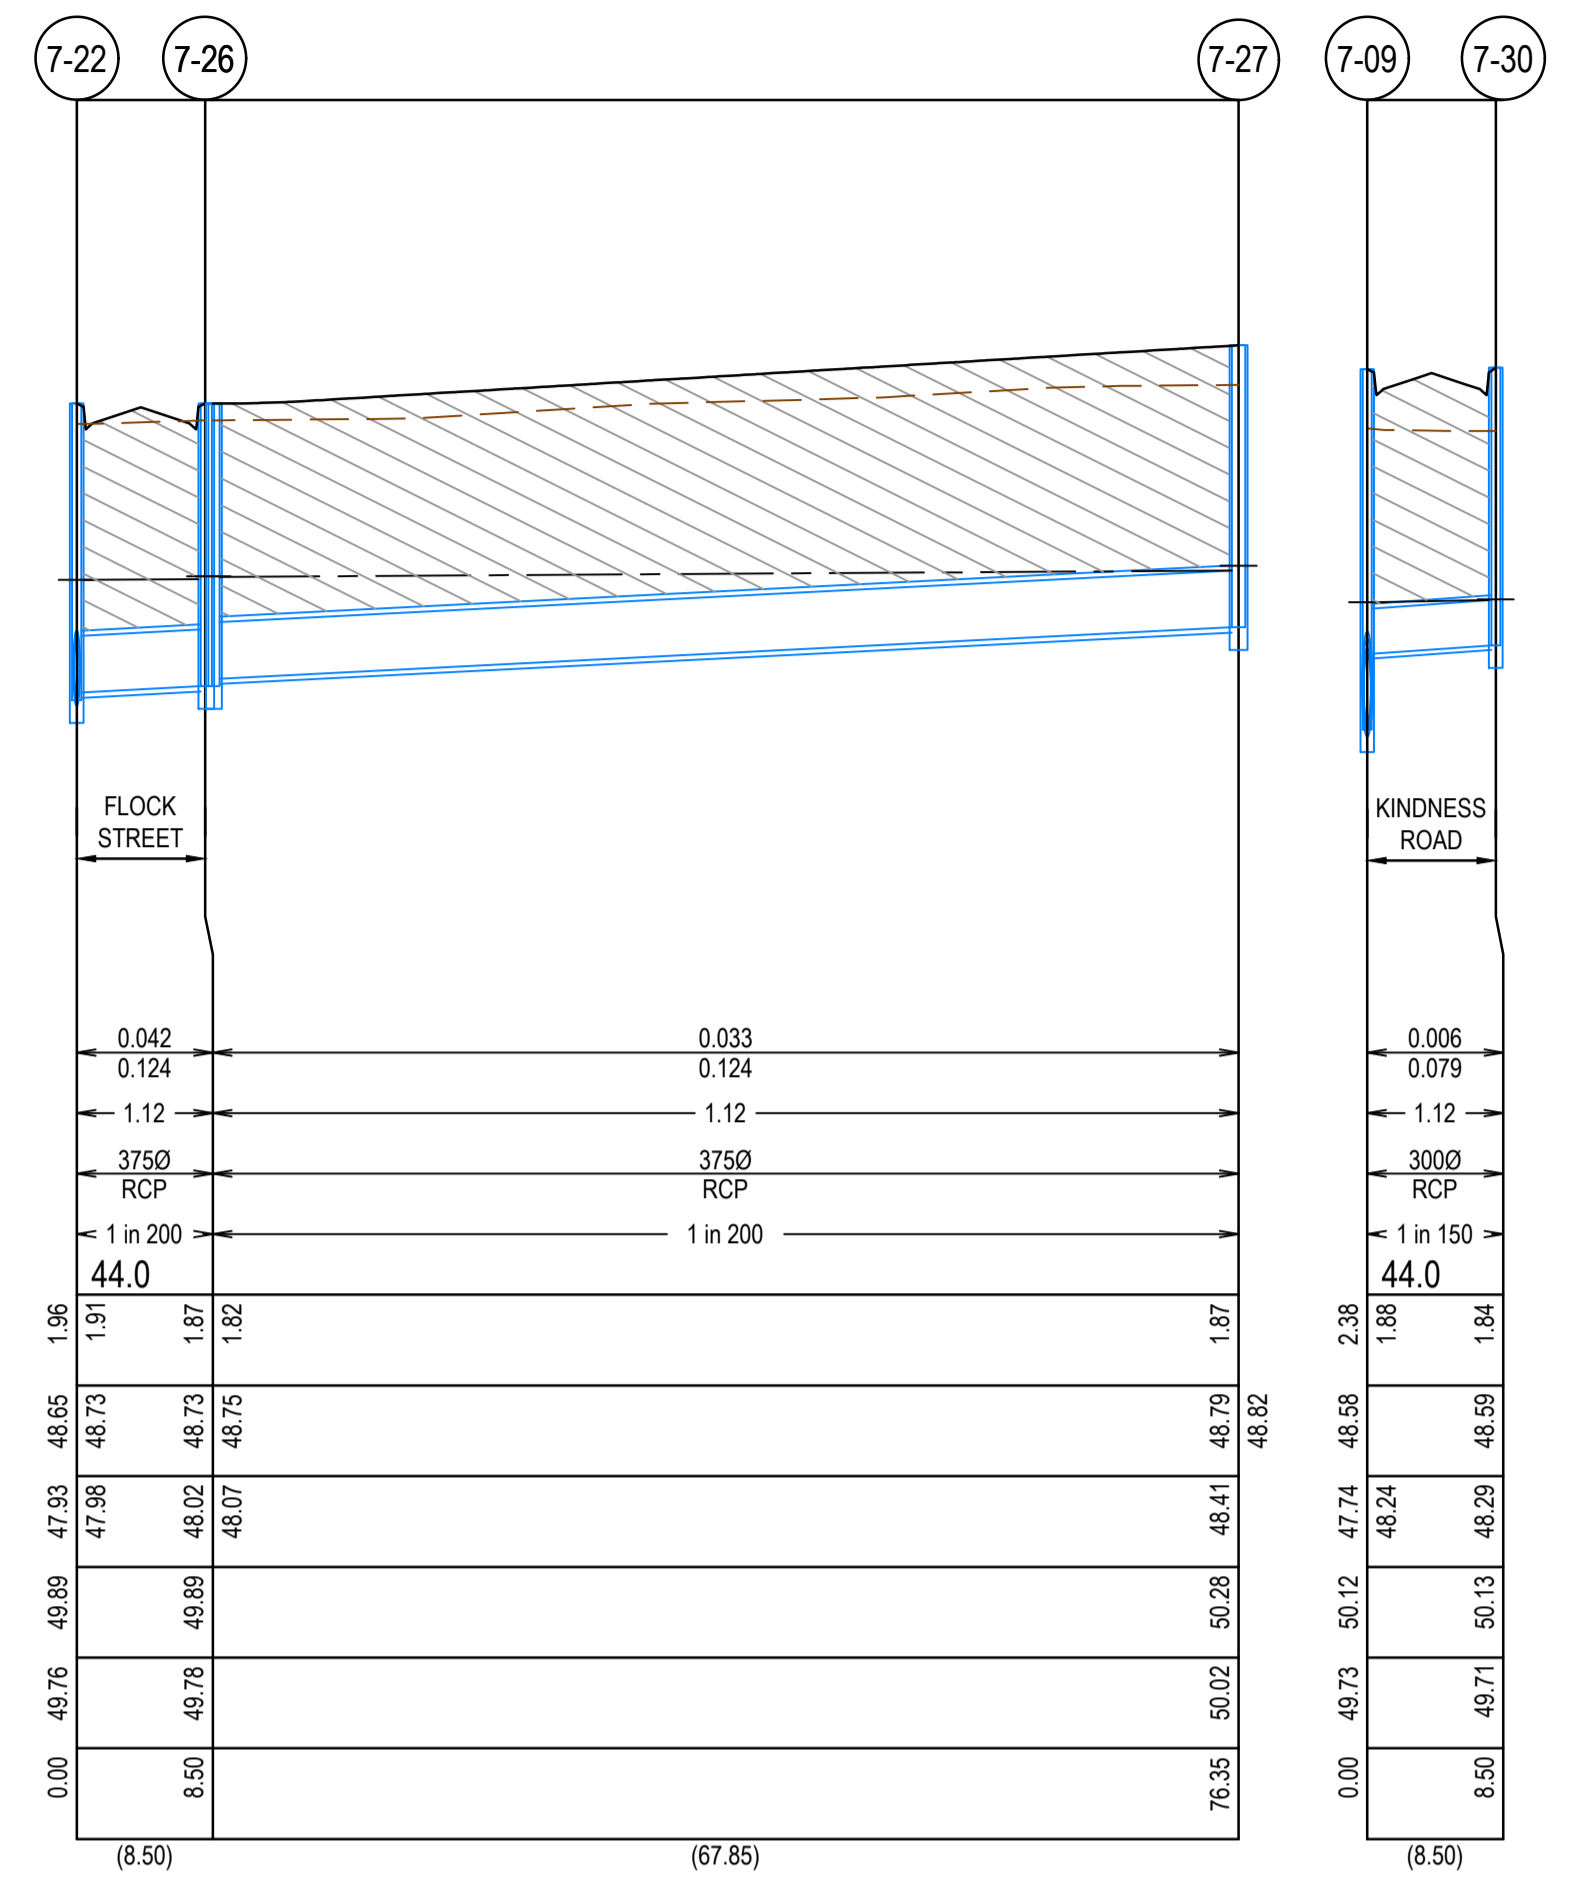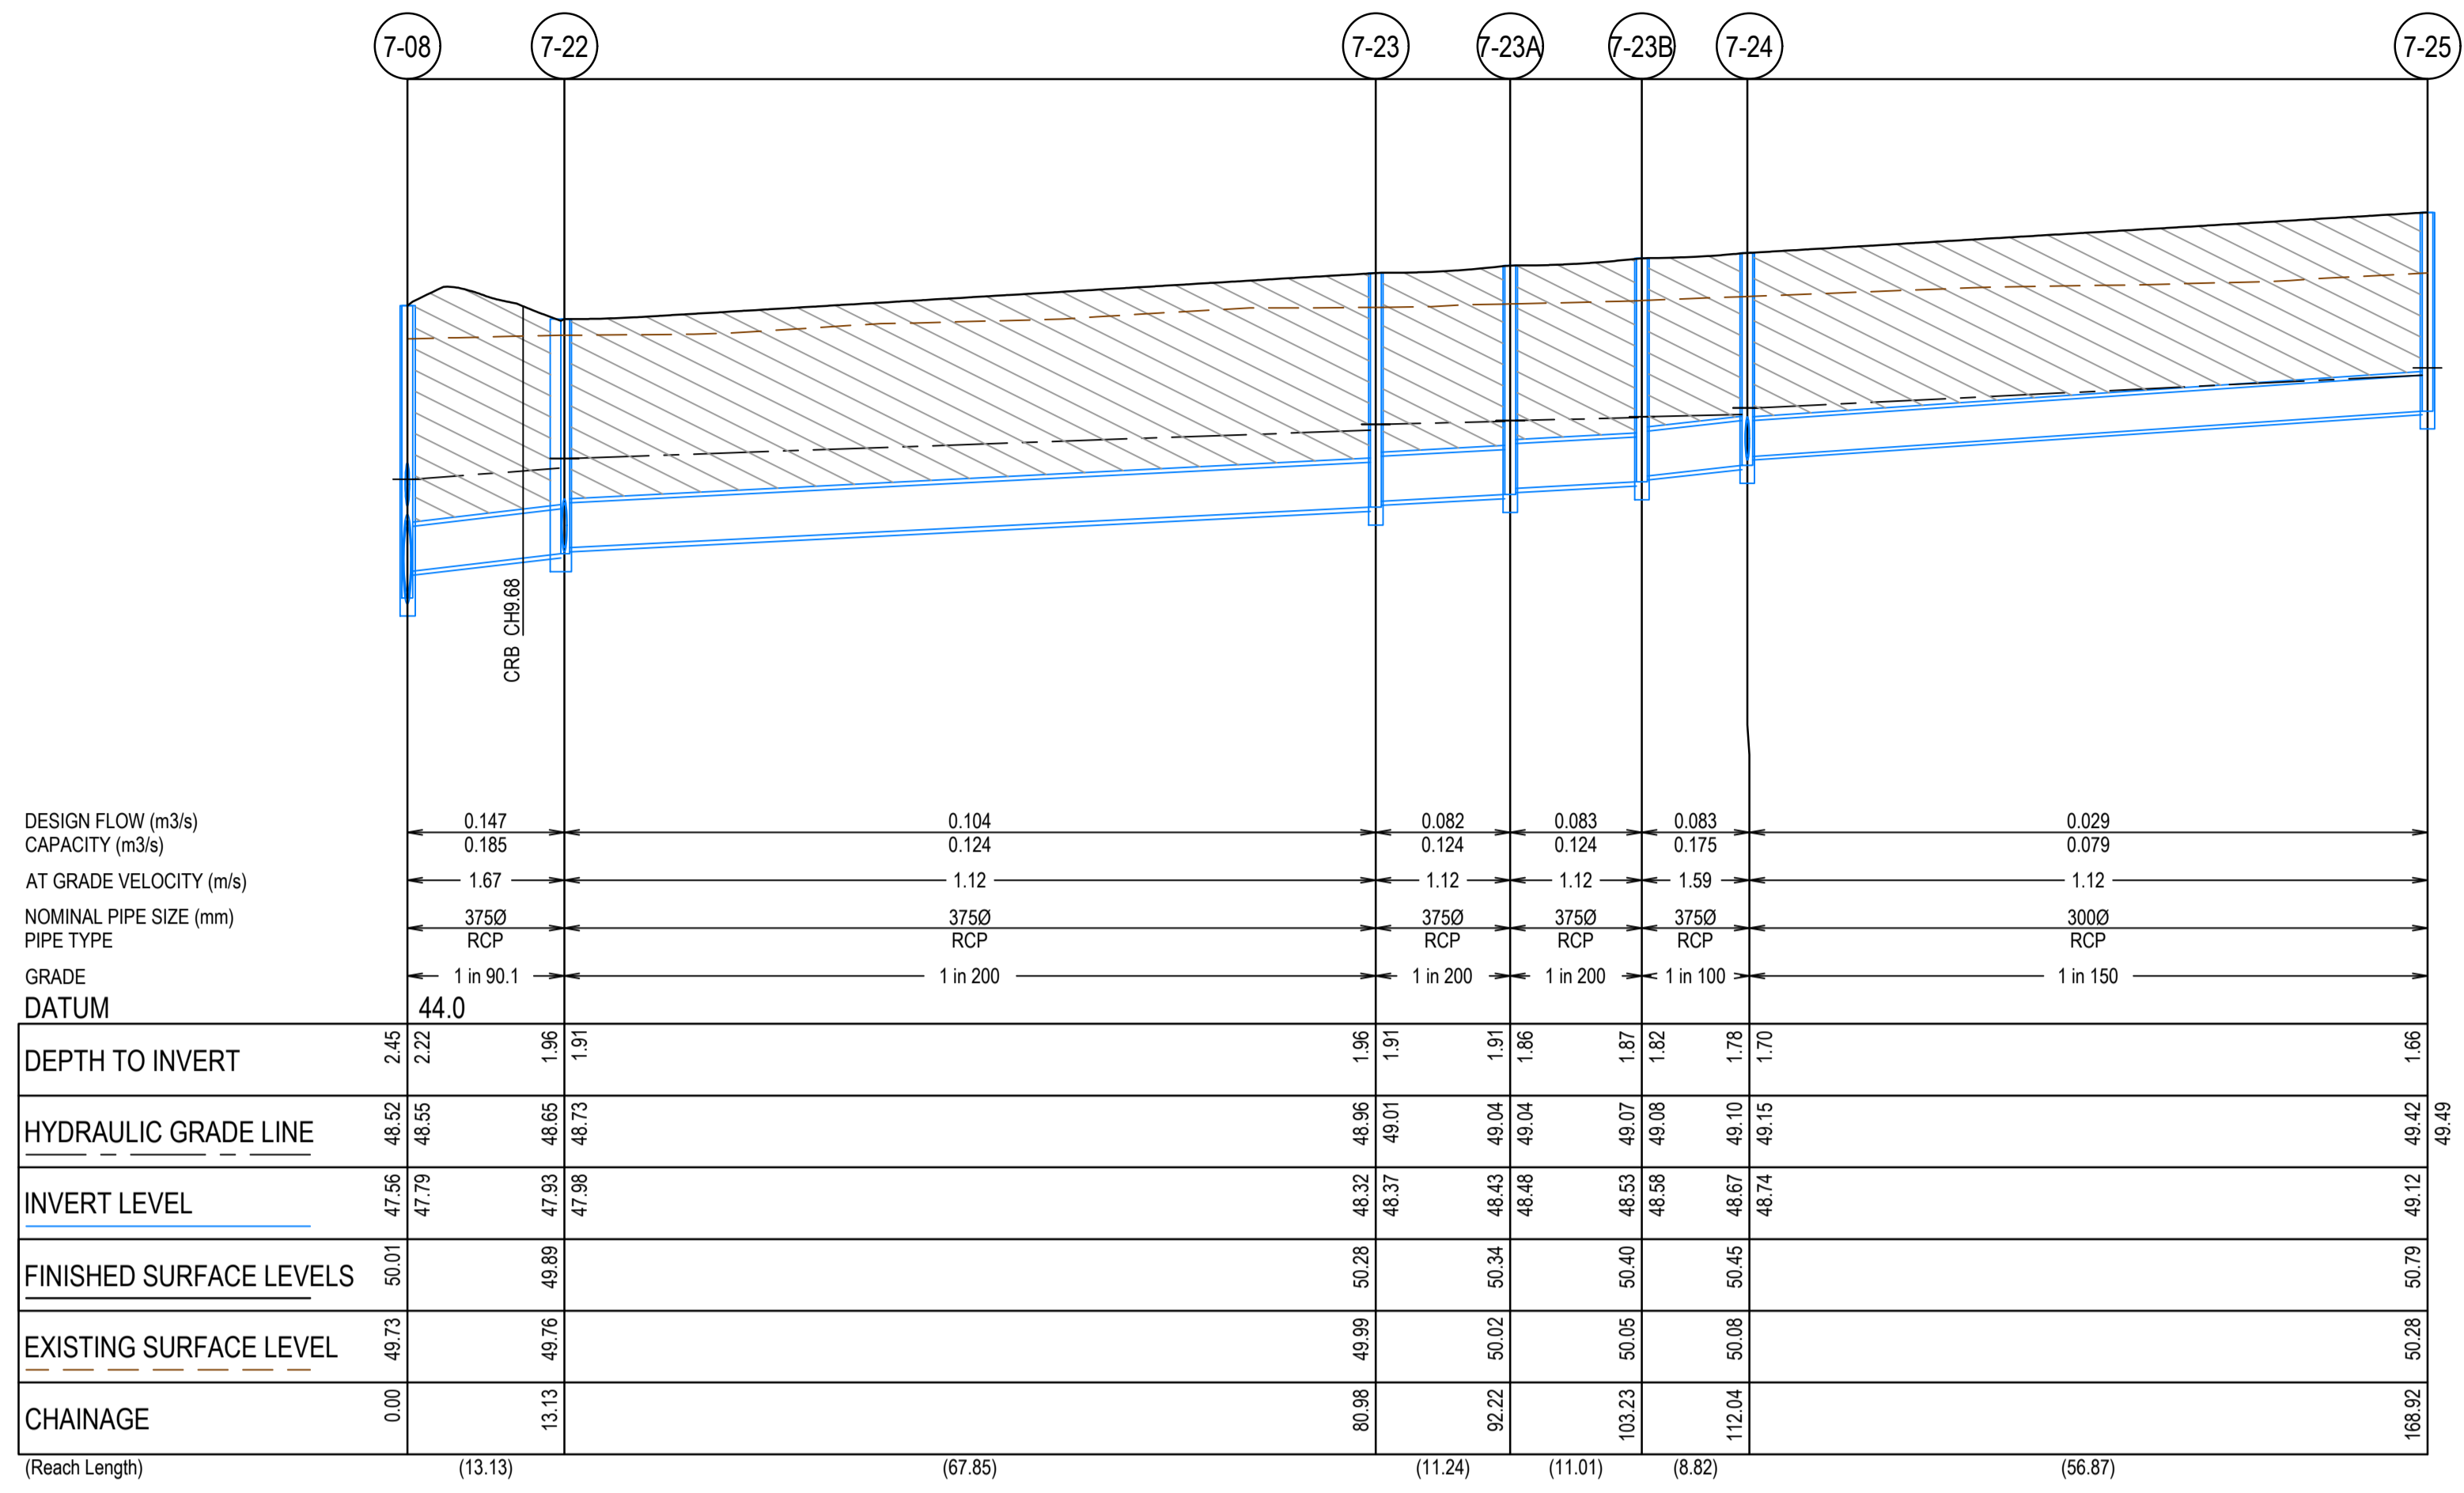

**AS CONSTRUCTED PLANS**

The purpose of these as-constructed plans is to update the design drawings to show significant changes which occurred during construction. Note that the levels shown on these plans are design levels, and have not been verified by survey. All information shown on these plans should be verified on site. SMEC Australia Pty Ltd accept no responsibility for loss or damages resulting from the inappropriate usage of these plans.



PLAN OF SUB. NO. PS900882T  
 PERMIT REF. NO. WYP10365/17.01  
**AS CONSTRUCTED**

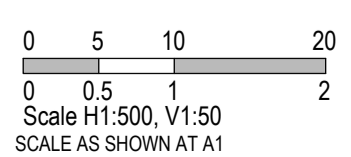

Member of the Surlana Jurong Group  
 Collins Square, Tower 4, Level 20, 727 Collins St  
 Melbourne, VIC 3008  
 Ph 03 9514 1500

Marigold - Stage 7  
 Wyndham City Council  
 Road and Drainage  
 Drainage Longitudinal Sections - 2

MELWAYS REF	PROJECT / DRAWING No	SHEET No	REVISION
359 F9	2360E-007-302	22 of 28	1

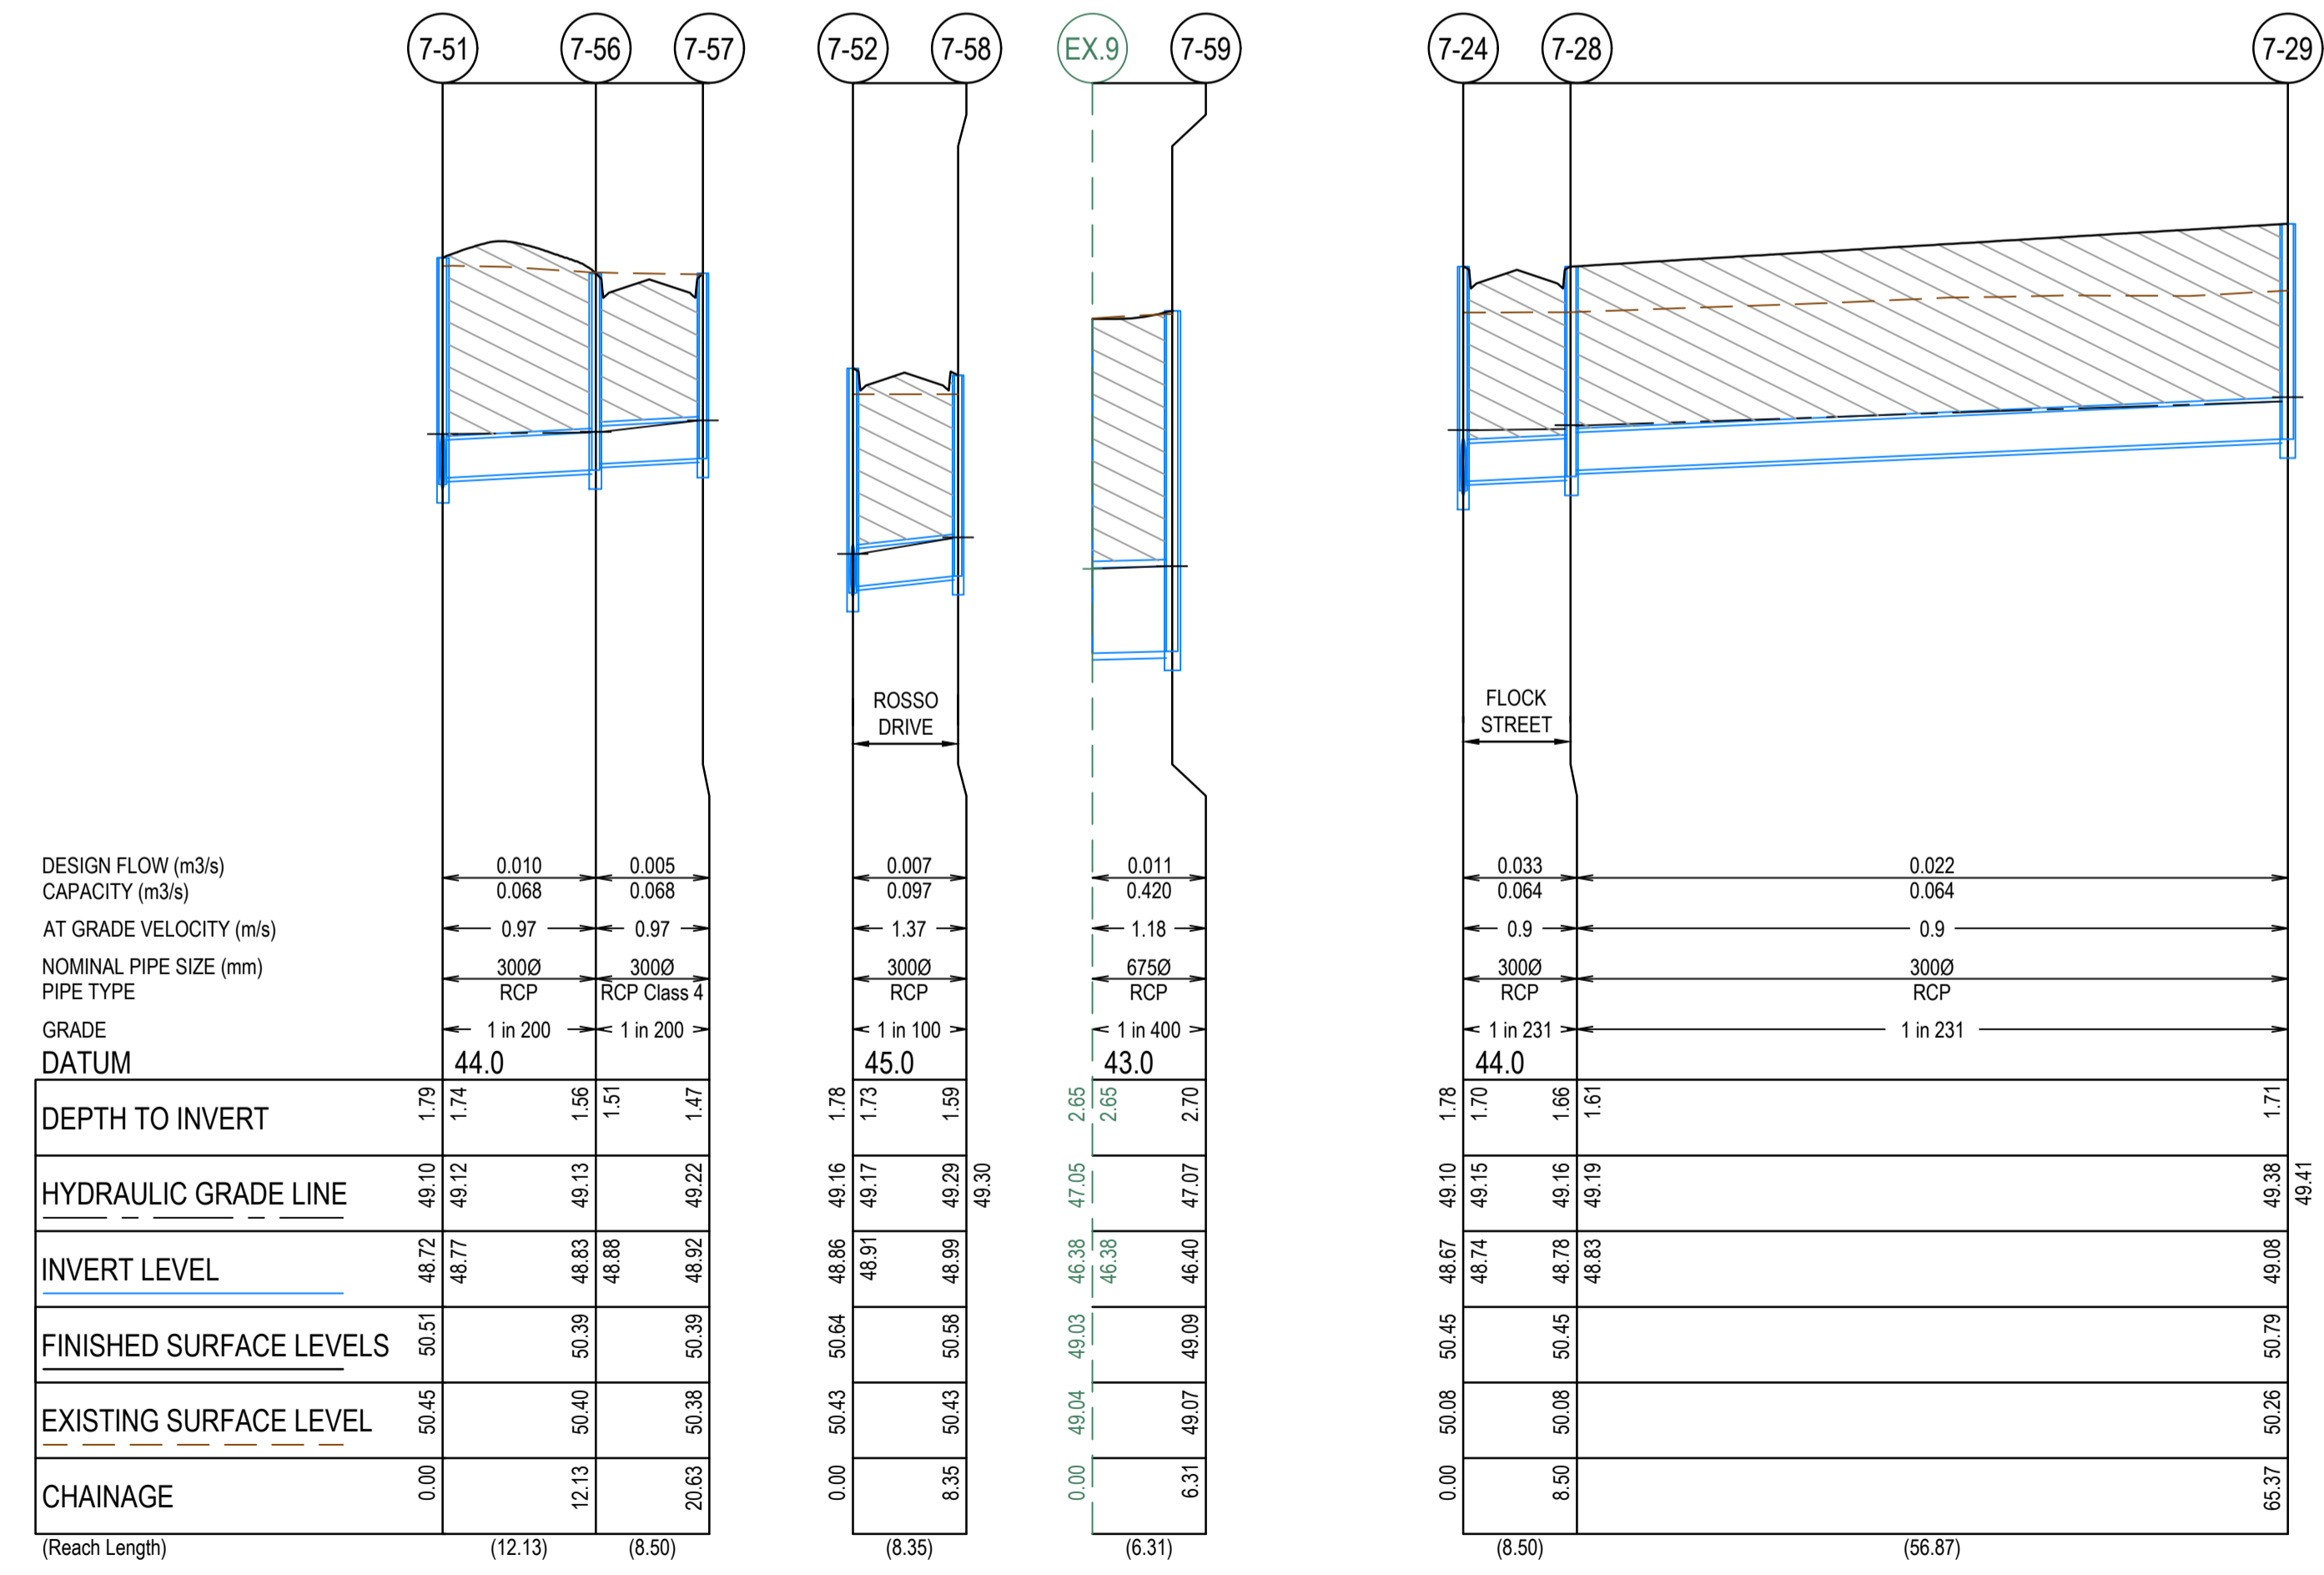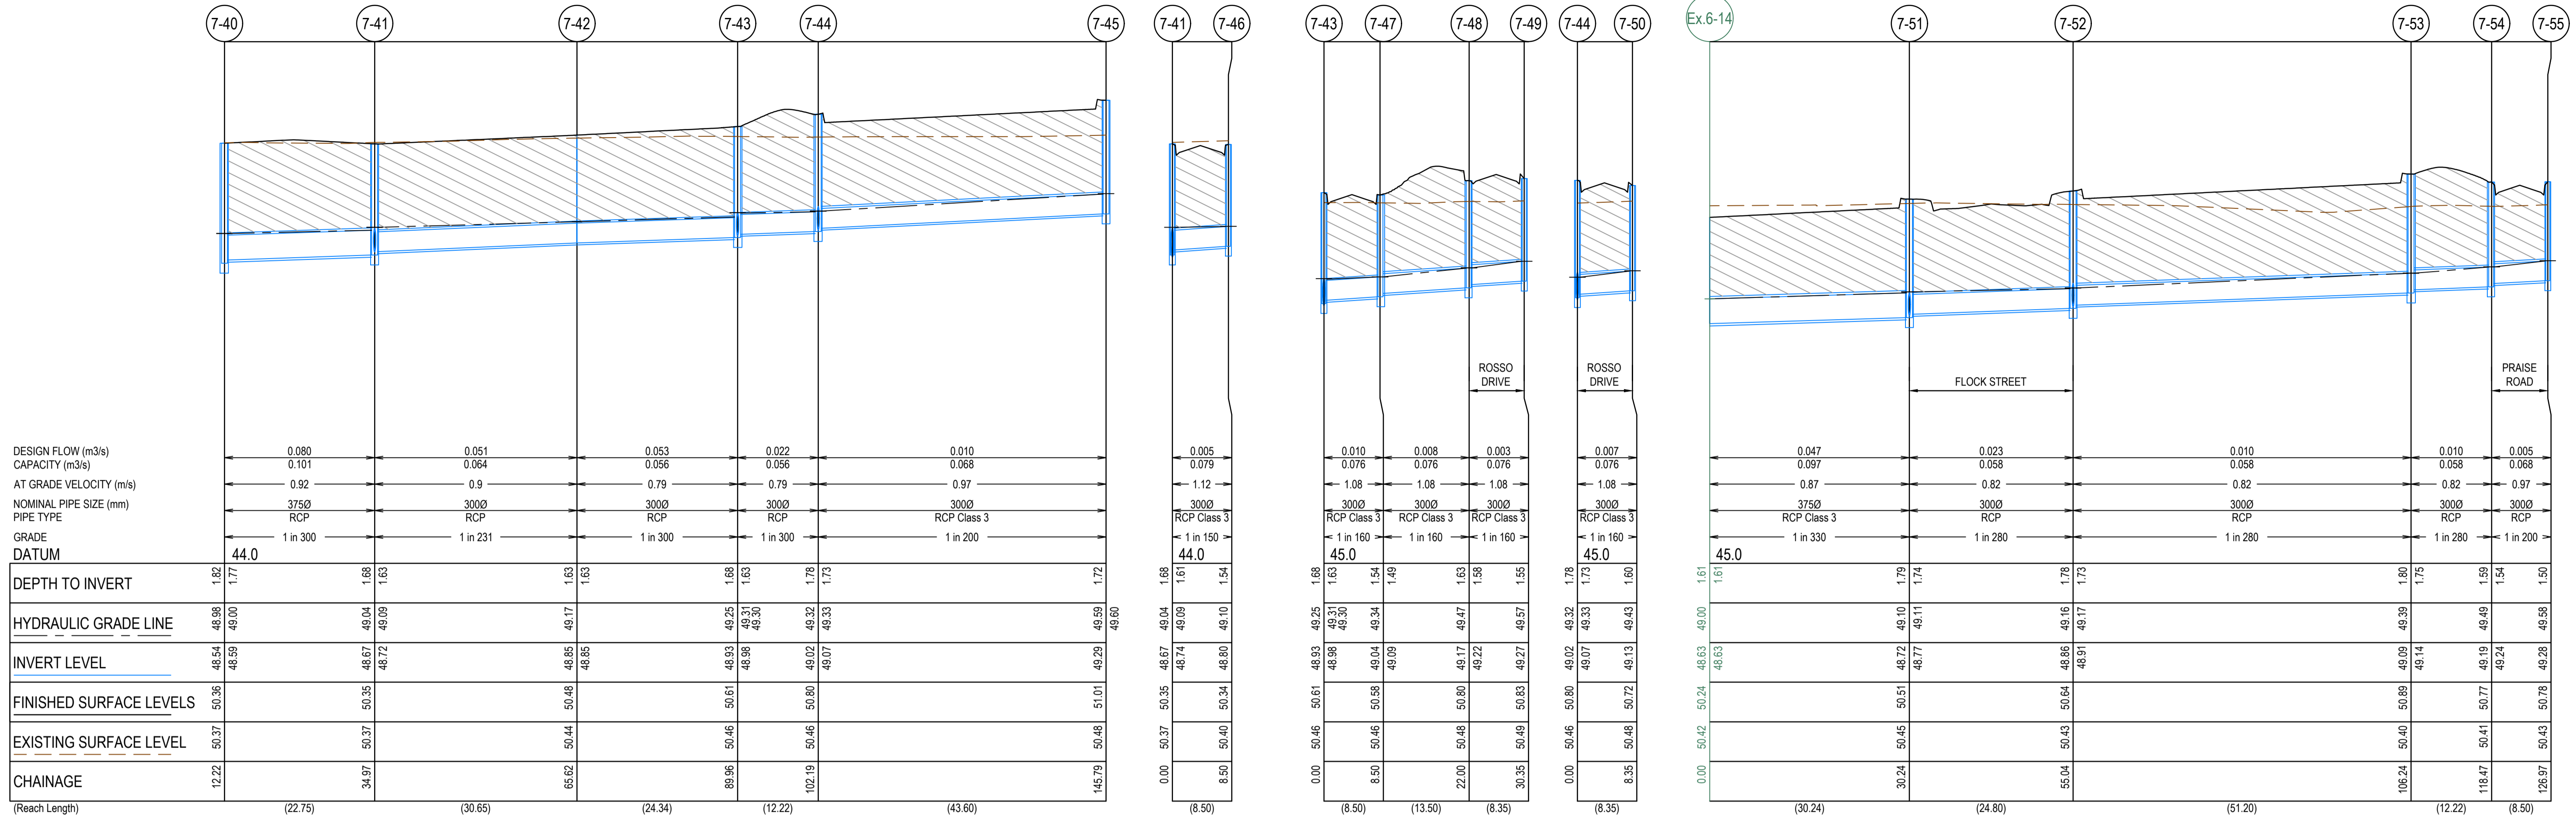

**CRUSHED ROCK BACKFILL**  
 CRB INDICATES CRUSHED ROCK BACKFILL COMPACTED IN ACCORDANCE WITH COUNCIL STANDARDS & SPECIFICATIONS, CLASS 3 UNLESS SPECIFIED OTHERWISE

**AS CONSTRUCTED PLANS**

The purpose of these as-constructed plans is to update the design drawings to show significant changes which occurred during construction. Note that the levels shown on these plans are design levels, and have not been verified by survey. All information shown on these plans should be verified on site. SMEC Australia Pty Ltd accept no responsibility for loss or damages resulting from the inappropriate usage of these plans.

PLAN OF SUB. NO. PS900882T  
 PERMIT REF. NO. WYP10365/17.01  
**AS CONSTRUCTED**

Member of the Surlana Jurong Group  
 ABN 47 065 475 149  
 Collins Square, Tower 4, Level 20, 727 Collins St  
 Melbourne, VIC 3008  
 Ph 03 9514 1500

Marigold - Stage 7  
 Wyndham City Council  
 Road and Drainage  
 Drainage Longitudinal Sections - 3

MELWAYS REF	PROJECT / DRAWING No	SHEET No	REVISION
359 F9	2360E-007-303	23 of 28	1

PIT SCHEDULE											
PIT NUMBER	TYPE	INTERNAL		INLET		OUTLET		F.S.L.	DEPTH	STANDARD DRAWING	REMARKS
		WIDTH (mm)	LENGTH (mm)	DIAMETER (mm)	INV R.L. (m)	DIAMETER (mm)	INV R.L. (m)				
07-01	DOUBLE SIDE ENTRY PIT	900	1200	825	46.433	825	46.383	49.156	2.773	EDCM 605 & MW 7251/08/404	EXISTING JUNCTION PIT. CONVERT TO SEP & ADJUST THE LID TO THE NEW FINISH SURFACE LEVEL.
07-02	DOUBLE SIDE ENTRY PIT	1350	1050	750	46.512	825	46.462	49.173	2.711	EDCM 605 MW 7251/08/404	EXISTING JUNCTION PIT. CONVERT TO SEP & ADJUST THE LID TO THE NEW FINISH SURFACE LEVEL.
07-03	DOUBLE SIDE ENTRY PIT	1500	900	750	46.66	750	46.61	49.35	2.74	EDCM 601	EXISTING JUNCTION PIT. CONVERT TO DSEP & ADJUST THE LID TO THE NEW FINISH SURFACE LEVEL.
07-04	SIDE ENTRY PIT	1050	900	750	46.856 47.04	750	46.806	49.713	2.907	EDCM 601	EXISTING JUNCTION PIT. CONVERT TO SEP & ADJUST THE LID TO THE NEW FINISH SURFACE LEVEL.
07-05	SIDE ENTRY PIT	1050	900	750	47.009 47.19 47.759	750	46.959	49.979	3.02	EDCM 601	EXISTING JUNCTION PIT. CONVERT TO SEP & ADJUST THE LID TO THE NEW FINISH SURFACE LEVEL.
07-06	DOUBLE SIDE ENTRY PIT	1200	900	600	47.302	600	47.252	49.99	2.738	EDCM 602&607	PIT TO BE HAUNCHED. 600x900 RISER BEHIND KERB. CHAMBER UNDER KERB. REFER TO SHEET 421 - GENERAL DETAILS FOR PIT DETAILS
07-07	DOUBLE SIDE ENTRY PIT	900	900	600	47.381	600	47.331	50.001	2.67	EDCM 602&607	PIT TO BE HAUNCHED. 600x900 RISER BEHIND KERB. CHAMBER UNDER KERB. REFER TO SHEET 421 - GENERAL DETAILS FOR PIT DETAILS
07-08	DOUBLE SIDE ENTRY PIT	900	900	600	47.61 48.54 375 47.785	600	47.56	50.006	2.445	EDCM 602&607	PIT TO BE HAUNCHED. 600x900 RISER BEHIND KERB. CHAMBER UNDER KERB. REFER TO SHEET 421 - GENERAL DETAILS FOR PIT DETAILS
07-09	SIDE ENTRY PIT	600	900	450	47.787 48.237	600	47.737	50.12	2.383	EDCM 601	
07-10	SIDE ENTRY PIT	600	900	450	47.96 48.91	450	47.91	50.242	2.333	EDCM 601	
07-11	SIDE ENTRY PIT	600	900	450	48.099 48.124 48.549	450	48.049	50.376	2.327	EDCM 601	
07-12	SIDE ENTRY PIT	600	900	450	48.231	450	48.181	50.5	2.319	EDCM 601	
07-13	JUNCTION PIT	600	900	300	49.306 48.356	450	48.306	50.578	2.271	EDCM 605	
07-15	DOUBLE SIDE ENTRY PIT	600	900			300	46.911	49.379	2.468	EDCM 602	
07-16	SIDE ENTRY PIT	600	900			300	47.123	49.731	2.609	EDCM 601	
07-17	SIDE ENTRY PIT	600	900			300	47.273	49.997	2.724	EDCM 601	
07-18	JUNCTION PIT	600	900	300	48.09	300	48.04	50.225	2.185	EDCM 605	
07-19	JUNCTION PIT	600	900	300	48.943	300	48.893	50.269	1.375	EDCM 605	
07-20	JUNCTION PIT	600	900			300	48.652	49.592	0.94	EDCM 605	
07-21	DOUBLE SIDE ENTRY PIT	600	900			300	48.624	50.017	1.393	EDCM 602	
07-22	DOUBLE SIDE ENTRY PIT	600	900	375	47.981 47.981	375	47.931	49.894	1.963	EDCM 602	
07-23	SIDE ENTRY PIT	600	900	375	48.37	375	48.32	50.278	1.958	EDCM 601	
7-23A	JUNCTION PIT	600	900	375	48.477	375	48.427	50.339	1.913	EDCM 605	
7-23B	JUNCTION PIT	900	600	375	48.582	375	48.532	50.401	1.869	EDCM 605	
07-24	SIDE ENTRY PIT	600	900	300	48.745 48.745	375	48.67	50.446	1.776	EDCM 601	
07-25	JUNCTION PIT	600	900			300	49.124	50.785	1.662	EDCM 605	HEAVY DUTY CLASS D COVER
07-26	DOUBLE SIDE ENTRY PIT	600	900	375	48.074	375	48.024	49.894	1.87	EDCM 605	
07-27	SIDE ENTRY PIT	600	900			375	48.413	50.278	1.865	EDCM 601	
07-28	SIDE ENTRY PIT	600	900	300	48.832	300	48.782	50.446	1.664	EDCM 601	
07-29	JUNCTION PIT	600	900			300	49.078	50.785	1.708	EDCM 605	HEAVY DUTY CLASS D COVER
07-30	SIDE ENTRY PIT	600	900			300	48.294	50.131	1.837	EDCM 601	
07-32	JUNCTION PIT	900	600	225	49.495	300	49.42	50.696	1.276	EDCM 605	
07-33	JUNCTION PIT	600	900			225	50.032	51.113	1.081	EDCM 605	
07-34	DOUBLE SIDE ENTRY PIT	600	900	300	48.295 48.295	300	48.245	50.317	2.071	EDCM 605	
07-35	SIDE ENTRY PIT	600	900	300	48.742	300	48.692	50.642	1.95	EDCM 601	
07-36	SIDE ENTRY PIT	600	900			300	48.827	50.642	1.815	EDCM 601	
07-38	JUNCTION PIT	900	600	300	49.699	300	49.649	50.981	1.332	EDCM 605	
07-39	JUNCTION PIT	600	900			300	49.886	51.15	1.264	EDCM 605	
7-13A	DOUBLE SIDE ENTRY PIT	600	900	375	48.503	375	48.453	50.103	1.65	EDCM 605	
07-40	SIDE ENTRY PIT	600	900	375	48.594	375	48.544	50.362	1.818	EDCM 601	
07-41	DOUBLE SIDE ENTRY PIT	600	900	300	48.72 48.745	375	48.67	50.353	1.683	EDCM 605	
07-42	TURNING POINT			300	48.852	300	48.852	50.485	1.633		
07-43	SIDE ENTRY PIT	600	900	300	48.983 48.983	300	48.933	50.614	1.681	EDCM 601	
07-44	DOUBLE SIDE ENTRY PIT	600	900	300	49.074 49.074	300	49.024	50.8	1.776	EDCM 605	
07-45	JUNCTION PIT	600	900			300	49.292	51.012	1.72	EDCM 605	
07-46	DOUBLE SIDE ENTRY PIT	600	900			300	48.801	50.344	1.542	EDCM 605	
07-47	SIDE ENTRY PIT	600	900	300	49.087	300	49.037	50.577	1.54	EDCM 601	
07-48	SIDE ENTRY PIT	600	900	300	49.221	300	49.171	50.796	1.625	EDCM 601	
07-49	SIDE ENTRY PIT	600	900			300	49.273	50.827	1.554	EDCM 601	
07-50	DOUBLE SIDE ENTRY PIT	600	900			300	49.126	50.722	1.596	EDCM 605	
07-51	SIDE ENTRY PIT	600	900	300	48.771 48.771	375	48.721	50.515	1.794	EDCM 601	
07-52	SIDE ENTRY PIT	600	900	300	48.91 48.91	300	48.86	50.639	1.779	EDCM 601	
07-53	SIDE ENTRY PIT	600	900	300	49.143	300	49.093	50.895	1.802	EDCM 601	
07-54	DOUBLE SIDE ENTRY PIT	600	900	300	49.236	300	49.186	50.774	1.587	EDCM 605	
07-55	DOUBLE SIDE ENTRY PIT	600	900			300	49.279	50.777	1.499	EDCM 605	
07-56	DOUBLE SIDE ENTRY PIT	600	900	300	48.882	300	48.832	50.392	1.559	EDCM 605	
07-57	DOUBLE SIDE ENTRY PIT	600	900			300	48.925	50.393	1.468	EDCM 605	
07-58	SIDE ENTRY PIT	600	900			300	48.993	50.583	1.589	EDCM 601	
Ex.9	ENDPIPE			675	46.38			49.031	0		CONNECT TO EXISTING PIPE
07-59	SIDE ENTRY PIT	1050	900			675	46.396	49.092	2.696	EDCM 601	PIT TO BE HAUNCHED. 600x900 RISER BEHIND KERB. CHAMBER UNDER KERB. REFER TO SHEET 421 - GENERAL DETAILS FOR PIT DETAILS

**AS CONSTRUCTED PLANS**

The purpose of these as-constructed plans is to update the design drawings to show significant changes which occurred during construction. Note that the levels shown on these plans are design levels, and have not been verified by survey. All information shown on these plans should be verified on site. SMEC Australia Pty Ltd accept no responsibility for loss or damages resulting from the inappropriate usage of these plans.



**AS CONSTRUCTED**

PLAN OF SUB. NO. PS90082T  
 PERMIT REF. NO. WYP10365/17.01




Member of the Surlana Jurong Group  
 ABN 47 065 475 149  
 Collins Square, Tower 4, Level 20, 727 Collins St  
 Melbourne, VIC 3008  
 Ph 03 9514 1500



Marigold - Stage 7  
 Wyndham City Council  
 Road and Drainage  
 Pit Schedule

MELWAYS REF <b>359 F9</b>	PROJECT / DRAWING No. <b>2360E-007-351</b>	SHEET No. <b>24 of 28</b>	REVISION <b>2</b>
------------------------------	---	------------------------------	----------------------



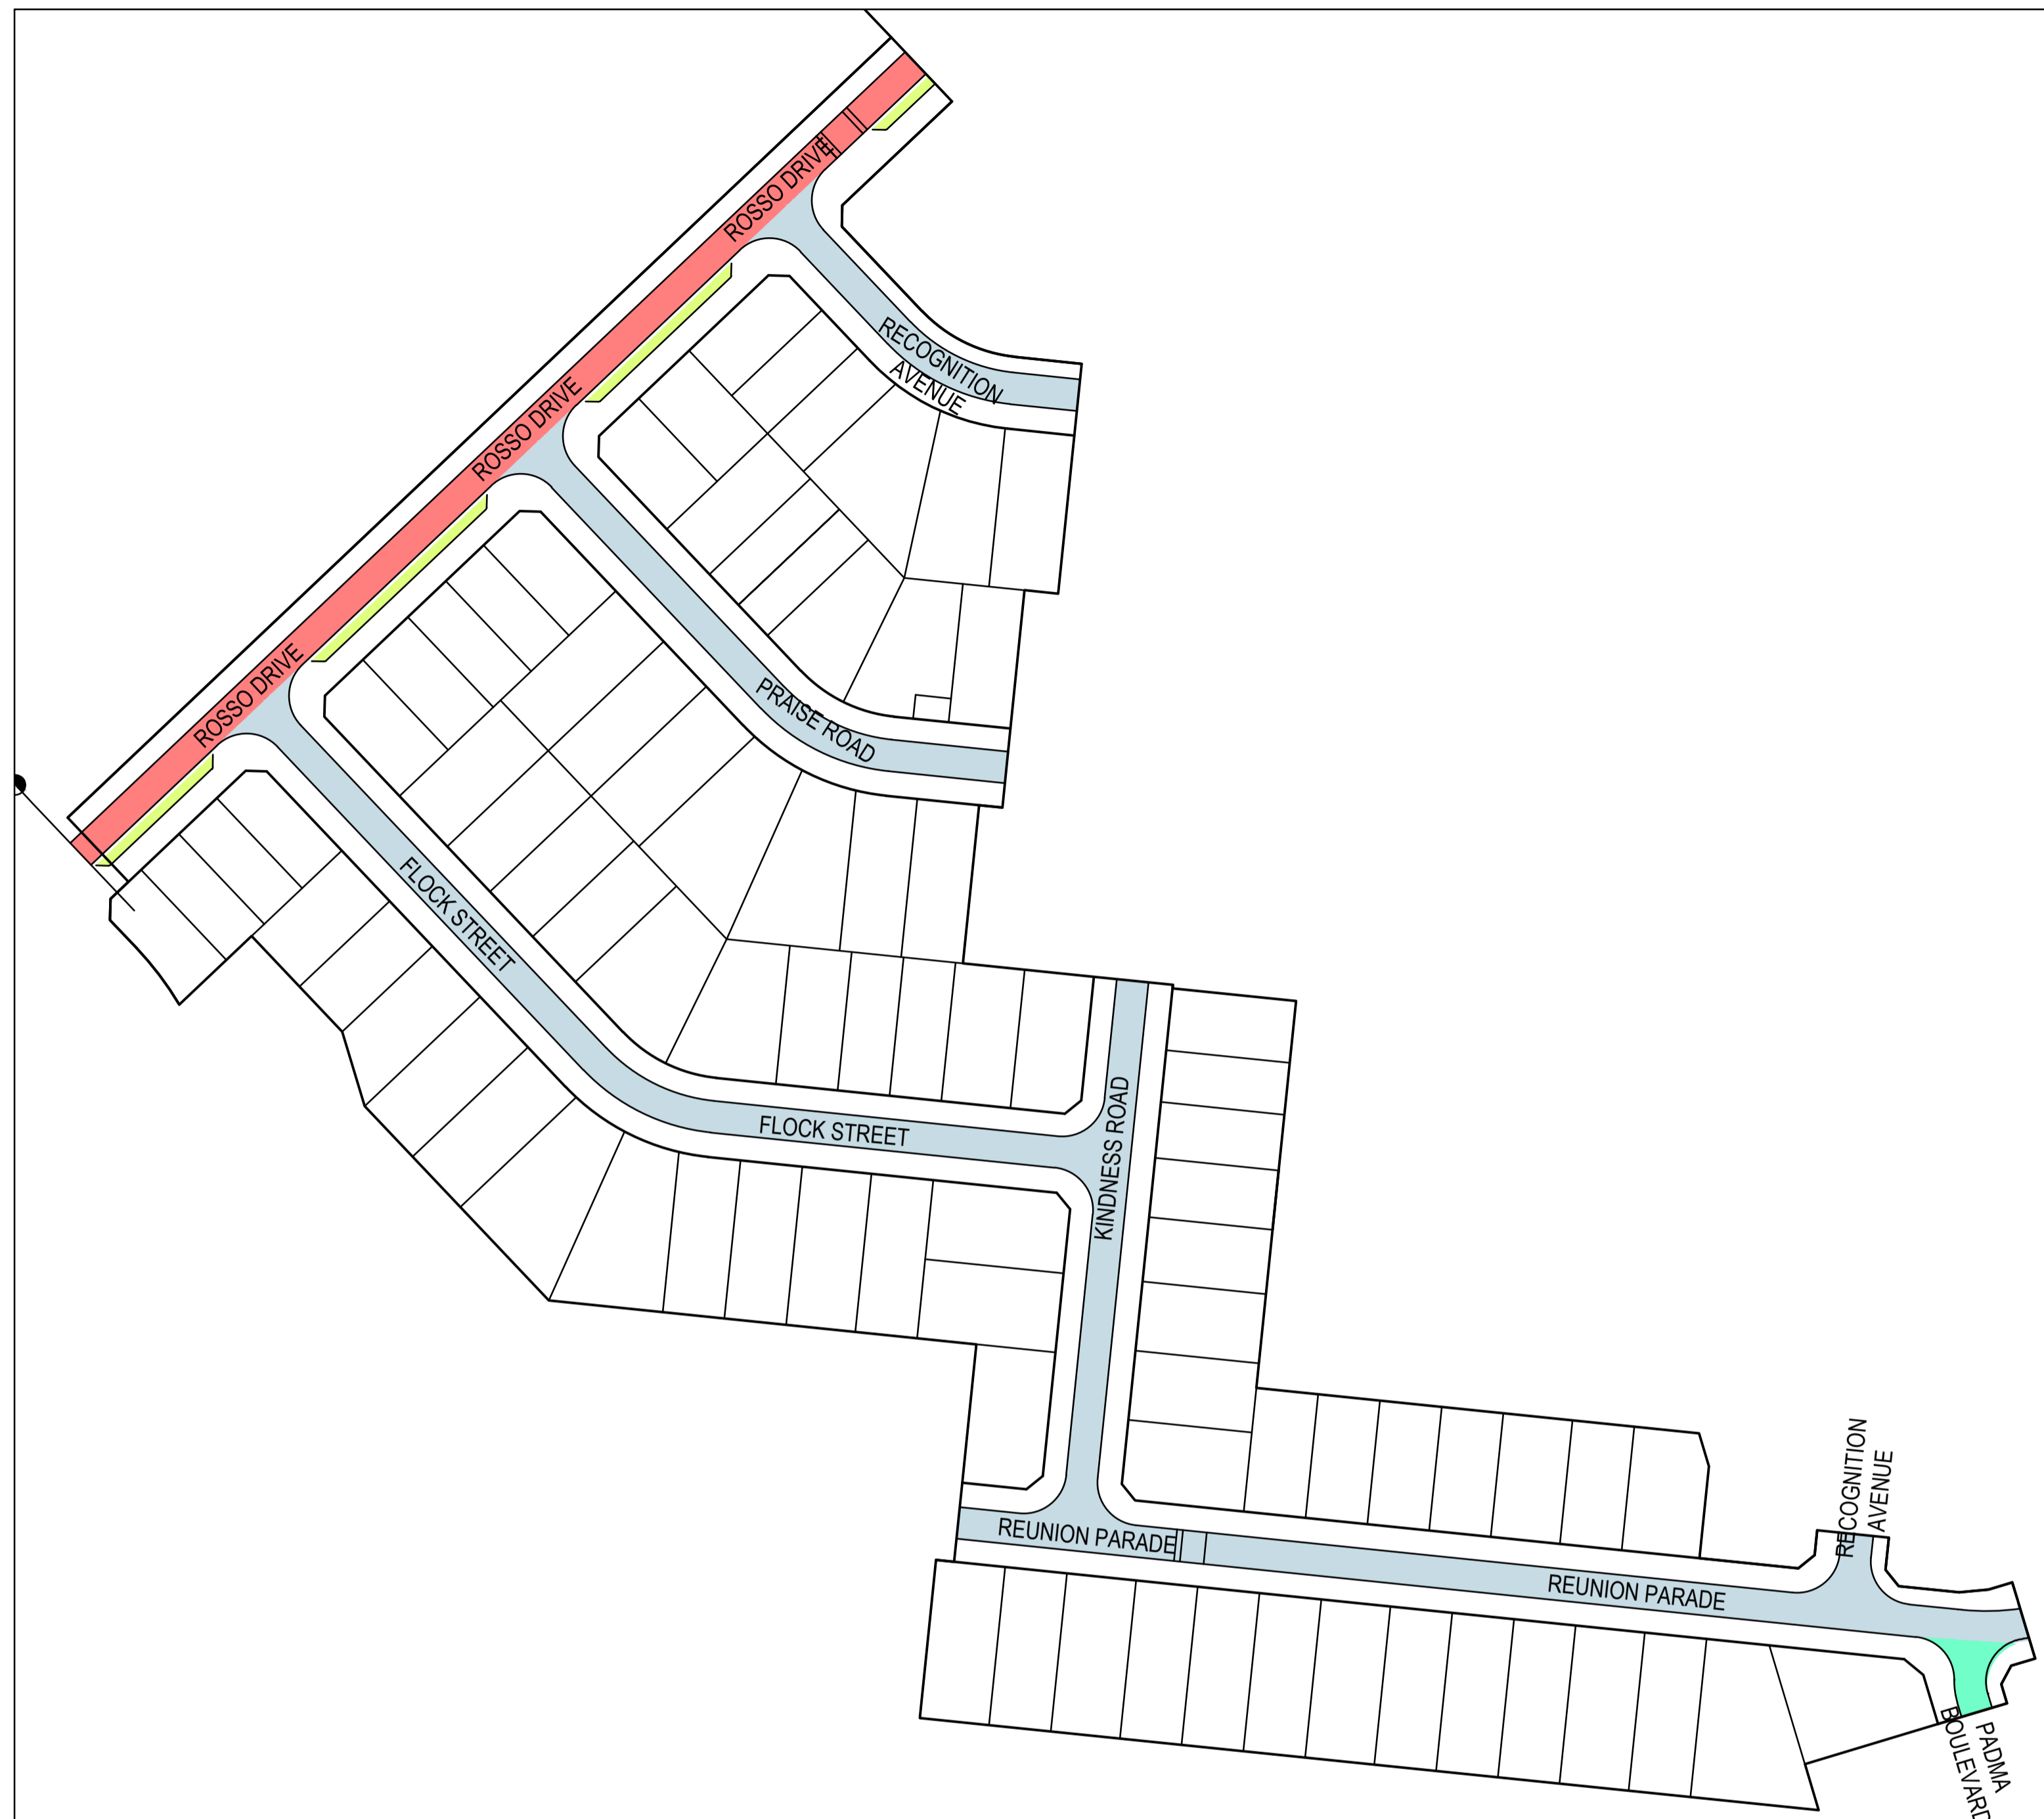

440mm PADMA BOULEVARD PAVEMENT COMPOSITION (TYPE C) AND 150mm DEEP CONSTRUCTION LAYER		
PAVEMENT LAYER	LAYER THICKNESS (mm)	MATERIAL
A WEARING COURSE	40	SIZE 14 TYPE N ASPHALT, CLASS 320 BINDER
B INTERMEDIATE COURSE	75	SIZE 20 TYPE SI ASPHALT, CLASS 320 BINDER
C BASE COURSE	75	SIZE 20 TYPE SI ASPHALT, CLASS 320 BINDER
D SUBBASE	100	SIZE 20mm CLASS 3 CEMENT TREATED CRUSHED ROCK 3% (E=500MPa) COMPACTED TO A MINIMUM CHARACTERISTIC DENSITY RATIO OF 96% MODIFIED COMPACTION MAXIMUM DRY DENSITY AS 1289.5.2.1
E CAPPING LAYER	150	TYPE A MATERIAL CBR ≥8%, SWELL ≤1.5% & PERMEABILITY $k \leq 1 \times 10^{-9}$ m/s SUBGRADE (DESIGN CBR 2%), COMPACTED TO A MINIMUM DENSITY RATIO OF 98% (STANDARD) MAXIMUM DRY DENSITY AS1289.5.1.1. TO BE COMPACTED IN 2 LAYERS
F CONSTRUCTION LAYER	150	TYPE A MATERIAL CBR ≥8%, SWELL ≤1.5% & PERMEABILITY $k \leq 1 \times 10^{-9}$ m/s SUBGRADE (DESIGN CBR 2%), COMPACTED TO A MINIMUM DENSITY RATIO OF 98% (STANDARD) MAXIMUM DRY DENSITY AS1289.5.1.1. TO BE COMPACTED IN 2 LAYERS

635mm REUNION PDE, FLOCK ST., KINDNESS RD., PRAISE RD., RECOGNITION AVE. COMPOSITION (TYPE A)		
PAVEMENT LAYER	LAYER THICKNESS (mm)	MATERIAL
ASPHALT WEARING COURSE	30	SIZE 10 TYPE N ASPHALT, CLASS 320 BINDER
ASPHALT BASE COURSE	30	SIZE 10 TYPE N ASPHALT, CLASS 320 BINDER
SEALING LAYER	10	SIZE 10 SAMI TREATMENT
BONDING LAYER		PRIME COST IF NOT SUBJECTED TO TRAFFIC OTHERWISE PRIMER SEAL
BASE COURSE	130	SIZE 20 CLASS 2 CR. COMPACTED DEPTH. COMPACTED TO A MINIMUM CHARACTERISTIC DENSITY RATIO OF 98% (MODIFIED) MAXIMUM DRY DENSITY AS1289.5.2.1
SUB-BASE COURSE	135	SIZE 20 CLASS 3 CR. COMPACTED DEPTH. COMPACTED TO A MINIMUM DENSITY RATIO OF 97% (MODIFIED) MAXIMUM DRY DENSITY AS1289.5.2.1
CAPPING LAYER	150	TYPE A MATERIAL CBR ≥8%, SWELL ≤1.5% & PERMEABILITY $k \leq 1 \times 10^{-9}$ m/s. COMPACTED TO A MINIMUM DENSITY CHARACTERISTIC DENSITY RATIO OF 98% (STANDARD) MAXIMUM DRY DENSITY AS1289.5.1.1
CONSTRUCTION LAYER	150	TYPE A FILL MATERIAL (MIN CBR 8%, SWELL ≤ 1.5%, PERMEABILITY $5 \times 10^{-9}$ m/s) COMPACTED TO A MINIMUM CHARACTERISTIC DENSITY RATIO OF 98% STANDARD MAXIMUM DRY DENSITY AS1289.5.1.1


740mm ROSSO DRIVE COMPOSITION (TYPE B)		
PAVEMENT LAYER	LAYER THICKNESS (mm)	MATERIAL
ASPHALT WEARING COURSE	40	SIZE 14 TYPE H
ASPHALT INTERMEDIATE COURSE	75	SIZE 20 TYPE SI
ASPHALT BASE COURSE	75	SIZE 20 TYPE SI
BASE COURSE	100	VICROADS CLASS 2, SIZE 20mm, 3% CTCR
SUB-BASE COURSE	100	VICROADS CLASS 3, SIZE 20mm, FCR
CAPPING LAYER	200	TYPE A CAPPING LAYER MATERIAL (MIN CBR 8%, SWELL ≤ 1.5%, PERMEABILITY $5 \times 10^{-9}$ m/s) COMPACTED TO A MINIMUM DENSITY CHARACTERISTIC DENSITY RATIO OF 98% (STANDARD) MAXIMUM DRY DENSITY AS1289.5.1.1
CONSTRUCTION LAYER	150	TYPE A CAPPING LAYER FILL MATERIAL (MIN CBR 8%, SWELL ≤ 1.5%, PERMEABILITY $5 \times 10^{-9}$ m/s) COMPACTED TO A MINIMUM CHARACTERISTIC DENSITY RATIO OF 98% STANDARD MAXIMUM DRY DENSITY AS1289.5.1.1

THE PAVEMENT SHOULD COMPRISE ROAD BASE OR SUBBASE QUALITY MATERIALS SPREAD IN LAYERS NOT EXCEEDING 200mm LOOSE LAYER THICKNESS, MOISTURE CONDITIONED TO WITHIN ± 2% MODIFIED OPTIMUM MOISTURE CONTENT (OMC) AND COMPACTED TO A DRY DENSITY RATIO OF 98% MODIFIED, PLACES IN ACCORDANCE WITH VICROADS REQUIREMENT.

THE PAVEMENT SHOULD COMPRISE ROAD BASE OR SUBBASE QUALITY MATERIALS SPREAD IN LAYERS NOT EXCEEDING 200mm LOOSE LAYER THICKNESS, MOISTURE CONDITIONED TO WITHIN ± 2% MODIFIED OPTIMUM MOISTURE CONTENT (OMC) AND COMPACTED TO A DRY DENSITY RATIO OF 98% MODIFIED, PLACES IN ACCORDANCE WITH VICROADS REQUIREMENT.

**WARNING**  
**BEWARE OF UNDERGROUND SERVICES**  
The locations of underground services are approximate only and their exact position should be proven on site. No guarantee is given that all existing services are shown. Locate all underground services before commencement of works.  
**DIAL 1100 BEFORE YOU DIG**  
www.1100.com.au

**PAVEMENT NOTE**  
ALL PAVEMENT DESIGNS HAVE BEEN PROVIDED BY TONKIN AND TAYLOR. SMEC IS NOT RESPONSIBLE FOR GEOTECHNICAL OR PAVEMENT RELATED DESIGNS AND IS NOT RESPONSIBLE FOR THE ACCURACY, ADEQUACY OR APPROPRIATENESS OF THESE DESIGNS. THE PAVEMENT COMPOSITIONS SHOWN ON THIS DRAWING HAVE BEEN REPRODUCED FROM THE PAVEMENT REPORT (1008776.1000v3) FOR THIS DEVELOPMENT STAGE. THIS DOCUMENT SHOULD BE REVIEWED BY THE CONTRACTOR TO ENSURE DESIGN HAS BEEN INTERPRETED CORRECTLY. A COPY OF THIS DOCUMENT WILL BE MADE AVAILABLE ON REQUEST.

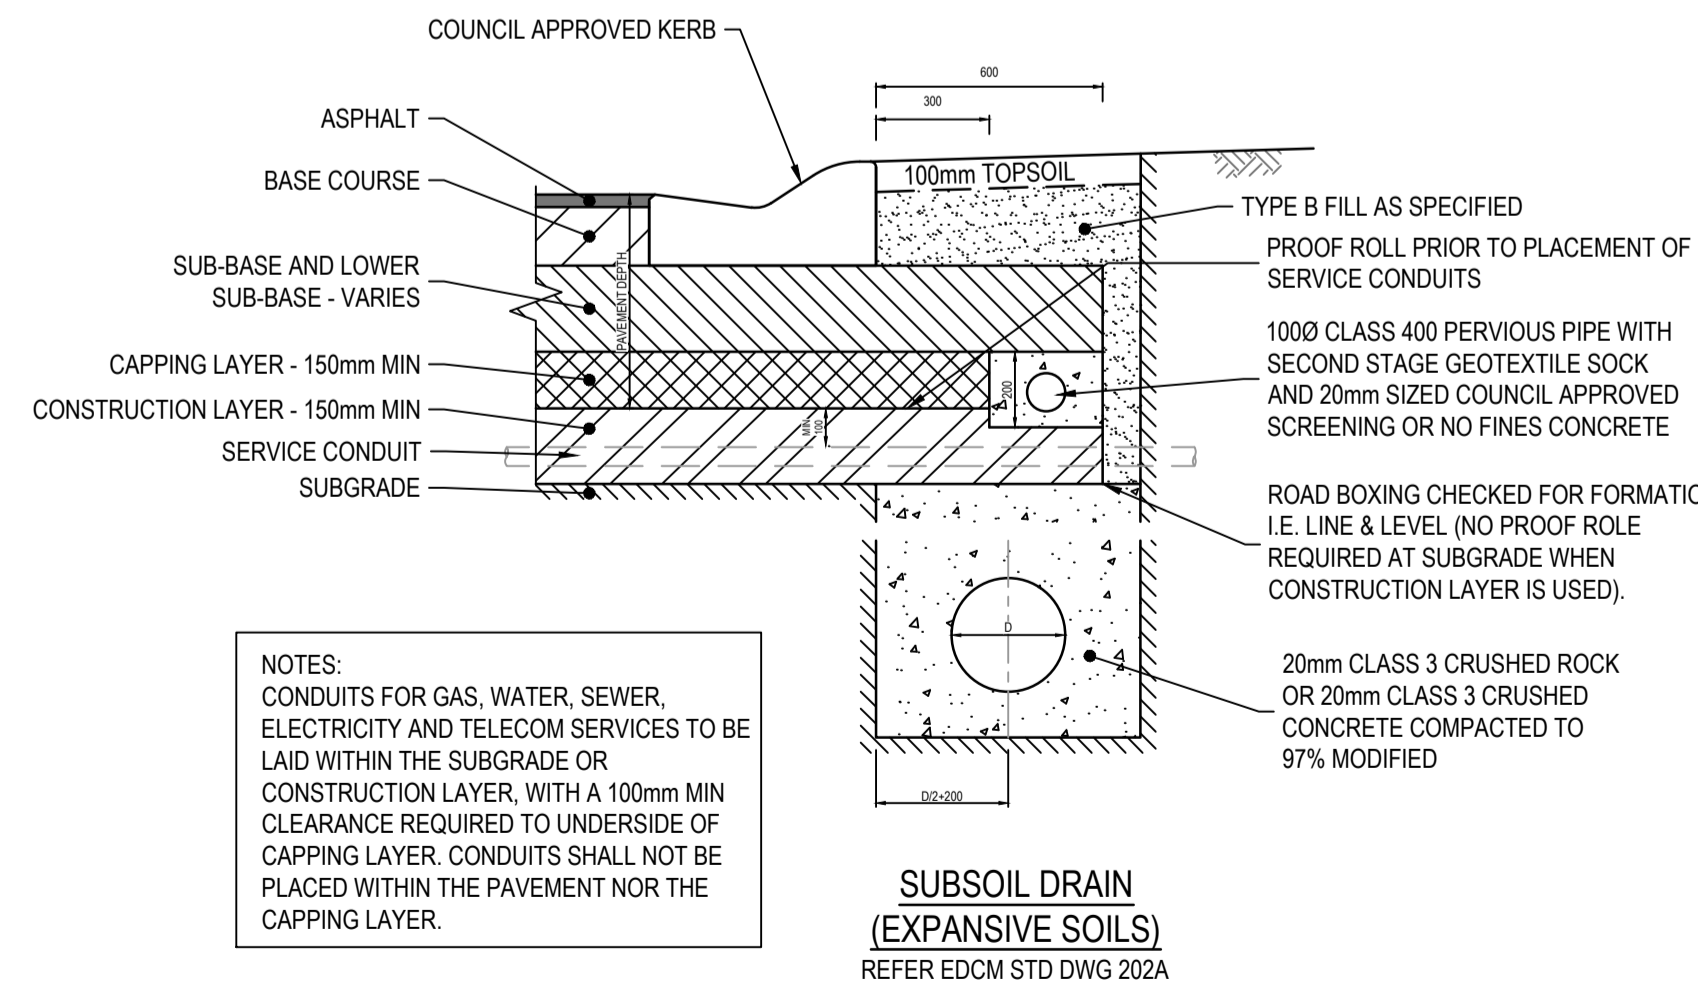

750mm ROSSO DRIVE PARKING BAY - 200 VPD - PARKING BAY PAVEMENT COMPOSITION		
PAVEMENT LAYER	LAYER THICKNESS (mm)	MATERIAL
CONCRETE	200	CONCRETE. SL82 MESH. 40mm TOP COVER
BASE COURSE	100	VICROADS CLASS 2, SIZE 20mm, 3% CTCR
SUB-BASE COURSE	100	VICROADS CLASS 3, SIZE 20mm, FCR
CAPPING LAYER	200	TYPE A CAPPING LAYER MATERIAL (MIN CBR 8%, SWELL ≤ 1.5%, PERMEABILITY $5 \times 10^{-9}$ m/s) COMPACTED TO A MINIMUM DENSITY CHARACTERISTIC DENSITY RATIO OF 98% (STANDARD) MAXIMUM DRY DENSITY AS1289.5.1.1
CONSTRUCTION LAYER	150	TYPE A CAPPING LAYER FILL MATERIAL (MIN CBR 8%, SWELL ≤ 1.5%, PERMEABILITY $5 \times 10^{-9}$ m/s) COMPACTED TO A MINIMUM CHARACTERISTIC DENSITY RATIO OF 98% STANDARD MAXIMUM DRY DENSITY AS1289.5.1.1



**AS CONSTRUCTED PLANS**

The purpose of these as-constructed plans is to update the design drawings to show significant changes which occurred during construction. Note that the levels shown on these plans are design levels, and have not been verified by survey. All information shown on these plans should be verified on site. SMEC Australia Pty Ltd accept no responsibility for loss or damages resulting from the inappropriate usage of these plans.

Quality Management ISO 9001  
 OHS Management AS/NZS 4801  
 Environmental Management ISO 14001  
 Global-Mark.com.au®

PLAN OF SUB. NO. PS900882T  
 PERMIT REF. NO. WYP10365/17.01

**AS CONSTRUCTED**

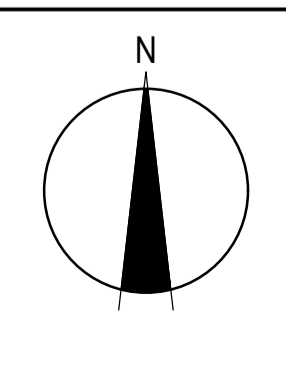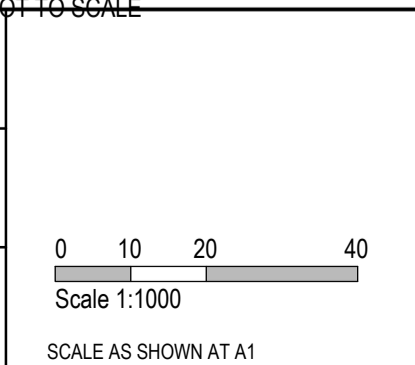


**SMEC**  
 Member of the Surlana Jurong Group  
 ABN 47 065 475 149  
 Collins Square, Tower 4, Level 20, 727 Collins St  
 Melbourne, VIC 3008  
 Ph 03 9514 1500


**GROWLAND**

Marigold - Stage 7  
 Wyndham City Council  
 Road and Drainage  
 Pavement Details - 1


MELWAYS REF: 359 F9  
 PROJECT / DRAWING No: 2360E-007-411  
 SHEET No: 25 of 28  
 REVISION: 2

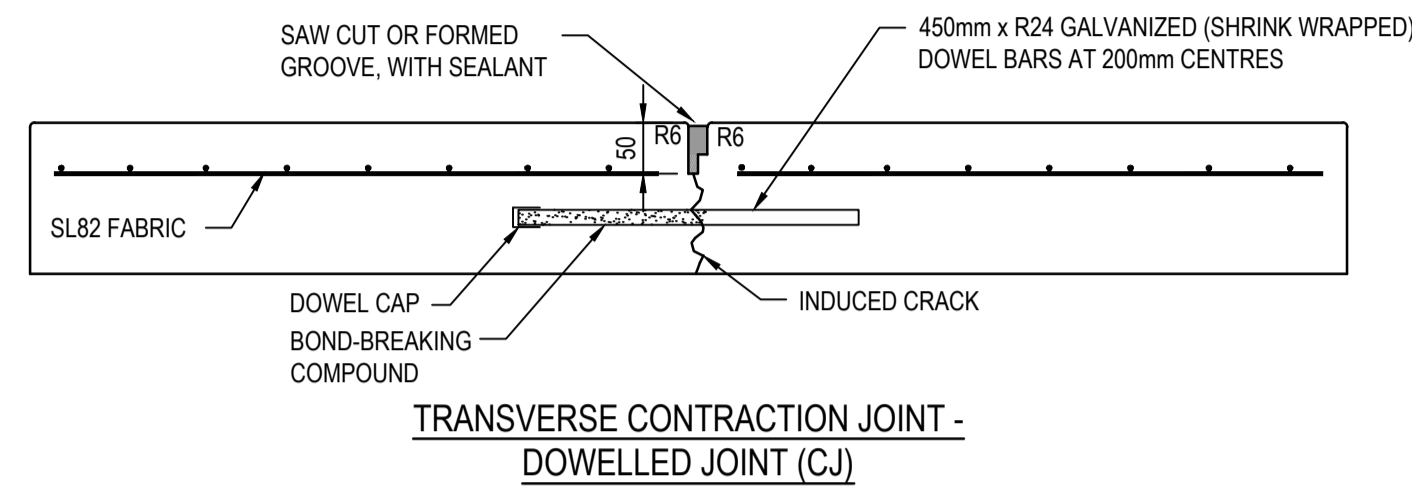


TRANSVERSE CONTRACTION JOINT -  
DOWELLED JOINT (CJ)

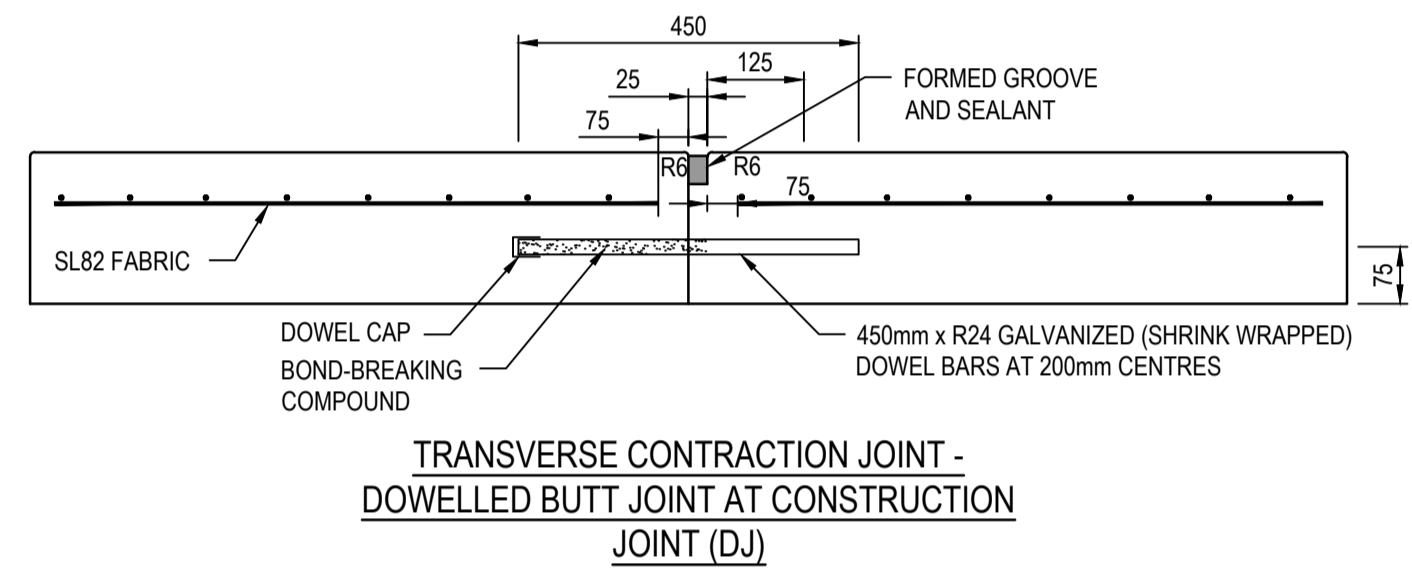

TRANSVERSE CONTRACTION JOINT -  
DOWELLED BUTT JOINT AT CONSTRUCTION  
JOINT (DJ)

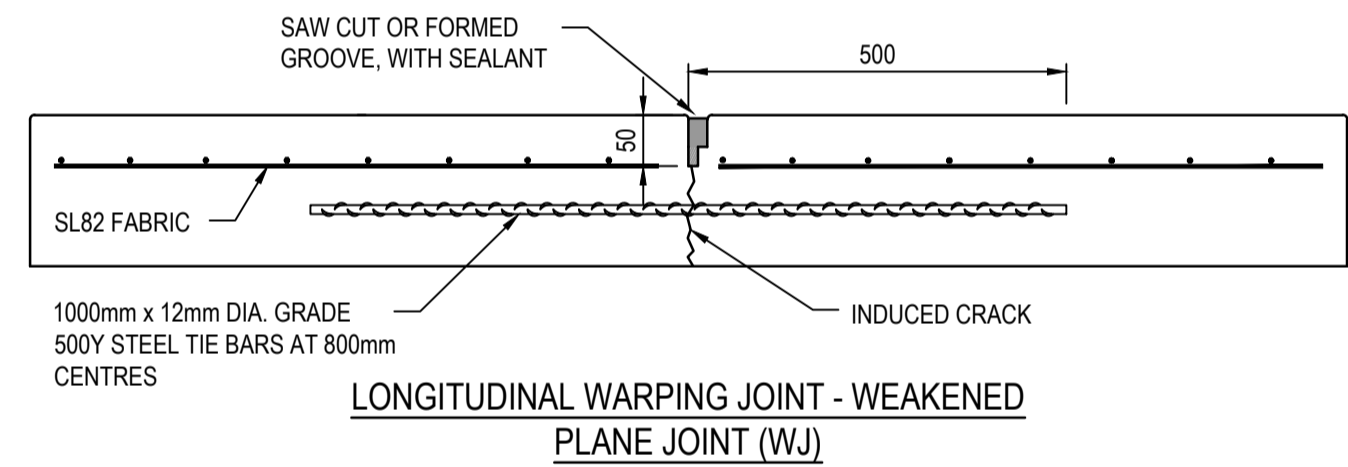

LONGITUDINAL WARPING JOINT - WEAKENED  
PLANE JOINT (WJ)

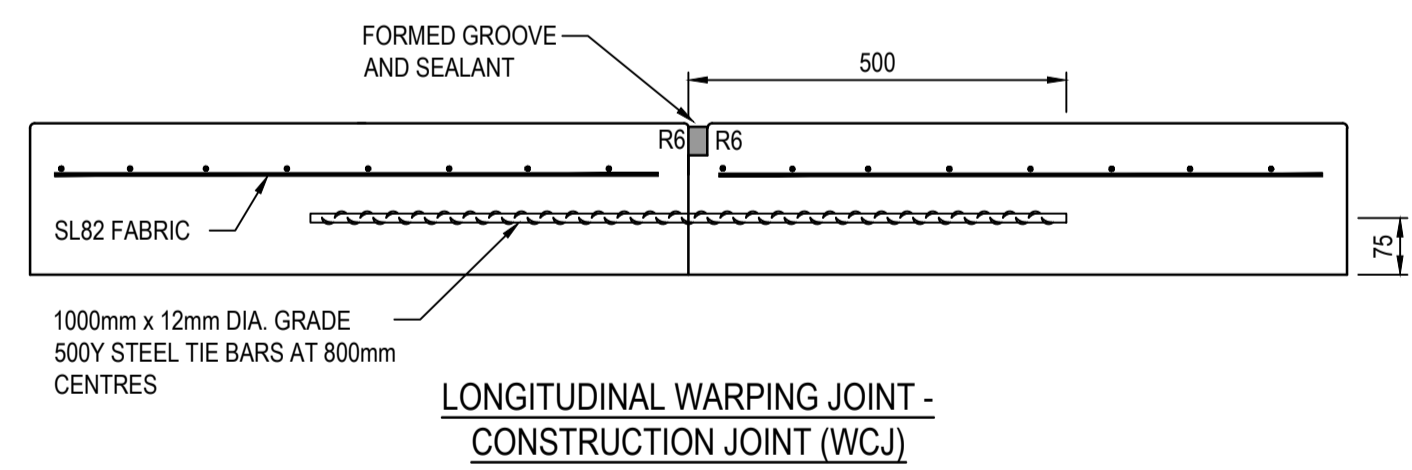


LONGITUDINAL WARPING JOINT -  
CONSTRUCTION JOINT (WCJ)

CONCRETE JOINTING DETAILS

NOT TO SCALE


NOTES:

- CONCRETE SHALL BE CURED IN ACCORDANCE WITH AS3600 AND NOT TO BE TRAFFICKED UNTIL AT LEAST SEVEN DAYS AFTER POURING.

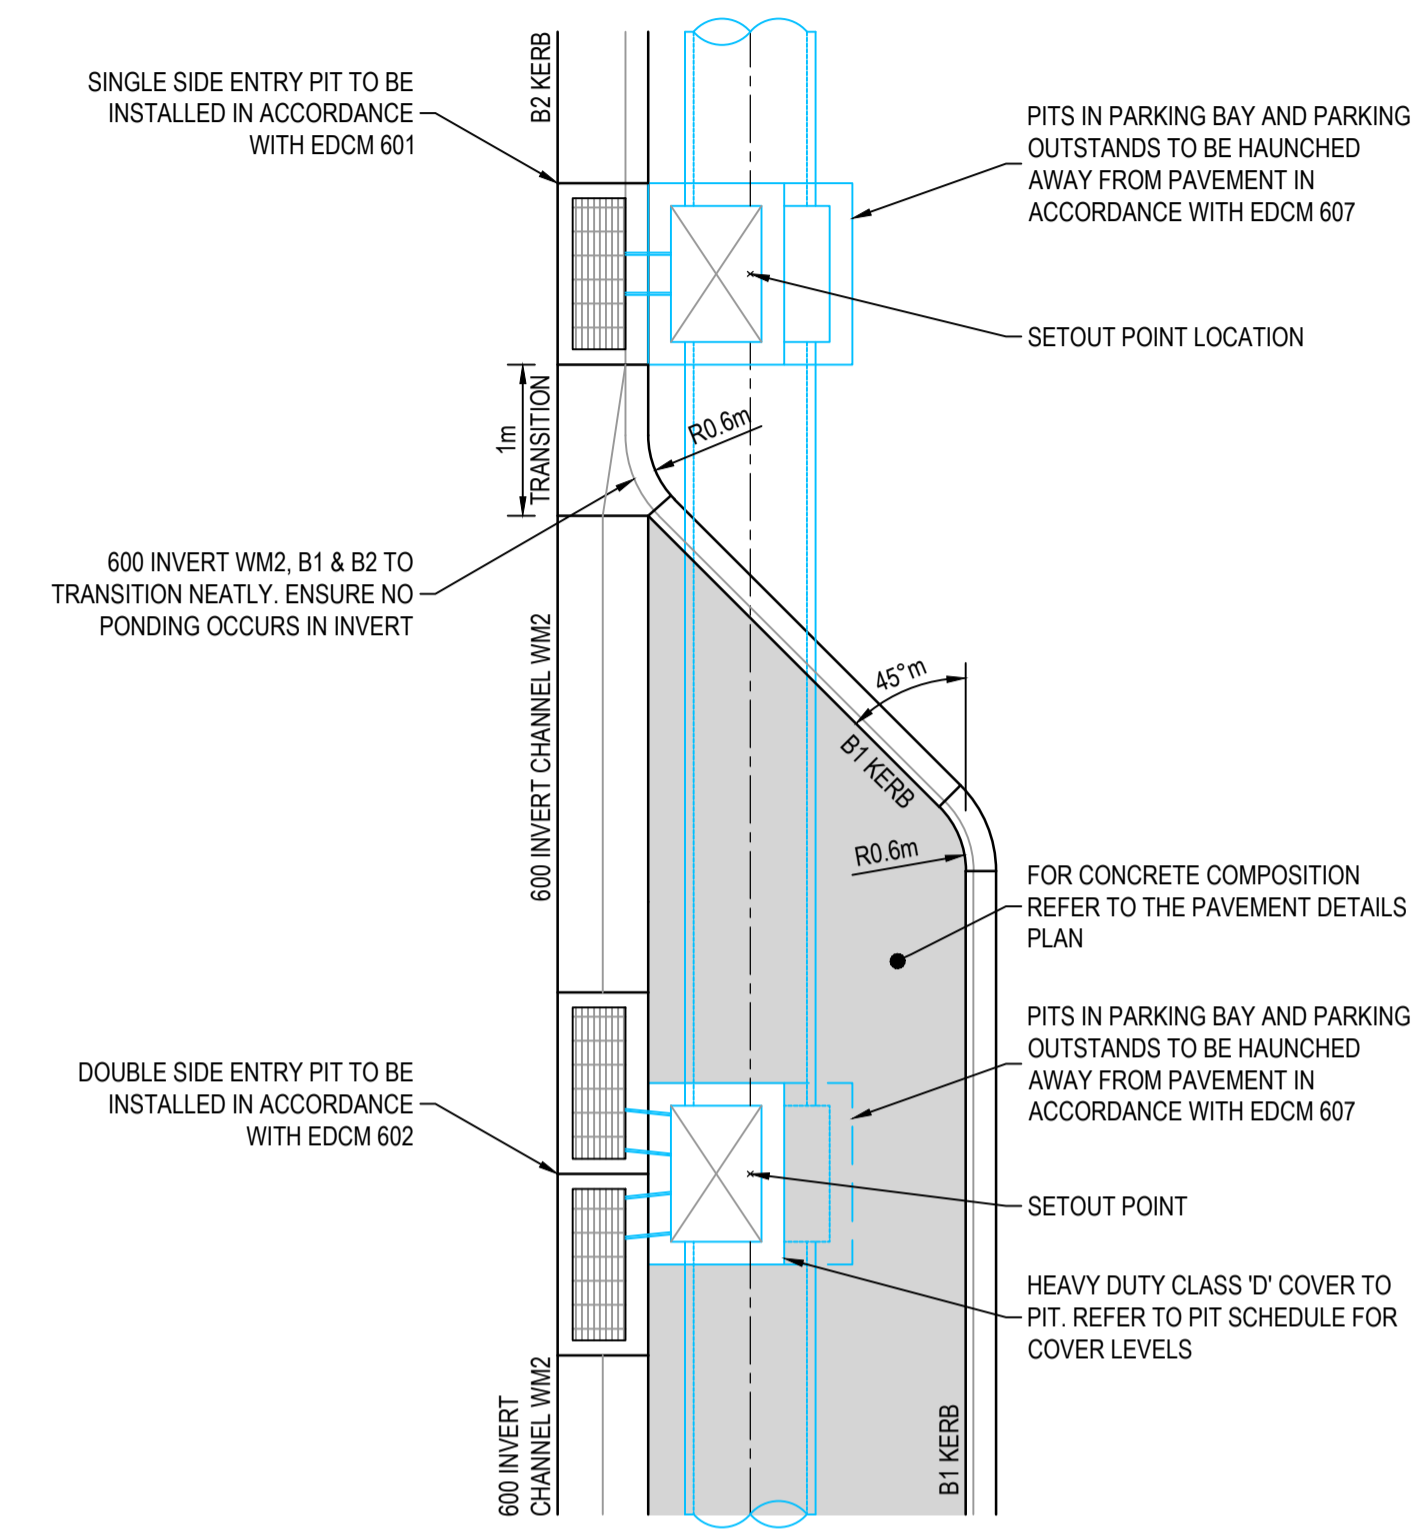

TYPICAL PARKING BAY & DRAINAGE PIT LAYOUT

SCALE 1:50

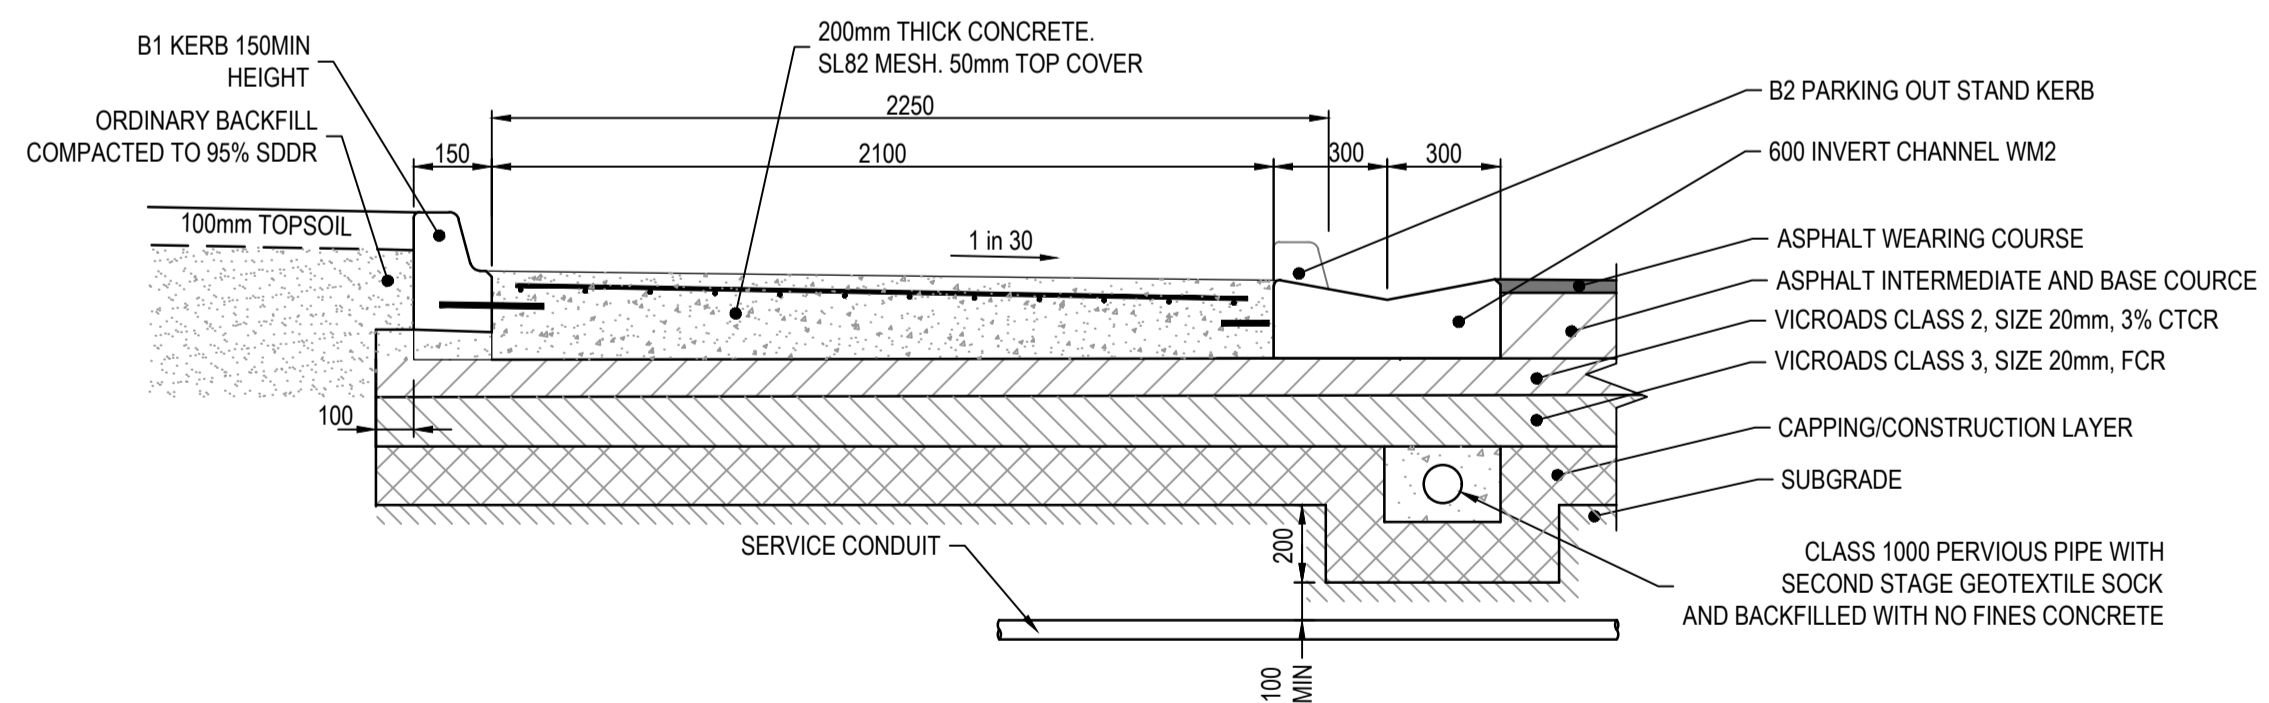

SECTION THROUGH PARKING

NOT TO SCALE

- NOTES:  
CONDUITS FOR GAS, WATER, ELECTRICITY AND TELECOM SERVICES TO BE LOCATED CLEAR OF PAVEMENT AND THE SUBSURFACE DRAIN

**WARNING**  
**BEWARE OF UNDERGROUND SERVICES**  
The locations of underground services are approximate only and their exact position should be proven on site.  
No guarantee is given that all existing services are shown.  
Locate all underground services before commencement of works  
**DIAL 1100 BEFORE YOU DIG**  
www.1100.com.au

AS CONSTRUCTED PLANS

The purpose of these as-constructed plans is to update the design drawings to show significant changes which occurred during construction. Note that the levels shown on these plans are design levels, and have not been verified by survey. All information shown on these plans should be verified on site. SMEC Australia Pty Ltd accept no responsibility for loss or damages resulting from the inappropriate usage of these plans.




PLAN OF SUB. NO.  
PS900882T  
PERMIT REF. NO.  
WYP10365/17.01

RP ENG	
RP ENG NO.	
DATE	


Scale 1:500  
SCALE AS SHOWN AT A1

**AS CONSTRUCTED**

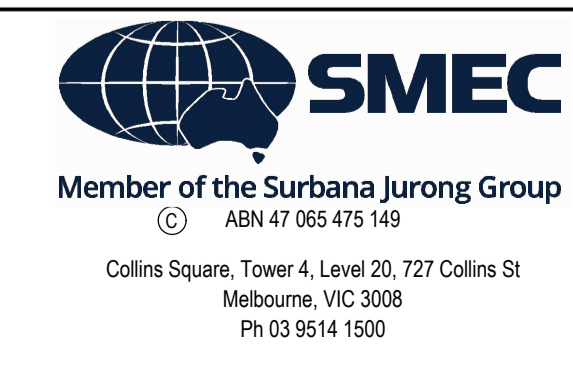


Marigold - Stage 7  
Wyndham City Council  
Road and Drainage  
Pavement Details - 2


MELWAYS REF 359 F9	PROJECT / DRAWING No. 2360E-007-412	SHEET No. 26 of 28	REVISION 1
-----------------------	--	-----------------------	---------------

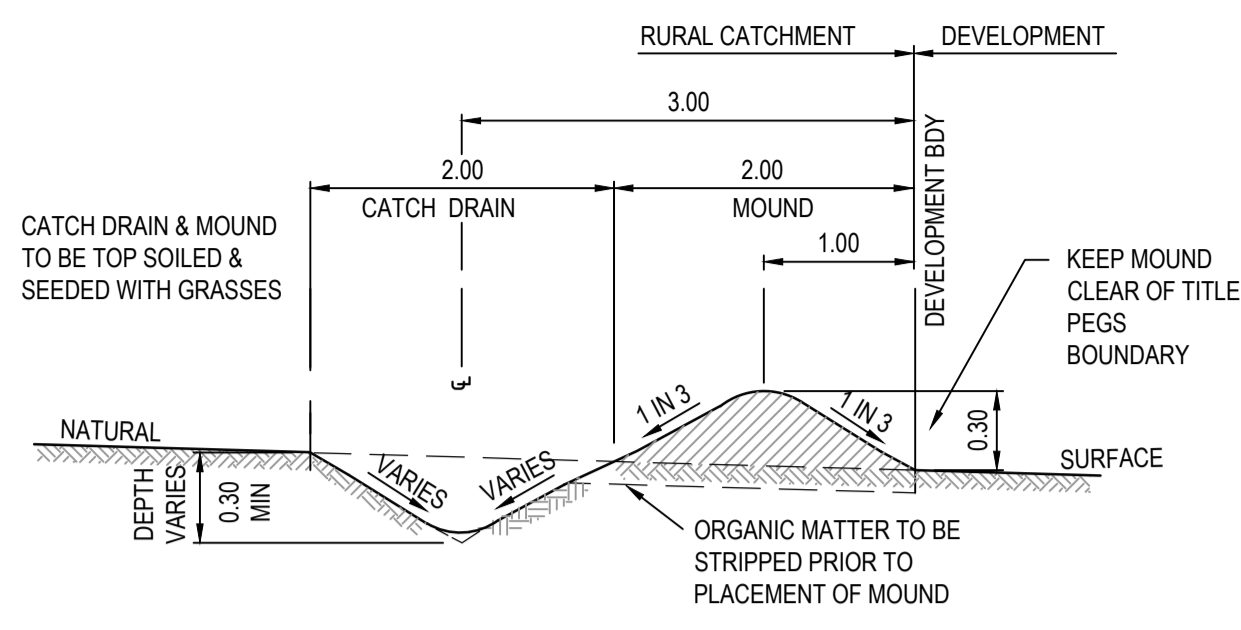


TYPICAL SECTION THROUGH CUT OFF DRAIN  
NOT TO SCALE

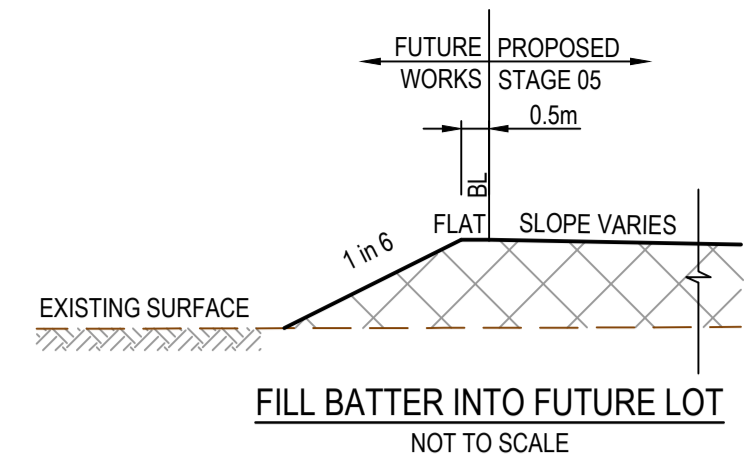


FILL BATTER INTO FUTURE LOT  
NOT TO SCALE

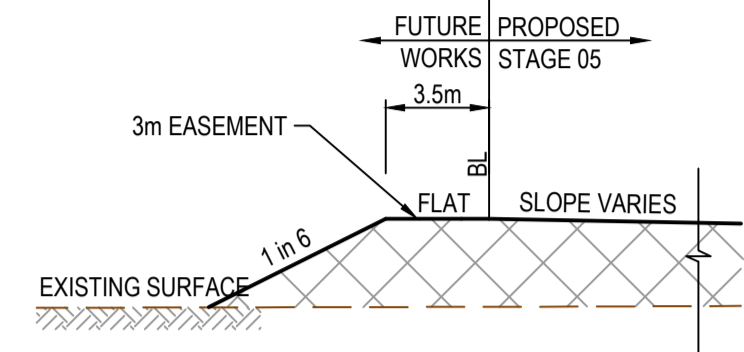


FILL BATTER (OVER EASEMENT)  
INTO FUTURE LOT  
NOT TO SCALE

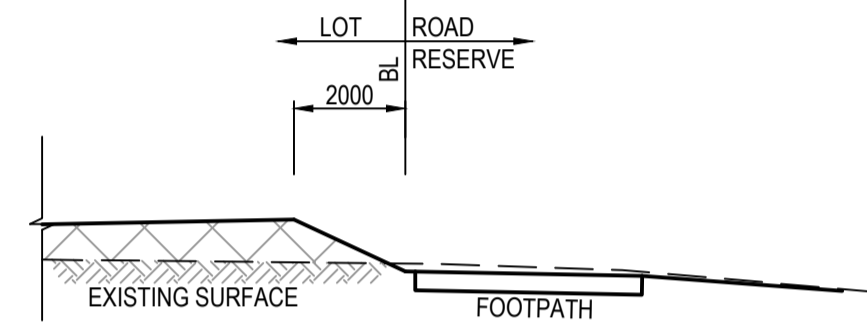

TYPICAL RIDGE BATTER DETAIL  
NOT TO SCALE

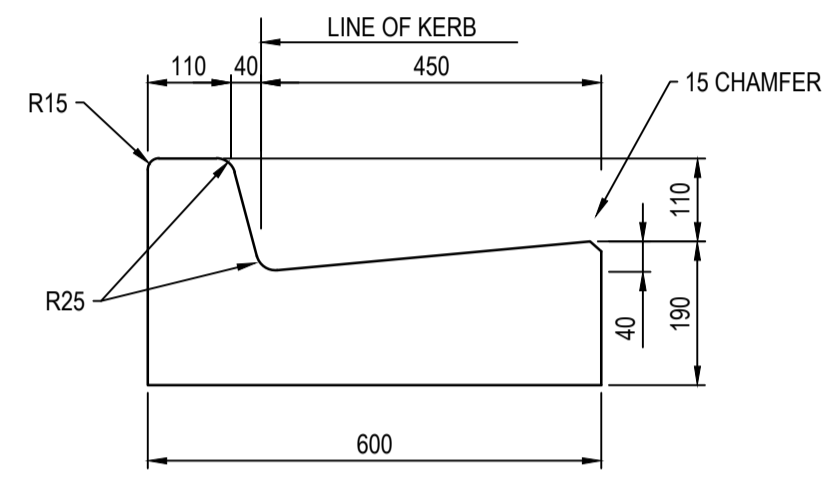


600 B2 KERB DETAIL  
SCALE 1:10  
EDCM

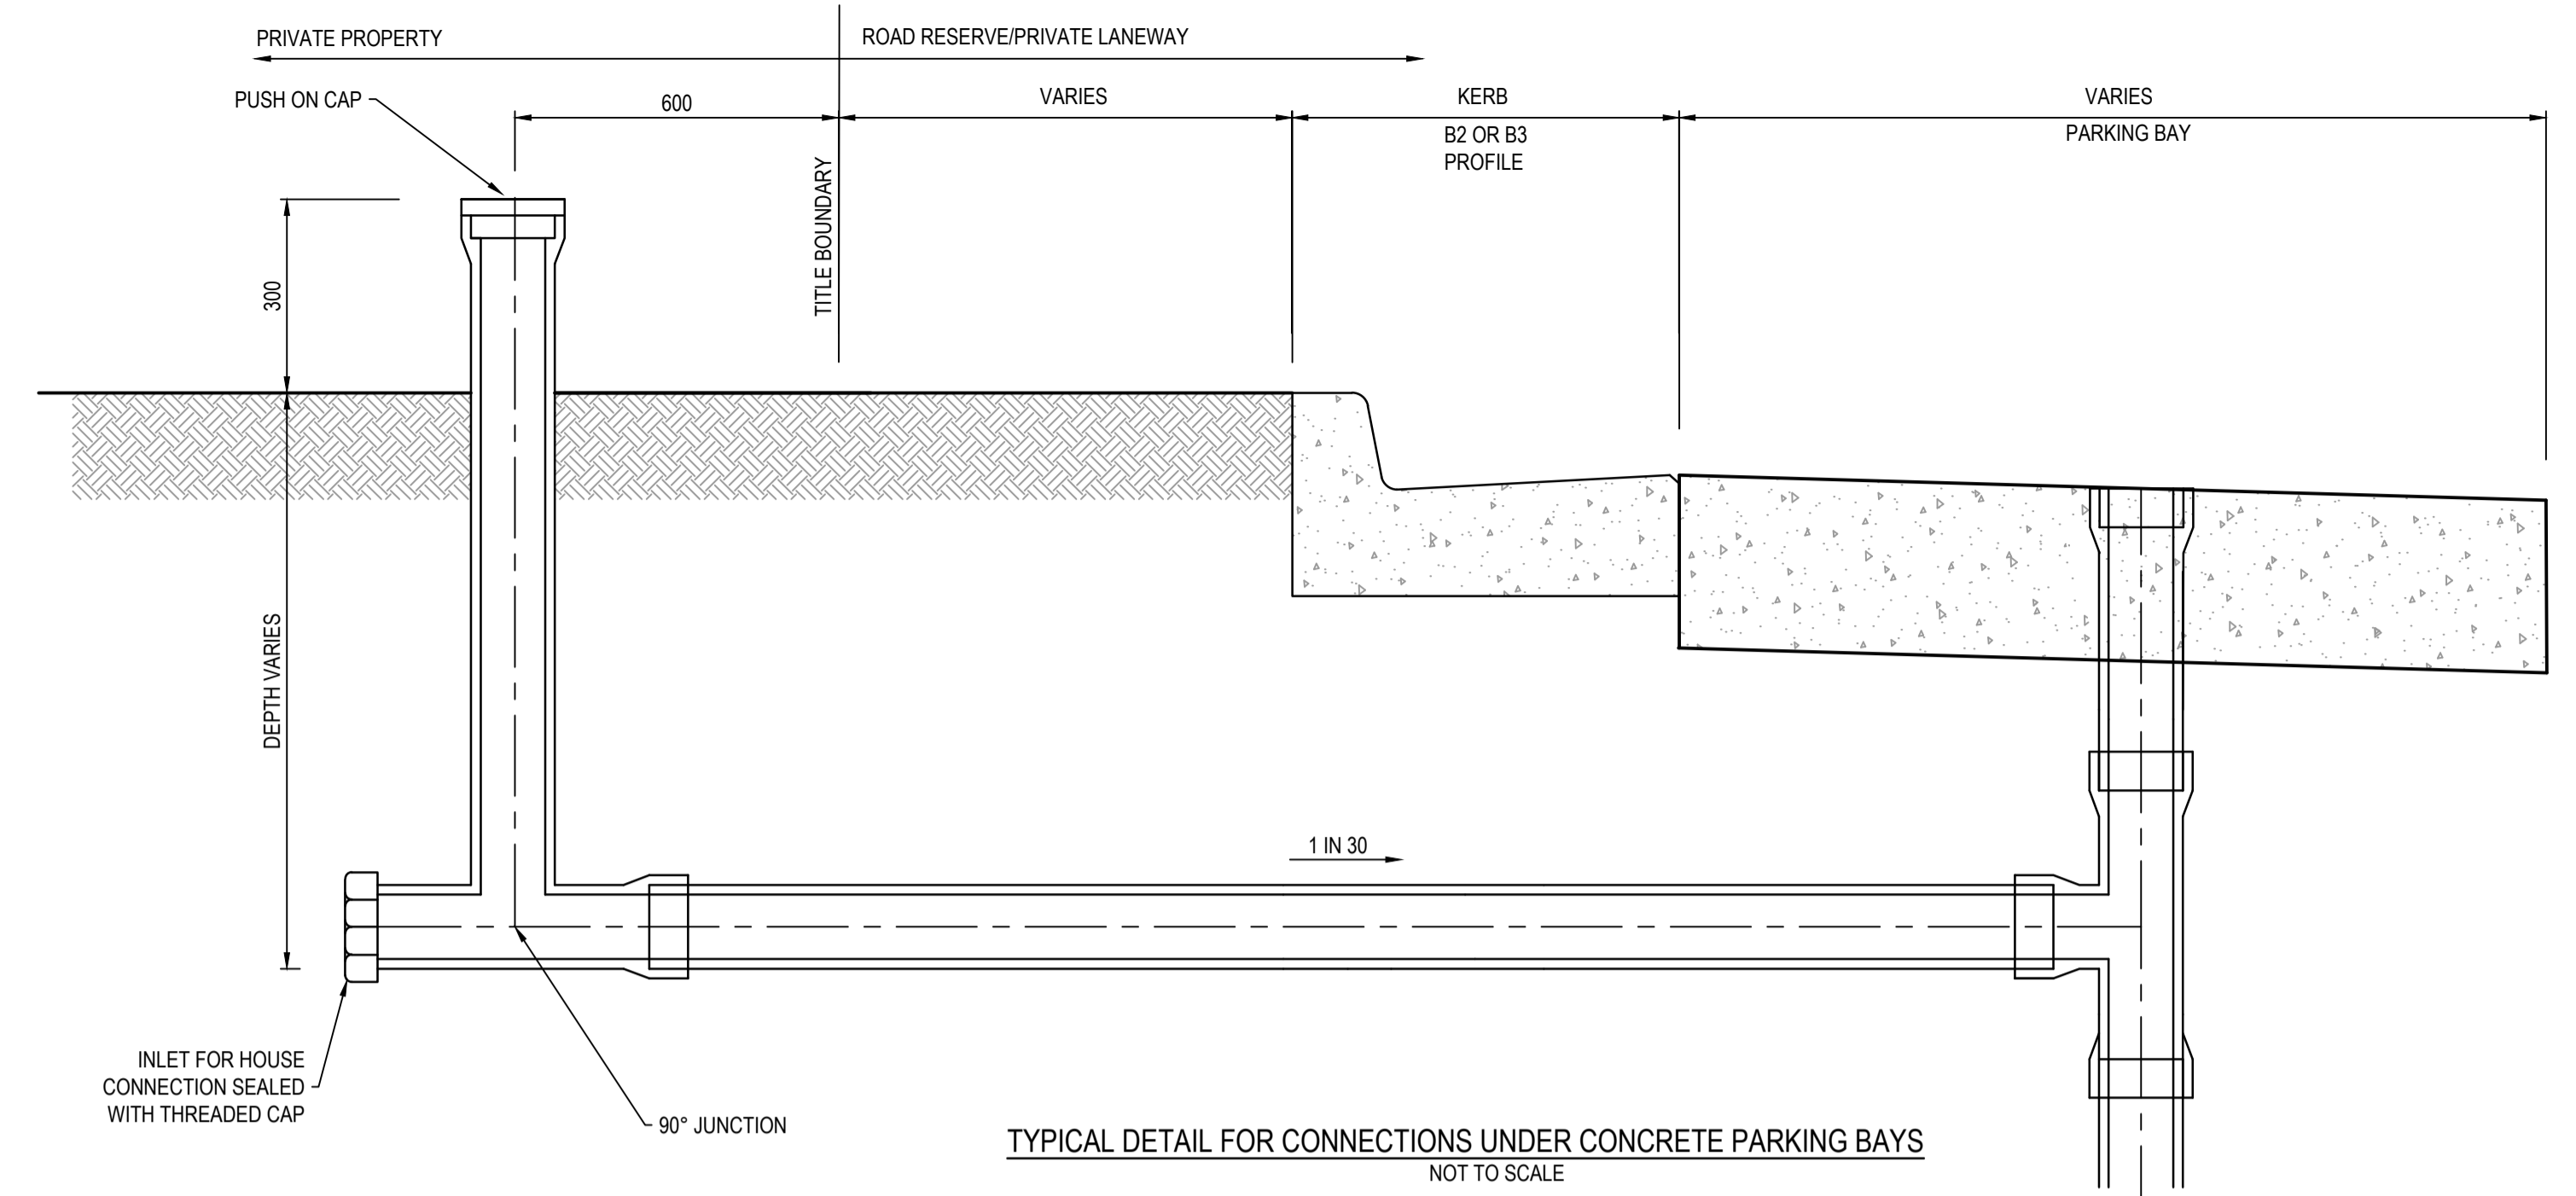


TYPICAL DETAIL FOR CONNECTIONS UNDER CONCRETE PARKING BAYS  
NOT TO SCALE


PVC PAN COLLAR WITH RUBBER RING  
OR APPROVED EQUIVALENT.  
RENDER AROUND COLLAR WITH MORTAR

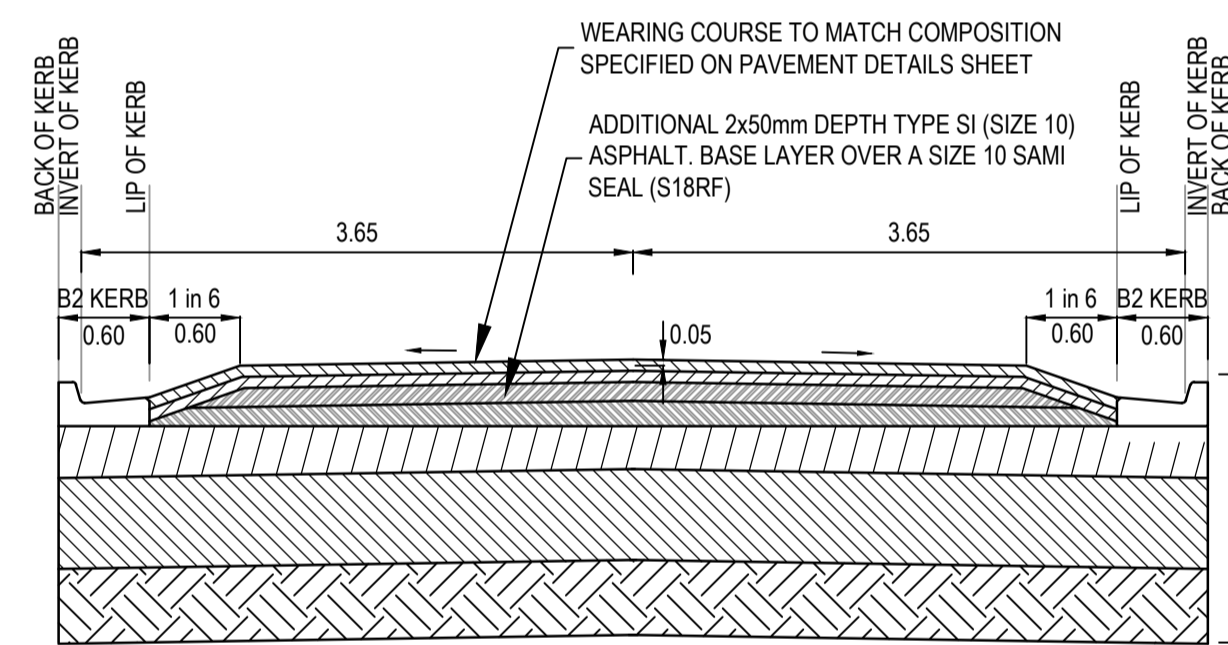


FLAT TOP RAISED PAVEMENT  
SECTION B-B  
NOT TO SCALE

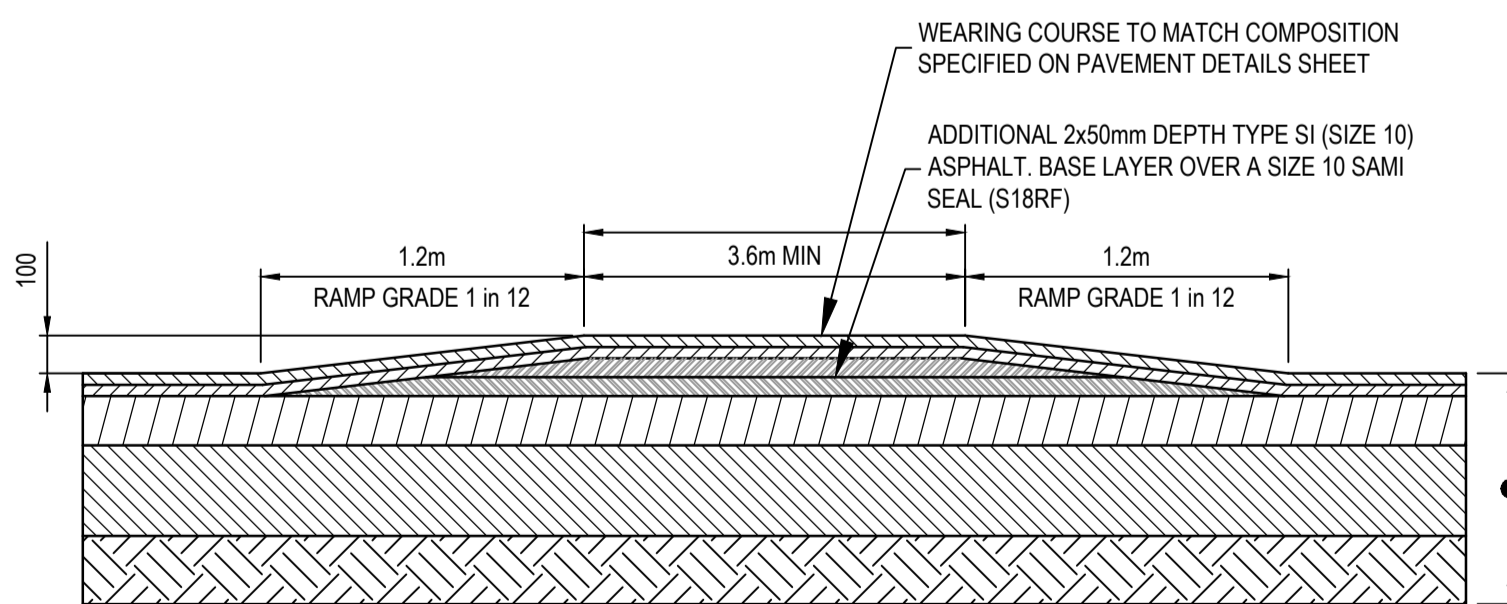

FLAT TOP RAISED PAVEMENT  
SECTION A-A  
NOT TO SCALE

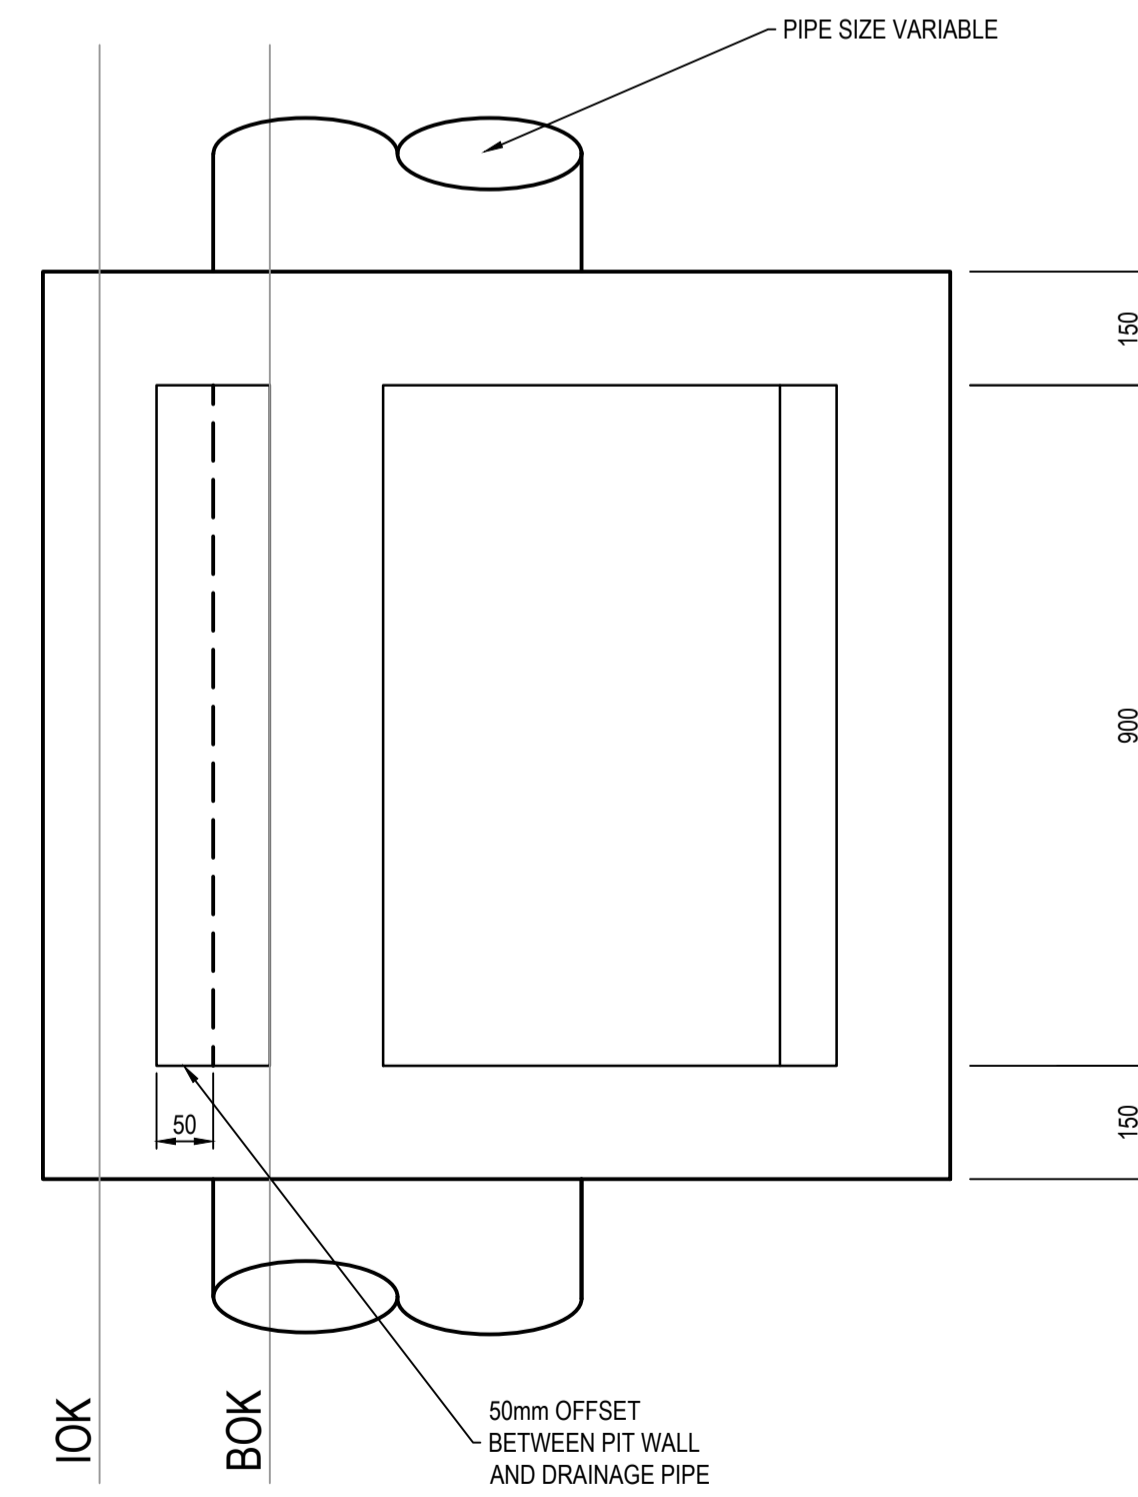

PIT REINFORCEMENT LAP DETAIL  
SCALE 1:10

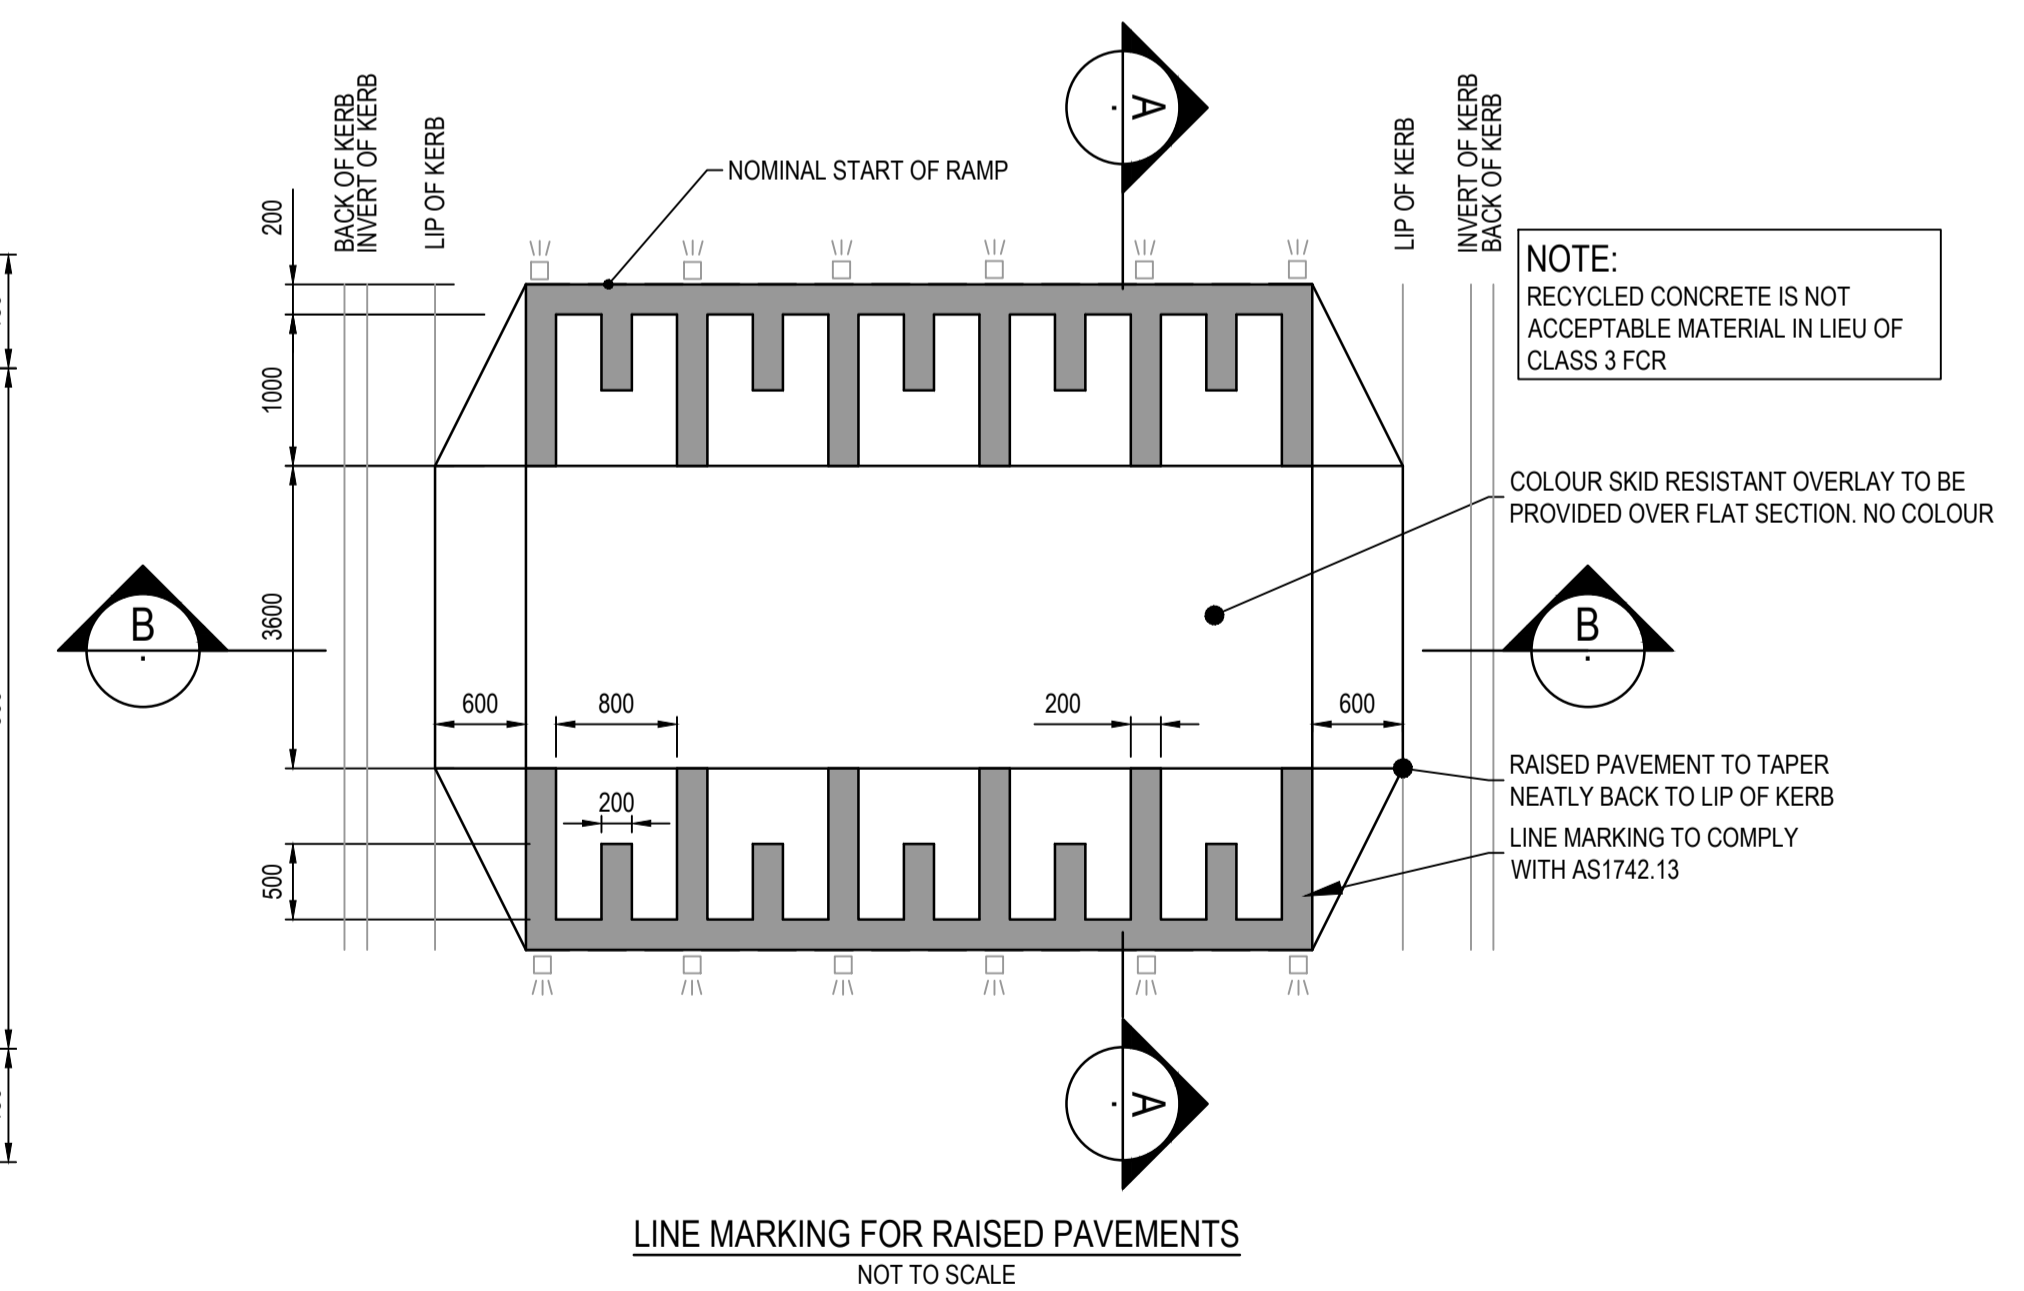

LINE MARKING FOR RAISED PAVEMENTS  
NOT TO SCALE

**AS CONSTRUCTED PLANS**

The purpose of these as-constructed plans is to update the design drawings to show significant changes which occurred during construction. Note that the levels shown on these plans are design levels, and have not been verified by survey. All information shown on these plans should be verified on site. SMEC Australia Pty Ltd accept no responsibility for loss or damages resulting from the inappropriate usage of these plans.



**AS CONSTRUCTED**

PLAN OF SUB. NO.  
PS900882T  
PERMIT REF. NO.  
WYP10365/17.01

SCALE AS SHOWN AT A1



Marigold - Stage 7  
Wyndham City Council  
Road and Drainage  
General Details

MELWAYS REF: 359 F9  
PROJECT / DRAWING No: 2360E-007-421  
SHEET No: 27 of 28  
REVISION: 2

PHASE	DISCIPLINE CODE	POTENTIAL RISK (Construction, Operations, Maintenance)			RISK OWNER	POTENTIAL CONSEQUENCES	POTENTIAL ELIMINATION MEASURE, DESIGN INITIATIVE or CONTROL (Identify any Standard or Code of practice used)	HOW ISSUE ADDRESSED IN DESIGN AND/OR CONSTRUCTION OF THE WORKS	IS THE RISK ELIMINATED? YES / NO	RESIDUAL RISK LIKELIHOOD (0-5)	RESIDUAL RISK CONSEQUENCE (0-5)	RESIDUAL RISK RATING	RESIDUAL RISK OWNER
<b>Road Furniture / Roadside Features</b>													
Construction	RD	Roads	Construction close to live traffic	New works will be constructed adjacent to live traffic when abutting existing stages.	Contractor	Disruptions to live traffic, construction incident involving live traffic.	Provide safe temporary traffic control (TCP)	TCP provided within contract	N	5	3	15	Constructor
Construction	US	Utilities or Services	Utilities become a hazard within clear zones	Vehicle conflict with utility / pit	Contractor	Personal injury, vehicle damage	Sequence works and protect with temp barrier or traffic control (TCP)	TCP provided within contract	N	1	5	5	Constructor
Operational	RD	Roads	Sight Lines	Inadequate drivers response time.	Road Authority	Increased potential for accidents	Ensure design complies with relevant standard. Undertake thorough Safety Audit	Vis lines checked and discussed with approval authority as part of design approval process	N	1	4	4	Road Authority
Operational	LS	Lines and Signs	Signs and street lights	Potential for drivers / riders to strike signs and street lights	Road Authority	Increased potential for accidents	Ensure design complies with relevant standard. Undertake thorough Safety Audit	Refer to appropriate standard for sign and lighting offsets	N	1	4	4	Road Authority
Operational	RF	Road Furniture	Headwalls	Potential vehicle conflict within clear zone	Road Authority	Increased potential for accidents	Establish adequate clear zone provision	Adequate barrier provided as per appropriate standard where within clear zone. Culvert headwall selection in accordance with authority standard	N	2	4	8	Road Authority
Operational	RD	Roads	Culverts	Potential fall hazard during maintenance, by vehicles and pedestrians	Relevant Authority	Falling from a height	Barriers to be provided in accordance with road standards	Barriers to be provided and safe batter slopes (>1:3)	N	2	5	10	Constructor
<b>Drainage</b>													
Operational	DR	Drainage	Grated Pits	Trip/fall hazard with large spaced grate	Relevant Authority	Increased potential for accidents	Provide pedestrian/bicycle friendly grates where applicable. Refer to pit schedule	Design in accordance with authority and manufacturers standards	N	3	2	6	Authority
Operational	DR	Drainage	Non Standard Large Pits	Potential for pit failure	Relevant Authority	Increased risk to maintenance crews/ vehicles	Structural design in accordance with relevant design principles.	Refer to structural drawings and calculations	N	1	4	4	Authority
Maintenance	DR	Drainage	Access to Pits	Lack of safe access for maintenance	Relevant Authority	Increased risk to maintenance crews	Provide safe working conditions for maintenance. Provide safe landing/ access arrangements as per relevant authority standards	Where possible design pit in location for easy access and outside of permanent water bodies	N	2	5	10	Authority
Maintenance	DR	Drainage	Deep Pits	Lack of safe entry for maintenance	Relevant Authority	Increased potential for accidents	Contractor to be certified for work in confined spaces, step irons to be provided to appropriate authority standards. Refer to pit schedule	Design in accordance with authority standards	N	1	5	5	Authority
Maintenance	DR	Drainage	Access to drains / culverts	Lack of safe access for maintenance	Relevant Authority	Increased risk to maintenance crews	Provide safe working conditions for maintenance. Access as approved by authority	Design pit in location for easy access as agreed with authority	N	2	3	6	Authority
<b>Sewer</b>													
Maintenance	SE	Sewer	Deep Manholes	Lack of safe entry for maintenance	Relevant Authority	Increased potential for accidents	Contractor to be certified for work in confined spaces, landings and step access provided as per authority standards and schedule	Design in accordance with authority standards. Refer pit schedule on drawings	N	1	5	5	Authority
Maintenance	SE	Sewer	Access to Manholes	Lack of safe access for maintenance	Relevant Authority	Increased risk to maintenance crews	Provide safe working conditions for maintenance. Manholes located in compliance with authority standards	Where possible design manhole in location for easy access	N	1	5	5	Authority
<b>Electricity</b>													
Operational	ES	Electrical Services	Electrical Design	Location of assets within clear zones e.g. pits/ substations	Relevant Authority	Increased potential for accidents	Electrical designed by sub consultant with appropriate accreditation and in accordance with authority standards	Pits designed below ground. Where above ground adequate offset from vehicle clear zones has been provided or barrier protection provided	N	2	3	6	Authority
<b>Telstra</b>													
Operational	TE	Telstra	Telstra Design	Location of assets within clear zones e.g. pits	Relevant Authority	Increased potential for accidents	Telecommunications designed by authority consultant with appropriate accreditation and in accordance with authority standards	Pits designed below ground. Where above ground adequate offset from vehicle clear zones has been provided or barrier protection provided	N	2	3	6	Authority
<b>Water</b>													
Operational	WA	Water	Water Design	Location of assets within clear zones e.g. pits/ substations	Relevant Authority	Increased potential for accidents	Water pits designed in accordance with authority standards	Pits designed below ground. Where above ground adequate offset from vehicle clear zones has been provided or barrier protection provided	N	2	3	6	Authority
<b>Gas</b>													
Operational	GA	Gas	Gas Design	Location of assets within clear zones e.g. pits/ substations	Relevant Authority	Increased potential for accidents	Water pits designed in accordance with authority standards	Pits designed below ground. Where above ground adequate offset from vehicle clear zones has been provided or barrier protection provided	N	1	1	1	Authority

**AS CONSTRUCTED PLANS**


The purpose of these as-constructed plans is to update the design drawings to show significant changes which occurred during construction. Note that the levels shown on these plans are design levels, and have not been verified by survey. All information shown on these plans should be verified on site. SMEC Australia Pty Ltd accept no responsibility for loss or damages resulting from the inappropriate usage of these plans.



**AS CONSTRUCTED**

PLAN OF SUB. NO.  
PS900882T  
PERMIT REF. NO.  
WYP10365/17.01

SCALE AS SHOWN AT A1

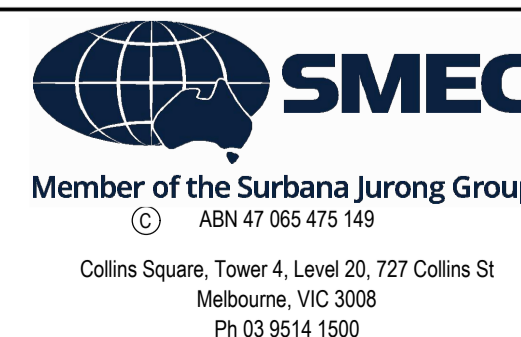

Marigold - Stage 7  
Wyndham City Council  
Road and Drainage  
Safety In Design

MELWAYS REF: 359 F9 PROJECT / DRAWING No: 2360E-007-500 SHEET No: 28 of 28 REVISION: 1